


8" Sanitary Sewer

8" Domestic Water


Utilities to be Abandoned

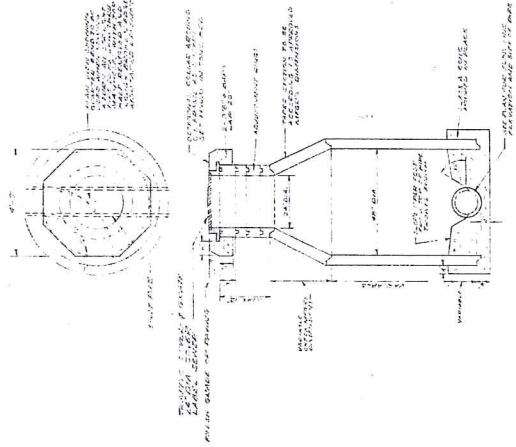

Manhole Detail

2-way clean-out provide concrete yardbox w/ concrete lid labeled " 2-way CO" typ.

Remove and dispose of (E) tree, grind stump to at least 18" below grade

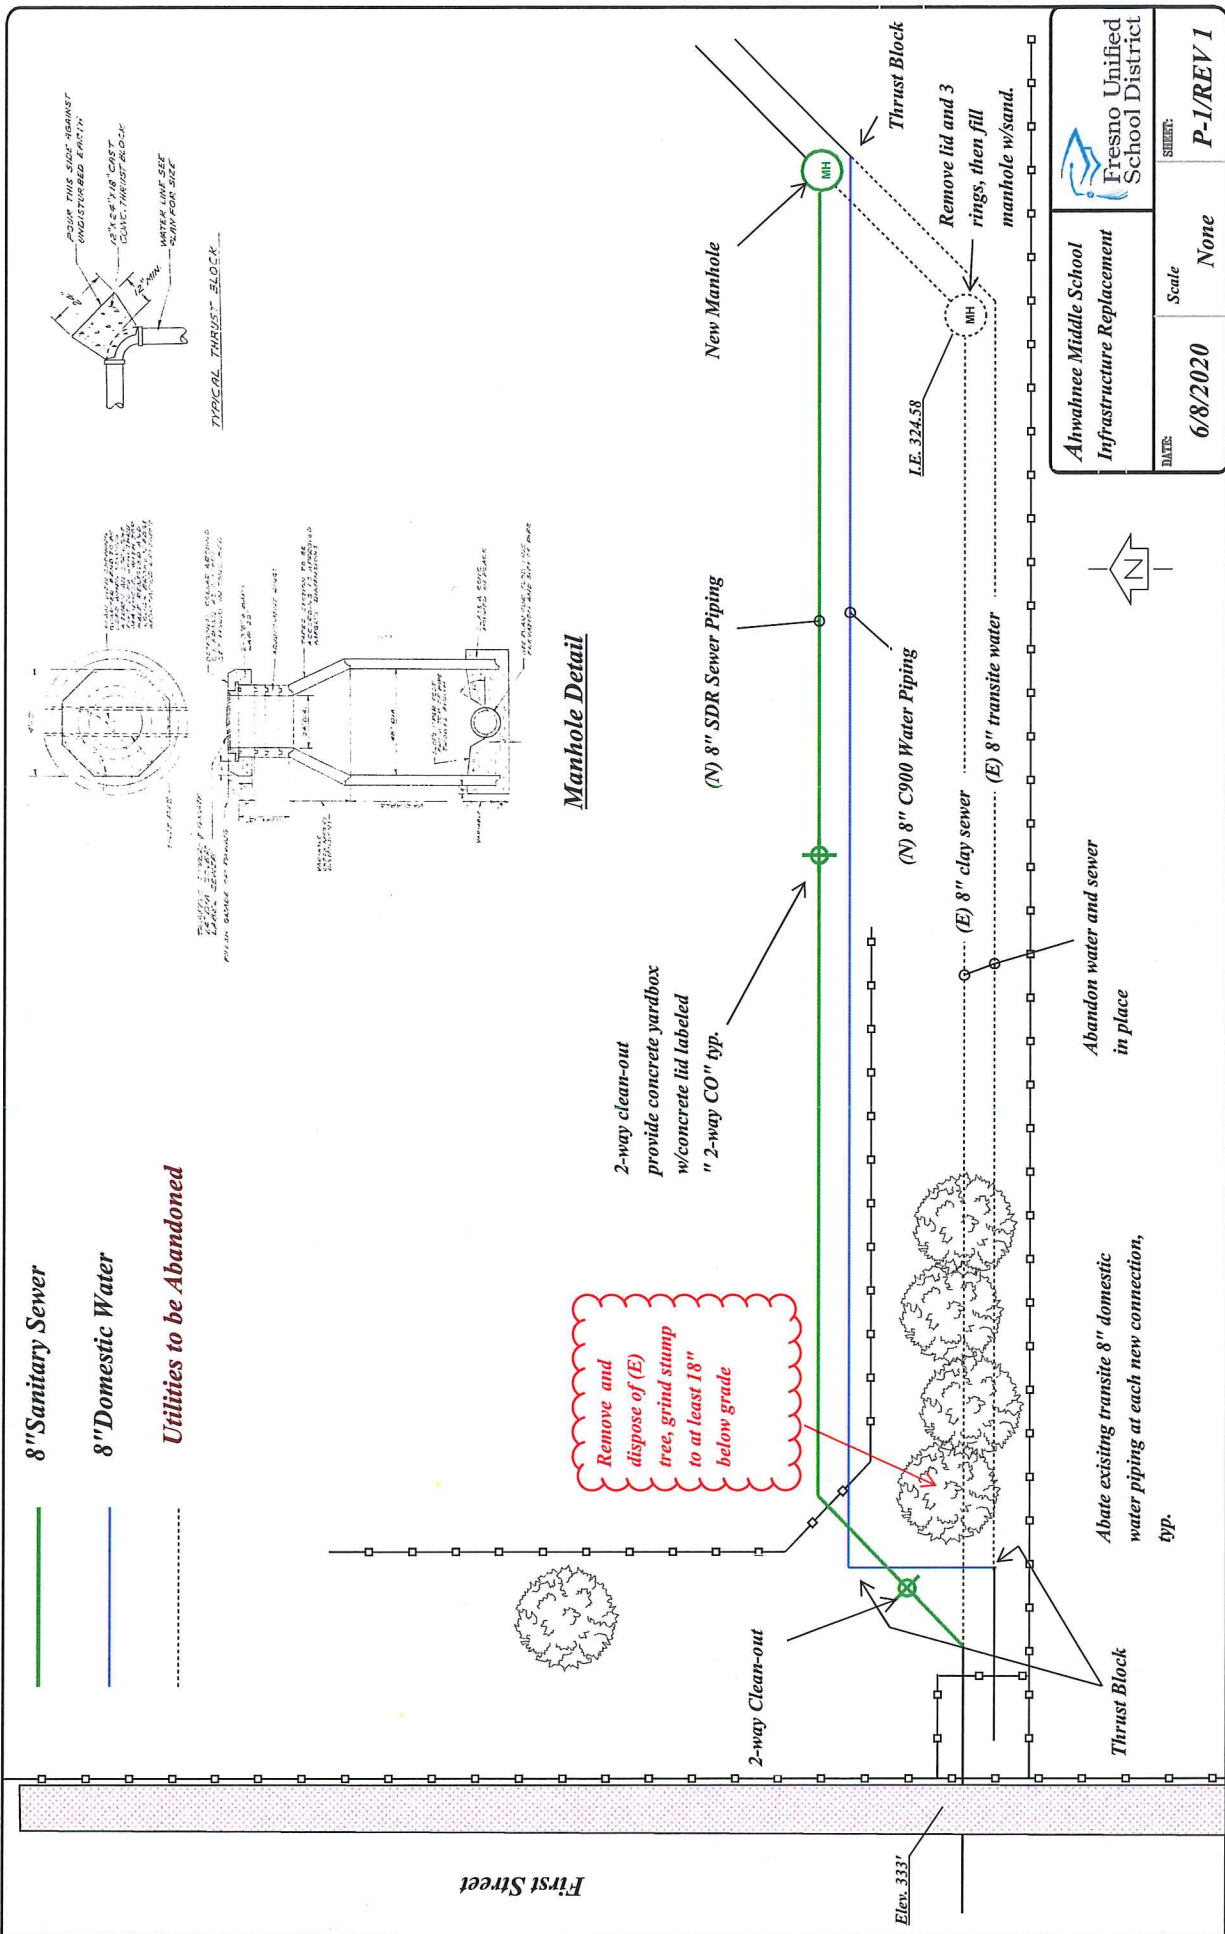

		Fresno Unified School District	
DATE: 6/8/2020	Scale: None	SHEET: P-1/REV I	