



Preparing Career Ready Graduates

Purchasing Services

4498 N. Brawley Ave. Fresno, CA 93722
Ph. (559) 457-3588 Fax (559) 457-6040

BOARD OF EDUCATION

Valerie F. Davis, President
Keshia Thomas, Clerk
Claudia Cazares
Genoveva Islas
Elizabeth Jonasson Rosas
Carol Mills, J.D.
Major Terry Slatik USMC (Retired)

SUPERINTENDENT

Robert G. Nelson, Ed.D.

April 22, 2021

ADDENDUM No. 1
BURROUGHS, EATON AND ROWELL ELEMENTARY SCHOOL
ENERGY MANAGEMENT SYSTEM REPLACEMENT
Bid No. 21-47

NOTICE TO ALL BIDDERS

This Addendum is attached to and made a part of the above entitled specifications for Fresno Unified School District with a scheduled bid opening on April 29, 2021 prior to 2:01 P.M. All changes and/or clarifications will appear in **bold** type and deletions will be struck out in revised sentences.

Incorporate the following into your bid response.

I. REFERENCE: LAWRENCE ENGINEERING GROUP ADDENDUM No. 1

Add: Incorporate LAWRENCE ENGINEERING GROUP Addendum No. 1.

Lawrence Engineering Group Addendum No. 1 dated April 22, 2021 shall be incorporated into the bid documents as part of the prime bidder proposal.

Instructions:

- Entire addendum may be downloaded from District Purchasing Web Site, under "Bid Opportunities".
<https://www.fresnou.org/dept/purchasing/Pages/Bid-Information.aspx>

Acknowledge receipt and understanding of this addendum in designated area of the Bid Form.


Ann Lporz
Purchasing Manager

ADDENDUM NO. 1

PROJECT: BID NO. 21-47

**FRESNO UNIFIED SCHOOL DISTRICT
EATON, ROWELL, BURROUGHS ELEMENTARY SCHOOL
ENERGY MANGEMENT SYSTEM REPLACEMENT**

APRIL 22, 2021

The following addendum becomes a part of the Contract Documents. It adds to, subtracts from or modifies the Contract Documents as noted. Bidders are required to acknowledge receipt of this addendum on the Bid Form. Failure to acknowledge receipt of each addendum may subject bidder to disqualification.

GENERAL ITEMS:

1. The mandatory Job Walk Sign-in Sheets are attached.
2. The Prequalified Contractor List is attached
3. EMS contractor shall submit .caf files for each device for approval during submittal process.
4. Coordinate with the District whether controls components will be returned to the District or demolished.
5. Provide 1 year warranty including parts and service for the Building Automation System.
6. New Johnson controls installed in existing panel does not require new UL listing of panel.
7. District personnel shall be present for all factory start-up and given 2 week notice.
8. Include factory start-up, and line reactors for Allen-Bradley drives.
9. Replace all existing Multi-zone Unit filters with MERV 13 filters, field verify size and quantity.
10. Revise project estimates as follow:
 - a. Eaton - \$356,235
 - b. Rowell - \$468,380
 - c. Burroughs - \$574,497
11. Replacement supply, return, and exhaust replacement motors are to be VFD rated with shaft grounding rings and premium efficiency.
12. Fresno Unified School District will provide a commissioning agent at all three sites.

DRAWINGS:

1. EATON ELEMENTARY SCHOOL: Refer to attached mechanical set, marked Delta 2.
2. ROWELL ELEMENTARY SCHOOL: Refer to attached mechanical set, marked Delta 2.
3. BURROUGHS ELEMENTARY SCHOOL: Refer to attached mechanical set, marked Delta 2.
4. ELECTRICAL DRAWINGS ALL SITES: Refer to attached addendum letter from Hardin-Davidson.
5. Prebid Request for Information: Refer to attached RFIs for response

SPECIFICATIONS:

1. Add to Specification Section 23 00 00, Paragraph 1.26:

SYSTEM ENERGY BALANCE:

- A. Scope: Provide the services of an independent test and balance agency to test, adjust and balance, retest and record performance of the system to obtain design quantities as specified. The agency must prove that they have no affiliation with any equipment manufacturer, design engineer, installing contractor, or any other party which might lead to a conflict of interest, in order to provide an unbiased, third party system balance and report.
- B. Qualifications: Prior to commencing work, the agency shall be reviewed by the Engineer and shall be certified by the Associated Air Balance Council, National Environmental Balancing Bureau or Testing, Adjusting and Balancing Bureau. The agency shall provide documentation of having successfully completed at least five projects of similar size and scope.
- C. Instruments: All instruments shall be accurately calibrated; calibration histories shall be available for examination. Application of instrumentation shall be in accordance with AABC, NEBB or TABB standards.
- D. Submittals: Include in shop drawings copies of forms to be used for testing and balancing showing all data which is to be recorded. Three copies of completed balance report shall be submitted to and reviewed by the Mechanical Engineer prior to the final mechanical construction review.
- E. Procedure - General: Procedure shall be in accordance with Associated Air Balance Council's "National Standards for Field Measurements and Instrumentation - Total System Balance", Volume Two, No. 12173, or equivalent NEBB or TABB standards. System shall be in full, continuous operation during test. Balanced quantities shall be plus 10%, minus 0% of design quantities. All nameplate data, manufacturer, model and serial numbers shall be recorded for each item tested.
- F. Extended Warranty: The test and balance agency shall include an extended warranty of 90 days after completion of test and balance work, during which time the Engineer, at his discretion, may request a recheck or resetting of any item or items in test report. The agency shall provide technicians to assist the Engineer in making any tests he may require during this period of time.
- G. Air Balance Procedure (For Each Air Handling System):
 1. All air filters shall be clean when air balance is performed.
 2. Provide a sketch of the equipment showing exactly where all pressure readings were taken.
 3. Adjust blower RPM to design requirements.
 4. Record motor full load amperes.
 5. Make pitot tube traverse of main supply and return ducts and obtain design CFM at fans.

6. Record system static pressures, inlet and discharge.
 7. Record filter quantity, size(s) and pressure drop across filter(s) at each filter bank.
 8. Adjust system for design CFM recirculated air.
 9. Adjust system for design CFM outside air.
 10. Record entering air temperatures. (DB heating, DB and WB cooling.)
 11. Record leaving air temperatures. (DB heating, DB and WB cooling.)
 12. Adjust all main supply and return air ducts to design CFM.
 13. Adjust all zones to design CFM, supply and return.
 14. Adjust all diffusers, grilles and registers to plus 10%, minus 0% of design requirements.
 15. Adjust CFM at all exhaust fans, make-up units, etc. (high and low speed, where applicable). Record applicable data from items 1 through 11 above.
 16. Each grille, diffuser and register shall be identified as to location.
 17. Verify proper diffusion pattern for all ceiling grilles and that all sidewall grilles are set for 5 degrees upward deflection unless otherwise noted. Make a notation of any that are not set properly.
 18. Size, type and manufacturer of diffusers, grilles, registers and all tested items shall be identified and listed. Manufacturer's ratings shall be used to make required calculations on all items.
 19. Readings and tests of diffusers, grilles, and registers shall include required FPM velocity and test resultant velocity, required CFM and test resultant CFM after adjustments.
 20. In cooperation with the control manufacturer's representative, set adjustments of automatically operated dampers to operate as specified. Testing agency shall check all controls for proper calibrations and list all controls requiring adjustment by control installers.
 21. All diffusers, grilles and registers shall be adjusted for required air patterns and to minimize drafts.
 22. As a part of the work of this contract, THE AIR CONDITIONING CONTRACTOR shall make any changes in pulleys, belts and dampers or the addition of dampers required for correct balance as recommended by air balance agency, at no additional cost to Owner.
 23. Set, test and adjust packaged heating/cooling unit economizer operation in cooperation with controls contractor. Record minimum and maximum outside and exhaust airflows.
2. Refer to Specification Section 23 09 24 2.2 A: Revise "Allen-Bradley Powerflex 753, without substitution." to "Allen-Bradley Powerflex 400 or 500, without substitution"
 3. Refer to Specification Section 23 09 23 2.1 B: Omit the following:
 1. Local Display Devices - PC Touchscreens
 2. Portable Operator Terminals – Laptop with required software installed
 4. Add Specification Sections:
 - A. 09 90 00 Painting
 - B. 09 90 01 Paint Material List
- Attachment: Job Walk Sign-in Sheets (6 sheets)
 Prequalified Contractors List (4 sheets)
 Eaton Elementary School EMS Plans –Delta 2
 Rowell Elementary School EMS Plans –Delta 2
 Burroughs Elementary School EMS Plans –Delta 2
 Electrical Addendum Letter
 Prebid Request For Information No.1 through No.23
 09 90 00 Painting
 09 90 01 Paint Material List

END OF ADDENDUM NO. 1

MANDATORY Pre-Bid Conference / Job Walk Sign-in Sheet

Formal Bid No. 21-47, Sections A-C

Burroughs, Eaton and Rowell Elementary Schools Energy Management System Replacement

Pre-Bid Conference Date: April 9, 2021 @ 9:00 A.M.

District Address	Conference Location	District Contact
Fresno Unified School District Purchasing Department 4498 N. Brawley Ave Fresno CA 93722	in front of the Administration Office of Burroughs Elementary School 166 N. Sierra Vista Ave. Fresno, CA 93702	Ann Loorz, Purchasing Manager 4498 N. Brawley Ave Fresno, CA 93722 559-457-3582
Contractor Information		Phone Number
Company Name: <u>LPA Automation</u>		(559) 907 - 2577
City: <u>Fresno, Ca</u>		Email
Contact Name: <u>Joe Calafiora</u>		JOEC@LPAAutomation.com
Contractor Information		Phone Number
Company Name: <u>FUSD</u>		() -
City: <u>Fresno</u>		Email
Contact Name: <u>William Anderson</u>		
Contractor Information		Phone Number
Company Name: <u>MEBA ENERGY SYSTEMS</u>		(559) 474 - 1493
City: <u>FRESNO CA</u>		Email
Contact Name: <u>CLINT PERRY</u>		CAPERRY@EMCOR.NET
Contractor Information		Phone Number
Company Name: <u>LEG</u>		(559) 943 0101
City: <u>Fresno, CA</u>		Email
Contact Name: <u>Ezequiel Fregoso</u>		ezequiel@legfresno.com
Contractor Information		Phone Number
Company Name: <u>Lawrence Engineering Group</u>		(559) 970 - 0919
City: <u>Fresno, CA</u>		Email
Contact Name: <u>Jose Jaime</u>		jose@legfresno.com

MANDATORY Pre-Bid Conference / Job Walk Sign-in Sheet

Formal Bid No. 21-47, Sections A-C

Burroughs, Eaton and Rowell Elementary Schools Energy Management System Replacement

Pre-Bid Conference Date: April 9, 2021 @ 9:00 A.M.

District Address	Conference Location	District Contact
Fresno Unified School District Purchasing Department 4498 N. Brawley Ave Fresno CA 93722	in front of the Administration Office of Burroughs Elementary School 166 N. Sierra Vista Ave. Fresno, CA 93702	Ann Loorz, Purchasing Manager 4498 N. Brawley Ave Fresno, CA 93722 559-457-3582
Contractor Information		Phone Number
Company Name: <u>Strategic Mechanical</u>		(559) 291 - 1952
City: <u>Fresno CA</u>		Email: <u>estimating@strategicmech.com</u>
Contact Name: <u>Daniel Brown</u>		
Contractor Information		Phone Number
Company Name: <u>Johnson Controls</u>		(559) 474 - 3317
City: <u>Fresno CA</u>		Email: <u>blake.l.semas@jci.com</u>
Contact Name: <u>Blake Semas</u>		
Contractor Information		Phone Number
Company Name: <u>FUSD- Purchasing</u>		(559) 457 - 3382
City: _____		Email: _____
Contact Name: <u>Ann Loorz</u>		
Contractor Information		Phone Number
Company Name: _____		() -
City: _____		Email: _____
Contact Name: _____		
Contractor Information		Phone Number
Company Name: _____		() -
City: _____		Email: _____
Contact Name: _____		

MANDATORY Pre-Bid Conference / Job Walk Sign-in Sheet

Formal Bid No. 21-47, Sections A-C

Burroughs, Eaton and Rowell Elementary Schools Energy Management System Replacement

Pre-Bid Conference Date: April 9, 2021 @ 9:00 A.M.

District Address	Conference Location	District Contact
Fresno Unified School District Purchasing Department 4498 N. Brawley Ave Fresno CA 93722	in front of the Administration Office of Eaton Elementary School 1451 E. Sierra Ave. Fresno, CA 93710	Ann Loorz, Purchasing Manager 4498 N. Brawley Ave Fresno, CA 93722 559-457-3582
Contractor Information		Phone Number
Company Name: <u>Ezequiel Leg</u>		(559) 431 - 0101
City: <u>Fresno, CA</u>		Email
Contact Name: <u>Ezequiel Fregoso</u>		<u>ezequiel@legfresno.com</u>
Contractor Information		Phone Number
Company Name: <u>Johnson Controls</u>		(559) 474 - 3317
City: <u>Fresno, CA</u>		Email
Contact Name: <u>Blake Semas</u>		<u>blake.1.semas@jci.com</u>
Contractor Information		Phone Number
Company Name: <u>MEGA ENERGY SYSTEM</u>		(559) 474 - 1497
City: <u>FRESNO CA</u>		Email
Contact Name: <u>CLINT PERRY</u>		<u>CLPERRY@CONCORD.NET</u>
Contractor Information		Phone Number
Company Name: <u>LAWRENCE ENGINEERING GROUP</u>		(559) 470 - 0919
City: <u>FRESNO, CA</u>		Email
Contact Name: <u>JOSE JAIMIN</u>		<u>jose@legfresno.com</u>
Contractor Information		Phone Number
Company Name: <u>LPC AUTOMATION.COM</u>		(559) 907 - 2577
City: <u>FRESNO, CA</u>		Email
Contact Name: <u>JOE CALAFIORA</u>		<u>JOEC@LPCAUTOMATION.COM</u>

MANDATORY Pre-Bid Conference / Job Walk Sign-in Sheet

Formal Bid No. 21-47, Sections A-C

Burroughs, Eaton and Rowell Elementary Schools Energy Management System Replacement

Pre-Bid Conference Date: April 9, 2021 @ 9:00 A.M.

District Address	Conference Location	District Contact
Fresno Unified School District Purchasing Department 4498 N. Brawley Ave Fresno CA 93722	in front of the Administration Office of Eaton Elementary School 1451 E. Sierra Ave. Fresno, CA 93710	Ann Loorz, Purchasing Manager 4498 N. Brawley Ave Fresno, CA 93722 559-457-3582
Contractor Information		Phone Number
Company Name: <u>Strategic Mechanical</u>		(559) 291-1952
City: <u>Fresno</u>		Email
Contact Name: <u>Daniel Brown</u>		<u>estimating@strategicmechanical.com</u>
Contractor Information		Phone Number
Company Name: <u>FUSD</u>		() -
City: <u>Fresno</u>		Email
Contact Name: <u>Danny Anderson</u>		
Contractor Information		Phone Number
Company Name: _____		() -
City: _____		Email
Contact Name: _____		
Contractor Information		Phone Number
Company Name: _____		() -
City: _____		Email
Contact Name: _____		
Contractor Information		Phone Number
Company Name: _____		() -
City: _____		Email
Contact Name: _____		

MANDATORY Pre-Bid Conference / Job Walk Sign-in Sheet

Formal Bid No. 21-47, Sections A-C

Burroughs, Eaton and Rowell Elementary Schools Energy Management System Replacement

Pre-Bid Conference Date: April 9, 2021 @ 9:00 A.M.

District Address	Conference Location	District Contact
Fresno Unified School District Purchasing Department 4498 N. Brawley Ave Fresno CA 93722	in front of the Administration Office of Rowell Elementary School 3460 E. McKenzie Ave. Fresno, CA 93702	Ann Loorz, Purchasing Manager 4498 N. Brawley Ave Fresno, CA 93722 559-457-3582
Contractor Information		Phone Number
Company Name: <u>LPC Automation.</u>		(559) 907 - 2577
City: <u>Fresno, Ca</u>		Email
Contact Name: <u>JOE Calafiore</u>		joec@lpcautomation.com
Contractor Information		Phone Number
Company Name: <u>Strategic Mechanical</u>		(559) 291 - 1952
City: <u>Fresno CA</u>		Email
Contact Name: <u>Daniel Brown</u>		estimating@strategicmech.com
Contractor Information		Phone Number
Company Name: <u>MESA ENERGY SYSTEMS</u>		(559) 474 - 1993
City: <u>FRESNO, CA</u>		Email
Contact Name: <u>CLINT PETTY</u>		CAPETTY@emcs.net
Contractor Information		Phone Number
Company Name: <u>FUSD</u>		() -
City: <u>Fresno</u>		Email
Contact Name: <u>Danny Anderson</u>		William.Anderson@fresno.k12.ca.us
Contractor Information		Phone Number
Company Name: _____		() -
City: _____		Email
Contact Name: _____		

MANDATORY Pre-Bid Conference / Job Walk Sign-in Sheet

Formal Bid No. 21-47, Sections A-C

Burroughs, Eaton and Rowell Elementary Schools Energy Management System Replacement

Pre-Bid Conference Date: April 9, 2021 @ 9:00 A.M.

District Address	Conference Location	District Contact
Fresno Unified School District Purchasing Department 4498 N. Brawley Ave Fresno CA 93722	In front of the Administration Office of Rowell Elementary School 3460 E. McKenzie Ave. Fresno, CA 93702	Ann Loorz, Purchasing Manager 4498 N. Brawley Ave Fresno, CA 93722 559-457-3582
Contractor Information		Phone Number
Company Name: <u>Johnson Controls, Inc.</u>		<u>(559) 474 - 3317</u>
City: <u>Fresno, CA</u>		Email: <u>blake.1.semas@jci.com</u>
Contact Name: <u>Blake Semas</u>		
Contractor Information		Phone Number
Company Name: <u>LAWRENCE ENGINEERING G.</u>		<u>(559) 431 - 0101</u>
City: <u>Fresno, CA</u>		Email: <u>ezequiel@legfresno.com</u>
Contact Name: <u>Ezequiel Fregoso</u>		
Contractor Information		Phone Number
Company Name: <u>Lawrence Engineering Group</u>		<u>(559) 970 - 0919</u>
City: <u>Fresno, CA</u>		Email: <u>jose@legfresno.com</u>
Contact Name: <u>José Jaime</u>		
Contractor Information		Phone Number
Company Name: <u>FUSD- Purchasing</u>		<u>(559) 457 - 3582</u>
City: _____		Email: _____
Contact Name: <u>Ann Looz</u>		
Contractor Information		Phone Number
Company Name: _____		<u>() - </u>
City: _____		Email: _____
Contact Name: _____		

PREQUALIFICATION CONTRACTORS LIST
(\$1 MILLION + PROJECTS)
AS OF APRIL 14, 2021

PRIME CONTRACTOR	CONTACT	PHONE No.	E-MAIL	LICENSE No.	LICENSES HELD	QUALIFIED DATE	VALID THROUGH
3D Datacom	Victor Biberston	559-593-0824	vbiberston@3dtsi.com	757157 B C7 C10		12/14/20	12/13/21
A-C Electric Company	Jim McGurk	559-233-2208	jimmcgurk@a-celectric.com	99849 A B C7 C10 C12 D42		07/14/20	07/13/21
Able Heating and Air Conditioning, Inc.	Shantel Nunn	619-409-9100	snunn@ableac.net	466861 B C20 C43		04/16/20	04/15/21
Acco Engineered Systems, Inc.	Randy Blunt	661-558-7014	rblunt@accos.com	120696 A B C4 C10 C16 C20 C36 C38		10/02/20	10/01/21
Alcorn Aire, Inc.	Jodi Nagel	661-323-1992	jnagel@alcornaire.com	735144 B C20		03/15/21	03/14/22
American Incorporated	Pat Alvarez	559-651-1776	palvarez@aminc.com	292529 A B C4 C7 C10 C20 C21 C36 C38 C43 C61 D6		03/11/21	03/10/22
American Paving Co.	Stephen Poindexter	559-268-9886	spoindexter@americanpavingco.com	181430 A B C8 C12 C31		07/17/20	07/16/21
AMG & Associates, Inc.	Albert Giacomazzi	661-251-7401	estimating@amgassociatesinc.com	881824 A B		09/08/20	09/07/21
Ardent General, Inc.	James Myers	559-492-3969	estimating@ardentgeneral.com	968340 A B		12/01/20	11/30/21
Audeamus dba Sebastian	Tony Bustos	559-432-5800	estimating@sebastiancorp.com	940822 A B C7 C10		02/11/21	02/10/22
Avidex Industires LLC	Ron Ponce	949-428-6333	biddesk@avidex.com	981651 C7 C10		03/30/21	03/29/22
Avison Construcion Inc.	Curtis Short	559-431-0317	cshort@avisoninc.com	823535 A		04/05/21	04/04/22
Bay City Mechanical, Inc.	Crystal Rougeau	510-233-7000	crystal@baycitymech.com	645126 B C4 C20 C36 C43		04/24/20	04/23/21
Belmont Construction, Inc. dba R&H Construction	Jacob Belmont	559-492-1252	jbelmont@rhconst.org	923412 A B C8		07/13/20	07/12/21
Bill Nelson General Engineering Construction, Inc.	Stacy French	559-439-1756	estimating@bngec.us ebower@bmyinc.com ;	692068 A		03/19/21	03/18/22
BMV Construction Group, Inc.	Eric Bower	559-243-4200	estimating@bmyinc.com	686178 A B C8		04/14/21	04/13/22
Bowen Engineering and Environmental	Erik Bowen	559-233-7464	office@bowendemo.com	816496 A B C10 C21 C22 C33 C39 C50 C61 D38		03/22/21	03/21/22
Brazos Urethane, Inc.	Craig Opel	559-674-1111	c.opel@brazosinc.com	982578 B C2 C33 C39 C43		03/19/21	03/18/22
Burke Diversified dba Burke Construction	Jason E. Burke	559-201-9335	jburke@burkediversified.com	61093 B C39		01/19/21	01/18/22
Bush Engineering, Inc.	Jasmine Cooper	559-584-1575	jasmine@bushconstruction.net ken@bviprojects.com ;	888139 A B C8 C21		12/22/20	12/21/21
BVI Construction, Inc.	Ken or Marla Grey	559-896-6450	marla@bviprojects.com	702975 A B		04/01/21	03/31/22
Central California Electronics, Inc.	Matthew Berryhill	559-485-1254	mattb@ccfresno.com	299868 C7 C10		01/11/21	01/10/22
Central Valley Asphalt (Doug Ross, Inc.)	Chelsea Aleston	559-562-7802	chelseacva@ocsnet.net	777434 A		02/18/21	02/17/22
Clean Cut Landscape Inc.	Karry Wendel	559-322-2041	karry@cleancutland.com dplaster@collinselectric.com ;	722882 A C27		04/06/21	04/05/22
Collins Electrical Company, Inc.	David Plaster	209-466-3691	atorres@collinselectric.com	115427 B C10 C31		02/04/21	02/03/22
Comfort Air, Inc.	Allan Goddard	209-466-4601	agoddard@comfortairinc.com	85895 B C4 C16 C20 C36 C38 C43		03/17/21	03/16/22
Contra Costa Electric, Inc.	Matt Furrer	559-252-1114	mfurrer@emcor.net	139885 A B C10		05/19/20	05/18/21
Control Fire Protection, Inc.	David Holt	661-322-1681	dholt@controlfire.net	534644 C16		10/09/20	10/08/21
Cosco Fire Protection, Inc.	Cody Stephens	559-275-3795	cstephens@coscofire.com	577621 C10 C16		03/30/21	03/29/22

PREQUALIFICATION CONTRACTORS LIST
(\$1 MILLION + PROJECTS)
AS OF APRIL 14, 2021

D. H. Williams Construction, Inc.	David Williams	559-241-0374	dhwco@comcast.net	571597	A	B											12/30/20	12/29/21
Dave Christian Construction Co., Inc.	Terri L. Emmett	559-255-1222	terri@davechristianconst.com	377698	A	C12											04/14/21	04/13/22
David A. Bush, Inc.	Jasmine Cooper	559-584-1575	jasmine@bushconstruction.net	492686	A	B	C8	C21									12/22/20	12/21/21
Davis Moreno Construction, Inc.	Stephen Davis	559-275-9410	stephen@davismorenoconstruction.com	804773	A	B	C8	C10	C61	D34							01/04/21	01/03/22
Digital Networks Group, Inc.	Ron Ponce, Felicia McGinn	949-428-6333	biddesk@digitalnetworksgroup.com	822511	C7	C10											11/23/20	11/22/21
Divcon Inc.	John Gandy	559-490-0205	john@divconinc.com	796543	A	B	C7										12/14/20	12/13/21
ECl (Engineered Controls, Inc.)	Richard Malcolm	559-323-9788	richard@ecihvac.com	714317	B	C20	C36	C43	C61	D62	D64						12/30/20	12/29/21
EKC Enterprises, Inc.	Greg Alavezos	559-438-0330	greg@ekccorp.com	916095	C7	C10											05/08/20	05/07/21
Famad Inc. dba Sitologiq	Chris Bristow	916-988-8808	chris.bristow@sitologiq.com	646794	A	B	C4	C10	C20	C36	C43						04/13/21	04/12/22
Elite Landscape Construction, Inc.	Cameron Nelson	559-292-2900	cameronn@eliteteamoffices.com	967955	C27												04/13/21	04/12/22
Fire System Solutions, Inc.	Jorge Moran	559-275-4894	jmoran@firesystemsolutions.com	982763	C10	C16											04/01/21	03/31/22
Fortune-Ratliff General Contractors, Inc.	Adam Myles	559-432-1306	adam@fortuneratcliff.com	496147	B	C8											10/28/20	10/27/21
Four C's Construction	Preston Cross	559-237-3990	preston@fourcsmetal.com	908294	B	C20	C36	C39	C43								02/01/21	01/31/22
Fresno Plumbing & Heating, Inc. (Costal Plumbing)	Wyndie Gibson	559-294-0200	wyndieg@fphinc.com	801642	B	C16	C20	C36									02/04/21	02/03/22
Fresno Roofing Co. Inc.	Edward Duarte	559-255-8377	ed@fresnorooftingco.net	302777	B	C2	C39										01/19/21	01/18/22
GC Builders	Gerardo Campos	559-478-3276	gcbuilders137@yahoo.com	933222	B												07/15/20	07/14/21
Graham Prewett, Inc.	Sean Prewett	559-291-3741	grmpre1@grahamprewett.com	793065	A	B	C33	C39	C43								11/30/20	11/29/21
Haydon Construction, Inc.	Nicole Hensley	559-251-5522	haydonconst@yahoo.com ; haydon.hr@yahoo.com	458977	A												06/30/20	06/29/21
Howe Electric Construction, Inc.	Kirstin Howe Lichtenwalner	559-255-8992	kirstin.howe@howe-electric.com	898737	B	C10	C46										12/18/20	12/17/21
HPS Mechanical, Inc.	Alma Martinez	661-397-2121	planroom@hpsmechanical.com	793014	A	B	C2	C4	C10	C16	C20	C34	C36	C42	C43	C46	03/25/21	03/24/22
Imperial Electric Service	Windell Pascascio Jr.	559-374-6484	windell@imperialelectricserviceinc.com	1015336	C10												01/05/21	01/04/22
J. Boone Mechanical, Inc.	Jim Boone	559-207-3470	jim@jboonemechanical.com	1302006	A	B	C4	C36	C38	C43							01/14/21	01/13/22
J. I. Garcia Construction, Inc.	Joseph V. Garica Karen Acosta	559-276-7726	joeg@jigarcia.com ; karena@jigarcia.com	556003	A	B											12/30/20	12/29/21
J. Noble Binns Plumbing Co., Inc.	Michelle Heinrichs	661-615-6101	michelle@binnsplumbing.com	481544	C4	C16	C34	C36	C55								09/21/20	09/20/21
Jarrett Electric, Inc.	Melissa Sweaney	661-327-8046	melissa@cjelectric.net	667401	C10												09/18/20	09/17/21
Jerico Fire Protection Company Inc.	Chris Miller	559-255-6446	chris@jericofire.com	548570	C16												03/22/21	03/21/22
Johnson Plumbing Industrial, Inc.	Jenifer Cunningham	209-384-1566	jen@johnsonindustrial.net	526086	C36												09/21/20	09/20/21
Katch Environmental Inc.	Paul Katchadoorian	559-292-6653	paul@katchenvironmental.com	933096	A	B											02/01/21	01/31/22
Kings County Air Conditioning, Inc.	Mark Mathis	559-584-4383	mark@kcairinc.com	828256	B	C20	C43										11/23/20	11/22/21
Kitcor Corporation	Kent Kitchen	818-767-4800	kentkitchen@kitcor.com ; ruby@kitcor.com	244236	C43												10/21/20	10/20/21
Klassen Corporation	Katie Angevine	661-324-3000	katiea@klassencorp.com	350573	B	C8	C51										04/22/20	04/21/21
Lawson Mechanical Contractors	Megan McCarthy	916-381-5000	mmccarthy@lawsonmechanical.com	178385	A	B	C2	C4	C16	C20	C36	C38	C43				12/22/20	12/21/21
Lindsay Electric (Steven Lindsay)	Steve Lindsay	559-281-6308	steve@lindsay-electric.com	932850	C10												11/18/20	11/17/21

PREQUALIFICATION CONTRACTORS LIST
(\$1 MILLION + PROJECTS)
AS OF APRIL 14, 2021


LPC Automation Inc.	Joe Calaflore	888-742-5572	joec@lpcautomation.com	886516	C10											12/28/20	12/27/21
Magnetar.us, Inc.	Greg Hardin	559-477-41347	sales@magnetar.us	904637	B	C7	C10									02/04/21	02/03/22
Mark III Construction, Inc.	Christina Kell	916-381-8080	estimating@mark-three.com	941726	A	B	C4	C7	C10	C16	C20	C36				05/26/20	05/25/21
Mark Wilson Construction Co., Inc.	Doug Reitz	559-348-0421	doug@markwilsonconstruction.com	774987	B											01/21/21	01/20/22
Marko Construction Group, Inc.	Paul K. Gong	559-222-7888	pkgong@markoconstruction.com	831764	A	B	C39									12/07/20	12/06/21
Mesa Energy Systems, Inc.	Rod Galvan	559-277-7900	mesanaservice@emcorgroup.com	611215	B	C4	C7	C10	C20	C36	C38	C46				03/15/21	03/14/22
Meyers Constructors, Inc.	Emily Mayoral	559-473-0014	emily@meyersconstructors.com	1004811	B	C51										10/13/20	10/12/21
Michael Cole Electric	Michael Cole	559-298-6464	mcecski@aol.com	625324	C10											01/11/21	01/10/22
Modern Air Mechanical	Dan Kumetat	209-722-0076	dan@modernair.biz ; est@modernair.biz	569680	C20	C38	C43									07/01/20	06/30/21
Morris Levin and Son	Haley White; Del Freitas	559-686-8561	hwhite@morrislevin.com ; dfreitas@morrislevin.com	167881	C2	C10	C34	C36	C38	C42	C60					10/26/20	10/25/21
Nations Roof West, LLC	Sean Rauch	559-252-1255	srauch@nationsroof.com	1012378	C39	C43										12/04/20	12/03/21
New England Sheet Metal and Mechanical Co.	John D. Sloan	559-268-7375	jsloan@nesm.com	433674	A	B	C4	C20	C36	C38	C43					01/19/21	01/18/22
Nolte Sheet Metal, Inc.	Ernie Nolte	559-275-1246	natalie@noltesheetmetal.com	438796	C20	C38	C43									02/09/21	02/08/22
Otavilla Mechanical Contractors Inc.	Mike Allivato	831-609-3000	mike@otavillamechanical.com	968640	C20											02/23/21	02/22/22
Patton Sheet Metal Works dba Patton Air Conditioning	Pat Shattuck	559-486-5222	pshattuck@pattonac.com ; jfortmeyer@pattonac.com	256026	B	C4	C20	C36	C38	C43						05/20/20	05/19/21
PCD	Christian Velasquez	707-546-3633	cvelasquez@pcdinc.net	527657	C7	C10										03/31/21	03/30/22
Power Design Electric, Inc.	Gabriel Lopez; Robert Glover	559-897-2599	glopez@powerdesignelectric.com ; robert@powerdesignelectric.com	851246	C10											09/21/20	09/20/21
Presidential Fire Protection, Inc.	Samantha Nigliazzo	916-379-9199	samantha@presidentialfireprotection.com	847133	C16											05/18/20	05/17/21
Pro-Craft Construction, Inc.	Estimating Department	909-790-5222	estimating@procraftci.com	467234	A	B	C2	C16	C34	C36	C42					02/16/21	02/15/22
R L H Fire Protection, Inc.	Bonnie Roberts	661-410-1321	broberts@rlhfp.com	777717	C10	C16										09/21/20	09/20/21
Rakkar Development & Construction	Tajinder Rakkar	559-994-9482	taj@rpccompanies.com	1037594	B											01/12/21	01/11/22
Red Moore Group, Inc.	Matthew Amato	559-538-5972	matthew.amato@rexmoore.com	976827	B	C10										04/28/20	04/27/21
San Joaquin Fire Protection Inc.	Georgia Sani	559-292-7111	georgia@sifpmail.com	775461	C16											04/17/20	04/16/21
Schreder & Brandt Mfg. Inc.	Carolyn Atkinson	530-899-1104	carolyn@schrederandbrandt.com	748129	A	B										02/16/21	02/15/22
Schultz Industries, Inc. dba Sturdisteel Company	Ruth Lopez	800-433-3116	rlopez@sturdisteel.net	727715	A											09/02/20	09/01/21
Seal Rite Paving (Witbro, Inc.)	Brooke Ashjian	559-222-7325	bids@sealritepaving.com	805585	A											02/10/21	02/09/22
Seals Construction, Inc.	Nick Seals	559-651-4040	nick.seals@sealsconstruction.com	949738	A	B										11/20/20	11/19/21
Silver Creek Industries, LLC.	Dani Shaughnessy	951-943-5393	dshaughnessy@silver-creek.net	855259	B	C10	C20	C27	C36							03/22/21	03/21/22
Simco Mechanical, Inc.	Alexander J. Harbachian	818-957-4994	alex@simcomechanical.com	974288	C20											04/15/20	04/14/21
Smith Mechanical-Electrical-Plumbing (Brannon/Smith Electric)	Michael Brannon	805-621-5000	mb@smith-electric.com	420418	A	B	C2	C4	C7	C9	C10	C16	C20	C36	C43	09/08/20	09/07/21
Soltek Pacific Const. Co. (Solpac Constr., Inc.)	Kevin M. Cammall	619-296-6247	marketing@soltekpacific.com	886641	A	B										02/04/21	02/03/22

PREQUALIFICATION CONTRACTORS LIST

(\$1 MILLION + PROJECTS)

AS OF APRIL 14, 2021

Southern Bleacher Company, Inc.	David McClendon	940-549-0733	herndon@southernbleacher.com	564497 A	03/30/21	03/29/22
Starace Mechanical Heating & Air Cond.	Martino Starace	559-686-4312	staracemechanical@gmail.com	933756 C20 C43	05/08/20	05/07/21
Steven's Electrical Contracting	Steven Harris	559-363-9776	stevens3639776@gmail.com	661442 C10	12/30/20	12/29/21
Stockbridge General Contracting, Inc.	Guy Stockbridge	559-292-2900	guys@eliteteamoffices.com	967612 A B C8 C27 C61 D9 D34	04/06/21	04/05/22
Strategic Mechanical, Inc.	Chad Petty	559-291-1952	cpetty@strategicmech.com	834679 B C2 C4 C10 C16 C20 C23 C36 C38 C42 C43 C51 C60	12/28/20	12/27/21
T.P. Thomas Plumbing, Inc.	Mike Lansford	559-591-6499	mike@tptplumbing.com	613719 C36	12/18/20	12/17/21
Todd Companies (JT2)	James Todd	559-651-5820	jt2@jt2inc.com	788798 A C21 C36 D6	04/23/20	04/22/21
Turner Construction Company	Drake Costa	916-956-1206	dcosta@tcco.com	210639 A B	04/20/20	04/19/21
Valley Precision Grading, Inc.	Kristofer Olson	916-638-8800	kip@vpgrading.com	783244 A C61 D12	08/20/20	08/19/21
Valley Unique Electric, Inc.	Mark Worthington	559-237-4795	mark@valleyunique.com	464539 C10	09/11/20	09/10/21
Westech Systems, Inc.	Helder Domingos, Darin Culberson	559-455-1720	hd@westechsys.com ; dc@westechsys.com	739791 C10 C46	12/22/20	12/21/21
Wild Electric, Incorporated	Craig Newton	559-251-7770	cnewton@wildelectric.net	500696 C10	02/18/21	02/17/22
Zumwalt Construction, Inc.	Robert McKnight	559-252-1000	rmcknight@zumwaltconst.com	706140 B	06/25/20	06/24/21

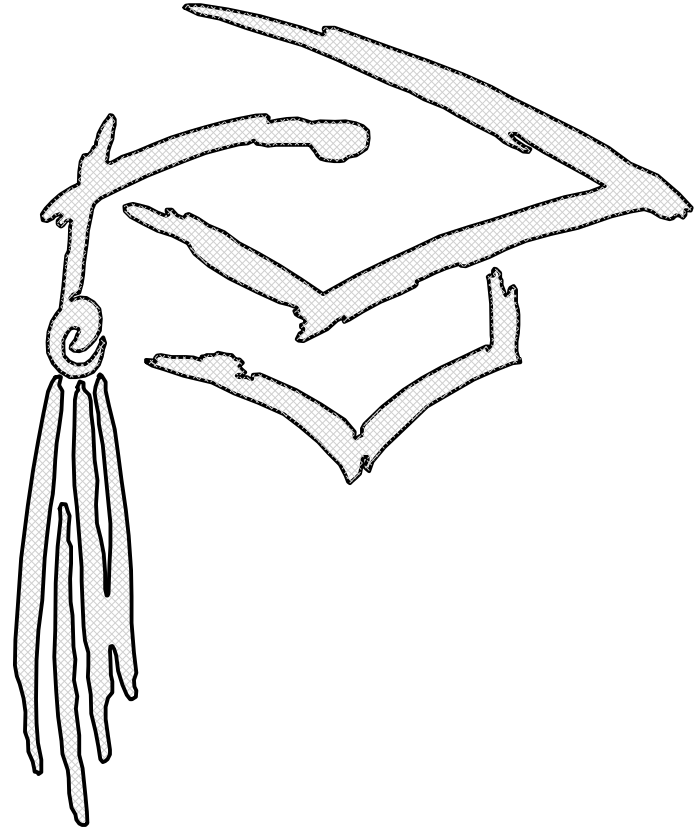

FRESNO UNIFIED SCHOOL DISTRICT

EATON ELEMENTARY SCHOOL

EMS REPLACEMENT

1451 EAST SIERRA AVE.
FRESNO, CALIFORNIA

OWNER
FRESNO UNIFIED SCHOOL DISTRICT

4600 N. BRAWLEY AVE.
FRESNO, CA 93722
(559) 457-3064

CONTACT: DANNY ANDERSON

MECHANICAL ENGINEER
LAWRENCE ENGINEERING GROUP

7084 NORTH MAPLE AVE. SUITE 101
FRESNO, CA 93720
(559) 431-0101

CONTACT: MIKE CANTELM

ELECTRICAL ENGINEER
HARDIN-DAVIDSON ENGINEERING, INC.
356 POLLASKY AVE. SUITE 200
CLOVIS, CA 93612
(559) 323-4995




CONTACT: RICH HARDIN

GENERAL NOTES:

- ALL WORK SHALL CONFORM TO 2019 EDITION TITLE 24, CALIFORNIA CODE OF REGULATIONS (CCR).
- CHANGE TO THE APPROVED DRAWINGS AND SPECIFICATIONS SHALL BE MADE BY ADDENDA OR CONSTRUCTION CHANGE DOCUMENT (CCD) APPROVED BY DSA, AS REQUIRED BY SECTION 4-338, PART 1, TITLE 24, CCR.
- A "DSA CERTIFIED" PROJECT INSPECTOR EMPLOYED BY THE DISTRICT (OWNER) AND APPROVED BY DSA SHALL PROVIDE CONTINUOUS INSPECTION OF THE WORK. THE DUTIES OF THE INSPECTOR ARE DEFINED IN SECTION 4-342, PART 1, TITLE 24, CCR. PROJECT REQUIRES A CLASS 3 INSPECTOR.
- A DSA ACCEPTED TESTING LABORATORY DIRECTLY EMPLOYED BY THE DISTRICT (OWNER) SHALL CONDUCT ALL THE REQUIRED TESTS AND INSPECTIONS FOR THE PROJECT.
- THE INTENT OF THESE DRAWINGS AND SPECIFICATIONS IS THAT THE WORK OF THE ALTERATION, REHABILITATION OR RECONSTRUCTION IS TO BE IN ACCORDANCE WITH TITLE 24, CCR. SHOULD ANY EXISTING CONDITIONS SUCH AS DETERIORATION OR NON-COMPLYING CONSTRUCTION BE DISCOVERED WHICH IS NOT COVERED BY THE CONTRACT DOCUMENTS WHEREIN THE FINISHED WORK WILL NOT COMPLY WITH TITLE 24, CCR, A CONSTRUCTION CHANGE DOCUMENT (CCD), OR A SEPARATE SET OF PLANS AND SPECIFICATIONS, DETAILING AND SPECIFYING THE REQUIRED WORK SHALL SUBMITTED TO AND APPROVED BY DSA BEFORE PROCEEDING WITH THE WORK. (SECTION 4-317(C), PART 1, TITLE 24, CCR)

PROJECT NOTES:

- PROVIDE ALL NEW CONTROL WIRE.
- PROVIDE ALL NEW ACTUATORS & SENSORS. RETURN EXISTING ACTUATORS TO DISTRICT.
- PROVIDE A NEW OUTSIDE AIR TEMPERATURE SENSOR AT EACH MULTI-ZONE.
- PROVIDE NEW CONTROLS FOR ALL EXHAUST FANS.
- PROVIDE NEW CONTROLS FOR EXTERIOR LIGHTING. REFER TO FLOOR PLAN SHEETS. MOUNT HARDWARE IN NEW LOCKABLE ENCLOSURES.
- PROGRAMMING SHALL BE IN THE CONTROLLERS AT THE UNIT, NOT THE FRONT END. THE FRONT END IS A MONITORING STATUS, ON-OFF DEVICE ONLY.
- WIRING IN ATTICS SHALL BE SUPPORTED ON J-HOOKS. NO WIRING ON ROOF.
- SALVAGE ALL CONTROL EQUIPMENT AND RETURN TO OWNER.
- PROVIDE AND INSTALL A 20A/1P, DUPLEX RECEPTACLE WITH CIRCUIT AND CIRCUIT BREAKER FROM THE NEAREST 120 VOLT PANEL IS 80-FEET AWAY FIELD LOCATE. PROVIDE POWER CONNECTIONS TO EACH ENERGY MANAGEMENT RIB. REFER TO MECHANICAL/EMS PLANS FOR EQUIPMENT LOCATIONS.
- CONTRACTOR MAY REUSE (E) CONTROLLER ENCLOSURE WHERE FEASIBLE.

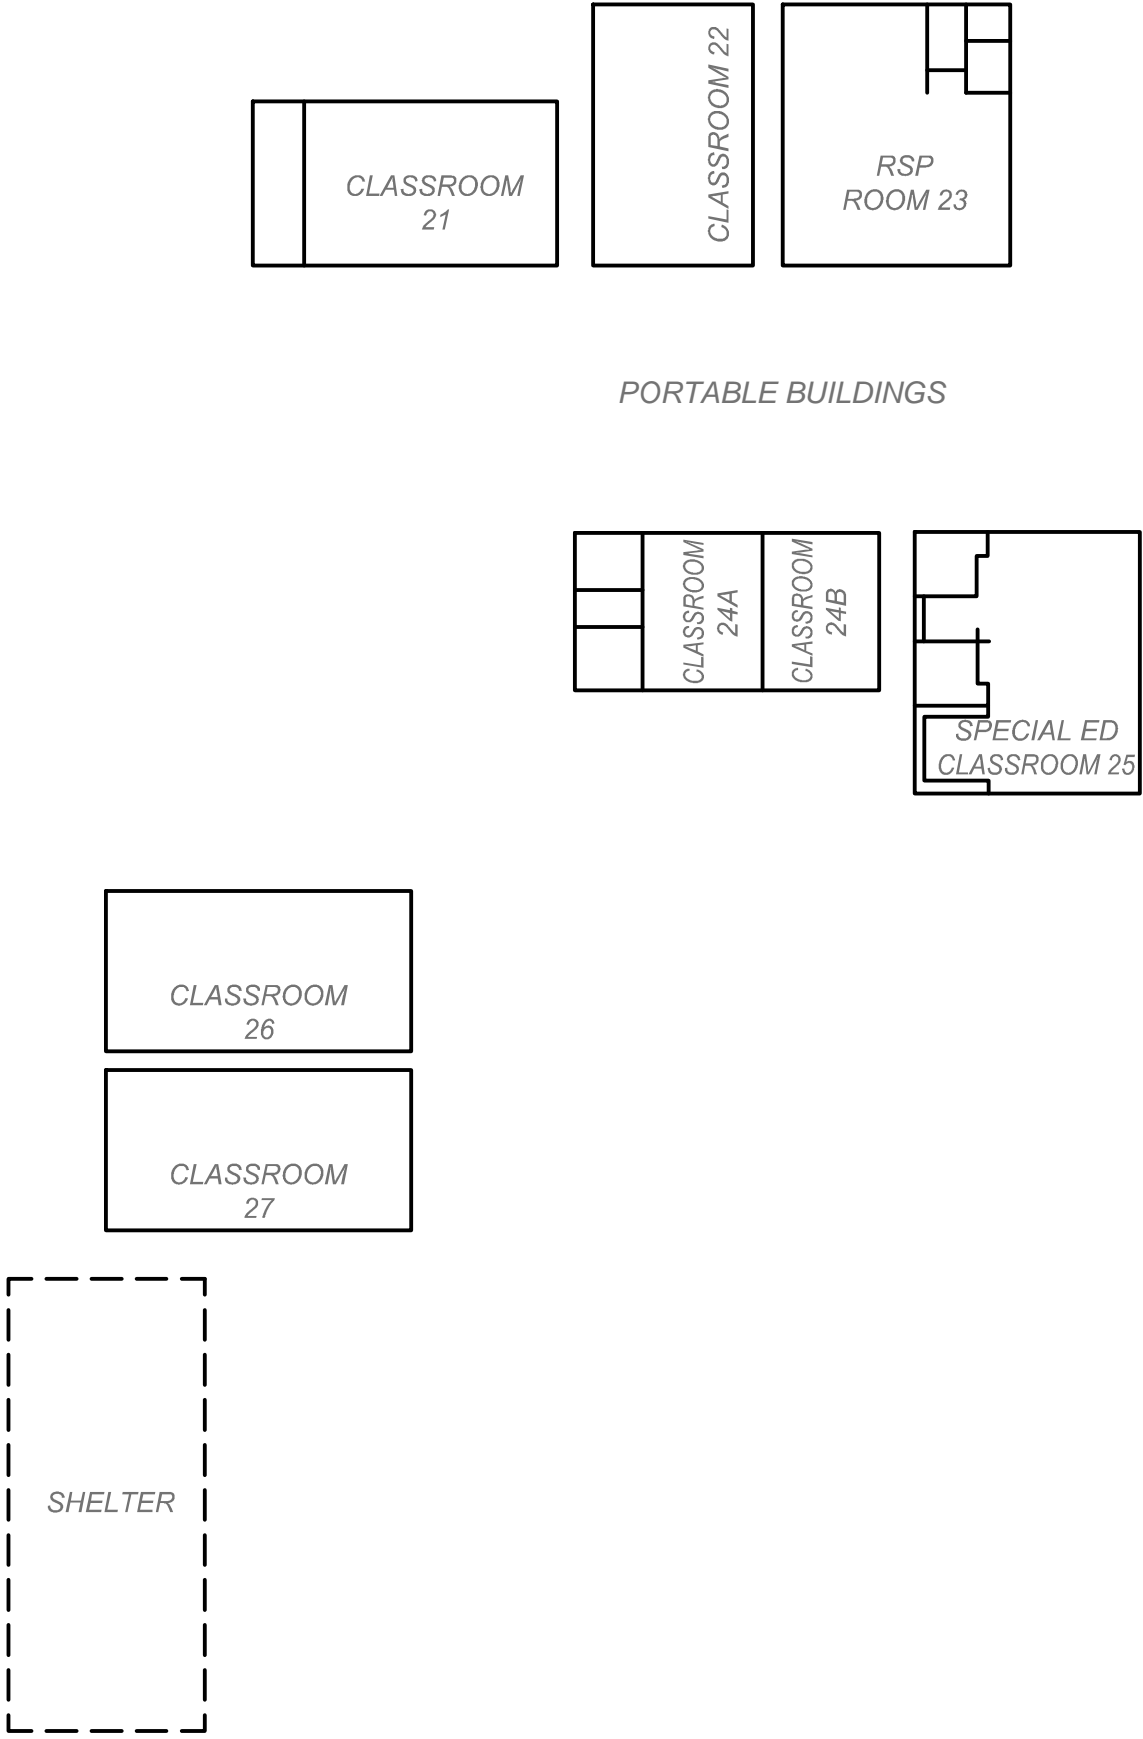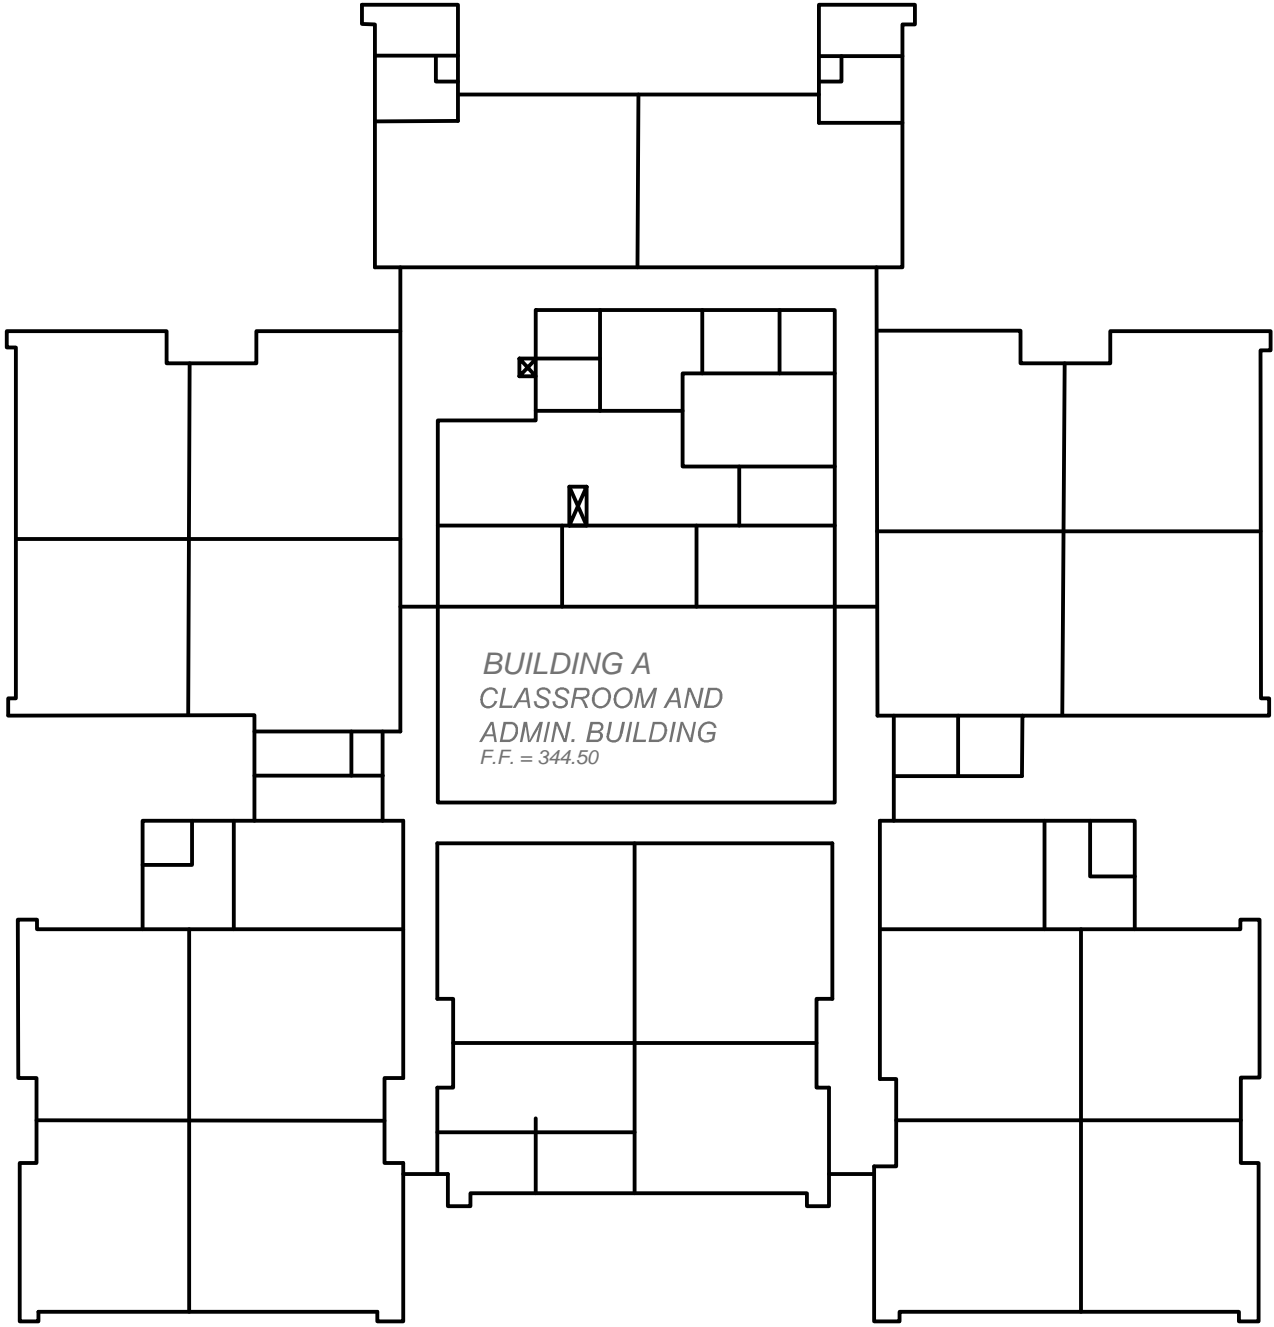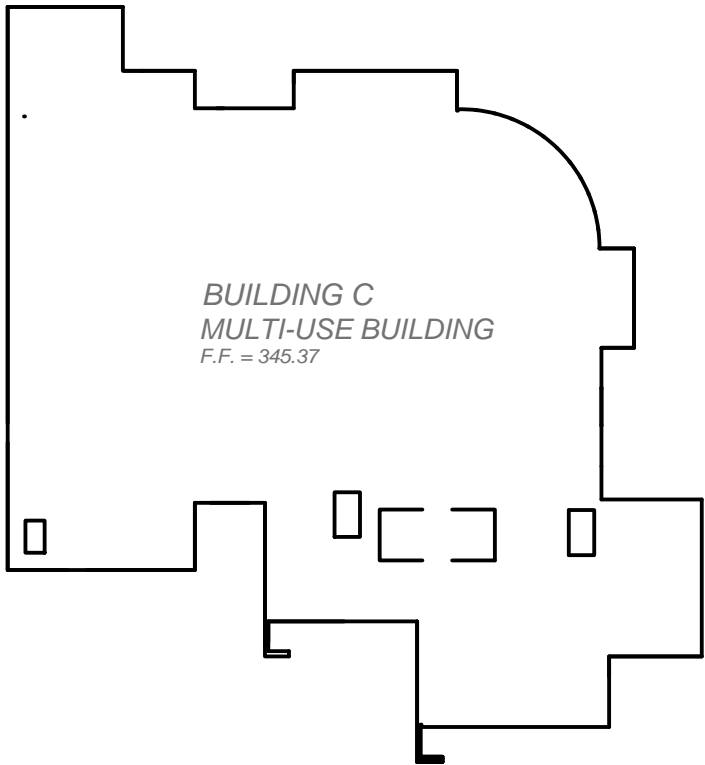

SHEET INDEX		
MECHANICAL		SHEET COUNT
G1	COVER SHEET	1
M1	BUILDING A - EMS PLAN	2
M2	BUILDING C - EMS PLAN	3
M3	PORTABLE BUILDING - EMS PLAN	4
M4	ENERGY MANAGEMENT DETAILS	5
M5	ENERGY MANAGEMENT DETAILS	6
M6	ENERGY MANAGEMENT DETAILS	7
M7	ENERGY MANAGEMENT DETAILS	8
M8	ENERGY MANAGEMENT DETAILS	9
M9	ENERGY MANAGEMENT DETAILS	10
M10	ENERGY MANAGEMENT DETAILS	11
ELECTRICAL		
E1	ELECTRICAL SYMBOLS AND NOTES	12
E2	ELECTRICAL PLAN	13
SHEET COUNT TOTAL:		13

SCOPE OF WORK	
THE SCOPE OF WORK IS AS INDICATED BY THE CONTRACT DRAWINGS AND SPECIFICATION AND IS SUMMARIZED AS FOLLOWS:	
<ul style="list-style-type: none">REPLACE EXISTING DDC CONTROLS w/(N) JOHNSON CONTROLS FX-80REPLACE AND UP SIZE EXISTING MULTI-ZONE UNIT SUPPLY AND RETURN / EXHAUST FAN WITH NEW MOTOR & VFD. SEE PLANS FOR SIZE & ELECTRICAL DRAWINGS.PROVIDE AN EXISTING CONDITION DUCT TRAVERSE FOR EACH SUPPLY ZONE, OUTSIDE AIR, & RETURN AIR ON MULTI-ZONE UNIT MZU-1, MZU-2, MZU-3 AND MZU-4 PRIOR TO START OF WORK AND ALSO UPON PROJECT COMPLETION.	

APPLICABLE CODES

2019 California Administrative Code - CCR Title 24, Part 1
2019 California Building Code - CCR Title 24, Part 2
2019 California Electrical Code - CCR Title 24, Part 3
2019 California Mechanical Code - CCR Title 24, Part 4
2019 California Plumbing Code - CCR Title 24, Part 5
2019 California Energy Code - CCR Title 24, Part 6
2019 California Fire Code - CCR Title 24, Part 9
2019 Existing Building Code - CCR Title 24, Part 10
2019 California Green Code - CCR Title 24, Part 11
2019 California Reference Code - CCR Title 24, Part 12
Title 19 CCR Public Safety, State Fire Marshall Regulations
2019 NFPA 72 for Fire Alarm System.
CFC CH 33 Fire Safety During Construction and Demolition



BLDG SITE PLAN

SCALE: 1" = 30'-0"

APPROVALS:
APPLICATION #
77777777



DATE: 11-25-2020

EMS REPLACEMENT
EATON ELEMENTARY SCHOOL
1451 EAST SIERRA AVE. FRESNO, CA
FRESNO UNIFIED SCHOOL DISTRICT
4600 N. BRAWLEY AVE. FRESNO, CA.

REVISIONS	4/22/21	EMS REVISIONS
1		
2		
3		
4		
5		

LAWRENCE
ENGINEERING GROUP
Fresno, CA 93720
7084 N. Maple Ave., Suite 101
(559) 431-0101
FAX (559) 431-1362

TITLE: COVER

SHEET: G1
PROJECT: 20138



DATE: 11-25-2020

EMS REPLACEMENT
EATON ELEMENTARY SCHOOL
1451 EAST SIERRA AVE. FRESNO, CA
FRESNO UNIFIED SCHOOL DISTRICT
4600 N. BRAWLEY AVE. FRESNO, CA.

REVISIONS
4/22/21 EMS REVISIONS
1
2
3
4
5


LAWRENCE
ENGINEERING GROUP
Fresno, CA 93720
(559) 431-1362
7084 N. Maple Ave., Suite 101
(559) 431-0101

TITLE:
BUILDING
"A" EMS
PLAN

SHEET:
M1
PROJECT 20138

KEYNOTES: (THIS SHEET ONLY)

- LOCATION OF (N) FX80. REFER TO DETAIL A/M-5.
- (E) HIGH WALL MOUNTED SPLIT HEAT PUMP WITH ODU ON ROOF.
- (E) MULTI-ZONE AIR HANDLER ON ROOF.
- ZONE
- ZONE
- EXHAUST FAN ON ROOF.
- ZONE
- ZONE
- REMOVE AND REPLACE (E) FAN MOTOR & ACCESSORIES w/(N) ALLEN BRADLEY VFD & COMPATIBLE MOTOR. PRE & POST AIR FLOW MEASUREMENTS TO MATCH. PROVIDE REPORTS TO MEOR.

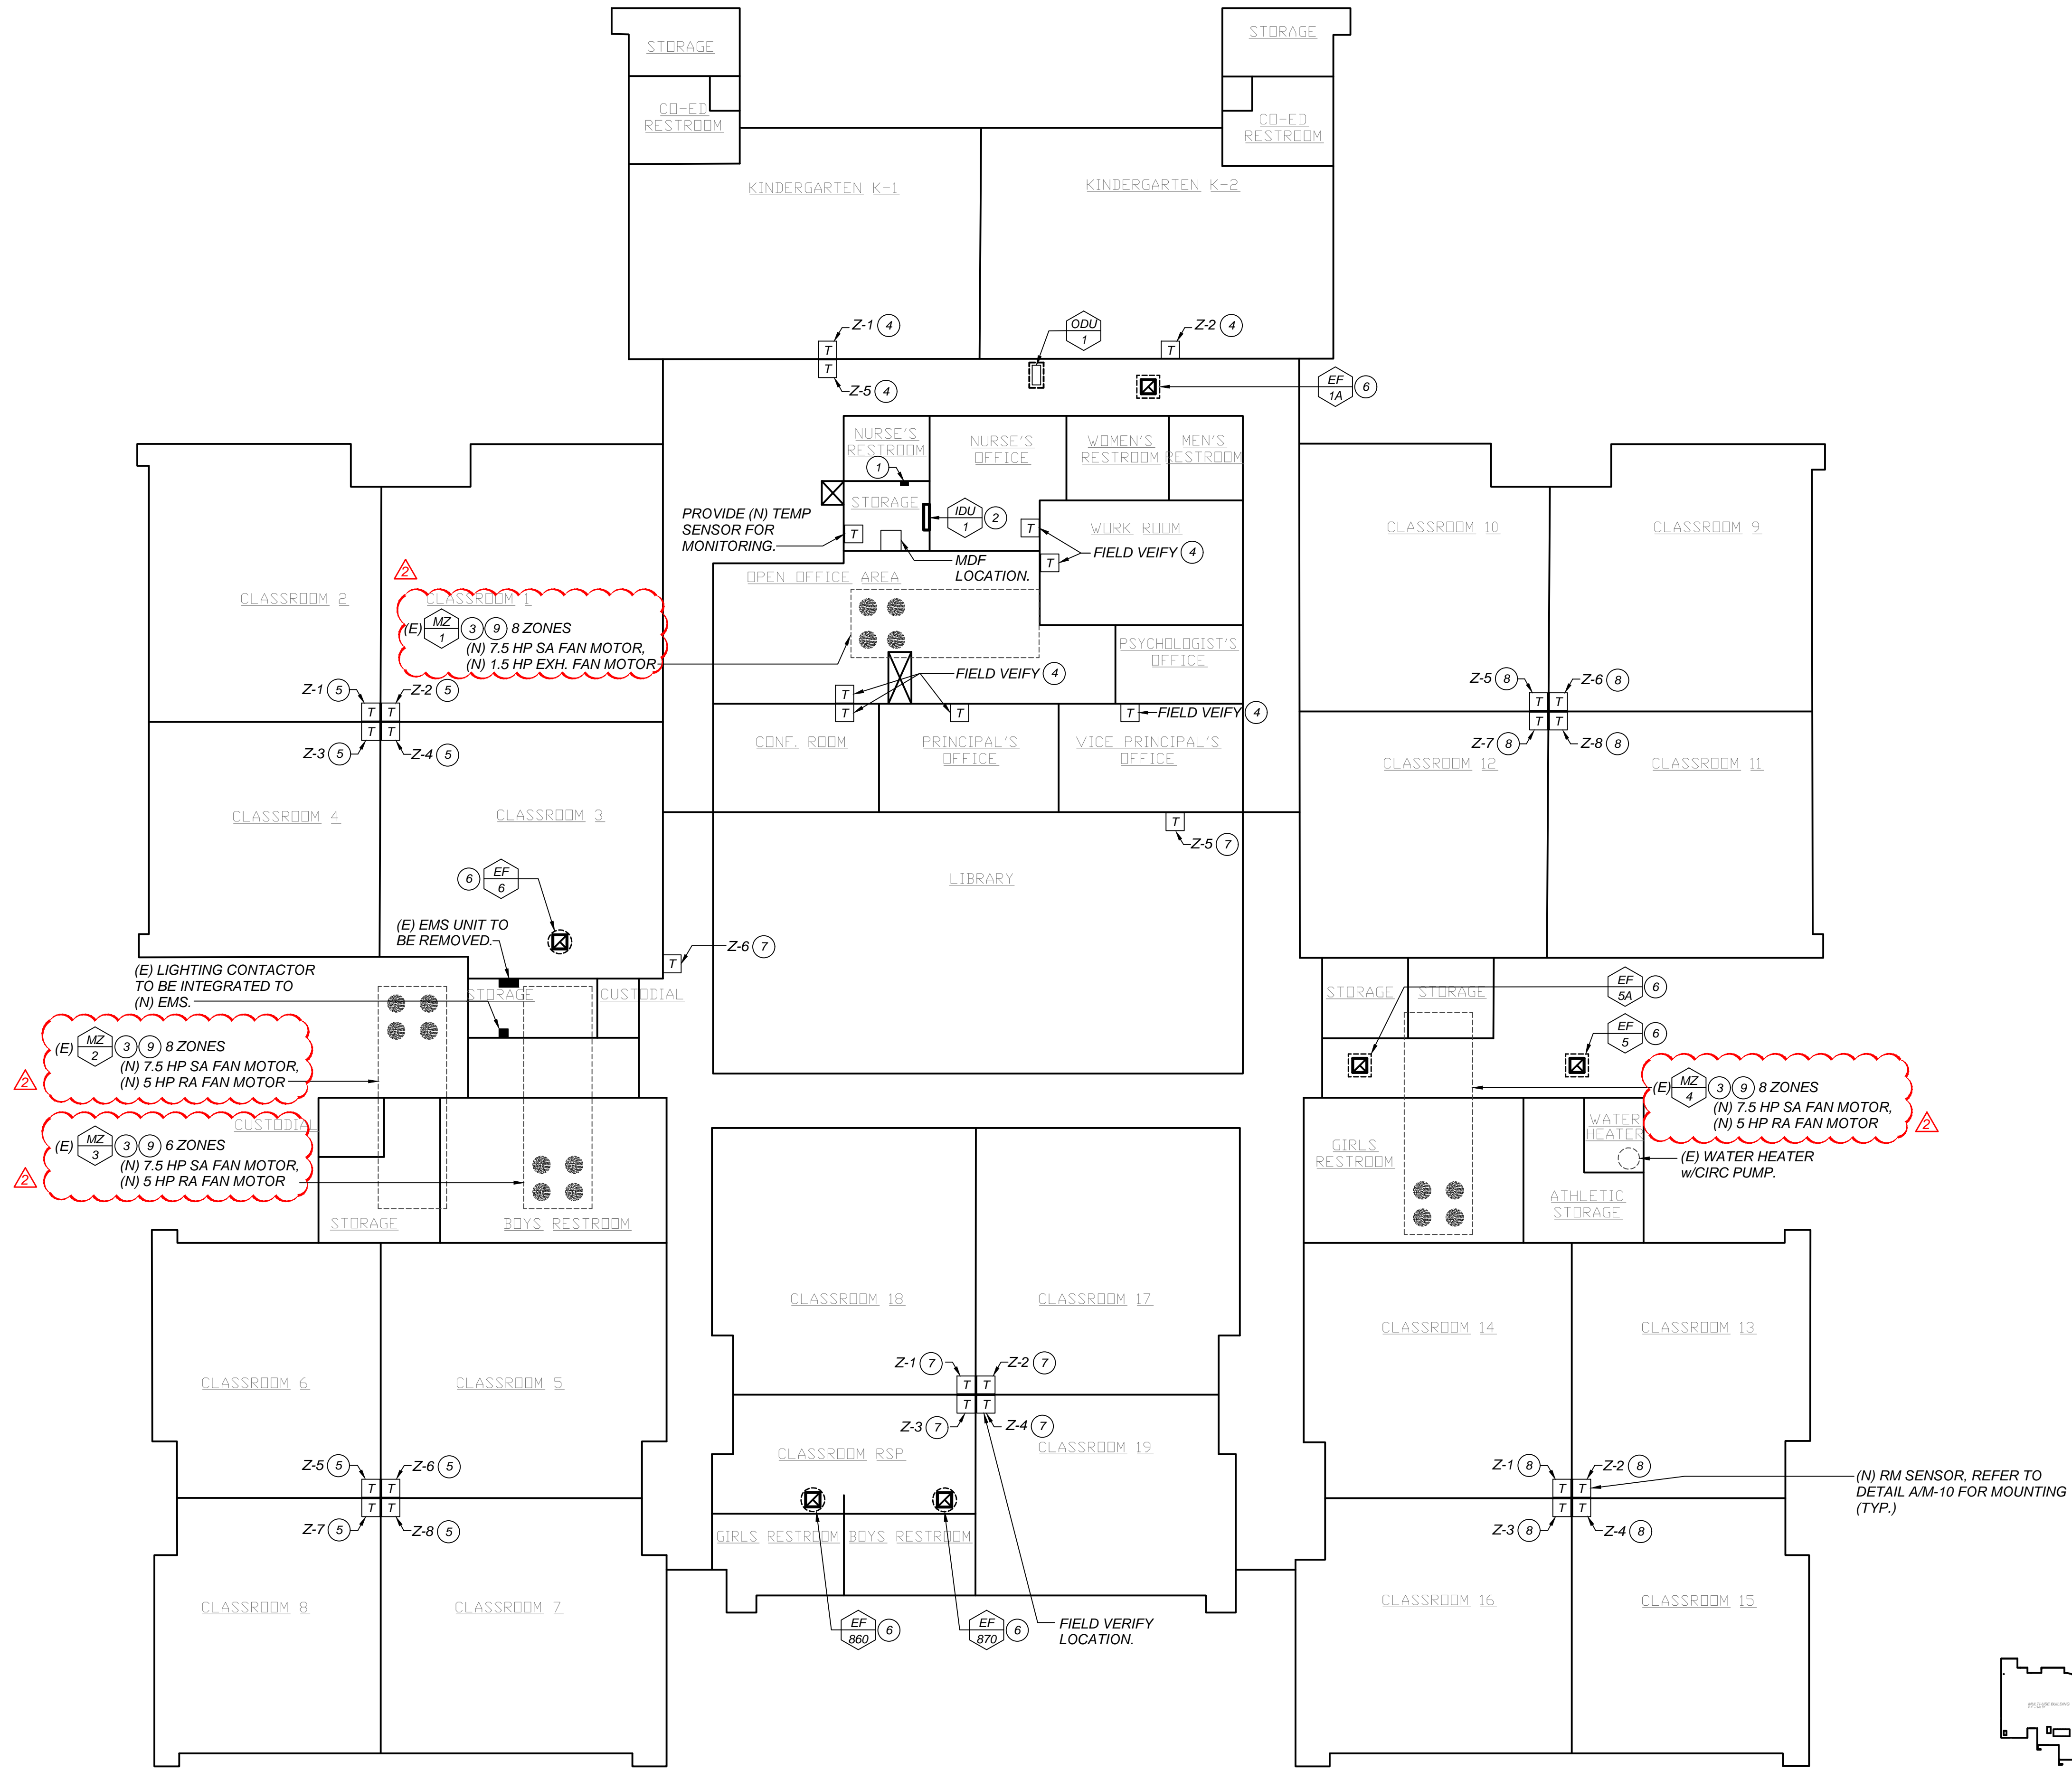


KEY PLAN



BLDG. A - CLASSROOM & ADMIN. BUILDING

SCALE: 3/32"=1'-0"

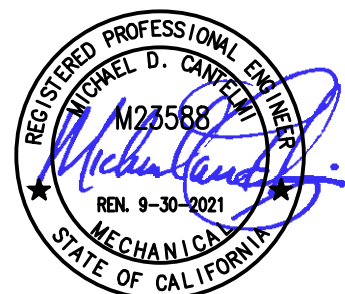

EMS REPLACEMENT
EATON ELEMENTARY SCHOOL
1451 EAST SIERRA AVE. FRESNO, CA
FRESNO UNIFIED SCHOOL DISTRICT
4600 N. BRAWLEY AVE. FRESNO, CA.

REVISIONS
42221 EMS REVISIONS


LAWRENCE
ENGINEERING GROUP
Fresno, CA 93720
(559) 431-1362
7084 N. Maple Ave., Suite 101
(559) 431-0101

TITLE:
BUILDING
"C" EMS
PLAN


SHEET:
M2
PROJECT 20138

KEYNOTES: (THIS SHEET ONLY)


- (E) PACKAGE AIR UNIT ON ROOF.
- (E) EXHAUST FAN ON ROOF.
- (E) AIR COOLED CONDENSER ON ROOF.
- (E) CIRCULATION PUMP TO BE INTEGRATED TO EMS THROUGH NEAREST CONTROLLER.
- (E) DX COOLING COIL w/ (E) ON ROOF, & (E) FURNACE.
- (E) ELECTRIC DUCT HEATER TO BE ENABLED BY HC/3 & CONTROLLED BY WALL MOUNTED THERMOSTAT.

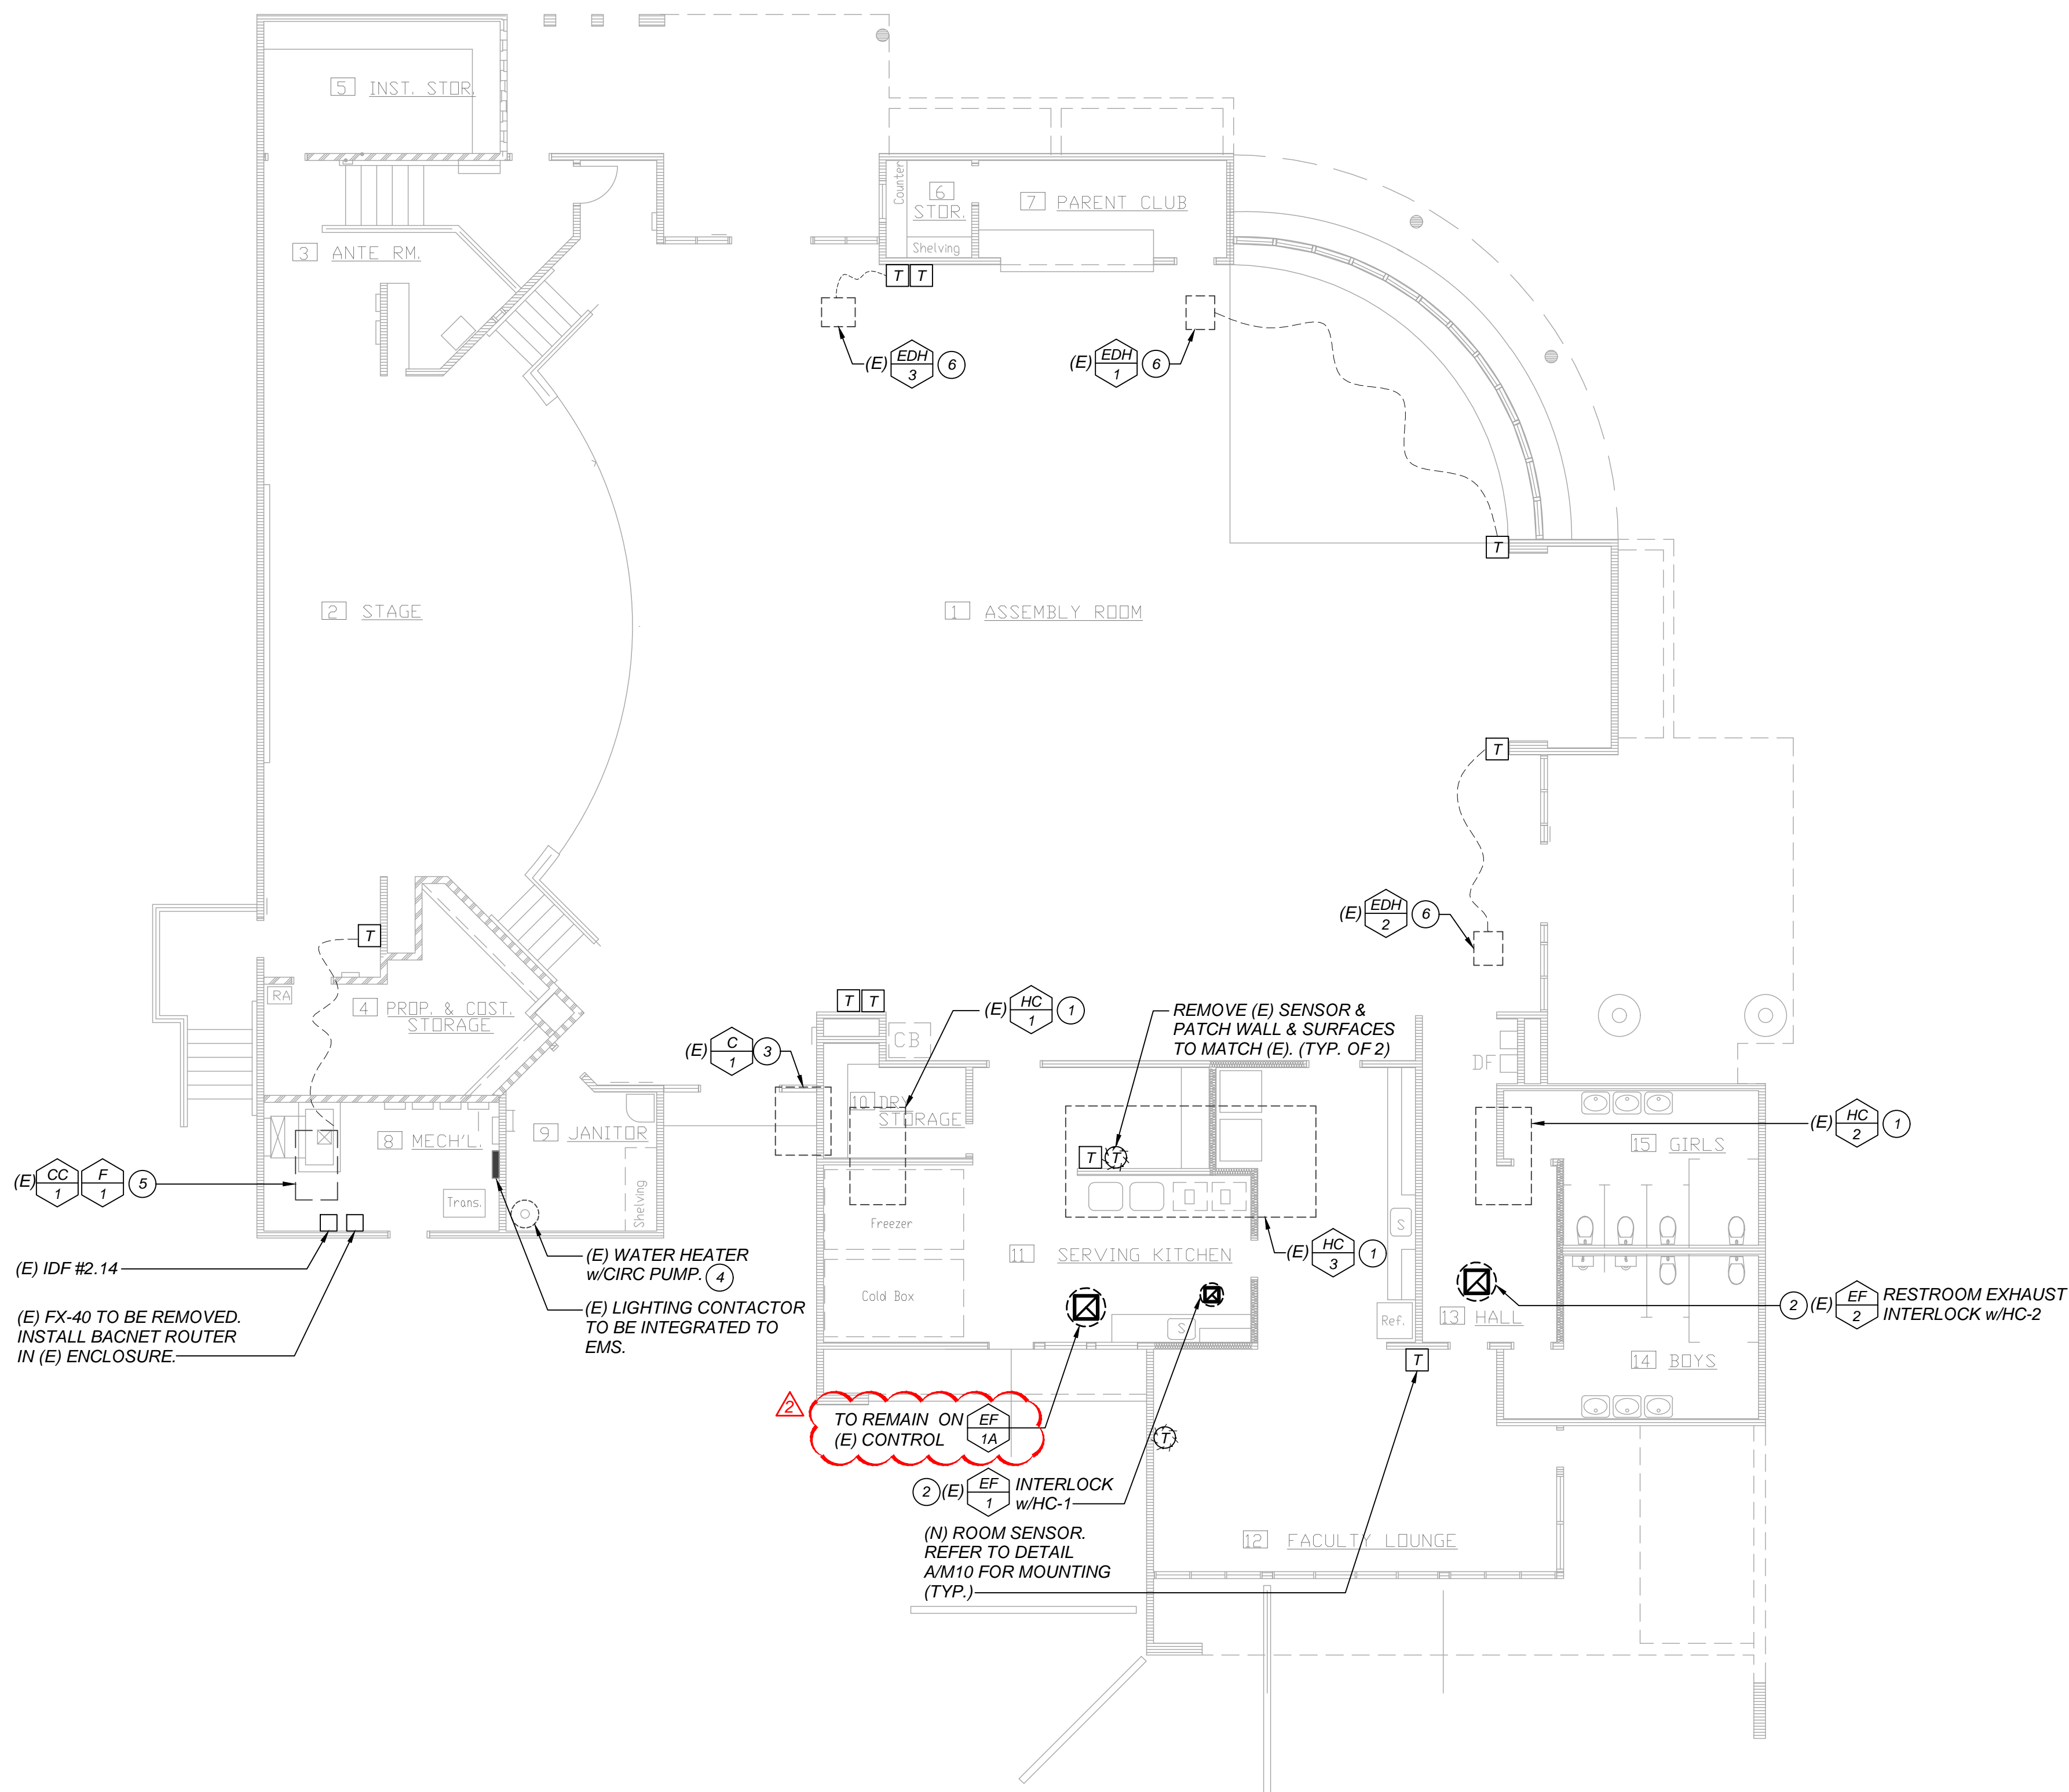

BLDG. C - MULTI-PURPOSE ROOM
SCALE: 1/8" = 1'-0"

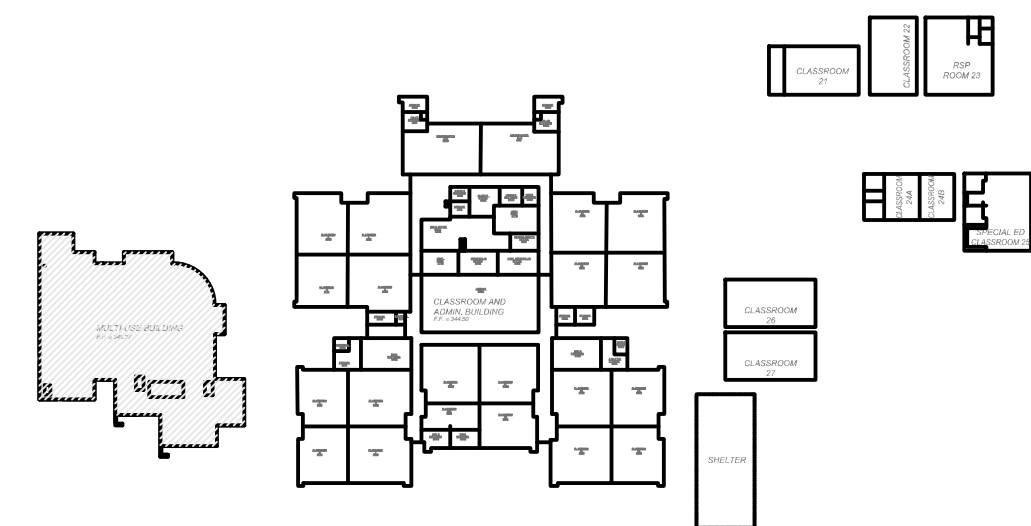

KEY PLAN

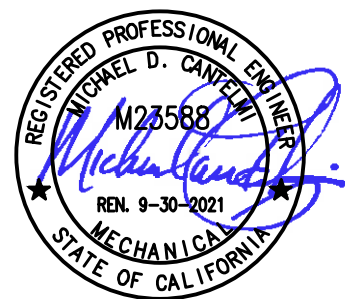

EMS REPLACEMENT
EATON ELEMENTARY SCHOOL
1451 EAST SIERRA AVE. FRESNO, CA
FRESNO UNIFIED SCHOOL DISTRICT
4600 N. BRAWLEY AVE. FRESNO, CA.

REVISIONS	4/22/21	EMS REVISIONS
Δ		
Δ		

LAWRENCE

ENGINEERING GROUP




7084 N. Maple Ave., Suite 101
Fresno, CA 93720
(559) 431-0101
FAX (559) 431-1362

TITLE:
PORTABLE
BUILDINGS
EMS PLAN

SHEET:
M3
PROJECT 20138

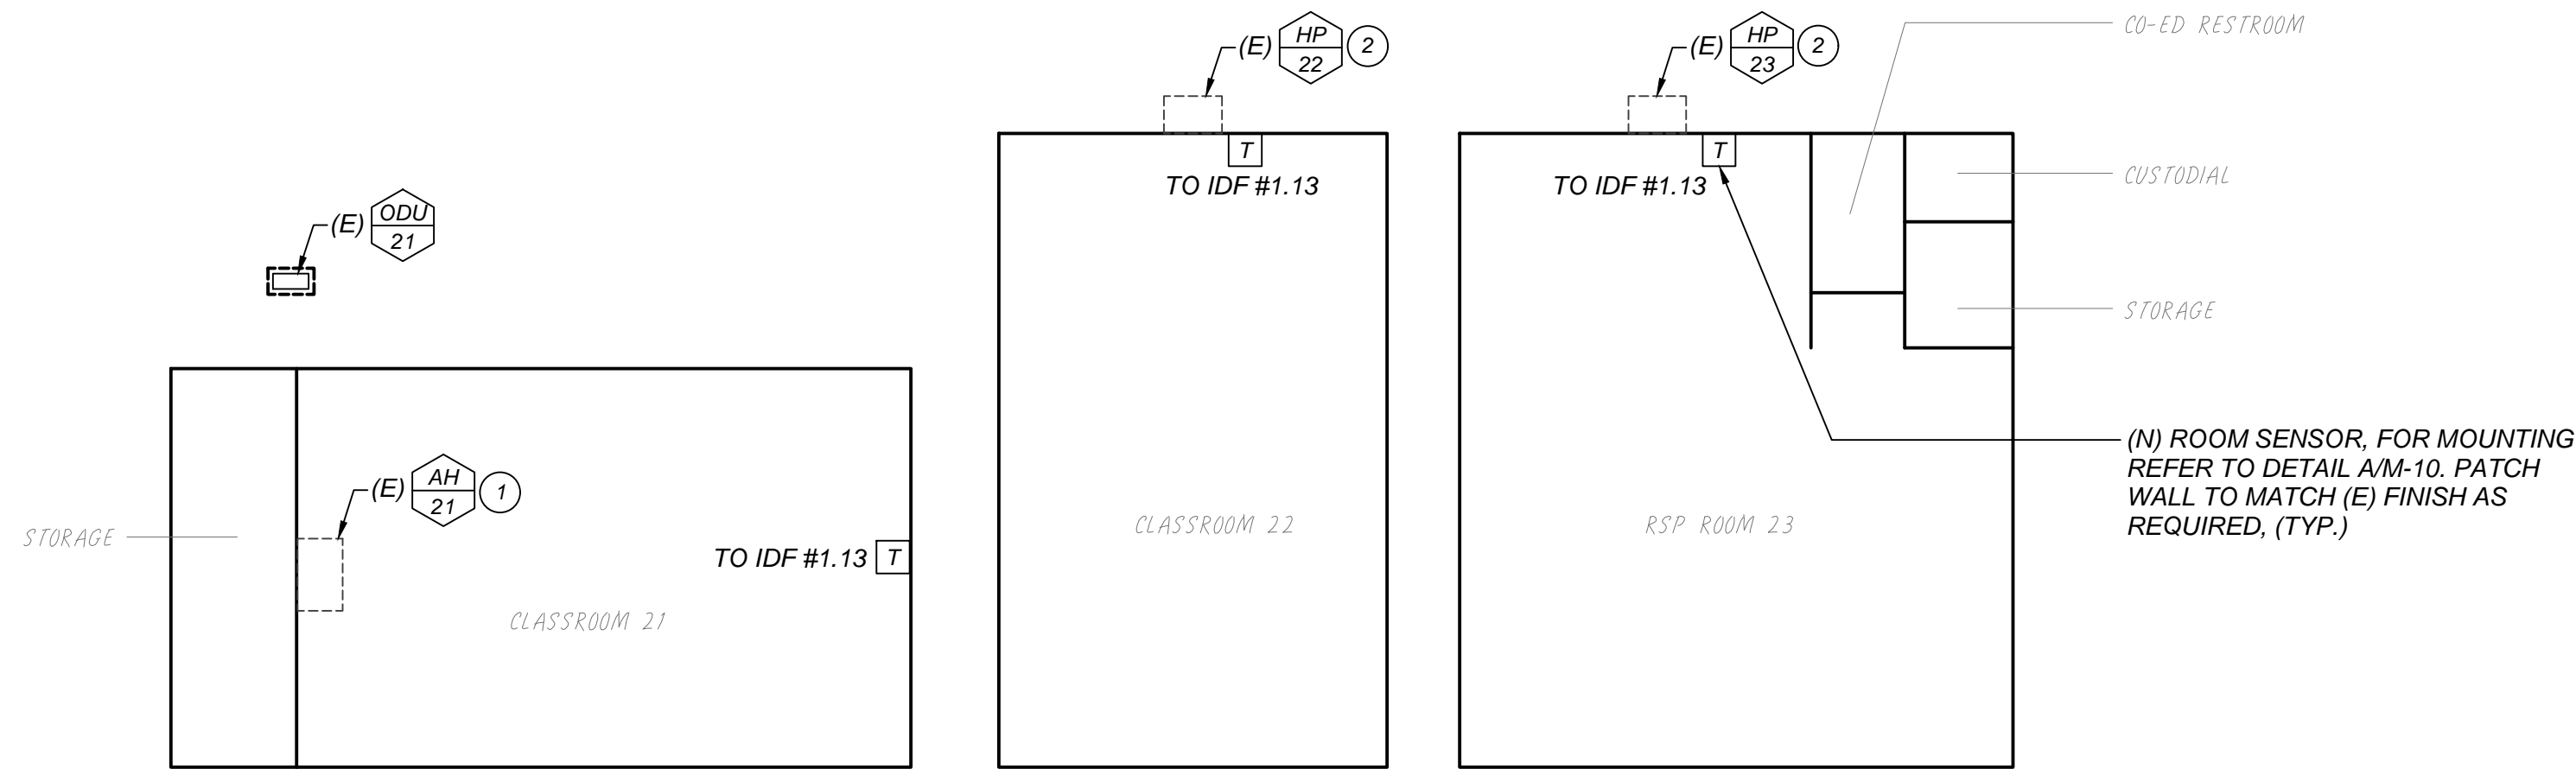


- KEYNOTES: (THIS SHEET ONLY)
- ① SPLIT SYSTEM WITH GAS FURNACE AND DX COOLING COIL.
 - ② WALL MOUNTED HEAT PUMP.

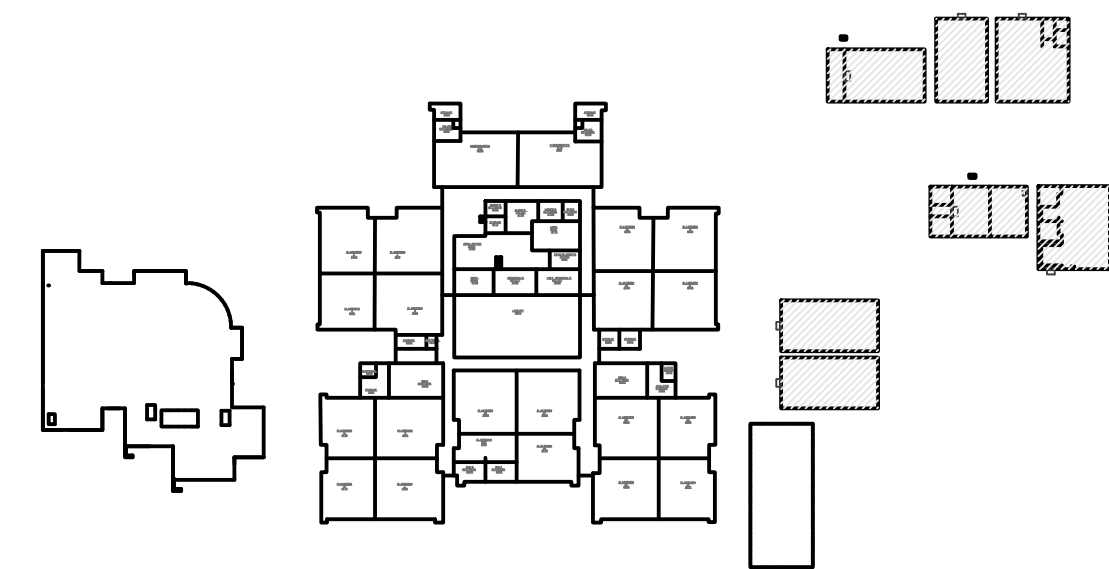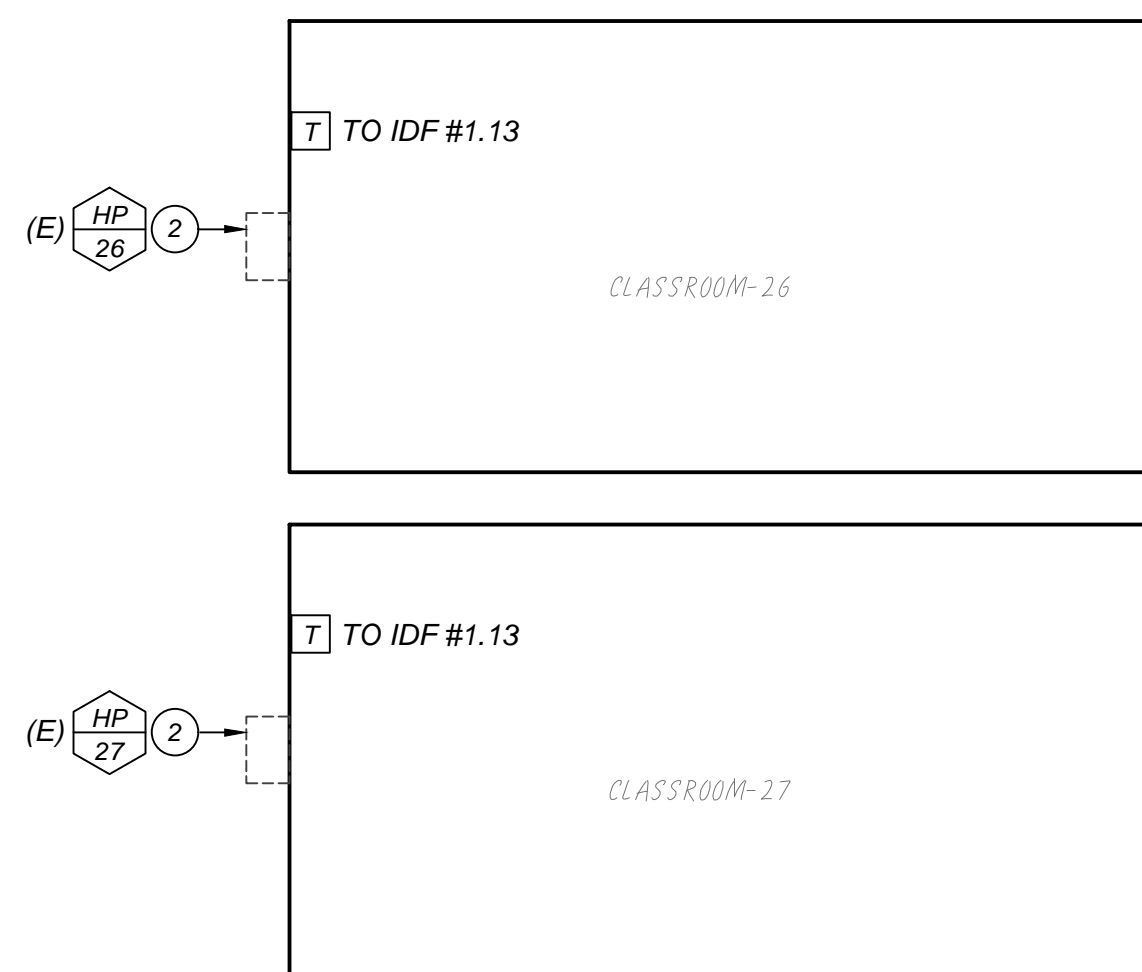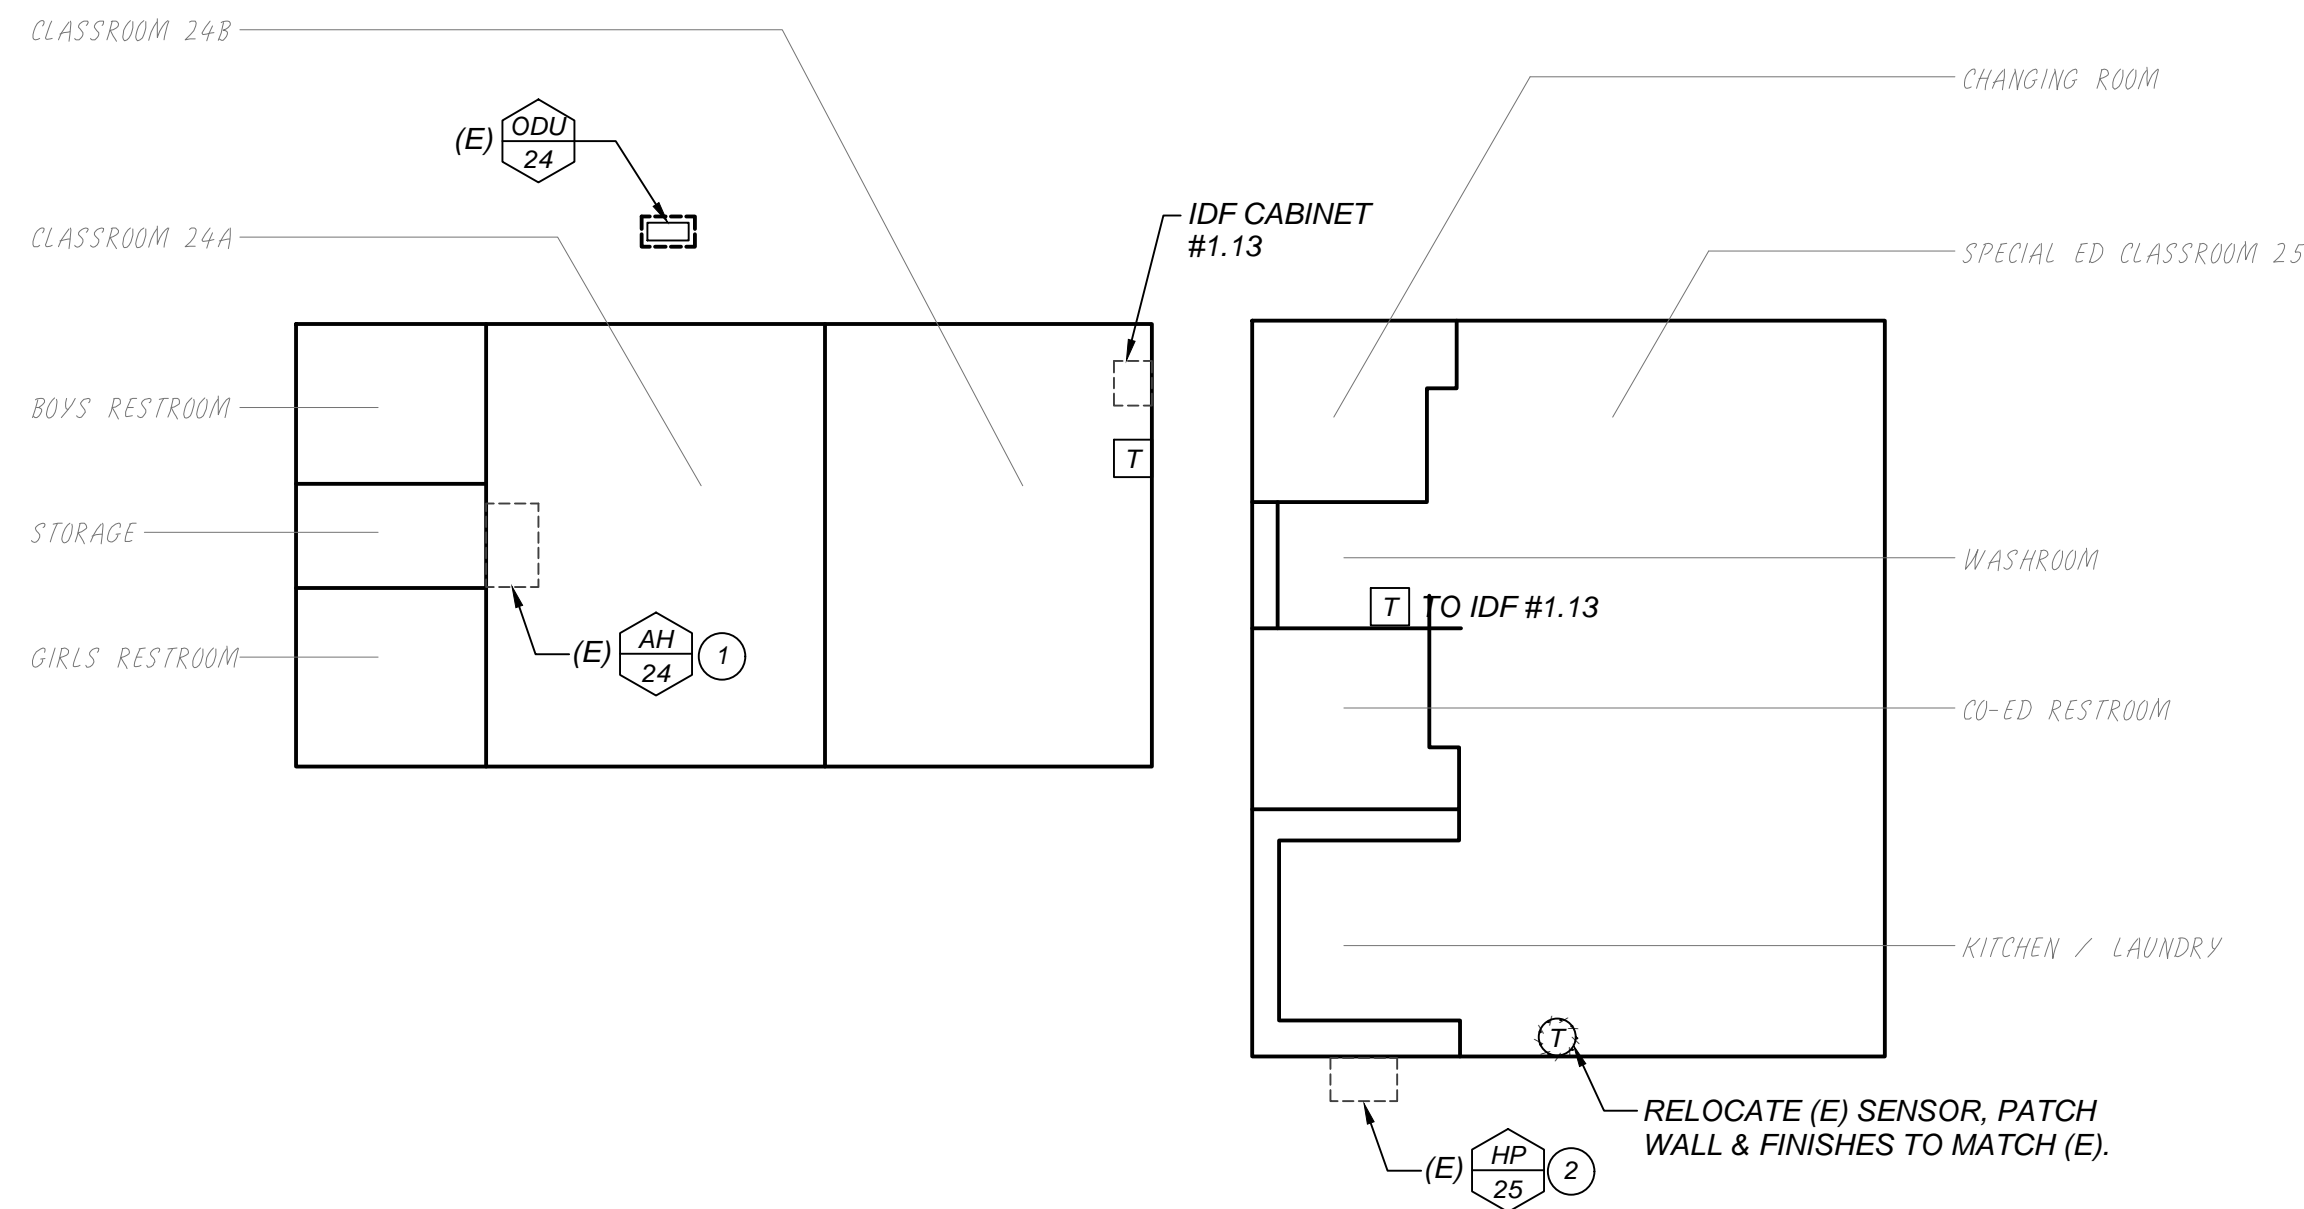

KEY PLAN



PORTABLE BUILDINGS - EMS PLAN
SCALE: 3/32"=1'-0"

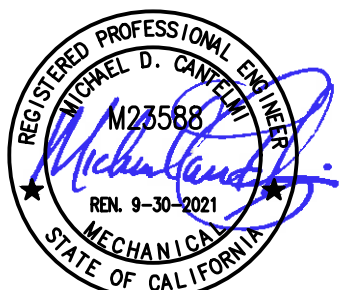

DATE: 11-25-2020

EMS REPLACEMENT
EATON ELEMENTARY SCHOOL
1451 EAST SIERRA AVE. FRESNO, CA
FRESNO UNIFIED SCHOOL DISTRICT
4600 N. BRAWLEY AVE. FRESNO, CA.

REVISIONS
4/22/21 EMS REVISIONS

LAWRENCE
ENGINEERING GROUP
Fresno, CA 93720
(559) 431-0101
7084 N. Maple Ave., Suite 101
FAX (559) 431-1362

TITLE:
ENERGY
MANAGEMENT
DETAILS


SHEET:
M4
PROJECT 20138

Sheet Notes

1. DEFAULT IP ADDRESS TO BE CHANGED DURING COMMISSIONING.
2. IP ADDRESSES TO BE PROVIDED BY FUSD.
3. A PANDUIT CJ688TGYL CONNECTOR IS REQUIRED BETWEEN ALL IP DEVICES AND THE NETWORK SWITCH.
4. BOTH ENDS OF ALL CAT-6 CABLES MUST BE LABELED WITH THE ROOM NUMBER, EQUIPMENT TYPE, AND PATCH PANEL NUMBER I.E. ROOM # - EQUIP. TYPE - PORT #
5. REFER TO E/M-4.

JACE Notes

HOST ID:
SERIAL NUMBER:
PRIMARY IP: 192.168.1.149
SECONDARY IP: 192.168.10.10

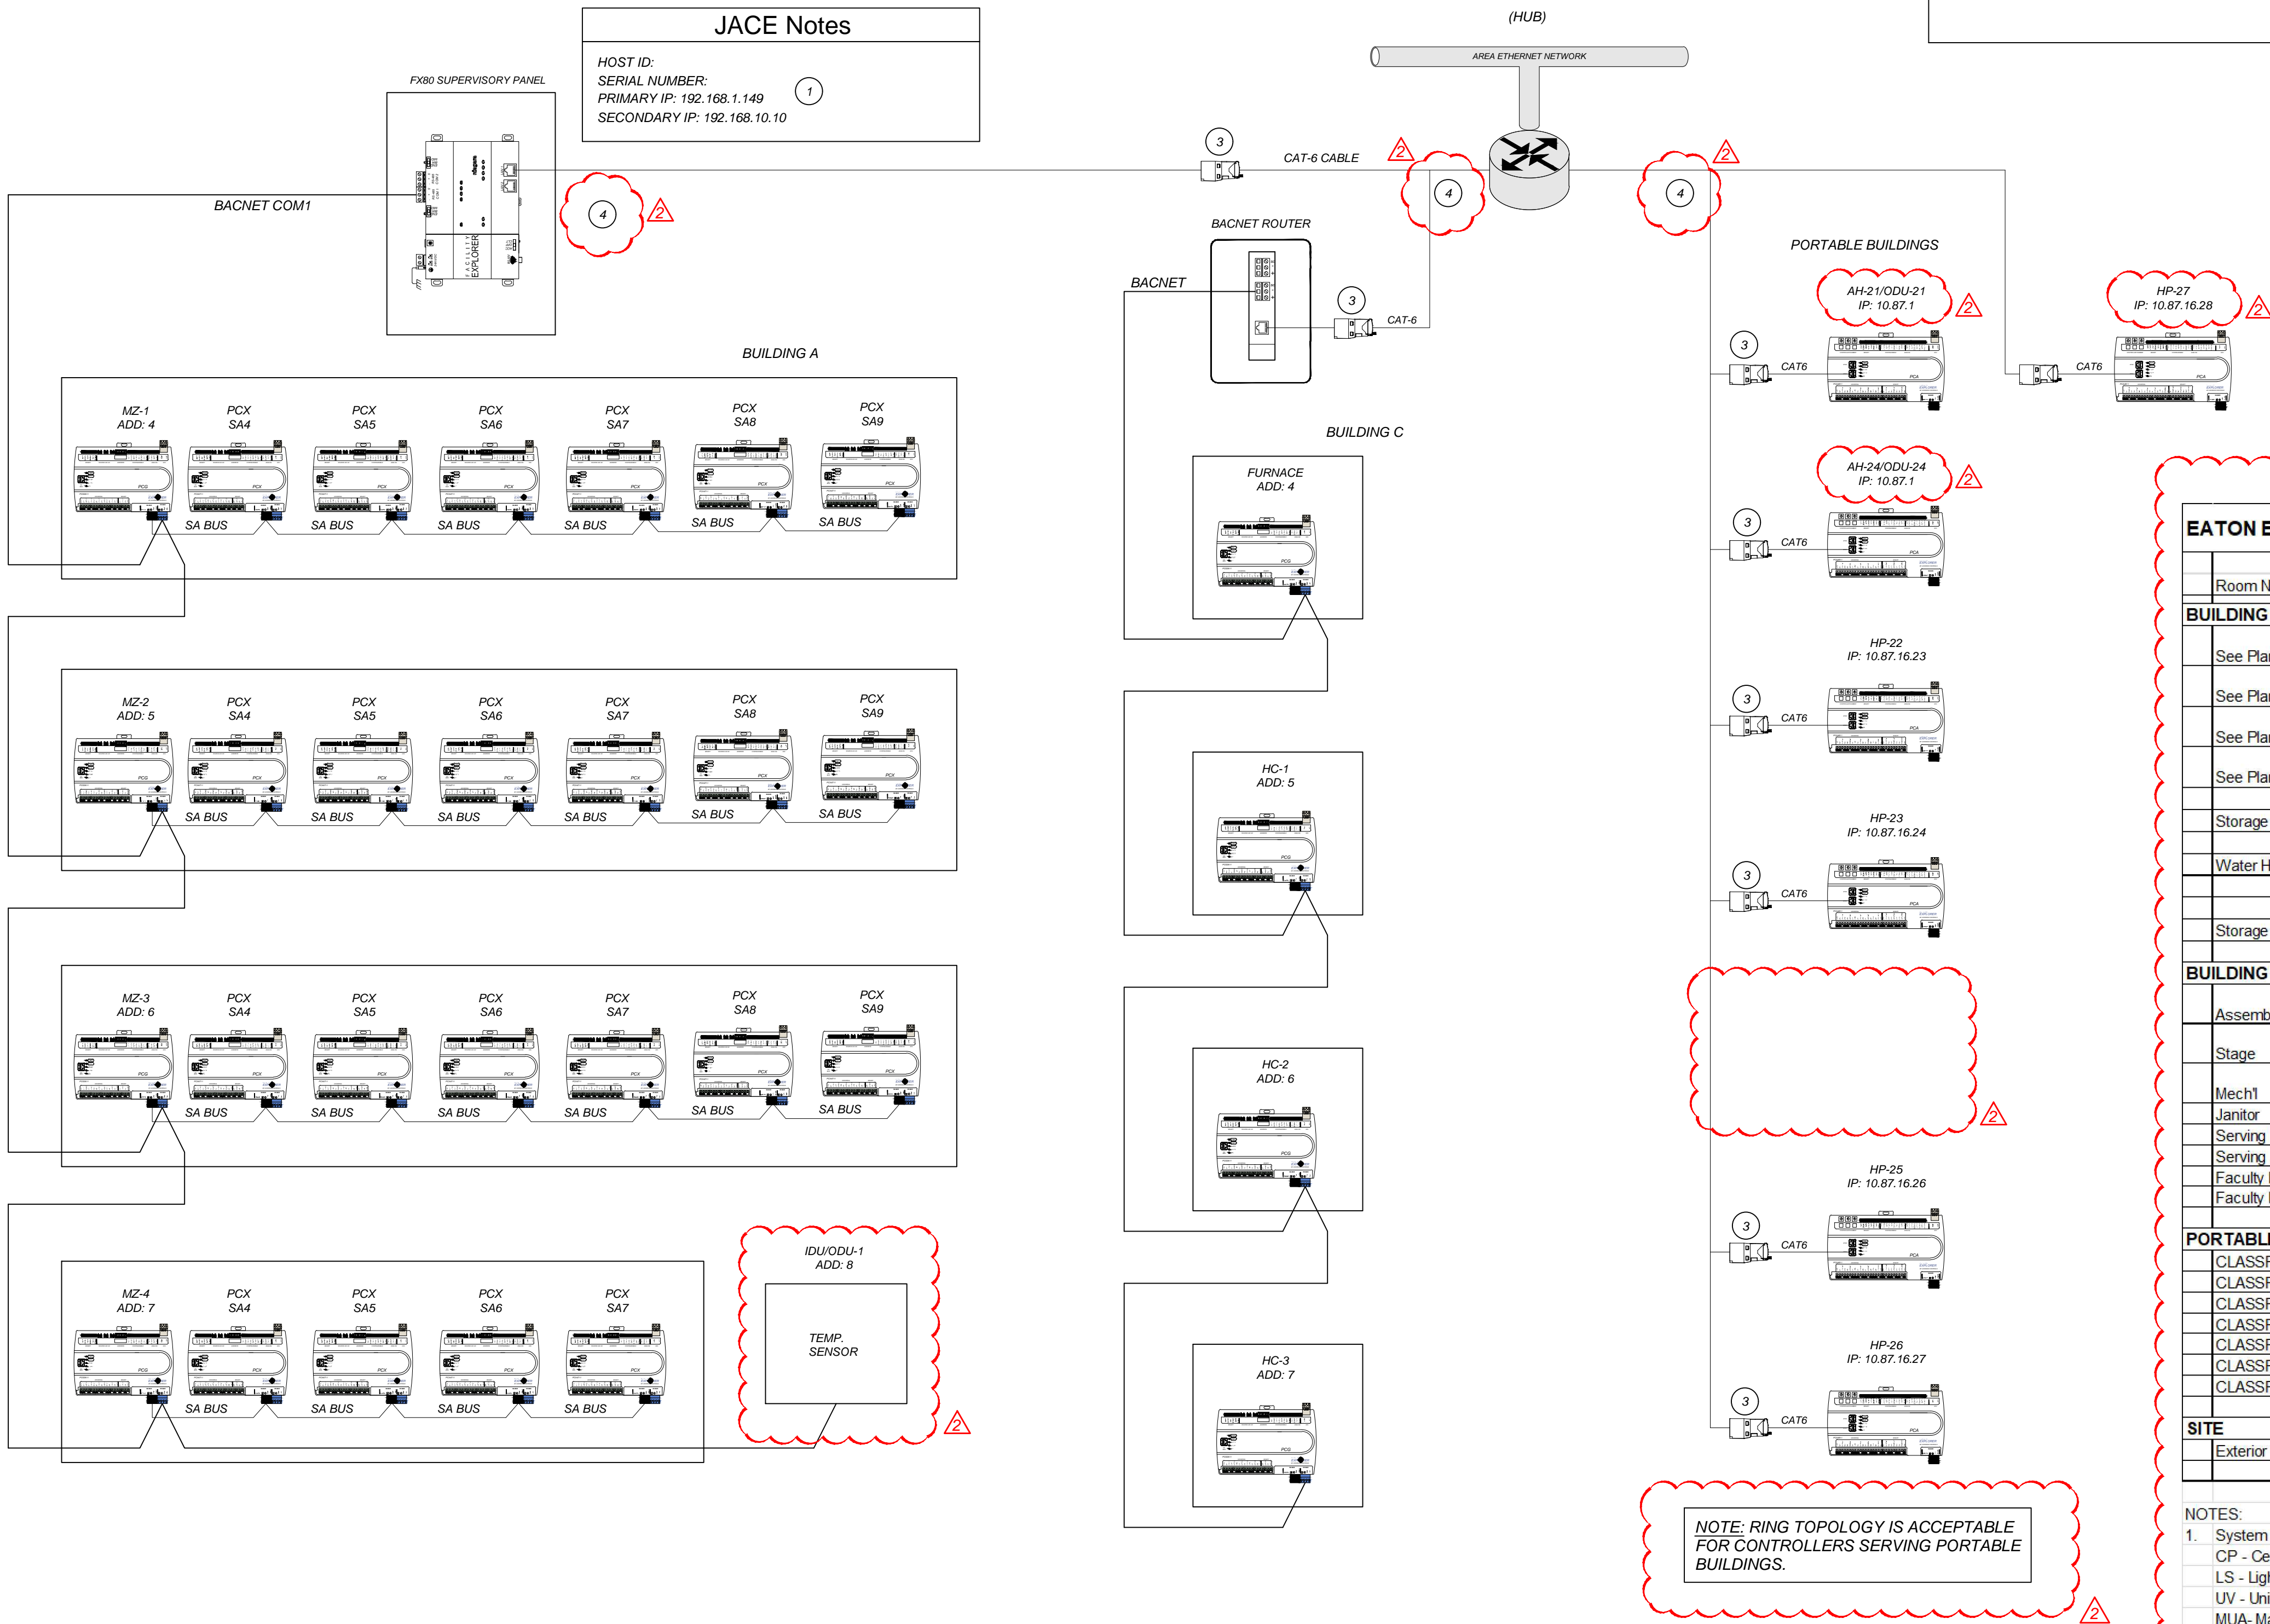

EATON ELEMENTARY SCHOOL CONTROL REFERENCES


Room Name	Room No.	A/C Mark No.	System Type	Description or Notes	See Detail
BUILDING A - CLASSROOM & ADMIN					
See Plans		MZ-1	MZAH	8 zones, (N) 7.5HP SA & 5 HP RA. Fan Motor & VFD	C/M-5
See Plans		MZ-2	MZAH	8 zones, (N) 10 HP SA & 5 HP RA Fan Motor & VFD	C/M-5
See Plans		MZ-3	MZAH	8 zones, (N) 7.5 HP SA & 1.5 HP EXH Fan Motor & VFD	C/M-5
See Plans		MZ-4	MZAH	6 zones, (N) 10 HP SA & 5 HP RA Fan Motor & VFD	C/M-5
Storage		EF-6	R/R Exhaust Fan	Interlock with MZU-3	E/M-9
Water Heater		EF-5/6A	Lighting Contactor	Interlock with MZU-4	B/M-5
			R/R Exhaust Fan	Interlock with MZU-4	E/M-9
			WH w/ Circ. Pump	Interlock with MZU-4	D/M-9
		EF-800	R/R Exhaust Fan	Interlock with lights	C/M-9
		EF-870	R/R Exhaust Fan	Interlock with lights	C/M-9
Storage		IDU-1/ODU-1	Split HP	Interlock with lights	C/M-9
				Interlock to Nearest UI, Monitor Only	B/M-6
BUILDING C					
Assembly Room	1	HC-3	G/E	Unit has 3 Electric Duct Heaters, Economizer and Powered Exhaust	A/M-8
Stage	2	F-1/CC-1/ C-1	Split G/E	Gas Furnace w/ DX Cooling Coil, and Air Cooled Condenser	A/M-7
Mech1	8			Intergrate Lighting Contactor to Nearest UI	F/M-9
Janitor	9		WH w/ Circ Pump	Intergrate Pump ON/OFF to nearest UO	D/M-9
Serving Kitchen	11	HC-1	G/E		C/M-7
Serving Kitchen	11	EF-1	Exhaust Fan	Interlock with HC-1	E/M-9
Faculty Lounge	12	HC-2	G/E		C/M-7
Faculty Lounge	12	EF-2	Exhaust Fan	Interlock with HC-2	E/M-9
PORTABLES					
CLASSROOM	21	AH-21	Split G/E		C/M-8
CLASSROOM	22	HP-22	Wall Mounted HP		A/M-9
CLASSROOM	23	HP-23	Wall Mounted HP		A/M-9
CLASSROOM	24	AH-24	Split G/E		C/M-8
CLASSROOM	25	HP-25	Wall Mounted HP		A/M-9
CLASSROOM	26	HP-26	Wall Mounted HP		A/M-9
CLASSROOM	27	HP-27	Wall Mounted HP		A/M-9
SITE					
Exterior Lighting					F/M-9

NOTES:

1. System Type Abbreviations: G/E - Gas Heating/Electric Cooling; HP - Heat Pump; CP - Central Plant Hot or Chilled Water; LS - Light Switch; UV - Unit Ventilator; MUA - Make-up Air; HW - Hot Water; DHW - Domestic Hot Water; MZ - Multizone; AH - Air handler

LAN ARCHITECTURE DETAIL

A
M-4

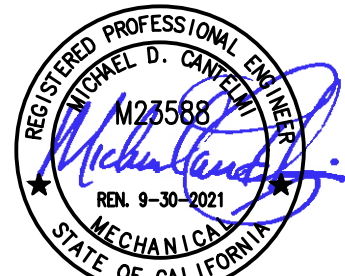

DATE: 11-25-2020

EMS REPLACEMENT
EATON ELEMENTARY SCHOOL
1451 EAST SIERRA AVE. FRESNO, CA
FRESNO UNIFIED SCHOOL DISTRICT
4600 N. BRAWLEY AVE. FRESNO, CA.

REVISIONS
4/22/21 EMS REVISIONS


LAWRENCE
ENGINEERING GROUP
Fresno, CA 93720
(559) 431-0101
7084 N. Maple Ave., Suite 101
(559) 431-0101

TITLE:
ENERGY
MANAGEMENT
DETAILS

SHEET:
M5
PROJECT 20138

Control Components	
TAG	DESCRIPTION
CDAT,HDAT	DUCT TEMP SENSOR
OAT	OUTSIDE AIR SENSOR
MAT	AVERAGING DUCT TEMP SENSOR
OAD/RAD	SPRING RETURN DAMPER ACTUATOR
PFDP	PRESSURE TRANSDUCER
SFVFD	(N) VARIABLE FREQUENCY DRIVE

Detail Notes	
1	LINE VOLTAGE & CONDUIT BY DIVISION 16.
2	CONTROL COMPONENTS PROVIDED BY TOTAL CONTROL CONTACT DEVEN PUTNAM AT 559-291-1000.
3	REFER TO DETAIL DMS FOR ZONE CONTROL DETAIL.
4	PROVIDE (N) ACTUATOR, FIELD VERIFY QUANTITY.
5	(N) VARIABLE FREQUENCY DRIVE AND MOTOR

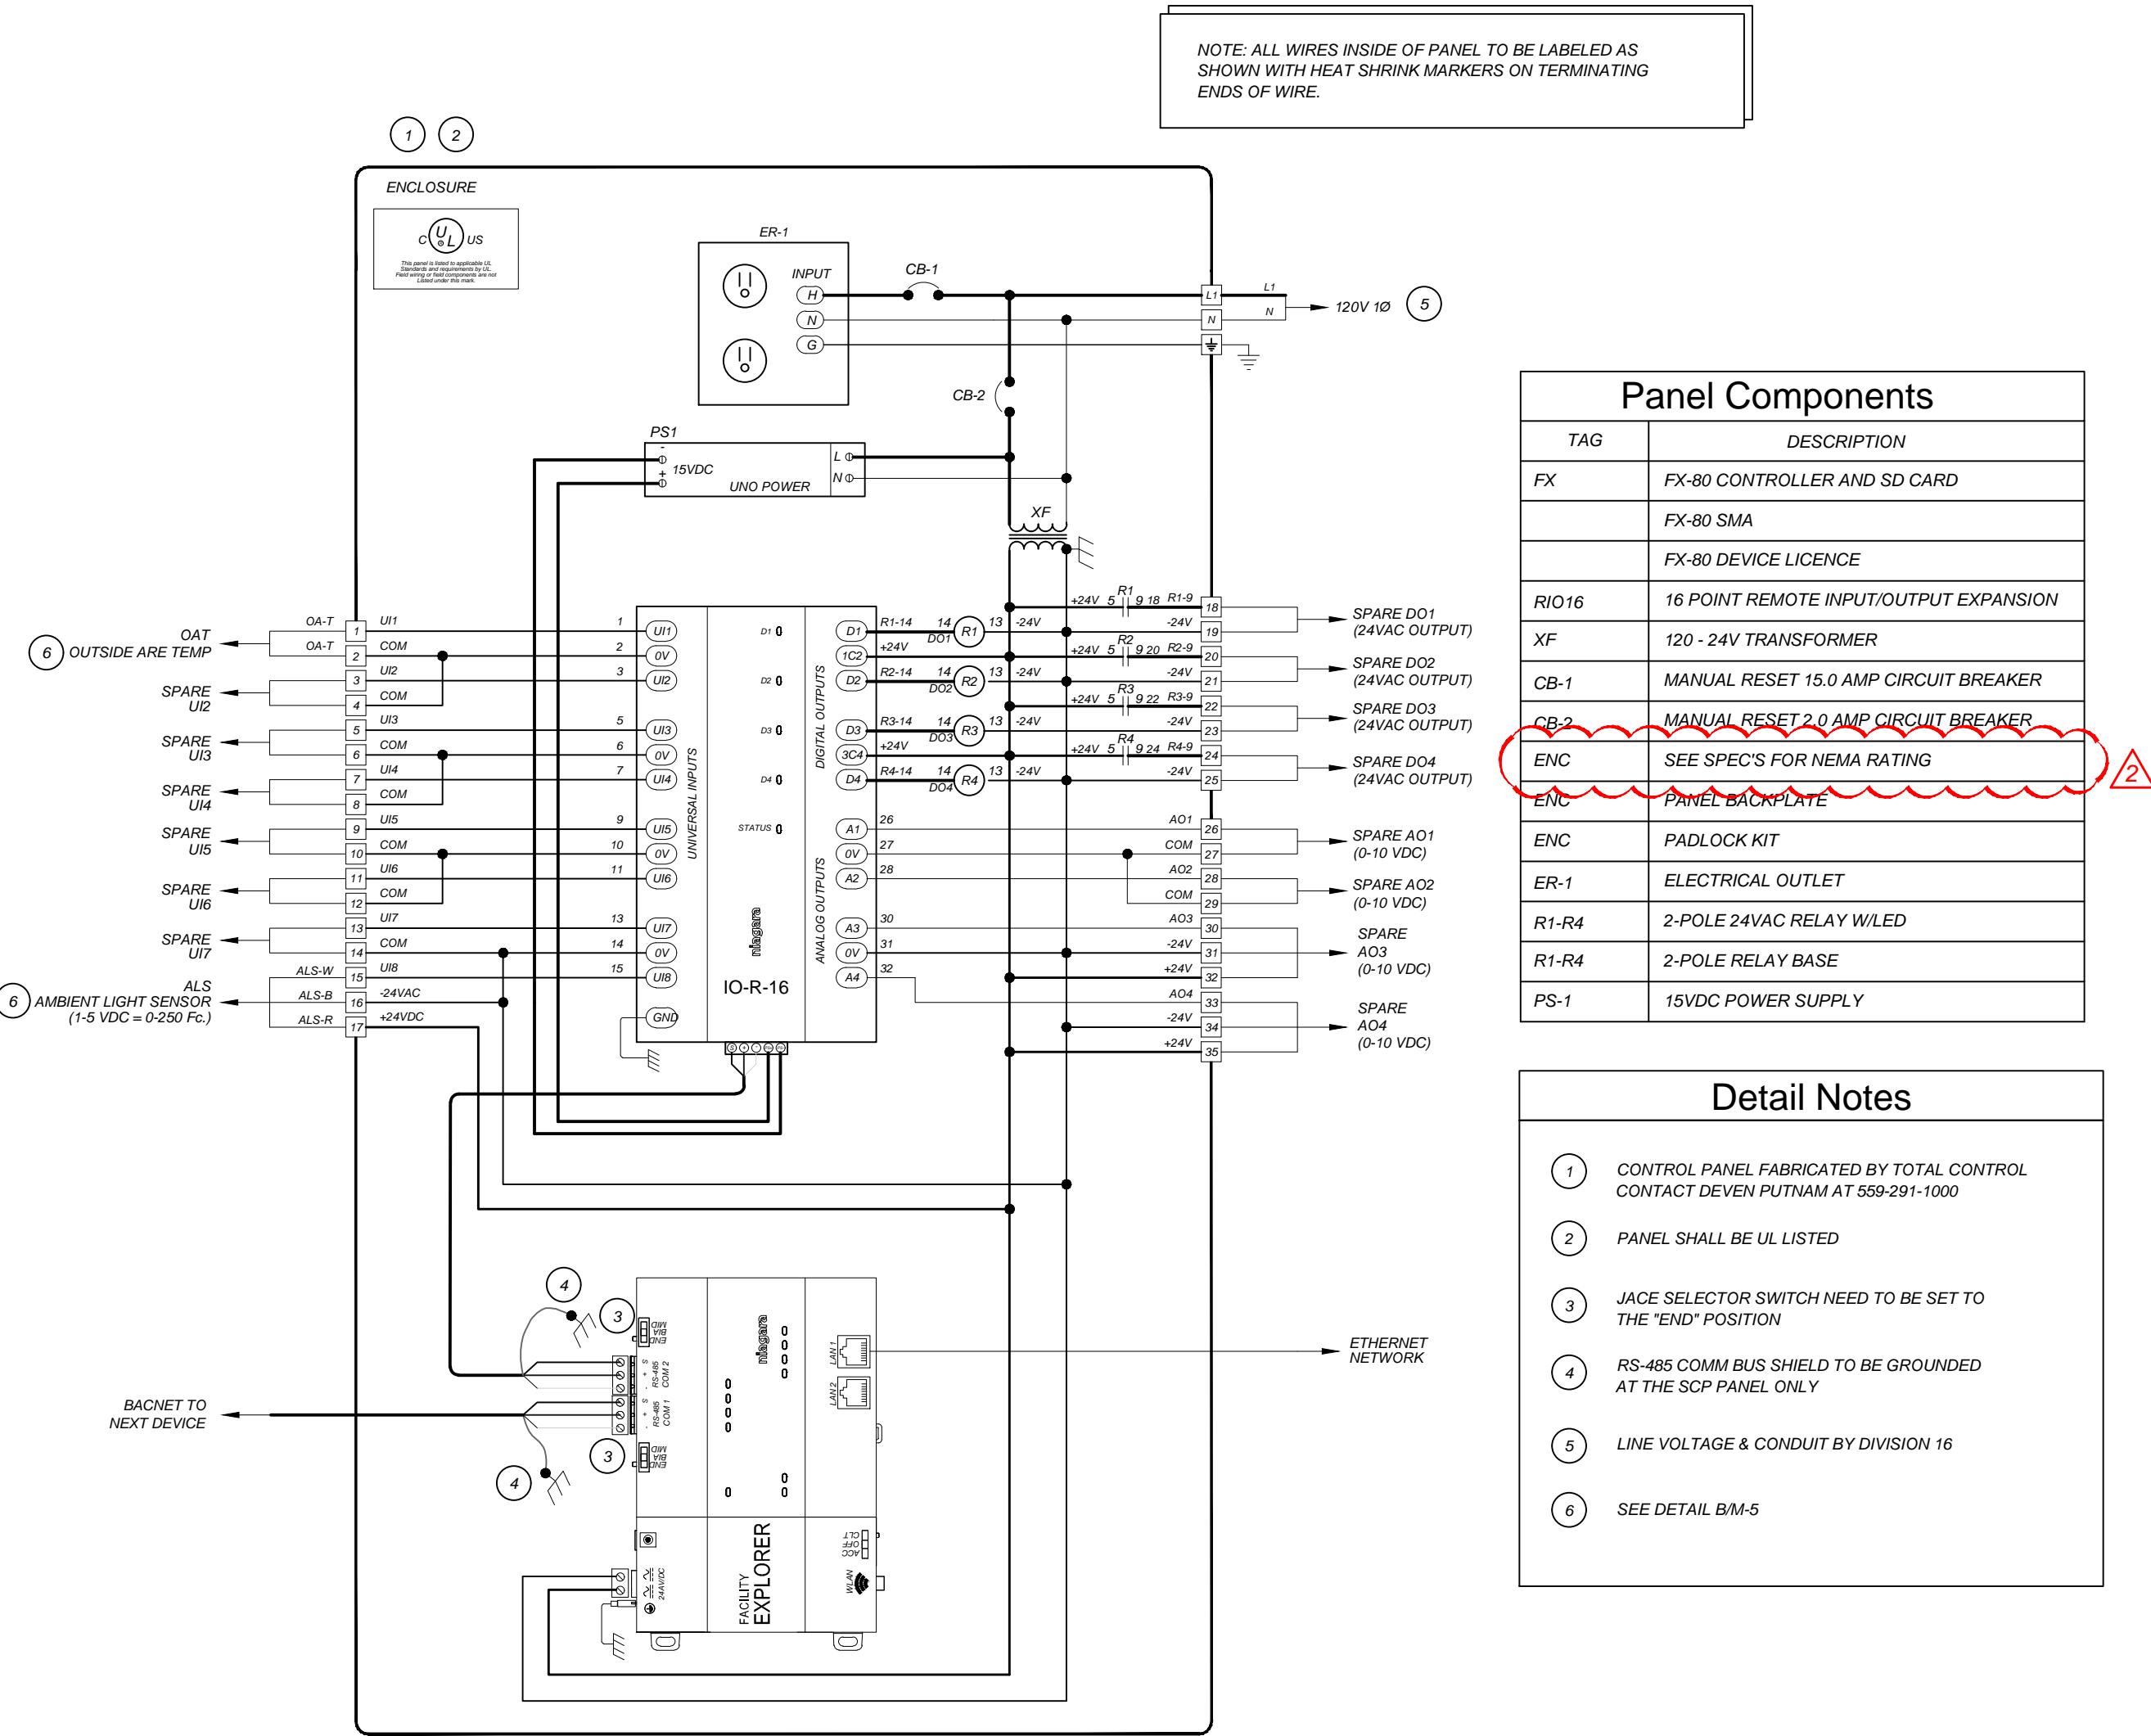


SUPERVISORY SCP SCHEMATIC DETAIL


MULTI-ZONE CONTROL DETAIL

Control Components	
TAG	DESCRIPTION
OAT	10K TYPE 3 OUTDOOR SENSOR
ALS	AMBIENT LIGHT SENSOR

Detail Notes	
1	LOCATE AMBIENT LIGHT SENSOR AT NORTHERN EXPOSURE OF BUILDING.
2	SEE DETAIL AM-5

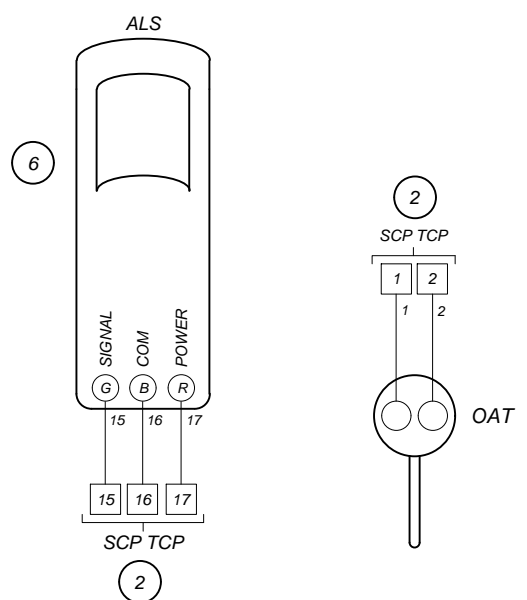


OUTDOOR PHOTOCELL AND TEMP SENSOR DETAIL

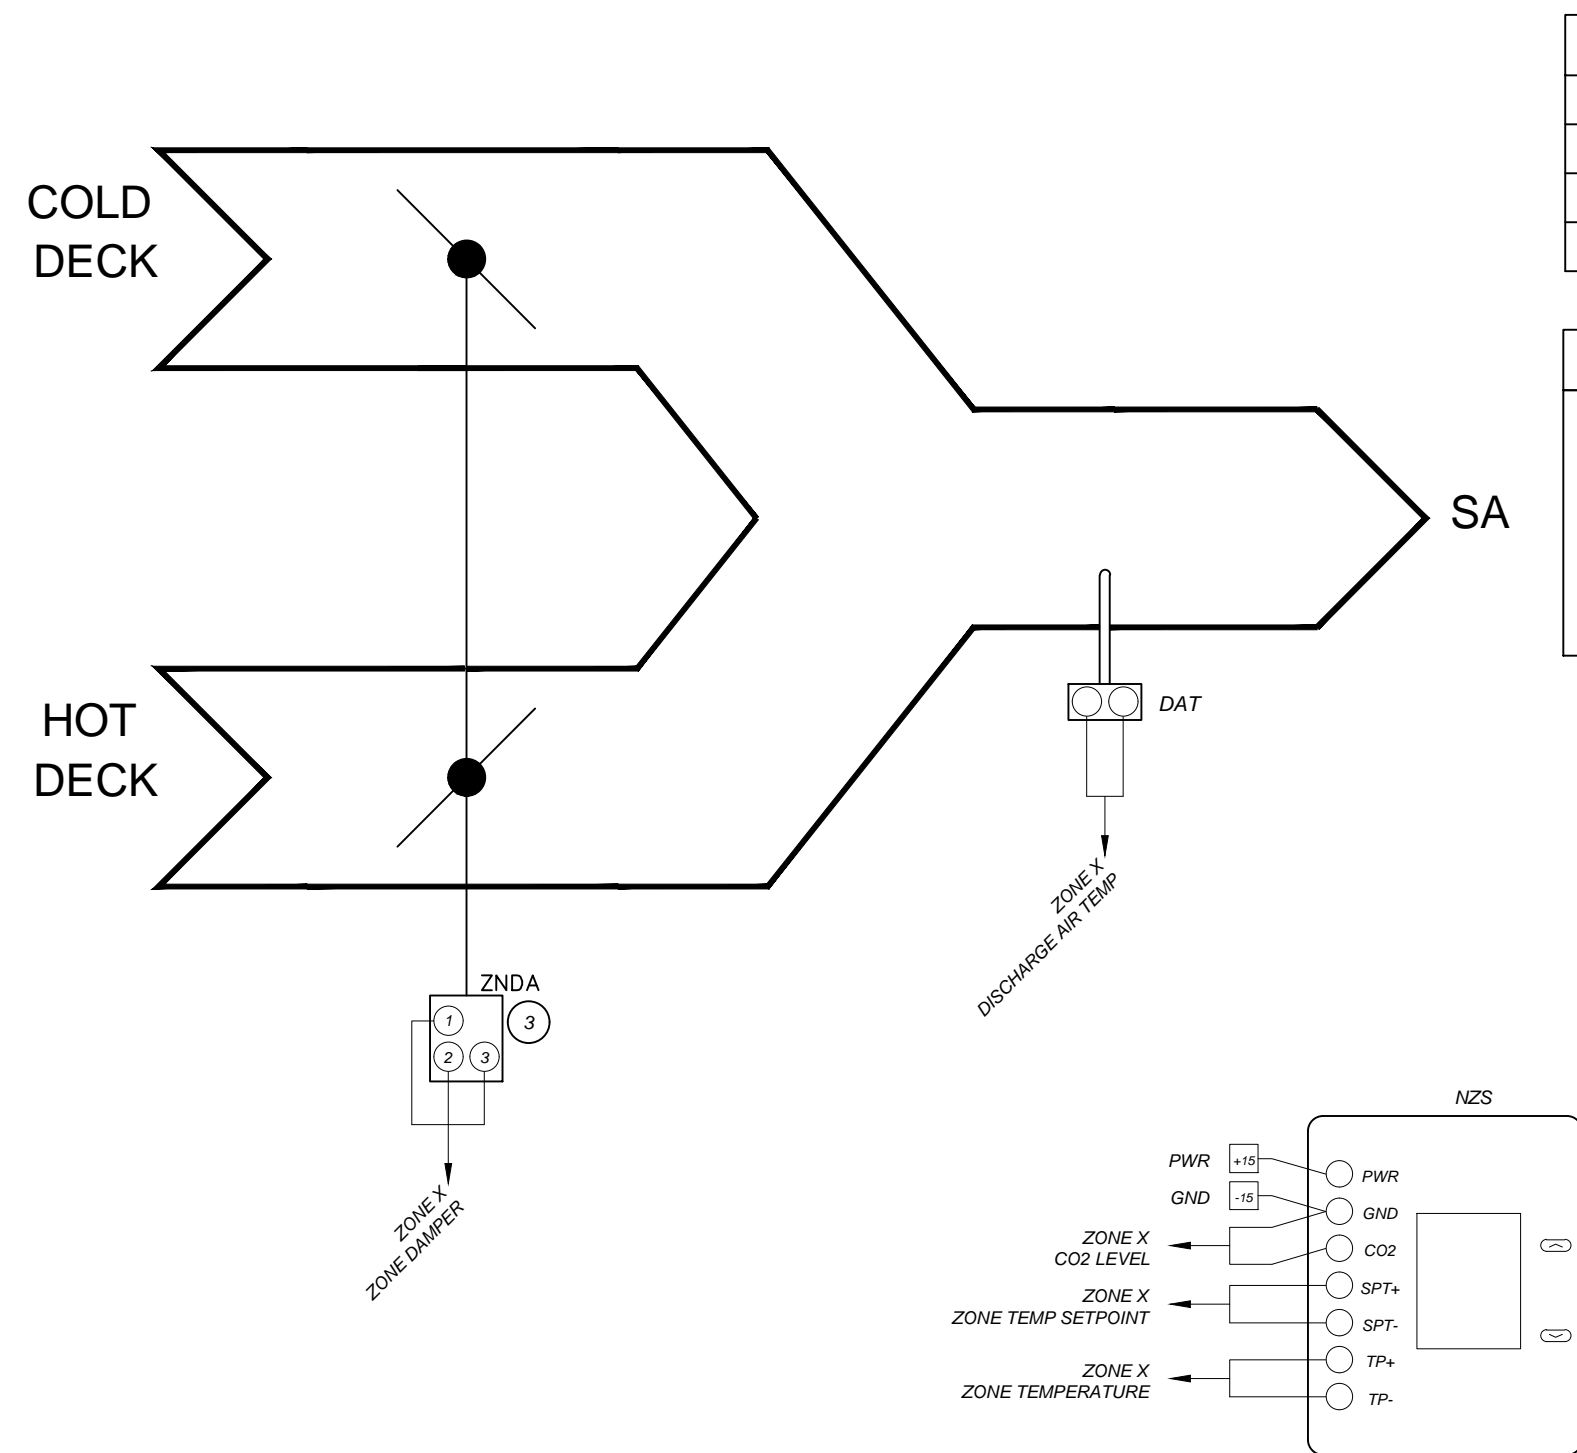

ZONE CONTROL DETAIL

Control Components	
TAG	DESCRIPTION
NZS	ZONE SENSOR W/ SETPOINT ADJUSTMENT
DAT	-
ZNDA	-


Detail Notes	
1	LINE VOLTAGE & CONDUIT BY DIVISION 16.
2	CONTROL COMPONENTS PROVIDED BY TOTAL CONTROL CONTACT DEVEN PUTNAM AT 559-291-1000.
3	PROVIDE (N) ACTUATOR.

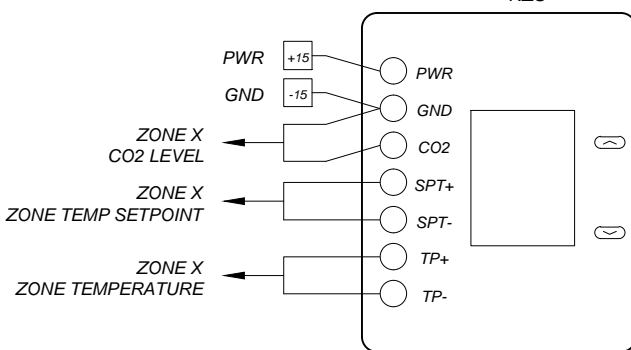

ZONE SENSOR DETAIL


B
M-6

Detail Notes	
1	LINE VOLTAGE & CONDUIT BY DIVISION 16.
2	UNIT SHALL SHUT DOWN UPON DETECTION OF SMOKE. WIRE ACCORDINGLY.
3	CONTROL COMPONENTS PROVIDED BY TOTAL CONTROL CONTACT DEVEN PUTNAM AT 559-291-1000.
4	SEE DETAIL BM-7 FOR TOP DIAGRAM.

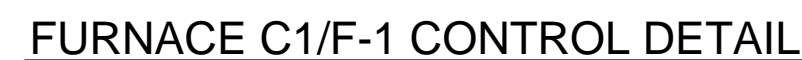


Detail Notes	
1	LINE VOLTAGE & CONDUIT BY DIVISION 16.
2	OAT GLOBALLY SHARED SOFTWARE POINT
3	CONTROL COMPONENTS PROVIDED BY TOTAL CONTROL CONTACT DEVEN PUTNAM AT 559-291-1000.
4	SEE DETAIL D/M-7 FOR TCP DIAGRAM.

CO2 Monitoring: If CO2 in the space rises above CO2 alarm setpoint (adj.), the system will generate a Niagara alarm.

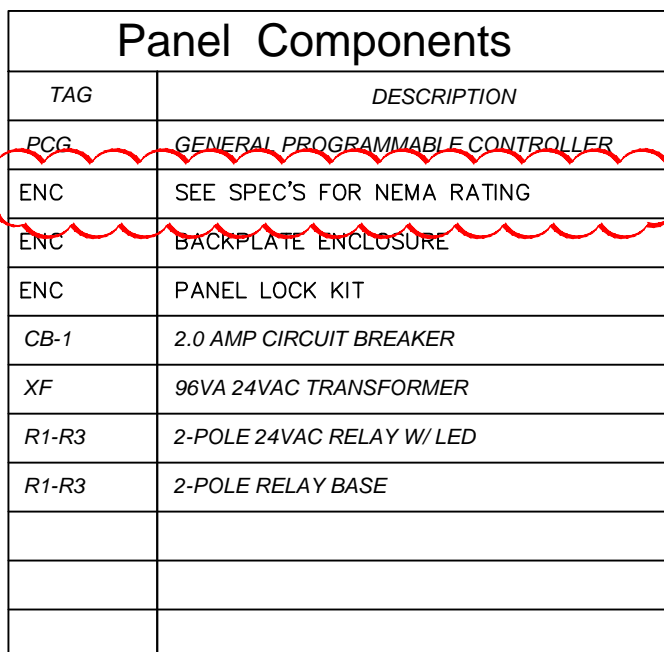

Detail Notes	
1	CONTROL PANELS FABRICATED BY TOTAL CONTROL CONTACT DEVEN PUTNAM AT 559-291-1000
2	PANEL SHALL BE UL LISTED
3	LINE VOLTAGE AND CONDUIT BY DIVISION 16.

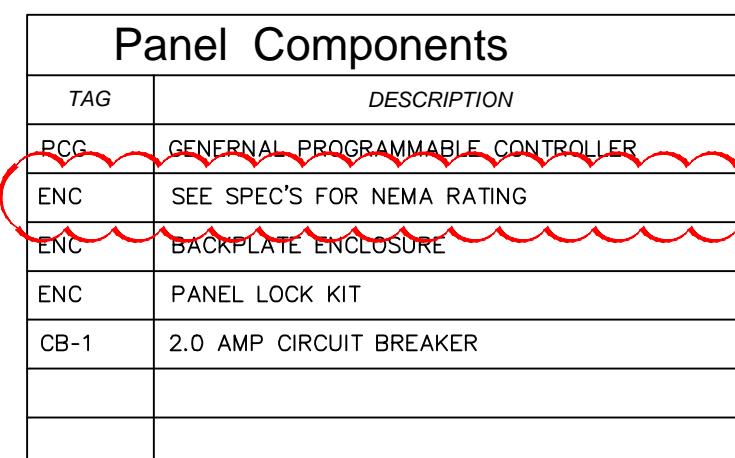

Detail Notes	
1	CONTROL PANEL FABRICATED BY TOTAL CONTROL CONTACT DEVEN PUTNAM 559-291-1000
2	PANEL SHALL BE UL LISTED
3	LINE VOLTAGE & CONDUIT BY DIVISION 16.

EMS REPLACEMENT
EATON ELEMENTARY SCHOOL
1451 EAST SIERRA AVE. FRESNO, CA

FRESNO UNIFIED SCHOOL DISTRICT
4600 N. BRAWLEY AVE. FRESNO, CA.

REVISIONS

2 4/22/21 EMS REVISIONS

LAWRENCE
ENGINEERING GROUP
Fresno, CA 93720
FAX (559) 431-1362

TITLE:

ENERGY


MANAGEMENT

DETAILS

SHEET:

M7

PROJECT 20138

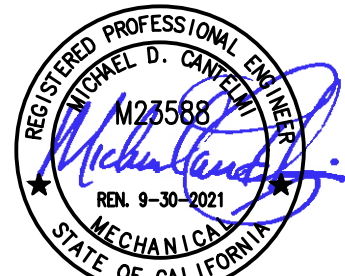

EMS REPLACEMENT
EATON ELEMENTARY SCHOOL
1451 EAST SIERRA AVE. FRESNO, CA
FRESNO UNIFIED SCHOOL DISTRICT
4600 N. BRAWLEY AVE. FRESNO, CA.

REVISIONS
4/22/21 EMS REVISIONS


LAWRENCE
ENGINEERING GROUP
Fresno, CA 93720
(559) 431-0101
7084 N. Maple Ave., Suite 101
(559) 431-1362

TITLE:
ENERGY
MANAGEMENT
DETAILS

SHEET:
M8
PROJECT 20138

Control Components	
TAG	DESCRIPTION
DAT,MAT,RAT	DUCT TEMP SENSOR
CCS,SFCS	CURRENT SENSOR
NZS	NETWORK ZONE SENSOR WITH CO2
OAD/RAD	SPRING RETURN DAMPER ACTUATOR
BSP	PRESSURE TRANSDUCER

Sheet Notes
1 LINE VOLTAGE & CONDUIT BY DIVISION 16.
2 OAT GLOBALLY SHARED SOFTWARE POINT
3 CONTROL COMPONENTS PROVIDED BY TOTAL CONTROL CONTACT DEVEN PUTNAM AT 559-291-1000.
4 SEE DETAIL B/M8 FOR TCP DIAGRAM.

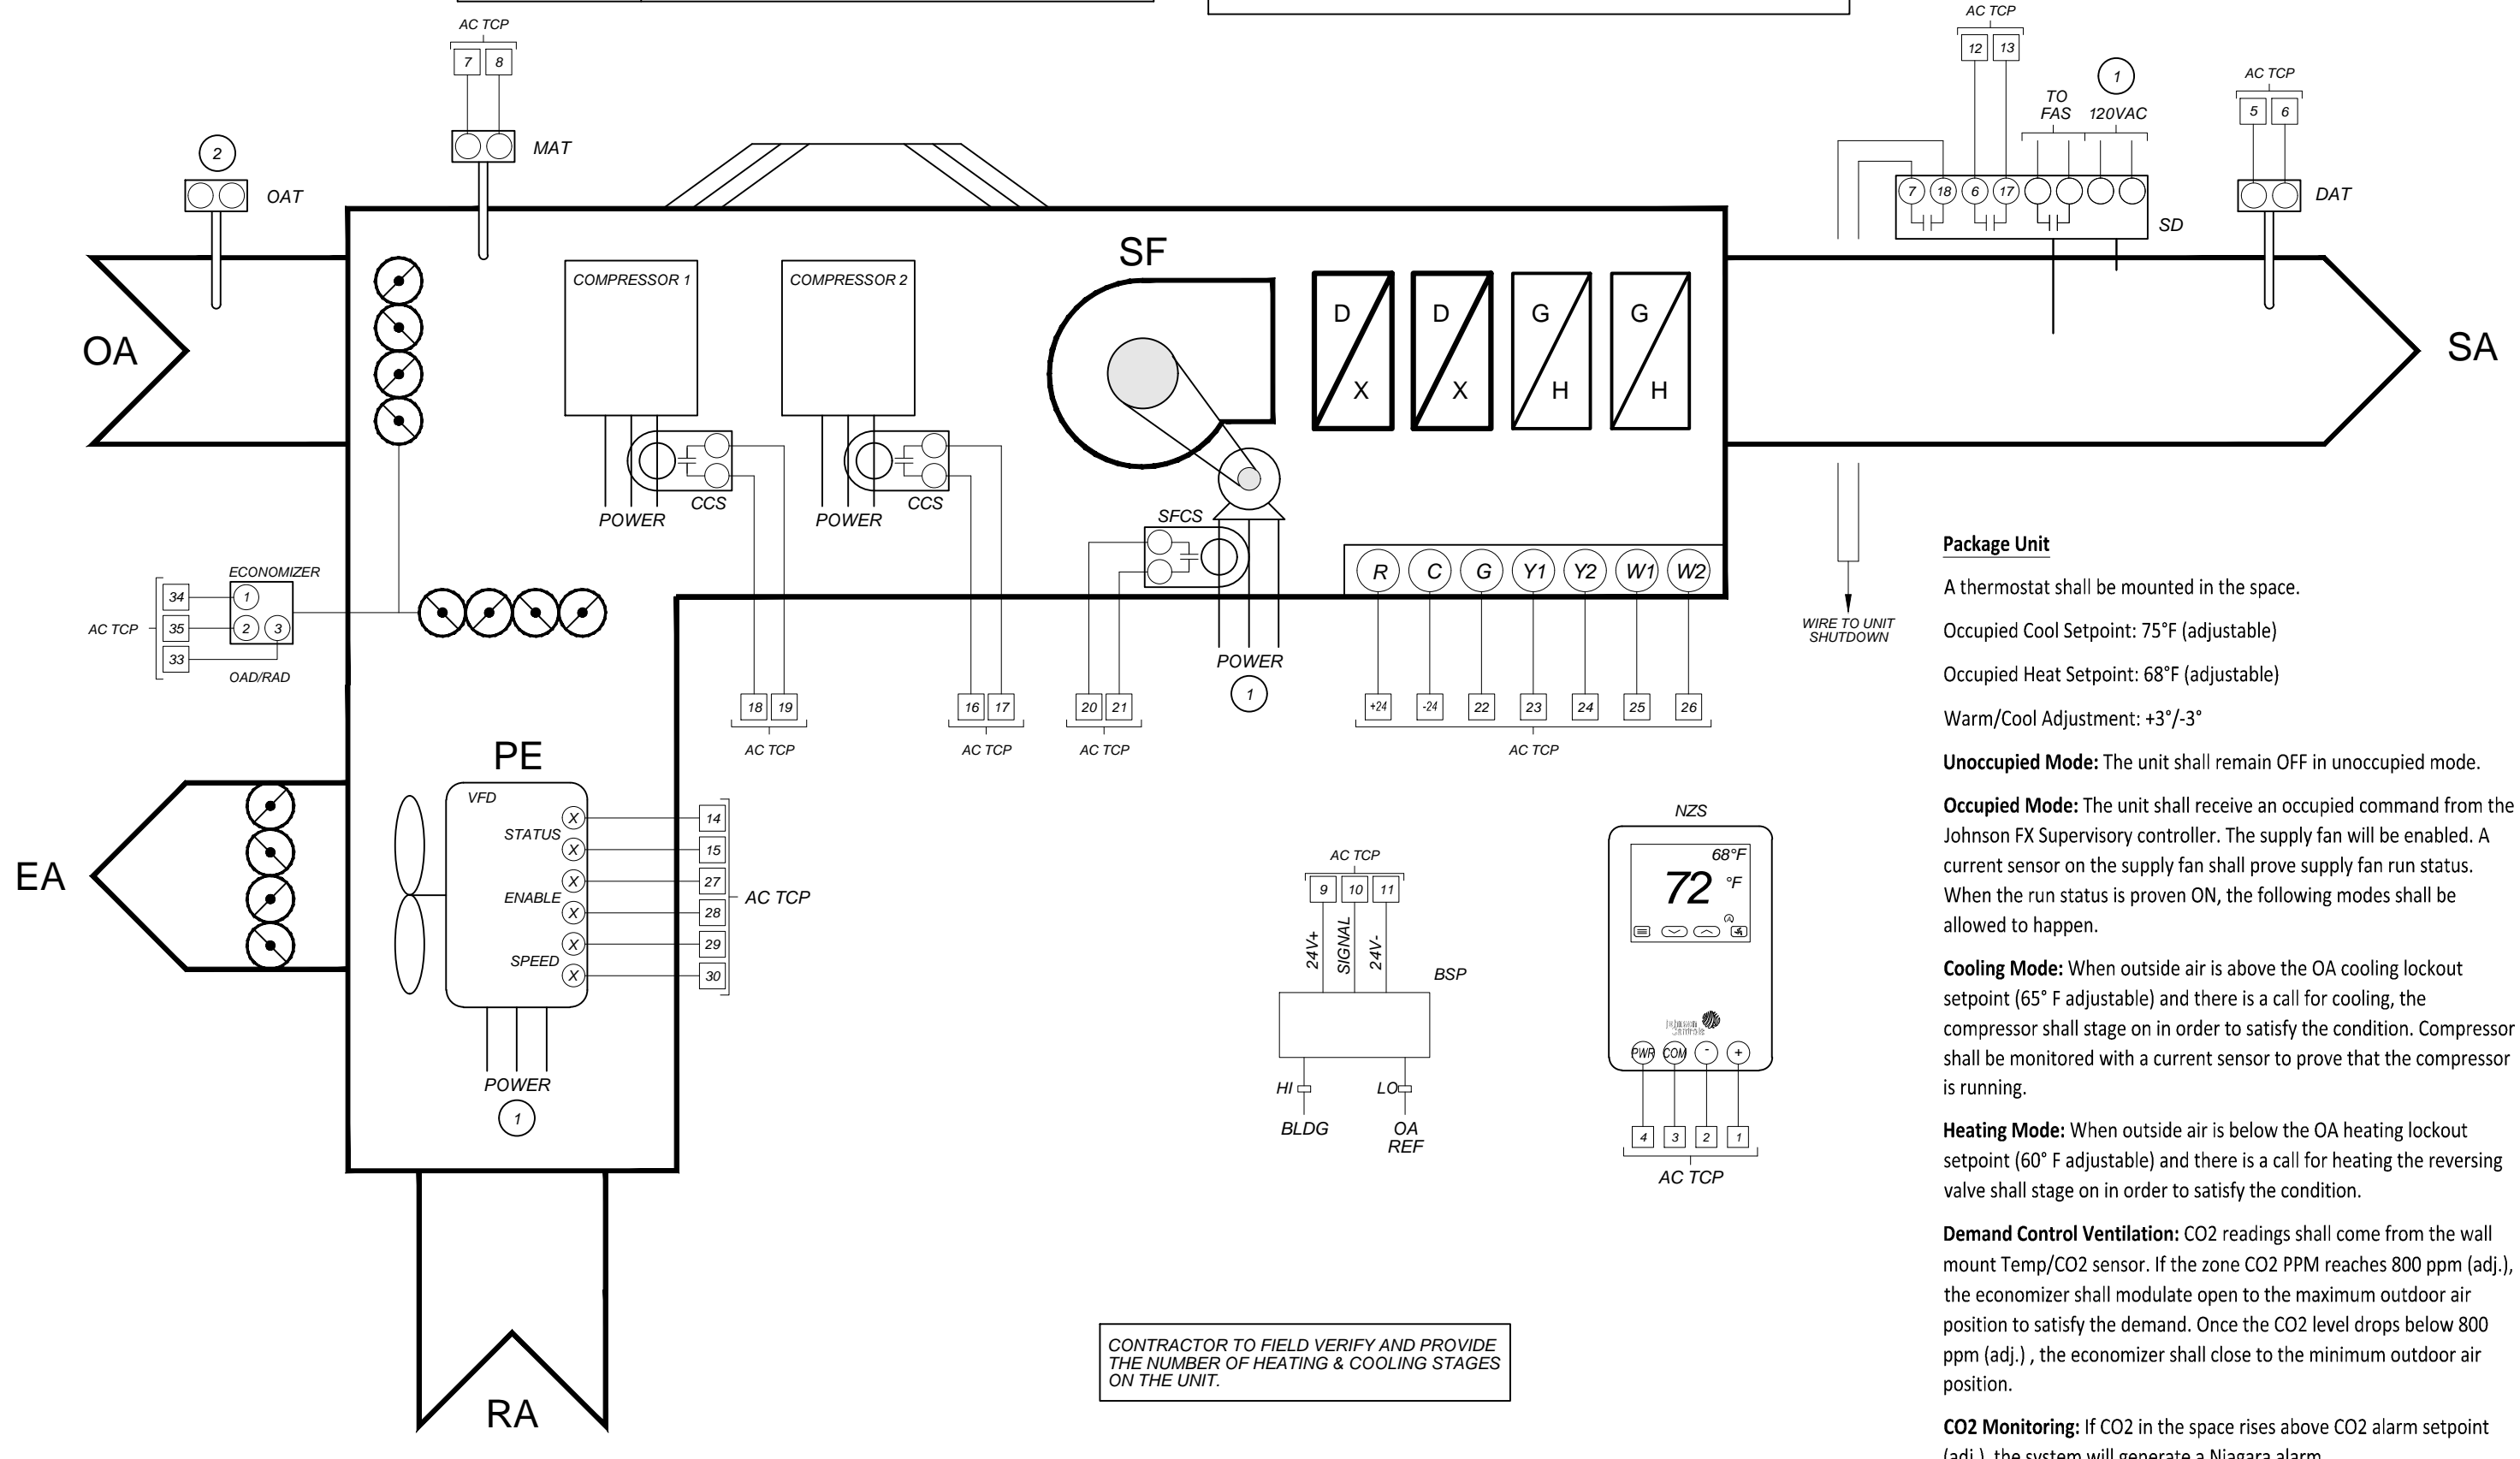


Package Unit
A thermostat shall be mounted in the space.
Occupied Cool Setpoint: 75°F (adjustable)
Occupied Heat Setpoint: 68°F (adjustable)
Warm/Cool Adjustment: +3°/-3°
Unoccupied Mode: The unit shall remain OFF in unoccupied mode.
Occupied Mode: The unit shall receive an occupied command from the Johnson FX Supervisory controller. The supply fan will be enabled. A current sensor on the supply fan shall prove supply fan run status. When the run status is proven ON, the following modes shall be allowed to happen.
Cooling Mode: When outside air is above the OA cooling lockout setpoint (65° F adjustable) and there is a call for cooling, the compressor shall stage on in order to satisfy the condition. Compressor shall be monitored with a current sensor to prove that the compressor is running.
Heating Mode: When outside air is below the OA heating lockout setpoint (60° F adjustable) and there is a call for heating the reversing valve shall stage on in order to satisfy the condition.
Demand Control Ventilation: CO2 readings shall come from the wall mount Temp/CO2 sensor. If the zone CO2 PPM reaches 800 ppm (adj.), the economizer shall modulate open to the maximum outdoor air position to satisfy the demand. Once the CO2 level drops below 800 ppm (adj.), the economizer shall close to the minimum outdoor air position.
CO2 Monitoring: If CO2 in the space rises above CO2 alarm setpoint (adj.), the system will generate a Niagara alarm.

ROOF TOP UNIT CONTROL DETAIL

A
M-8


Control Components	
TAG	DESCRIPTION
DAT,MAT,RAT	DUCT TEMP SENSOR
OAD/RAD	SPRING RETURN DAMPER ACTUATOR
NZS	NETWORK ZONE SENSOR W/ CO

Detail Notes
1 LINE VOLTAGE & CONDUIT BY DIVISION 16.
2 OAT GLOBALLY SHARED SOFTWARE POINT
3 CONTROL COMPONENTS PROVIDED BY TOTAL CONTROL CONTACT DEVEN PUTNAM AT 559-291-1000.
4 SEE DETAIL D/M-8 FOR TCP DIAGRAM.

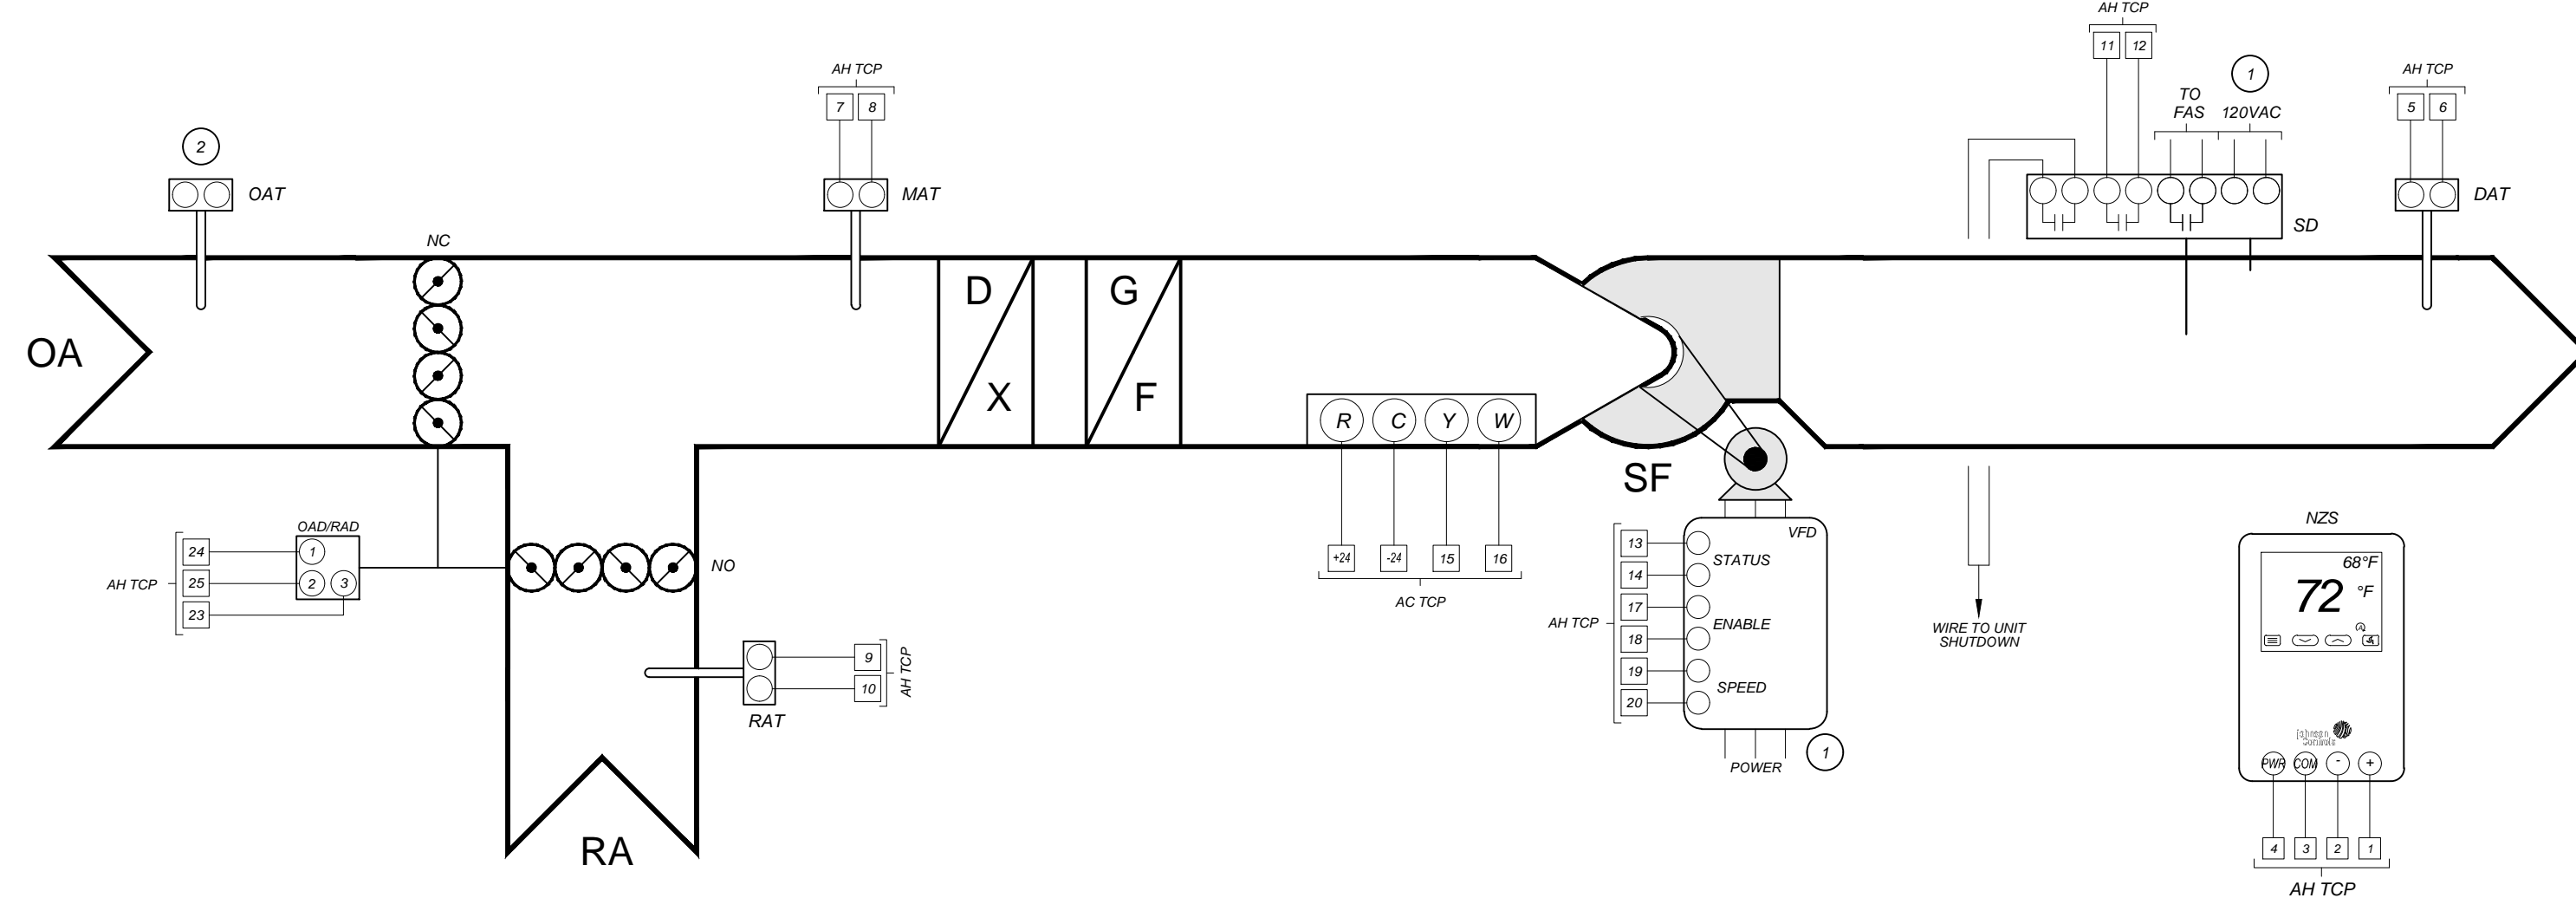

AIR HANDLER CONTROL DETAIL

C
M-8

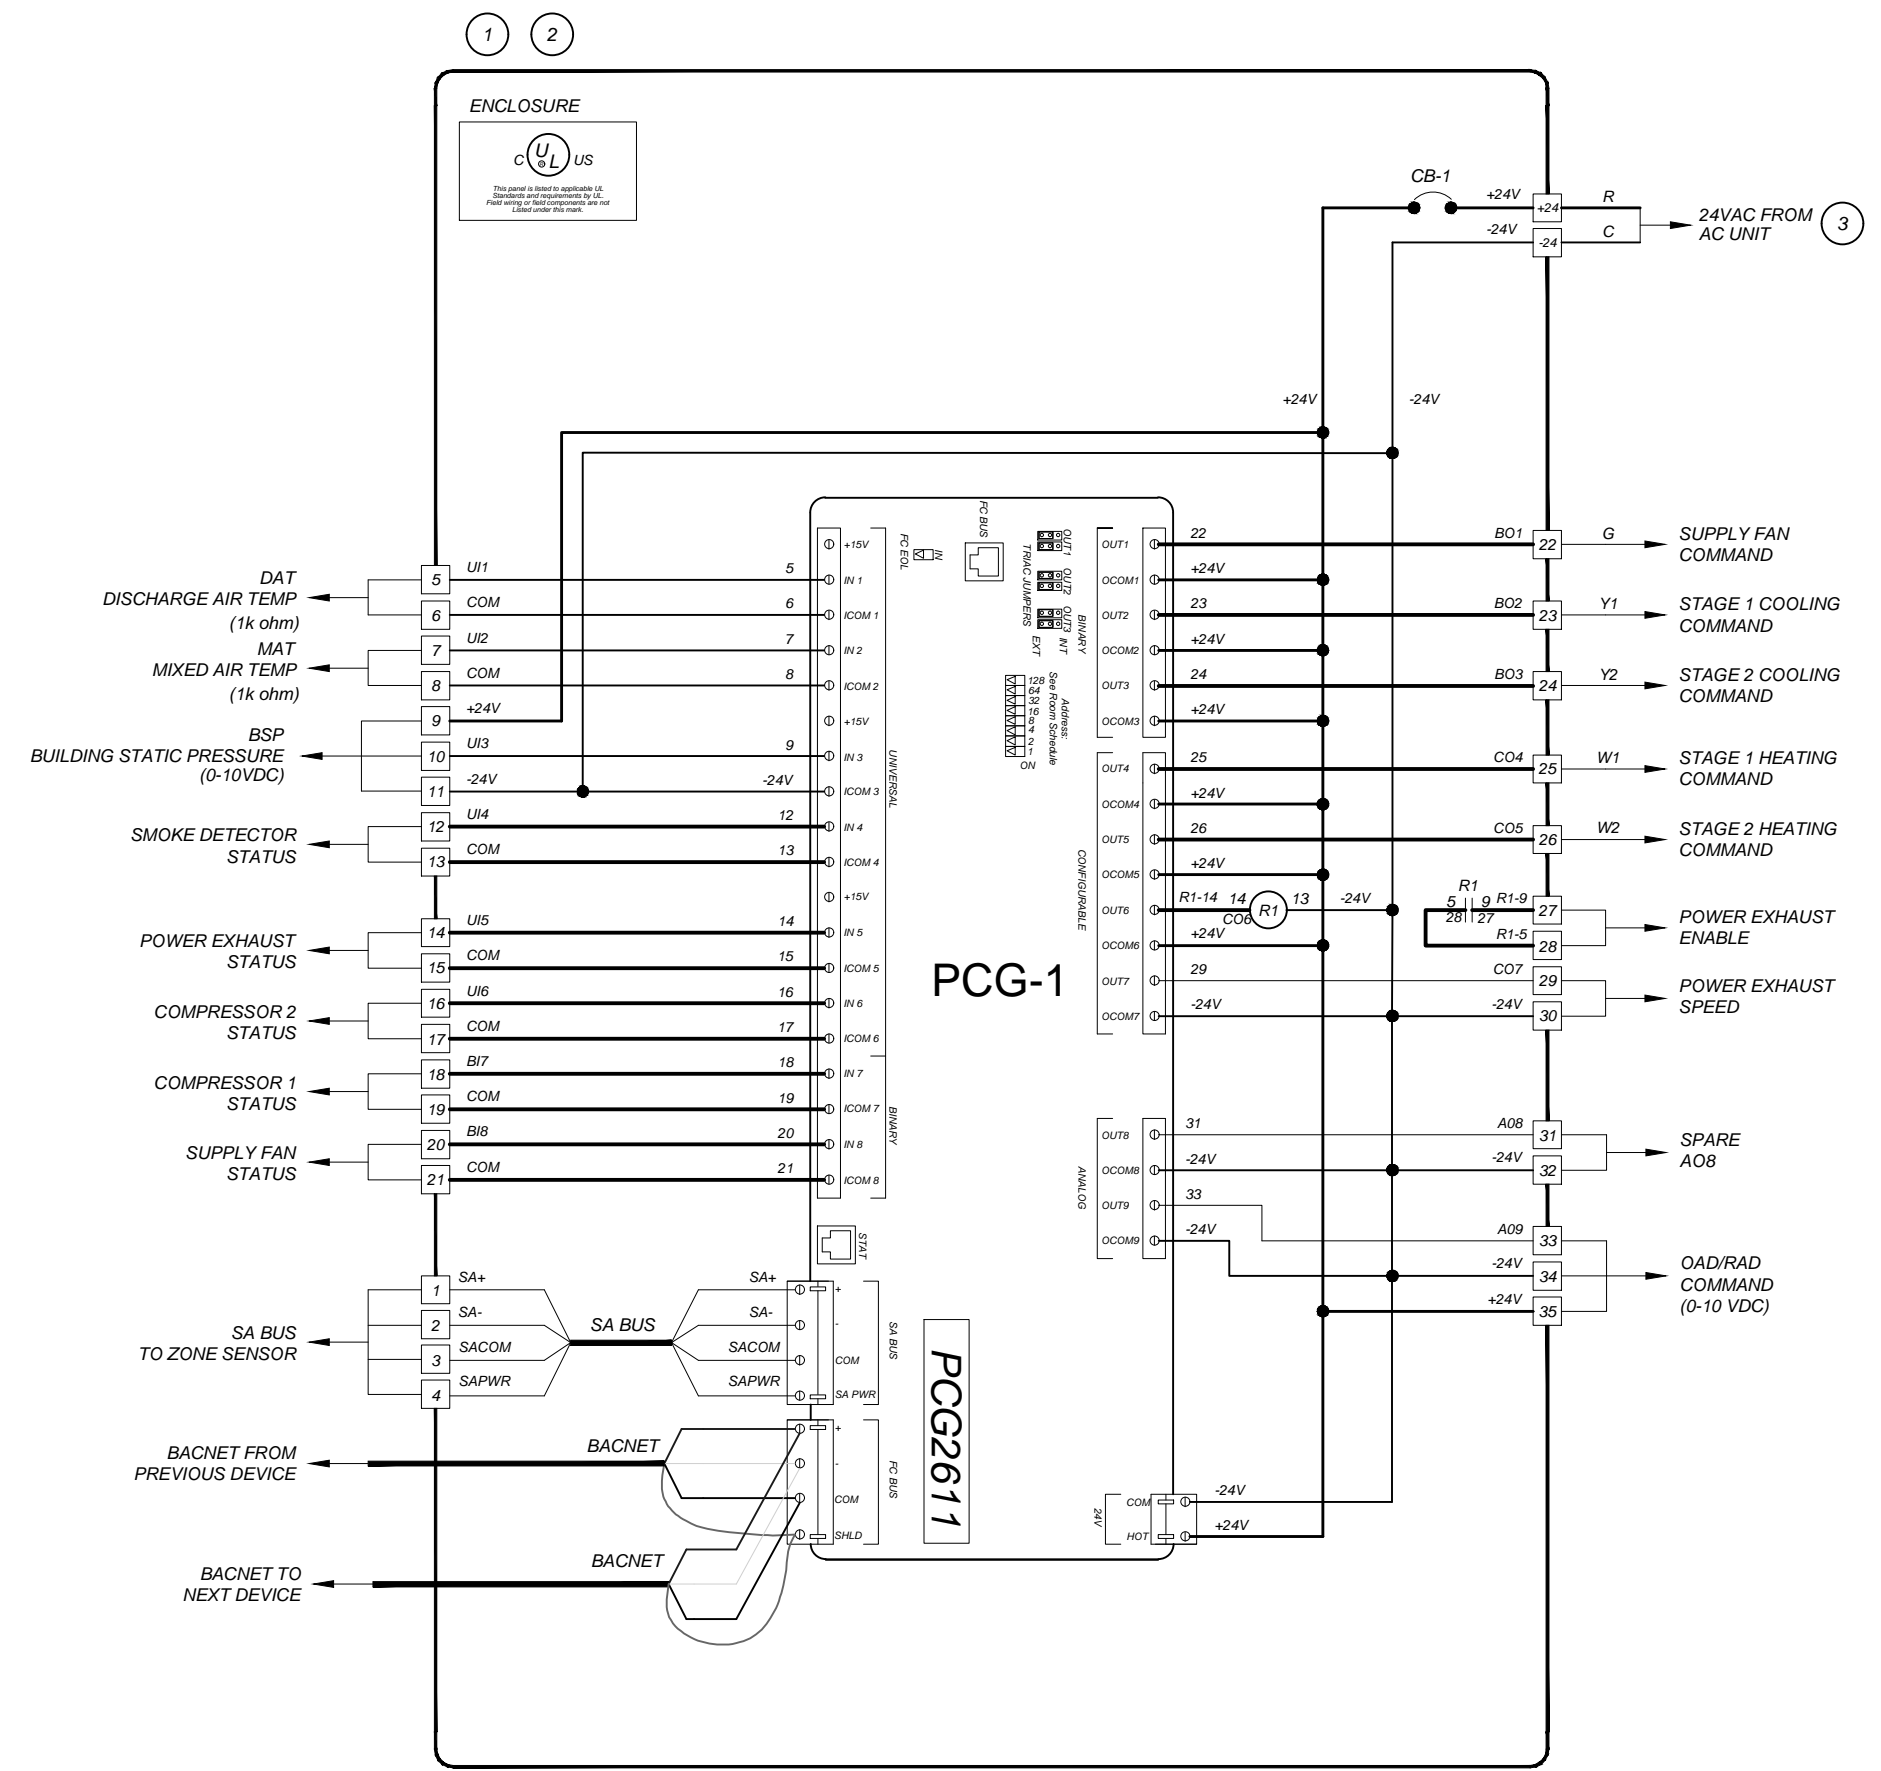


NOTE: ALL WIRES INSIDE OF PANEL TO BE LABELED AS SHOWN WITH HEAT SHRINK MARKERS ON TERMINATING ENDS OF WIRE.

Panel Components	
TAG	DESCRIPTION
PCG	GENERAL PROGRAMMABLE CONTROLLER
ENC	SEE SPEC'S FOR NEMA RATING
ENC	BACKPLATE ENCLOSURE
ENC	PANEL LOCK KIT
CB-1	2.0 AMP CIRCUIT BREAKER
R1	2-POLE 24VAC RELAY W/ LED
R1	2-POLE RELAY BASE

Sheet Notes
1 CONTROL PANEL FABRICATED BY TOTAL CONTROL CONTACT DEVEN PUTNAM AT 559-291-1000
2 PANEL SHALL BE UL LISTED
3 LINE VOLTAGE & CONDUIT BY DIVISION 16.

ROOF TOP UNIT TCP SCHEMATIC DETAIL

B
M-8

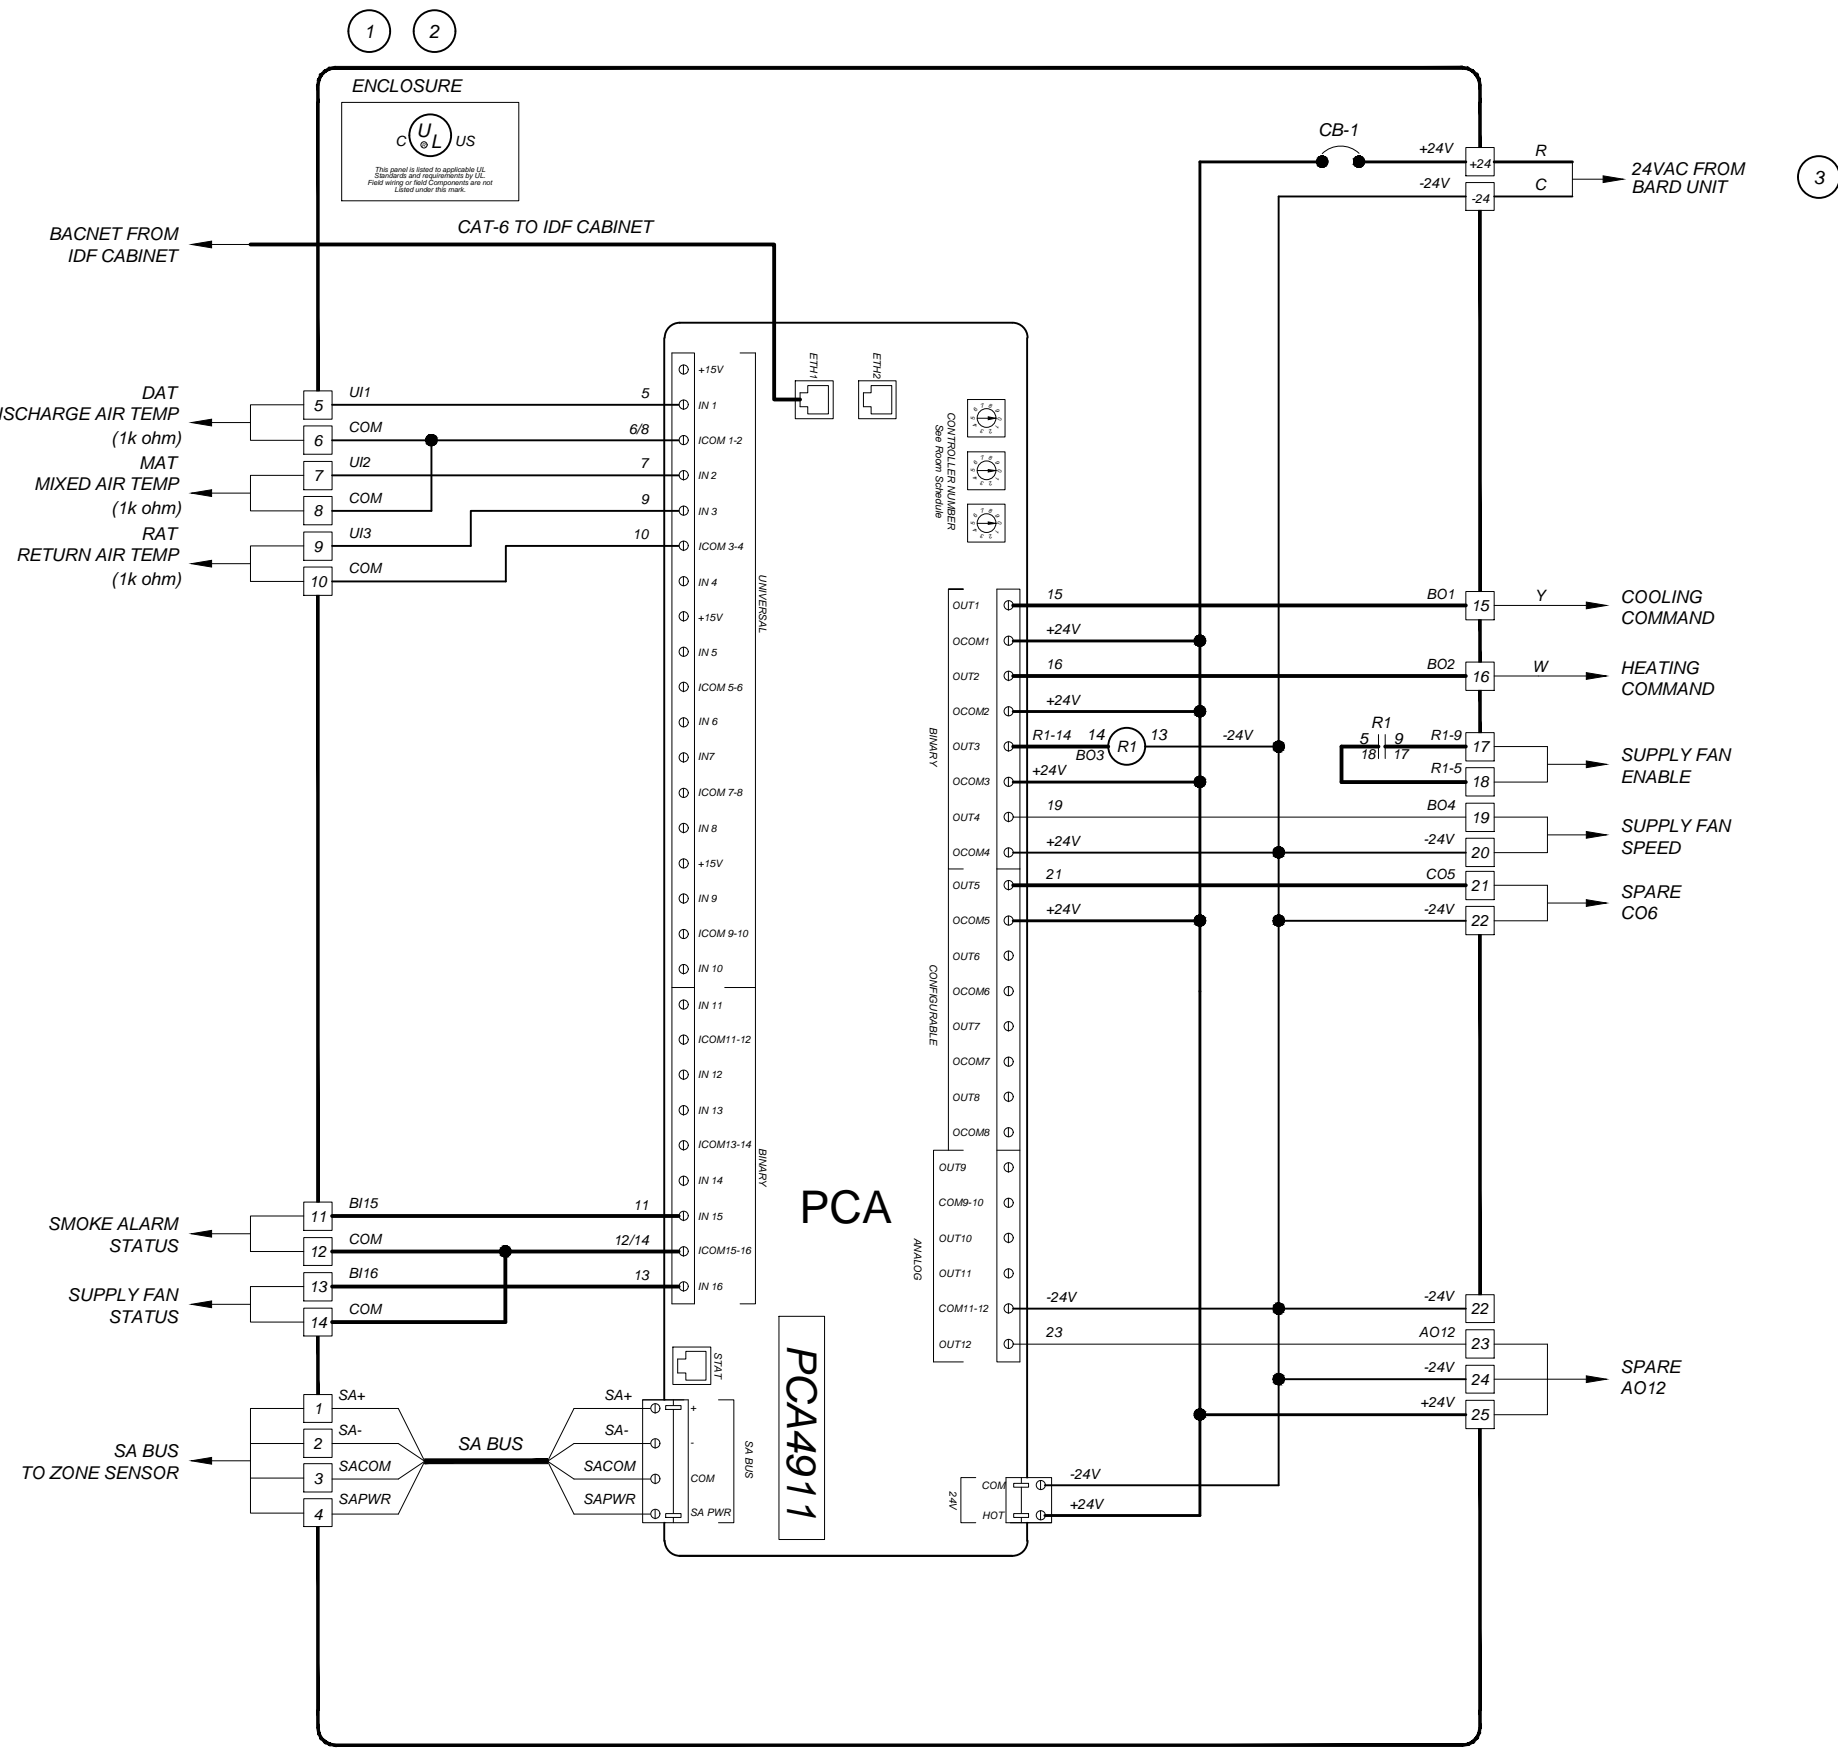


NOTE: ALL WIRES INSIDE OF PANEL TO BE LABELED AS SHOWN WITH HEAT SHRINK MARKERS ON TERMINATING ENDS OF WIRE.

Panel Components	
TAG	DESCRIPTION
PCA	ADVANCED PROGRAMMABLE CONTROLLER
ENC	SEE SPEC'S FOR NEMA RATING
ENC	BACKPLATE ENCLOSURE
ENC	PANEL LOCK KIT
CB-1	MANUAL RESET 2.0 AMP CIRCUIT BREAKER
R1	2-POLE 24VAC RELAY W/ LED
R1	2-POLE RELAY BASE

Detail Notes
1 CONTROL PANEL FABRICATED BY TOTAL CONTROL CONTACT DEVEN PUTNAM AT 559-291-1000.
2 PANEL SHALL BE UL LISTED
3 LINE VOLTAGE & CONDUIT BY DIVISION 16.

AIR HANDLER TCP SCHEMATIC DETAIL

D
M-8

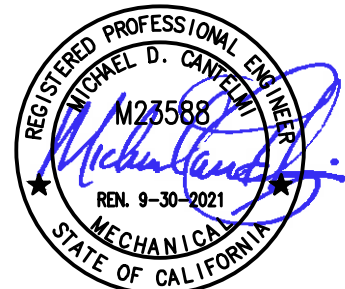

EMS REPLACEMENT
EATON ELEMENTARY SCHOOL
1451 EAST SIERRA AVE. FRESNO, CA
FRESNO UNIFIED SCHOOL DISTRICT
4600 N. BRAWLEY AVE. FRESNO, CA.

REVISIONS
4/22/21 EMS REVISIONS


LAWRENCE
ENGINEERING GROUP
Fresno, CA 93720
7084 N. Maple Ave., Suite 101
(559) 431-0101
FAX (559) 431-1362

TITLE:
ENERGY
MANAGEMENT
DETAILS

SHEET:
M9
PROJECT 20138

Control Components	
TAG	DESCRIPTION
DAT	DUCT TEMP SENSOR
SFCS, CCS	CURRENT SENSOR
NZS	NETWORK ZONE SENSOR W/ CO

Detail Notes	
1	LINE VOLTAGE & CONDUIT BY DIVISION 16.
2	CONTROL COMPONENTS PROVIDED BY TOTAL CONTROL CONTACT DEVEN PUTNAM AT 559-291-1000
3	SEE DETAIL B/M-9 FOR TCP DIAGRAM.

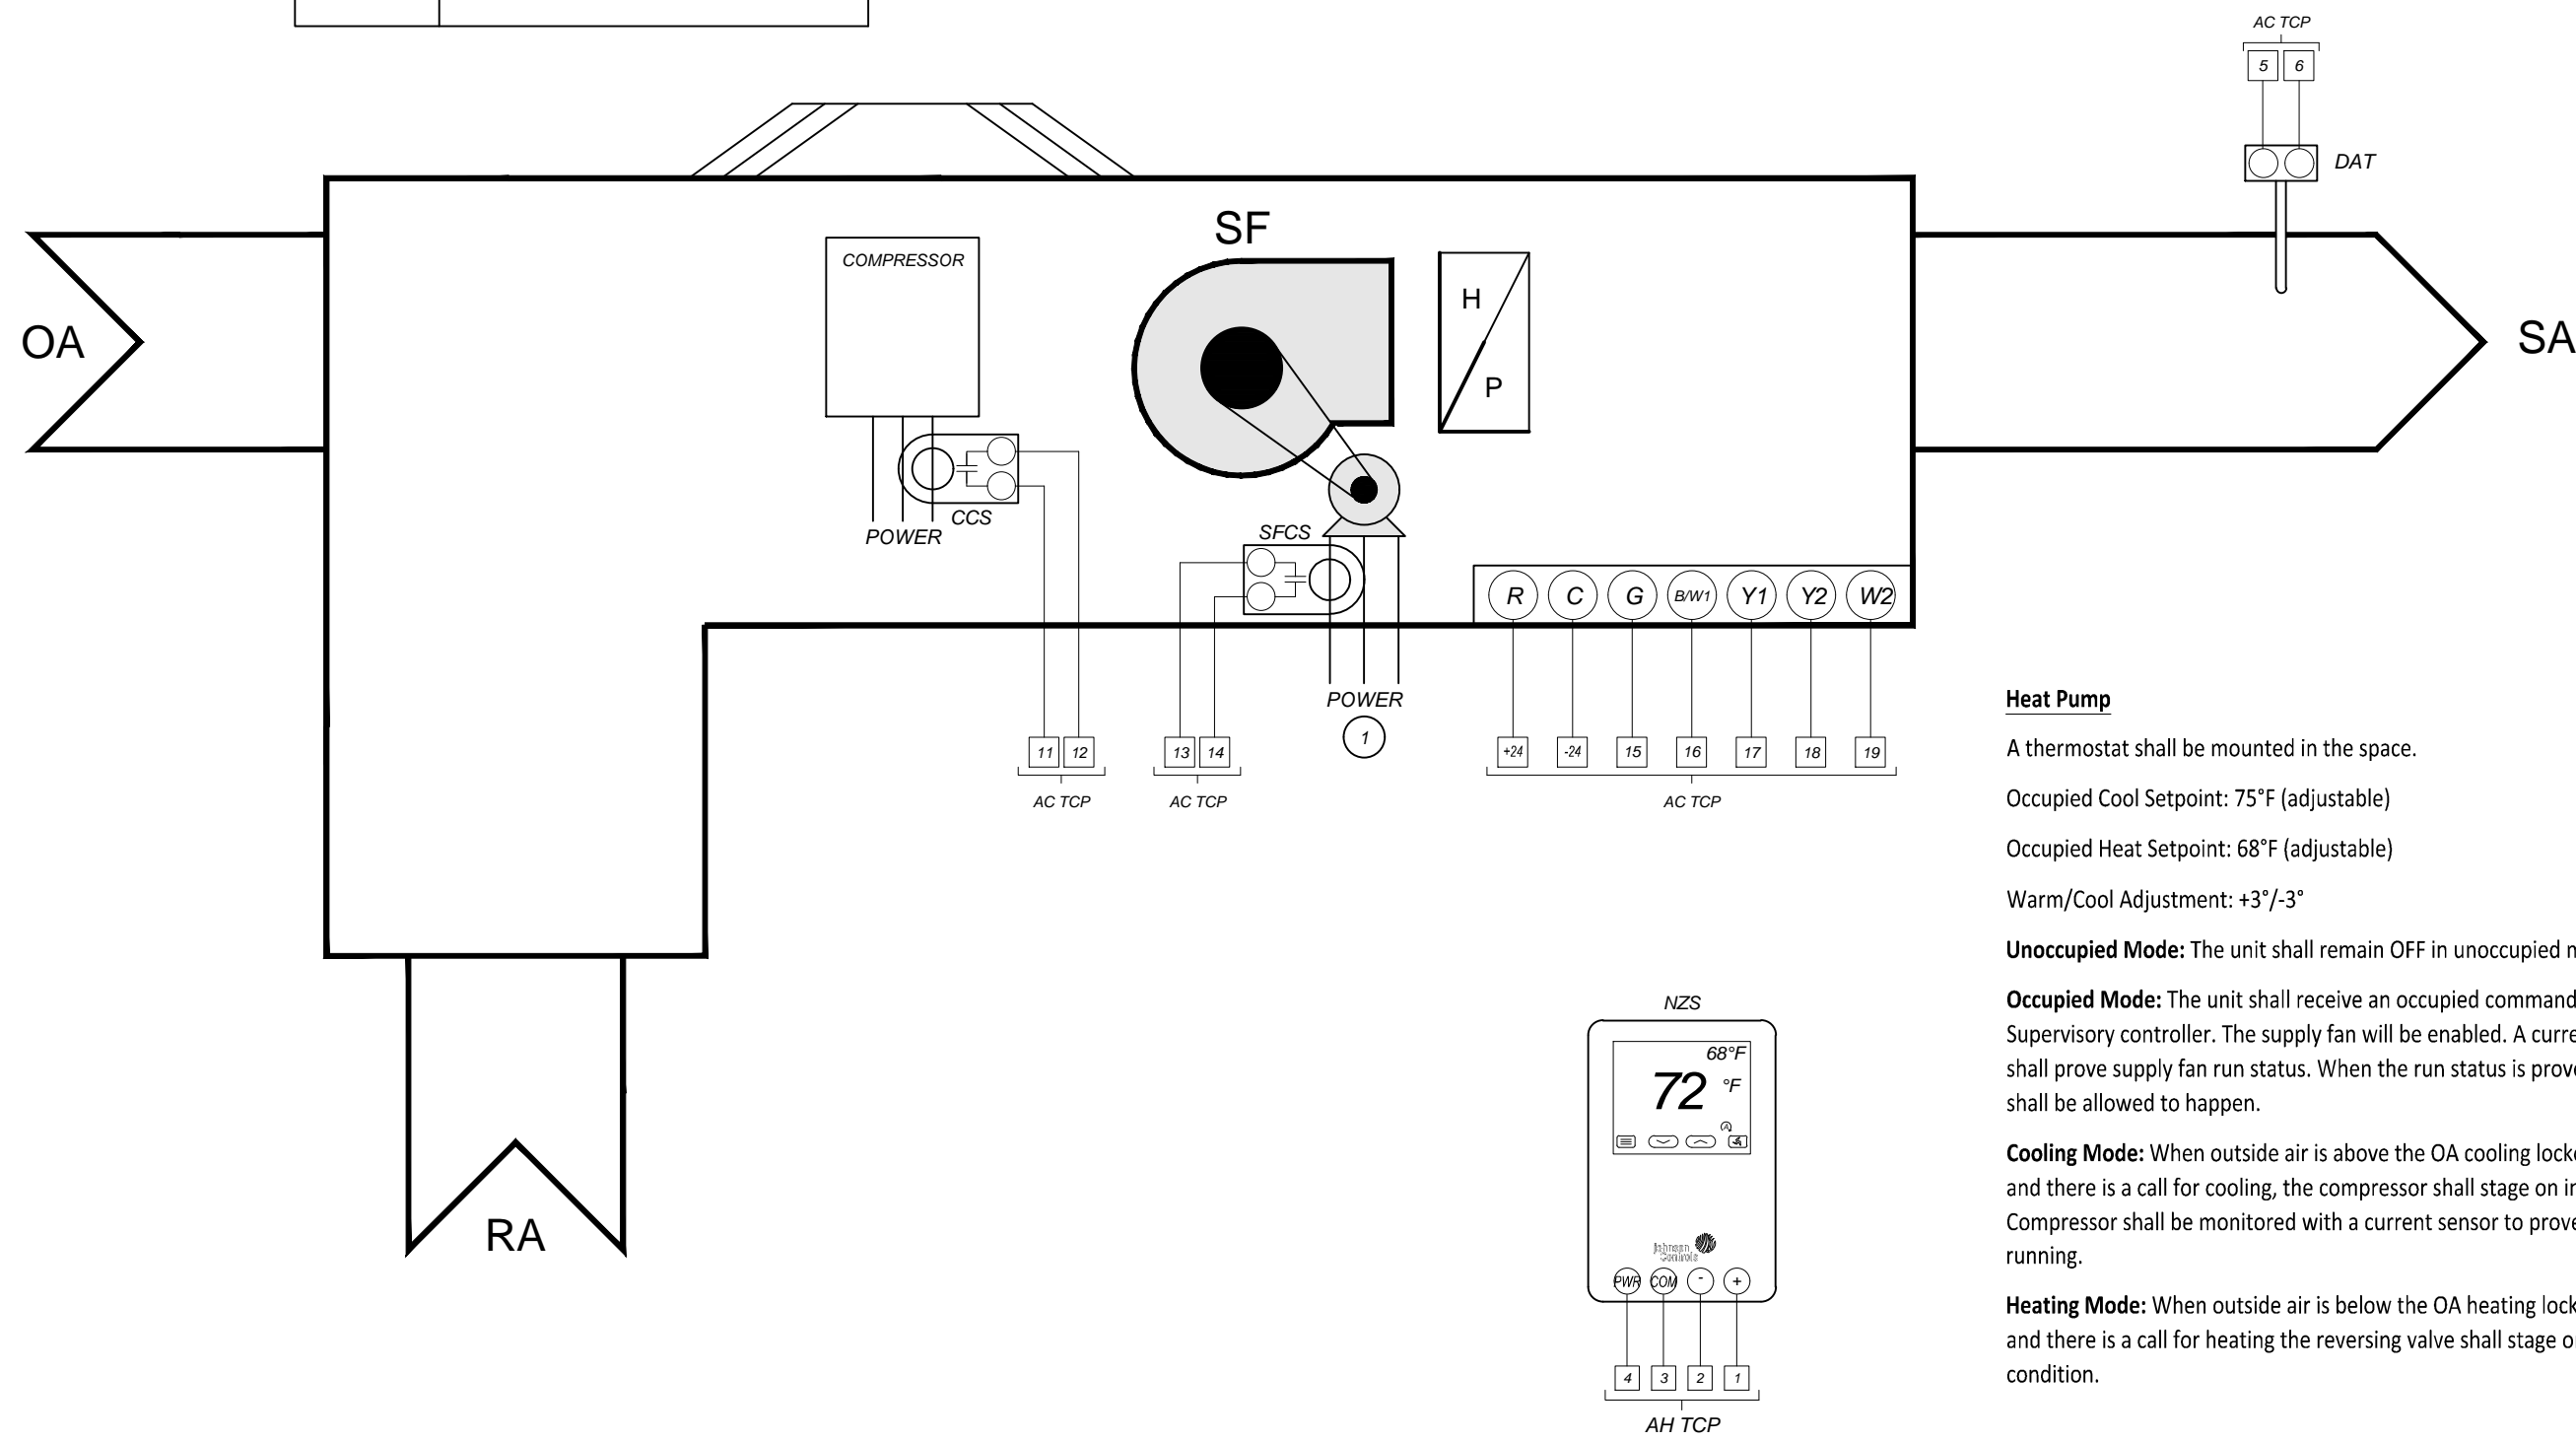


WALL MOUNTED HEAT PUMP CONTROL DETAIL

A
M-9

NOTE: ALL WIRES INSIDE OF PANEL TO BE LABELED AS SHOWN WITH HEAT SHRINK MARKERS ON TERMINATING ENDS OF WIRE.

Panel Components	
TAG	DESCRIPTION
PCA	ADVANCED PROGRAMMABLE CONTROLLER
CB-1	MANUAL RESET 2.0 AMP CIRCUIT BREAKER
ENC	SEE SPEC'S FOR NEMA RATING
ENC	BACKPLATE ENCLOSURE
ENC	PANEL LOCK KIT
TCP	TCP LABEL


Detail Notes	
1	CONTROL PANEL FABRICATED BY TOTAL CONTROL CONTACT DEVEN PUTNAM AT 559-291-1000.
2	PANEL SHALL BE UL LISTED
3	LINE VOLTAGE & CONDUIT BY DIVISION 16.
4	

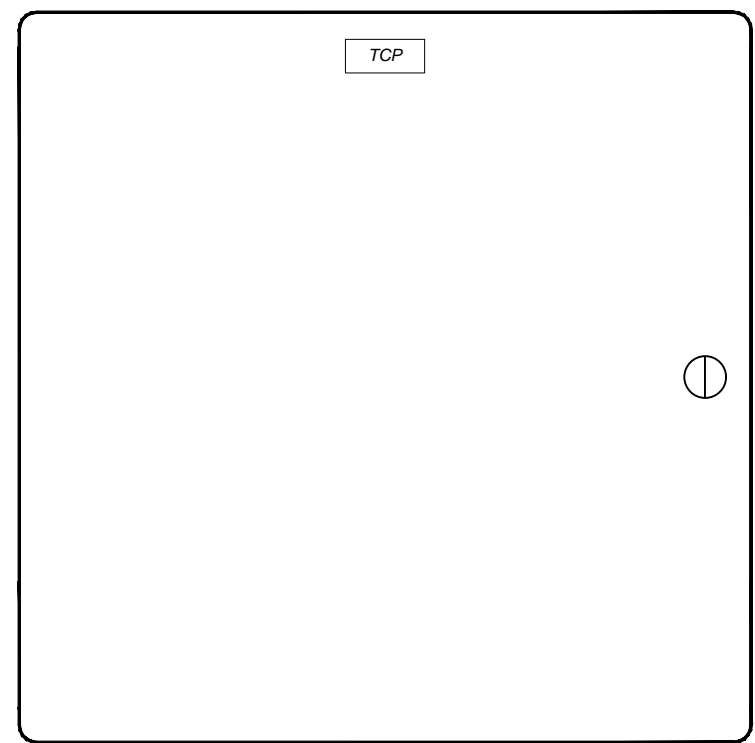

PANEL DOOR LAYOUT

B
M-9


WALL MOUNTED HEAT PUMP TCP SCHEMATIC DETAIL

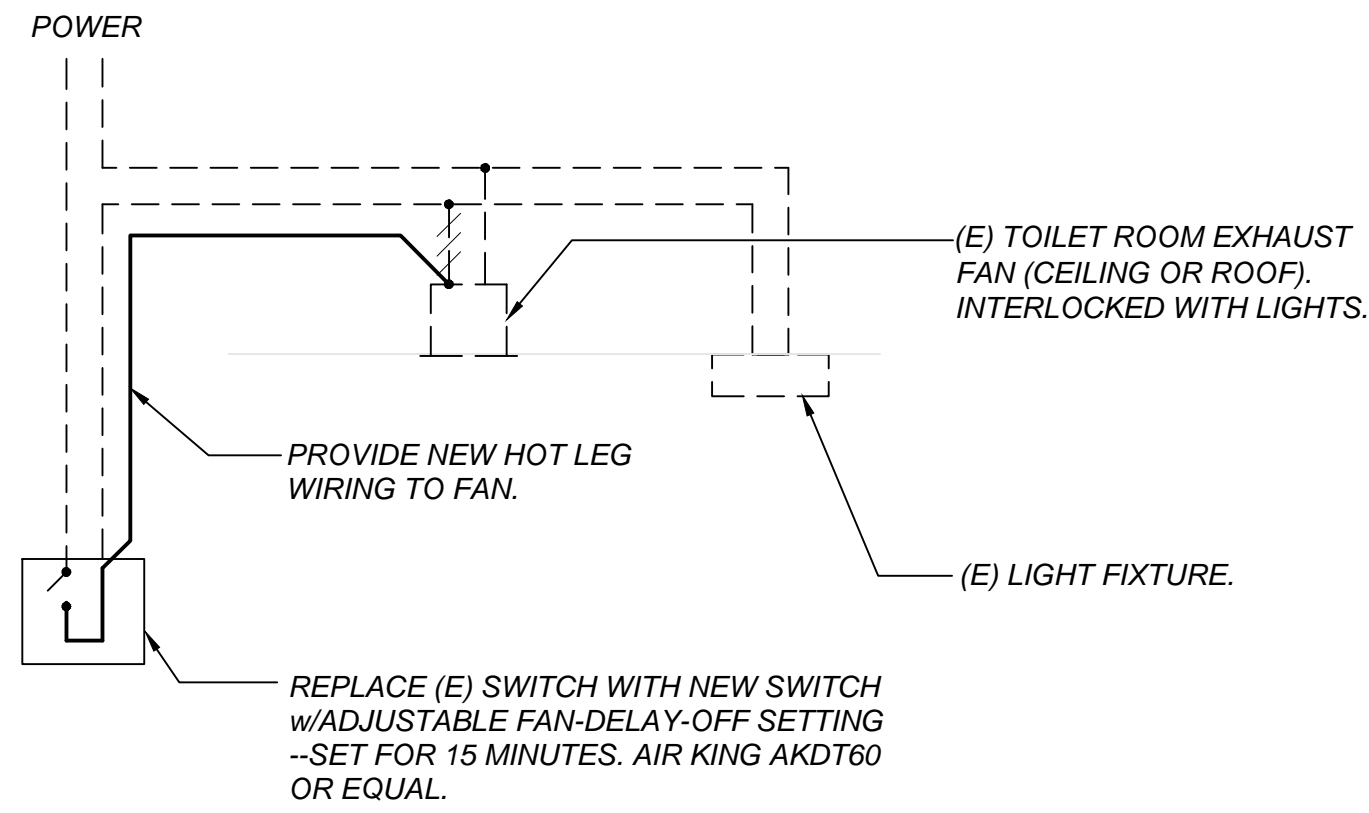

LIGHT / EXHAUST TIMER SWITCH

SCALE: NONE


C
M-9

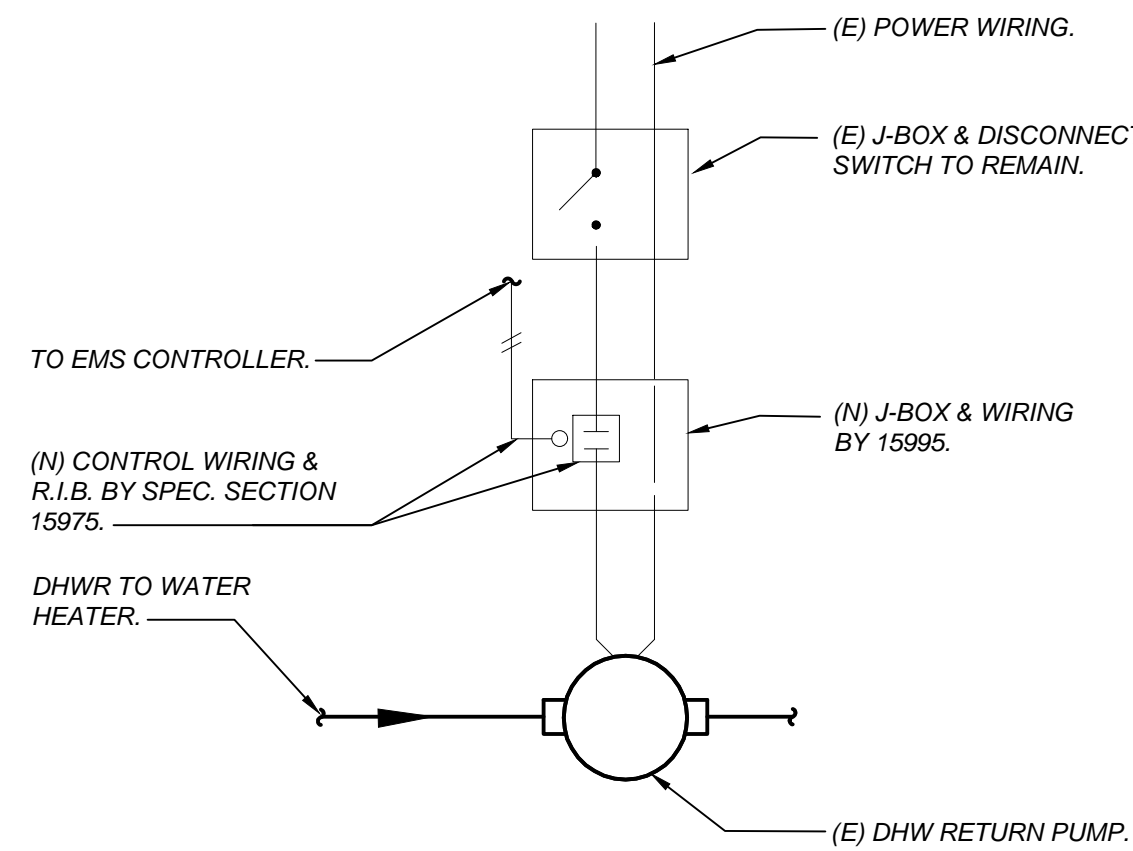

DOMESTIC H.W.R. PUMP CONTROL

SCALE: NONE


D
M-9

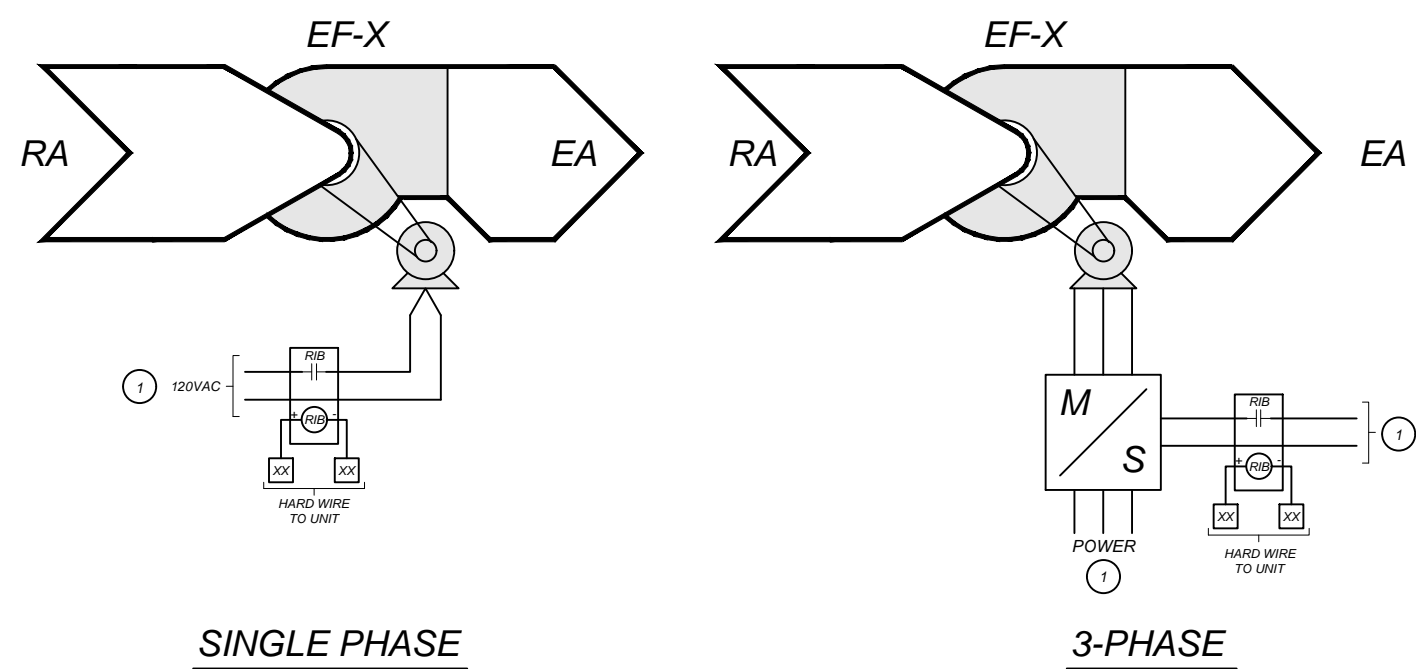

EXHAUST FAN INTERLOCK CONTROL

SCALE: NONE

E
M-9

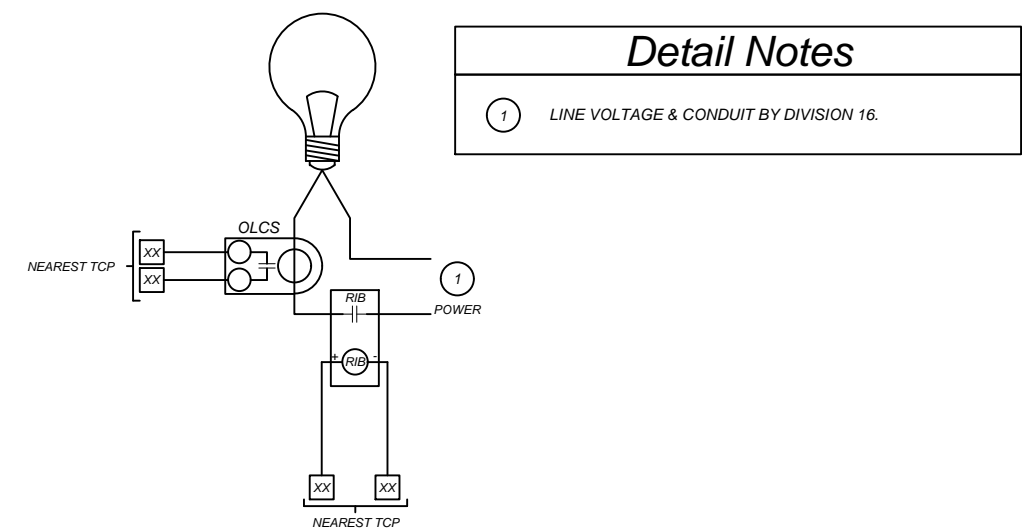


LIGHTING CONTROL

EXTERIOR LIGHTING CONTROL DETAIL

SCALE: NONE

F
M-9

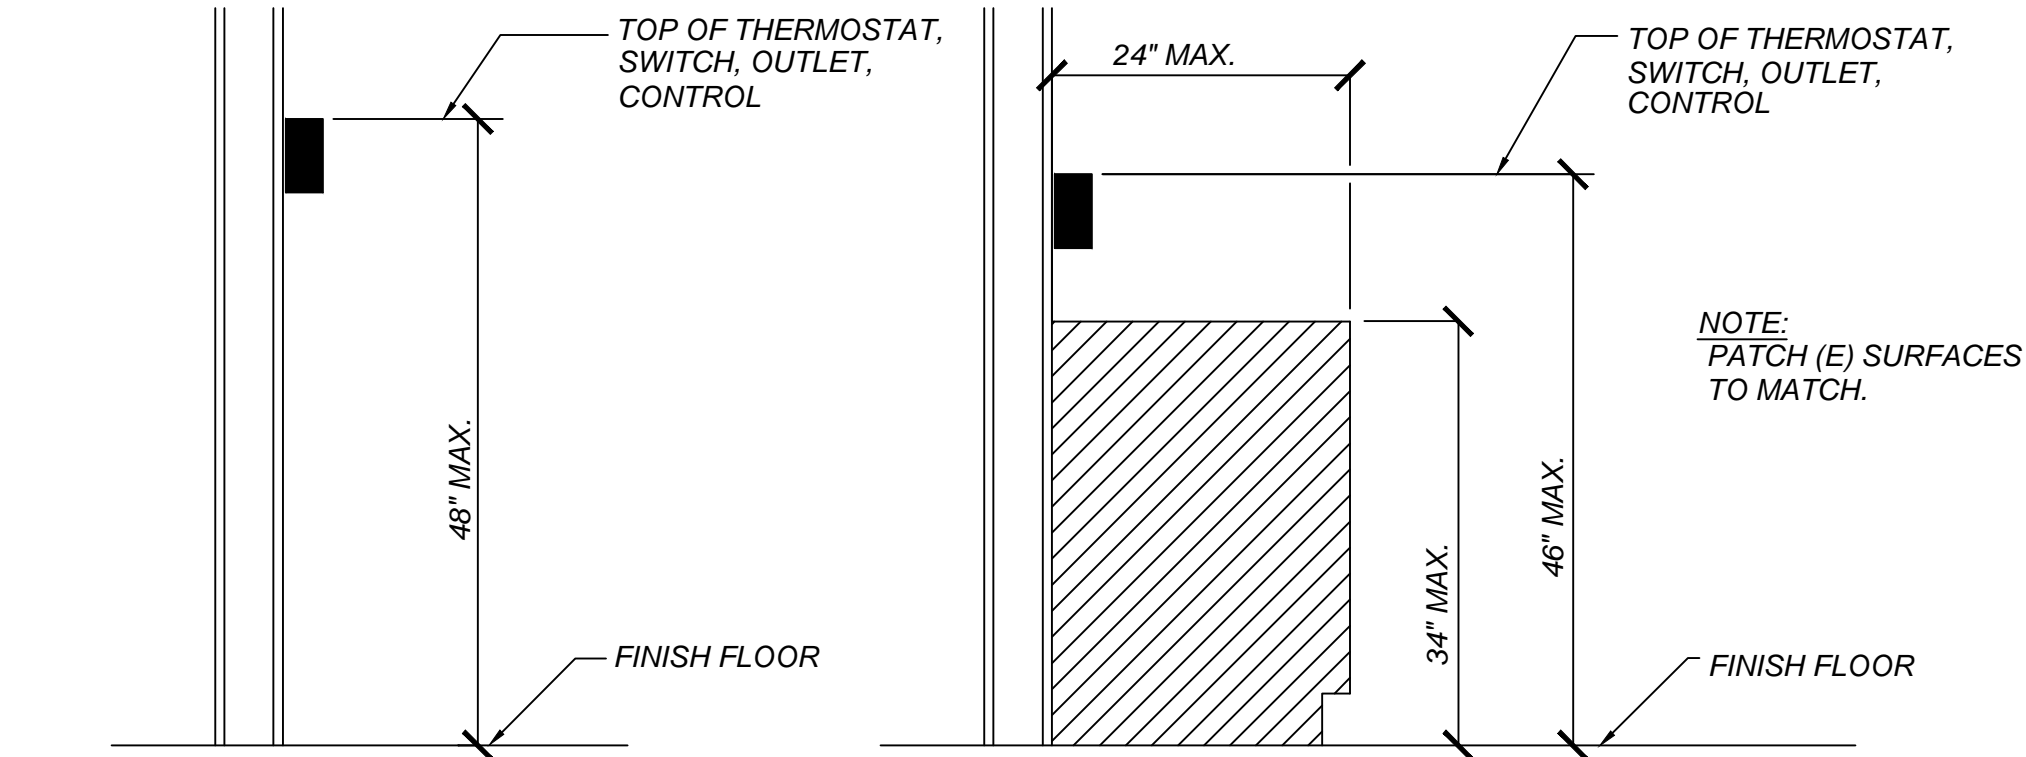


MOUNTING HEIGHT OVER OBSTRUCTION

THERMOSTAT MOUNTING

SCALE: NONE

A
M-10

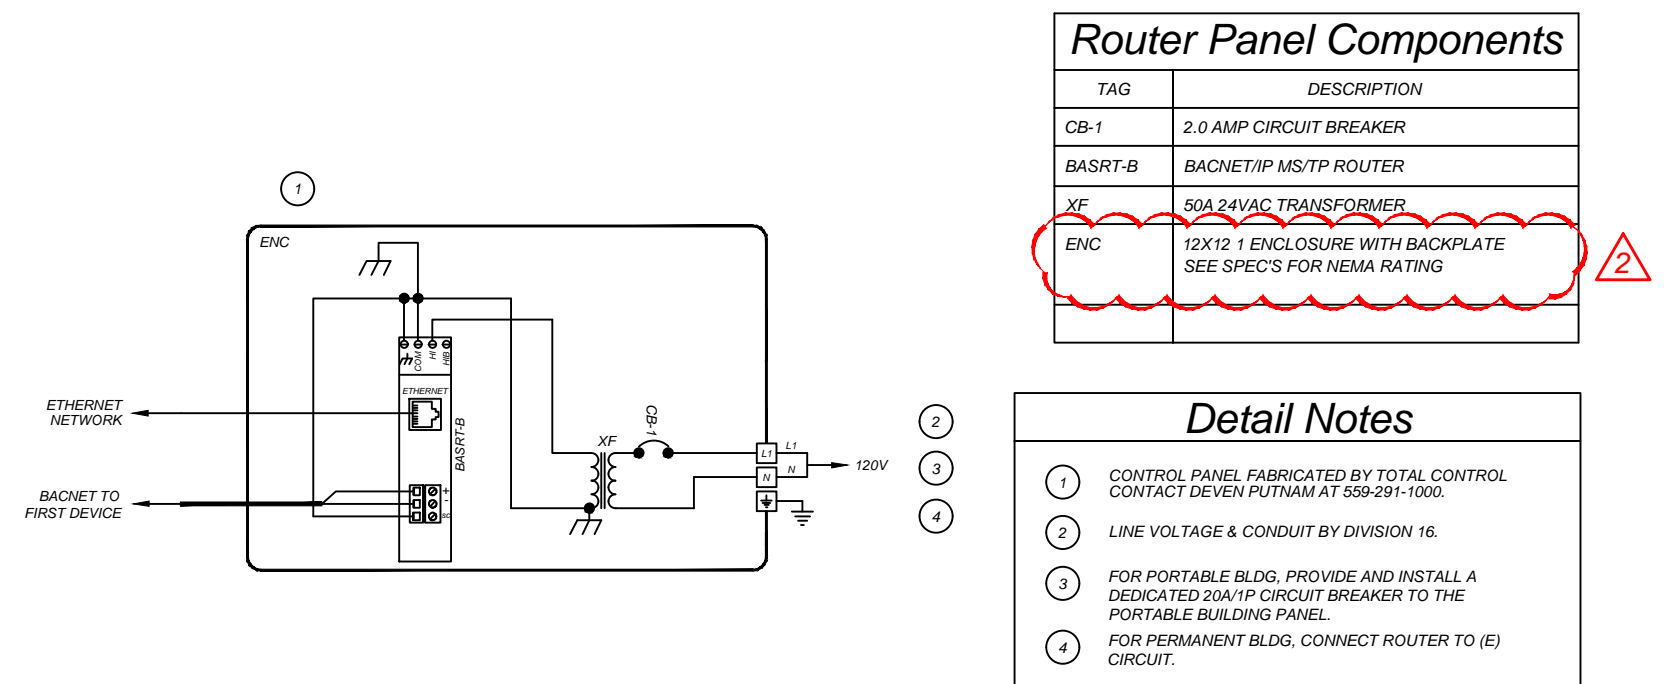


BACNET/IP MS/TP ROUTER PANEL DETAIL

SCALE: NONE

B
M-10

APPROVALS:
APPLICATION #
?????????

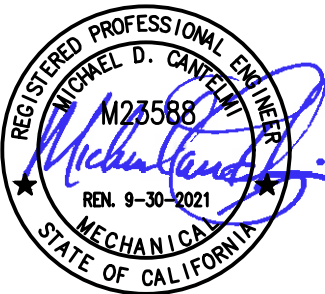

DATE: 11-25-2020


EMS REPLACEMENT
EATON ELEMENTARY SCHOOL
1451 EAST SIERRA AVE. FRESNO, CA
FRESNO UNIFIED SCHOOL DISTRICT
4600 N. BRAWLEY AVE. FRESNO, CA.

REVISIONS					
4/22/21	EMS REVISIONS				

LAWRENCE
ENGINEERING GROUP
Fresno, CA 93720
(559) 431-0101
7084 N. Maple Ave., Suite 101
(559) 431-1362

TITLE:
ENERGY
MANAGEMENT
DETAILS

SHEET:
M10
PROJECT 20138

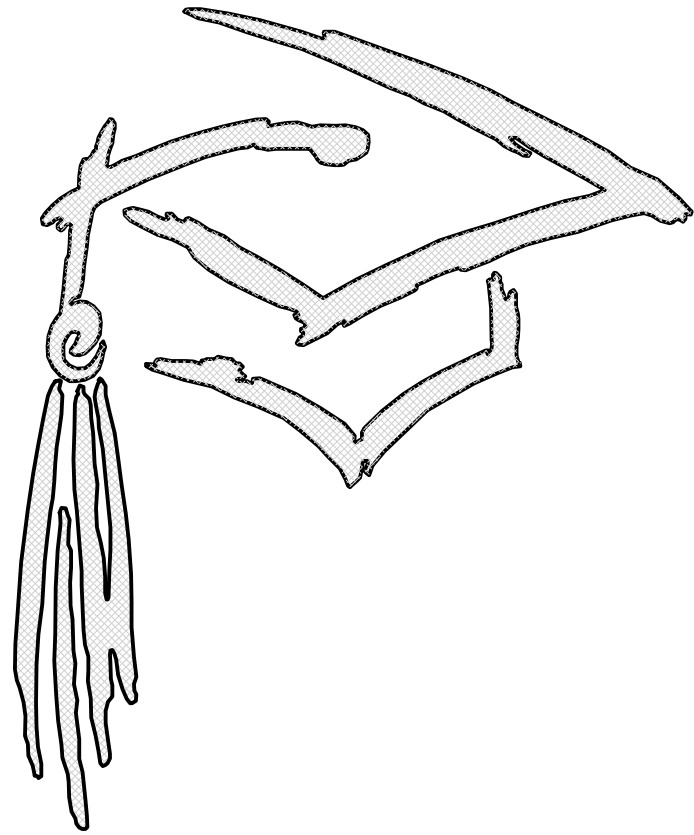

FRESNO UNIFIED SCHOOL DISTRICT

ROWELL ELEMENTARY SCHOOL

EMS REPLACEMENT

3460 E. McKENZIE AVE.
FRESNO, CALIFORNIA 93702

OWNER
FRESNO UNIFIED SCHOOL DISTRICT

4600 N. BRAWLEY AVE.
FRESNO, CA 93722
(559) 457-3064

CONTACT: DANNY ANDERSON

MECHANICAL ENGINEER
LAWRENCE ENGINEERING GROUP

7084 NORTH MAPLE AVE. SUITE 101
FRESNO, CA 93720
(559) 431-0101

CONTACT: MICHAEL CANTELM

ELECTRICAL ENGINEER
HARDIN-DAVIDSON ENGINEERING, INC.
356 POLLASKY AVE. SUITE 200
CLOVIS, CA 93612
(559) 323-4995

CONTACT: RICH HARDIN

GENERAL NOTES:


- ALL WORK SHALL CONFORM TO 2019 EDITION TITLE 24, CALIFORNIA CODE OF REGULATIONS (CCR).
- CHANGE TO THE APPROVED DRAWINGS AND SPECIFICATIONS SHALL BE MADE BY ADDENDA OR CONSTRUCTION CHANGE DOCUMENT (CCD) APPROVED BY DSA, AS REQUIRED BY SECTION 4-338, PART 1, TITLE 24, CCR.
- A "DSA CERTIFIED" PROJECT INSPECTOR EMPLOYED BY THE DISTRICT (OWNER) AND APPROVED BY DSA SHALL PROVIDE CONTINUOUS INSPECTION OF THE WORK. THE DUTIES OF THE INSPECTOR ARE DEFINED IN SECTION 4-342, PART 1, TITLE 24, CCR. PROJECT REQUIRES A CLASS 3 INSPECTOR.
- A DSA ACCEPTED TESTING LABORATORY DIRECTLY EMPLOYED BY THE DISTRICT (OWNER) SHALL CONDUCT ALL THE REQUIRED TESTS AND INSPECTIONS FOR THE PROJECT.
- THE INTENT OF THESE DRAWINGS AND SPECIFICATIONS IS THAT THE WORK OF THE ALTERATION, REHABILITATION OR RECONSTRUCTION IS TO BE IN ACCORDANCE WITH TITLE 24, CCR. SHOULD ANY EXISTING CONDITIONS SUCH AS DETERIORATION OR NON-COMPLYING CONSTRUCTION BE DISCOVERED WHICH IS NOT COVERED BY THE CONTRACT DOCUMENTS WHEREIN THE FINISHED WORK WILL NOT COMPLY WITH TITLE 24, CCR, A CONSTRUCTION CHANGE DOCUMENT (CCD), OR A SEPARATE SET OF PLANS AND SPECIFICATIONS, DETAILING AND SPECIFYING THE REQUIRED WORK SHALL SUBMITTED TO AND APPROVED BY DSA BEFORE PROCEEDING WITH THE WORK. (SECTION 4-317(C), PART 1, TITLE 24, CCR)

PROJECT NOTES:

- PROVIDE ALL NEW CONTROL WIRE.
- PROVIDE ALL NEW ACTUATORS. RETURN EXISTING ACTUATORS TO DISTRICT.
- PROVIDE A NEW OUTSIDE AIR TEMPERATURE SENSOR AT EACH MULTI-ZONE.
- PROVIDE NEW CONTROLS FOR ALL EXHAUST FANS.
- PROVIDE NEW CONTROLS FOR EXTERIOR LIGHTING. REFER TO FLOOR PLAN SHEETS. MOUNT HARDWARE IN NEW LOCKABLE ENCLOSURES.
- PROGRAMMING SHALL BE IN THE CONTROLLERS AT THE UNIT, NOT THE FRONT END. THE FRONT END IS A MONITORING STATUS, ON-OFF DEVICE ONLY.
- WIRING IN ATTICS SHALL BE SUPPORTED ON J-HOOKS. NO WIRING ON ROOF.
- SALVAGE ALL CONTROL EQUIPMENT AND RETURN TO OWNER.
- PROVIDE AND INSTALL A 20A/1P, DUPLEX RECEPTACLE WITH CIRCUIT AND CIRCUIT BREAKER FROM THE NEAREST 120 VOLT PANEL IS 80-FEET AWAY FIELD LOCATE. PROVIDE POWER CONNECTIONS TO EACH ENERGY MANAGEMENT RIB. REFER TO MECHANICAL/EMS PLANS FOR EQUIPMENT LOCATIONS.
- REUSE (E) CONTROLLER ENCLOSURE WHERE FEASIBLE.

APPLICABLE CODES

2019 California Administrative Code - CCR Title 24, Part 1
2019 California Building Code - CCR Title 24, Part 2
2019 California Electrical Code - CCR Title 24, Part 3
2019 California Mechanical Code - CCR Title 24, Part 4
2019 California Plumbing Code - CCR Title 24, Part 5
2019 California Energy Code - CCR Title 24, Part 6
2019 California Fire Code - CCR Title 24, Part 9
2019 Existing Building Code - CCR Title 24, Part 10
2019 California Green Code - CCR Title 24, Part 11
2019 California Reference Code - CCR Title 24, Part 12
Title 19 CCR Public Safety, State Fire Marshall Regulations
2019 NFPA 72 for Fire Alarm System.
CFC CH 33 Fire Safety During Construction and Demolition

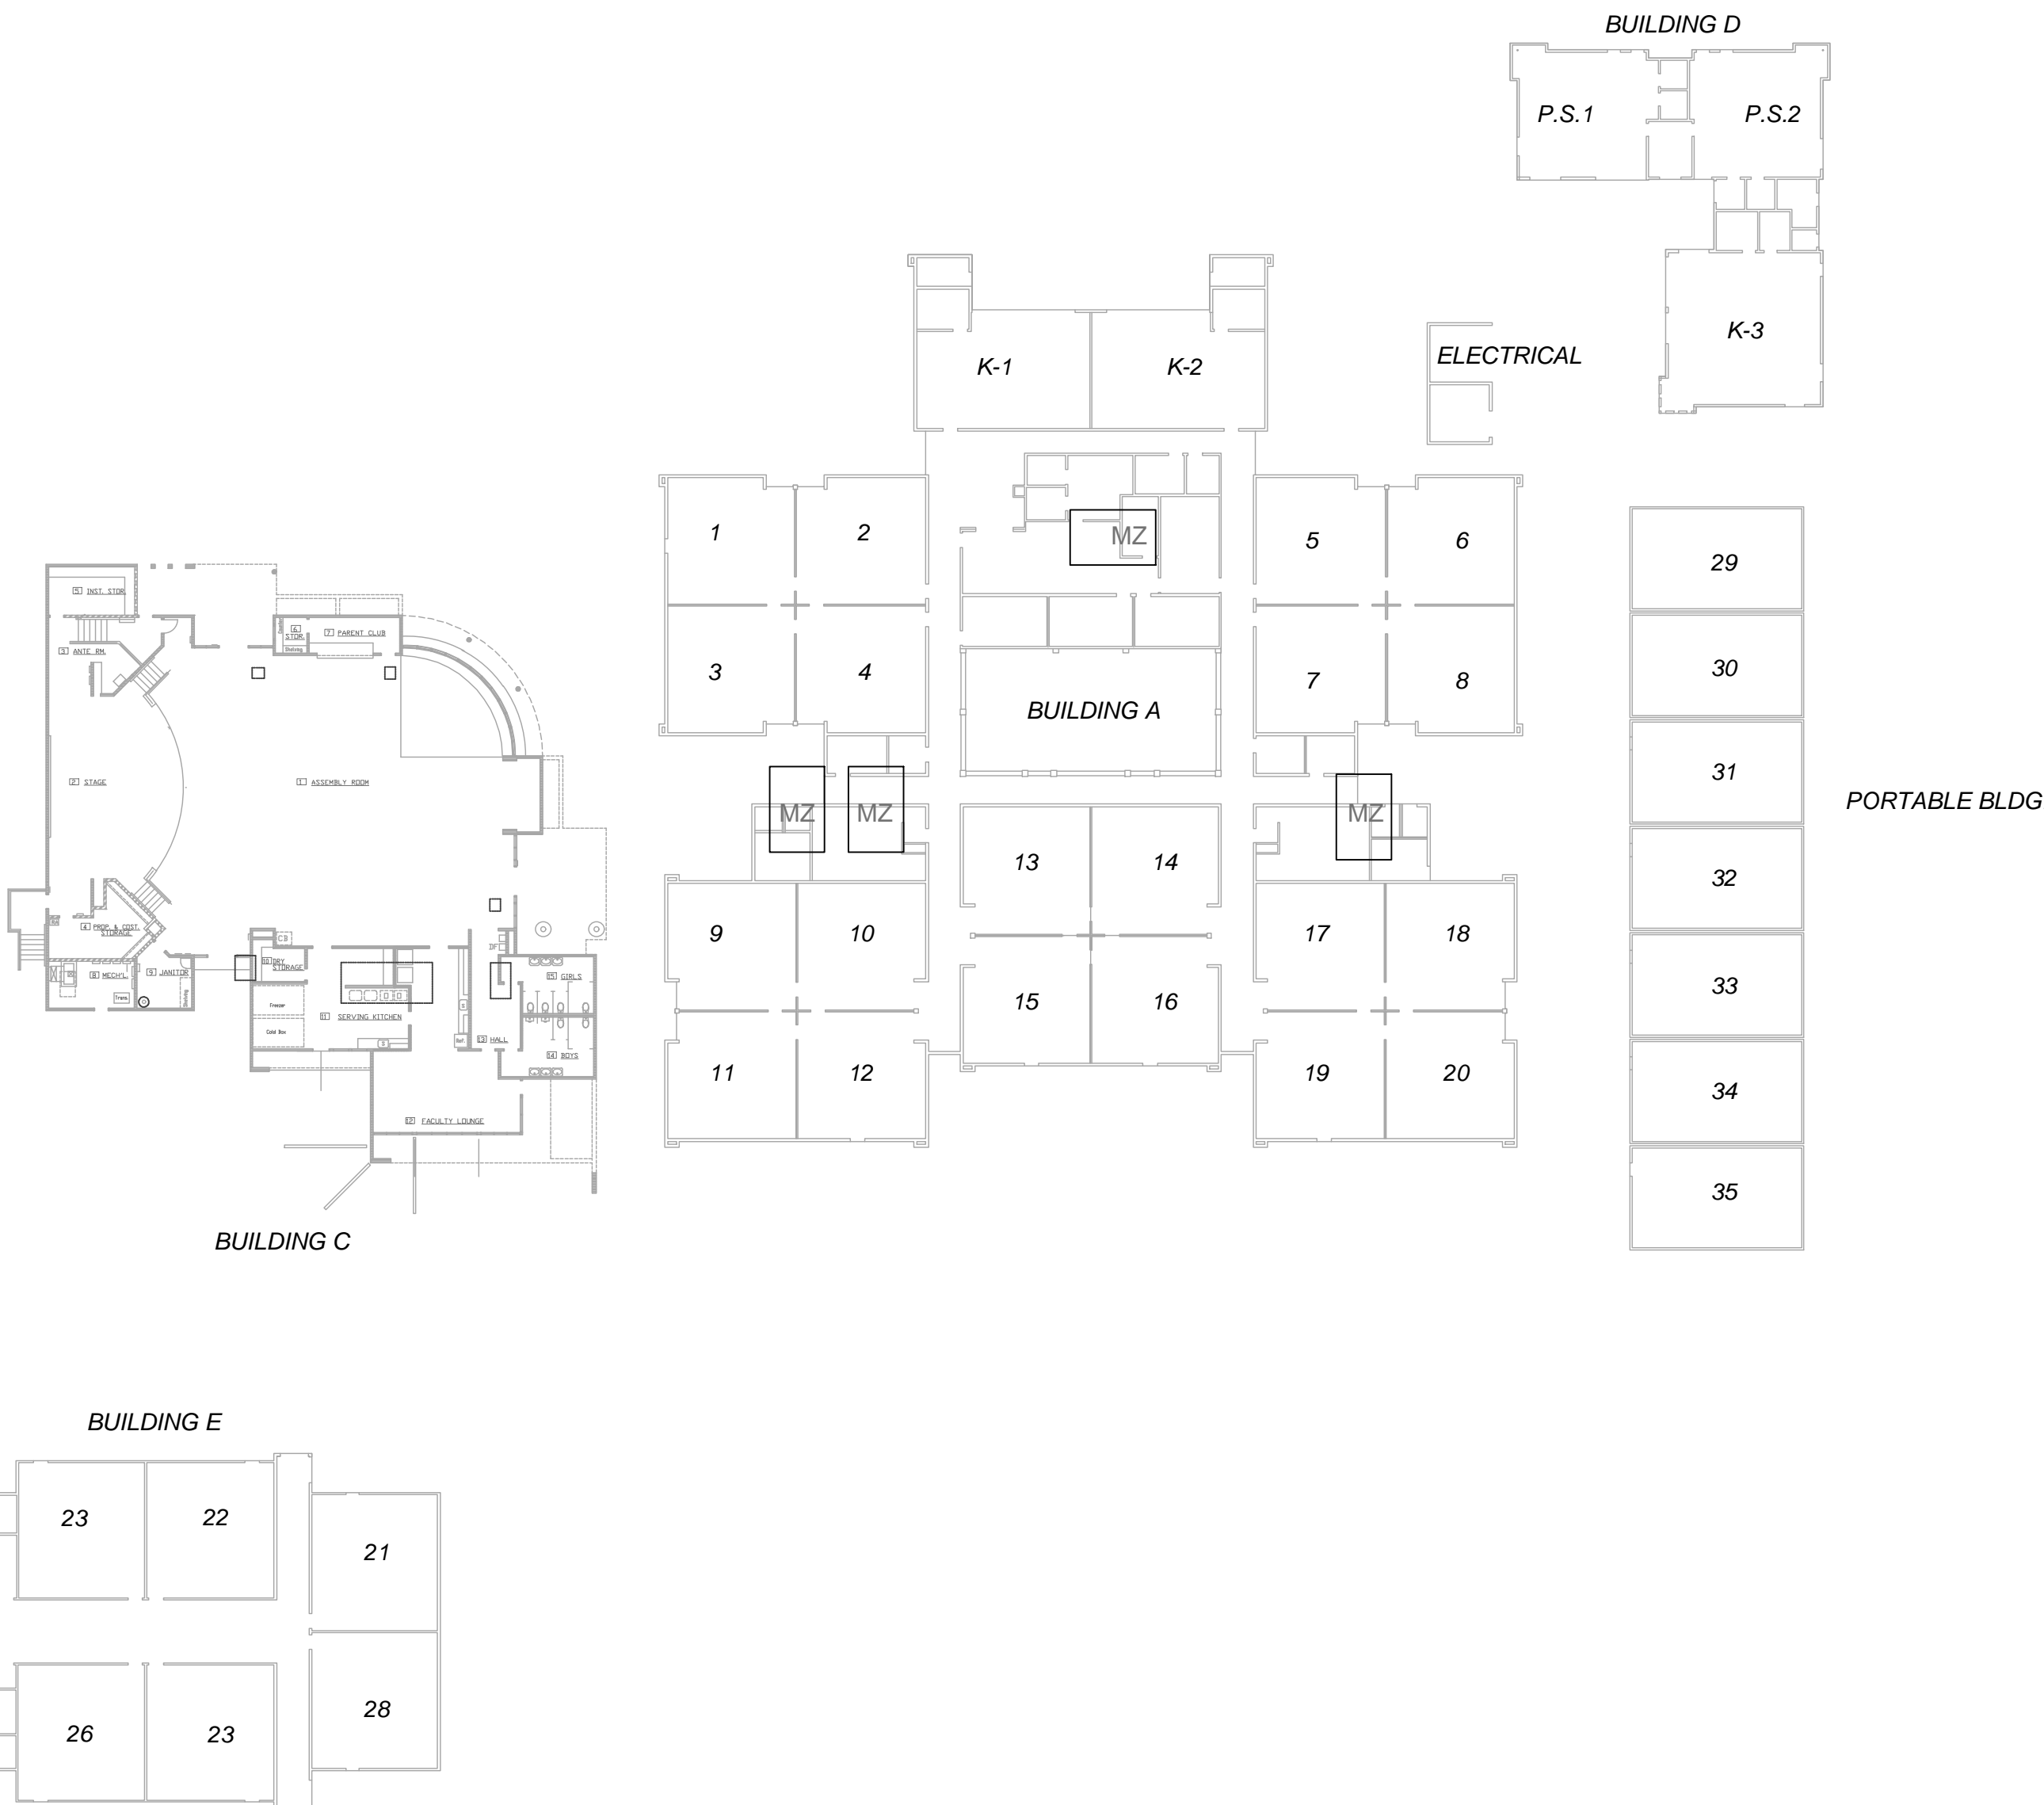

SITE PLAN

SCALE: 1" = 30'-0"

SHEET INDEX

MECHANICAL	SHEET COUNT
G1 COVER SHEET	1
M1 BUILDING A - EMS PLAN	2
M2 BUILDING C - EMS PLAN	3
M3 BUILDING D, E, & PORTABLES - EMS PLAN	4
M4 ENERGY MANAGEMENT DETAILS	5
M5 ENERGY MANAGEMENT DETAILS	6
M6 ENERGY MANAGEMENT DETAILS	7
M7 ENERGY MANAGEMENT DETAILS	8
M8 ENERGY MANAGEMENT DETAILS	9
M9 ENERGY MANAGEMENT DETAILS	10
M10 ENERGY MANAGEMENT DETAILS	11

ELECTRICAL

E1 ELECTRICAL SYMBOLS AND NOTES	12
E2 ELECTRICAL PLAN	13

SHEET COUNT TOTAL:


13

SCOPE OF WORK

THE SCOPE OF WORK IS AS INDICATED BY THE CONTRACT DRAWINGS AND SPECIFICATION AND IS SUMMARIZED AS FOLLOWS:

- REPLACE EXISTING DDC CONTROLS w/(N) JOHNSON CONTROLS EX-80
- REPLACE AND UP SIZE EXISTING MULTI-ZONE UNIT SUPPLY AND RETURN / EXHAUST FAN WITH NEW MOTOR & VFD. SEE PLANS FOR SIZE & ELECTRICAL DRAWINGS.
- PROVIDE AN EXISTING CONDITION DUCT TRAVERSE FOR EACH SUPPLY ZONE, OUTSIDE AIR, & RETURN AIR ON MULTI-ZONE UNIT MZU-1, MZU-2, MZU-3 AND MZU-4 PRIOR TO START OF WORK AND ALSO UPON PROJECT COMPLETION.

APPROVALS:
APPLICATION #
77777777

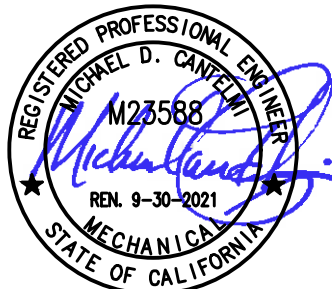

DATE: 11-25-2020

EMS REPLACEMENT
ROWELL ELEMENTARY SCHOOL
3460 EAST McKENZIE AVE. FRESNO, CA 93702
FRESNO UNIFIED SCHOOL DISTRICT
4600 N. BRAWLEY AVE. FRESNO, CA.

REVISIONS
4/22/21 EMS REVISIONS
1
2
3
4
5

LAWRENCE
ENGINEERING GROUP
FRESNO, CA 93720
FAX (559) 431-1362
7084 N. Maple Ave., Suite 101
(559) 431-0101

TITLE: COVER

SHEET: G1
PROJECT 20139



DATE: 11-25-2020

EMS REPLACEMENT
ROWELL ELEMENTARY SCHOOL
3460 EAST MCKENZIE AVE. FRESNO, CA 93702
FRESNO UNIFIED SCHOOL DISTRICT
4600 N. BRAWLEY AVE. FRESNO, CA.

REVISIONS
42221 EMS REVISIONS



LAWRENCE
ENGINEERING GROUP
Fresno, CA 93720
7084 N. Maple Ave., Suite 101
(559) 431-0101
FAX (559) 431-1362

TITLE:
BUILDING A
EMS PLAN

SHEET:
M1
PROJECT 20139

KEYNOTES: (THIS SHEET ONLY)


- 1 LOCATION OF (N) EMS ROUTER, FIELD VERIFY LOCATION.
- 2 (E) HIGH WALL MOUNTED SPLIT HEAT PUMP WITH ODU ON ROOF.
- 3 (E) MULTI-ZONE AIR HANDLER ON ROOF.
- 4 MZ 1 ZONE
- 5 MZ 2 ZONE
- 6 EXHAUST FAN ON ROOF.
- 7 MZ 4 ZONE
- 8 MZ 3 ZONE
- 9 REMOVE AND REPLACE (E) FAN MOTOR & ACCESSORIES w/(N) ALLEN BRADLEY VFD & COMPATIBLE MOTOR. PRE & POST AIR FLOW MEASUREMENTS TO MATCH. PROVIDE REPORTS TO MEOR.

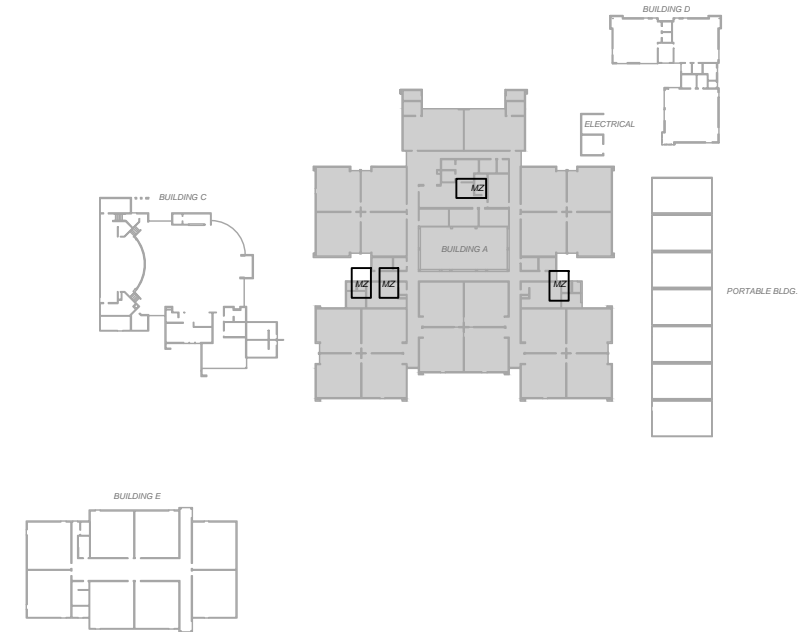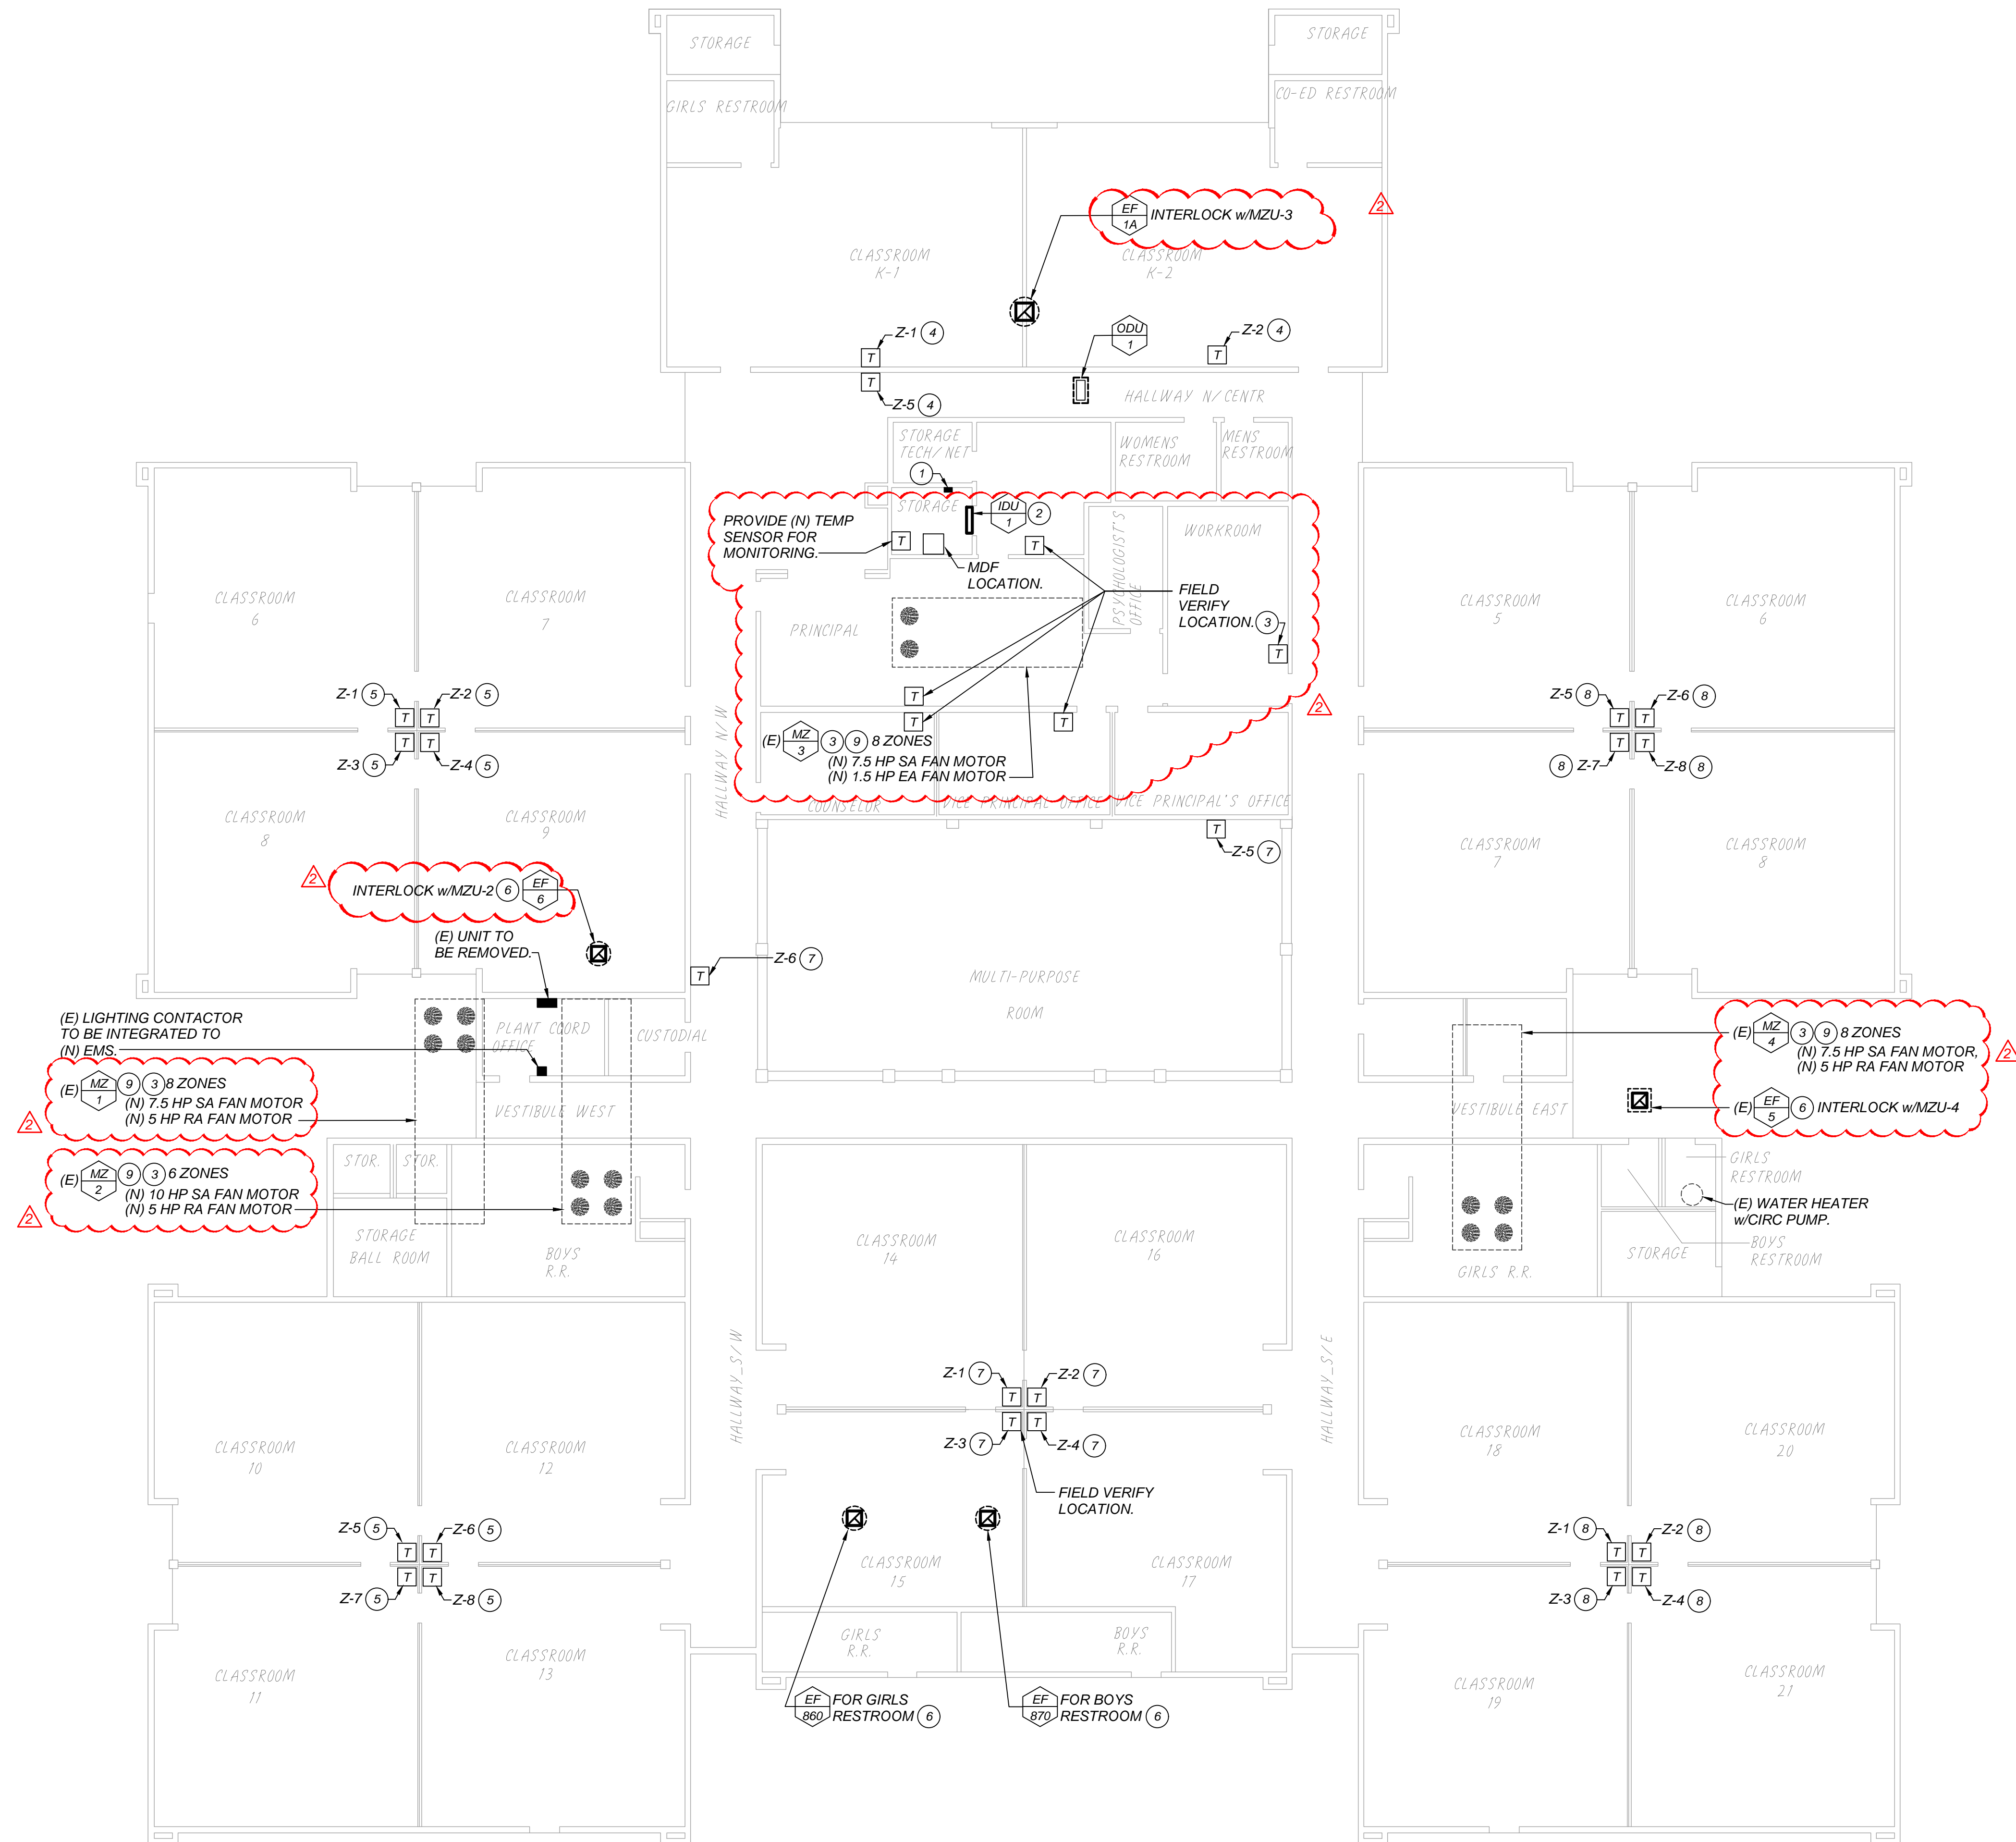

BUILDING A - EMS PLAN
SCALE: 3/32" = 1'-0"



KEYPLAN
SCALE: NONE

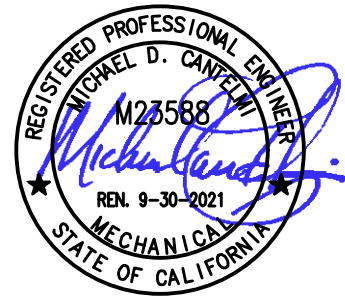

DATE: 11-25-2020

EMS REPLACEMENT
ROWELL ELEMENTARY SCHOOL
3460 EAST MCKENZIE AVE. FRESNO, CA 93702
FRESNO UNIFIED SCHOOL DISTRICT
4600 N. BRAWLEY AVE. FRESNO, CA.

REVISIONS
42221 EMS REVISIONS
Δ
Δ

LAWRENCE
ENGINEERING GROUP
Fresno, CA 93720
(559) 431-0101
7084 N. Maple Ave., Suite 101
FAX (559) 431-1362

TITLE:
LIBRARY
MEDIA
CLASSROOMS

SHEET:
M2
PROJECT 20139

KEYNOTES: (THIS SHEET ONLY)

- (E) PACKAGE AIR UNIT ON ROOF.
- (E) EXHAUST FAN ON ROOF.
- (E) AIR COOLED CONDENSER ON ROOF.
- (E) CIRCULATION PUMP TO BE INTEGRATED TO EMS THROUGH NEAREST CONTROLLER.
- (E) DX COOLING COIL w/ (E) ON ROOF, & (E) FURNACE.
- (E) ELECTRIC DUCT HEATER TO BE ENABLED ONLY WHEN UNIT IS FUNCTIONING AND CONTROLLED BY (N) THERMOSTAT w/± 3° ADJUSTMENT.
- REFER TO DETAIL D/M9.

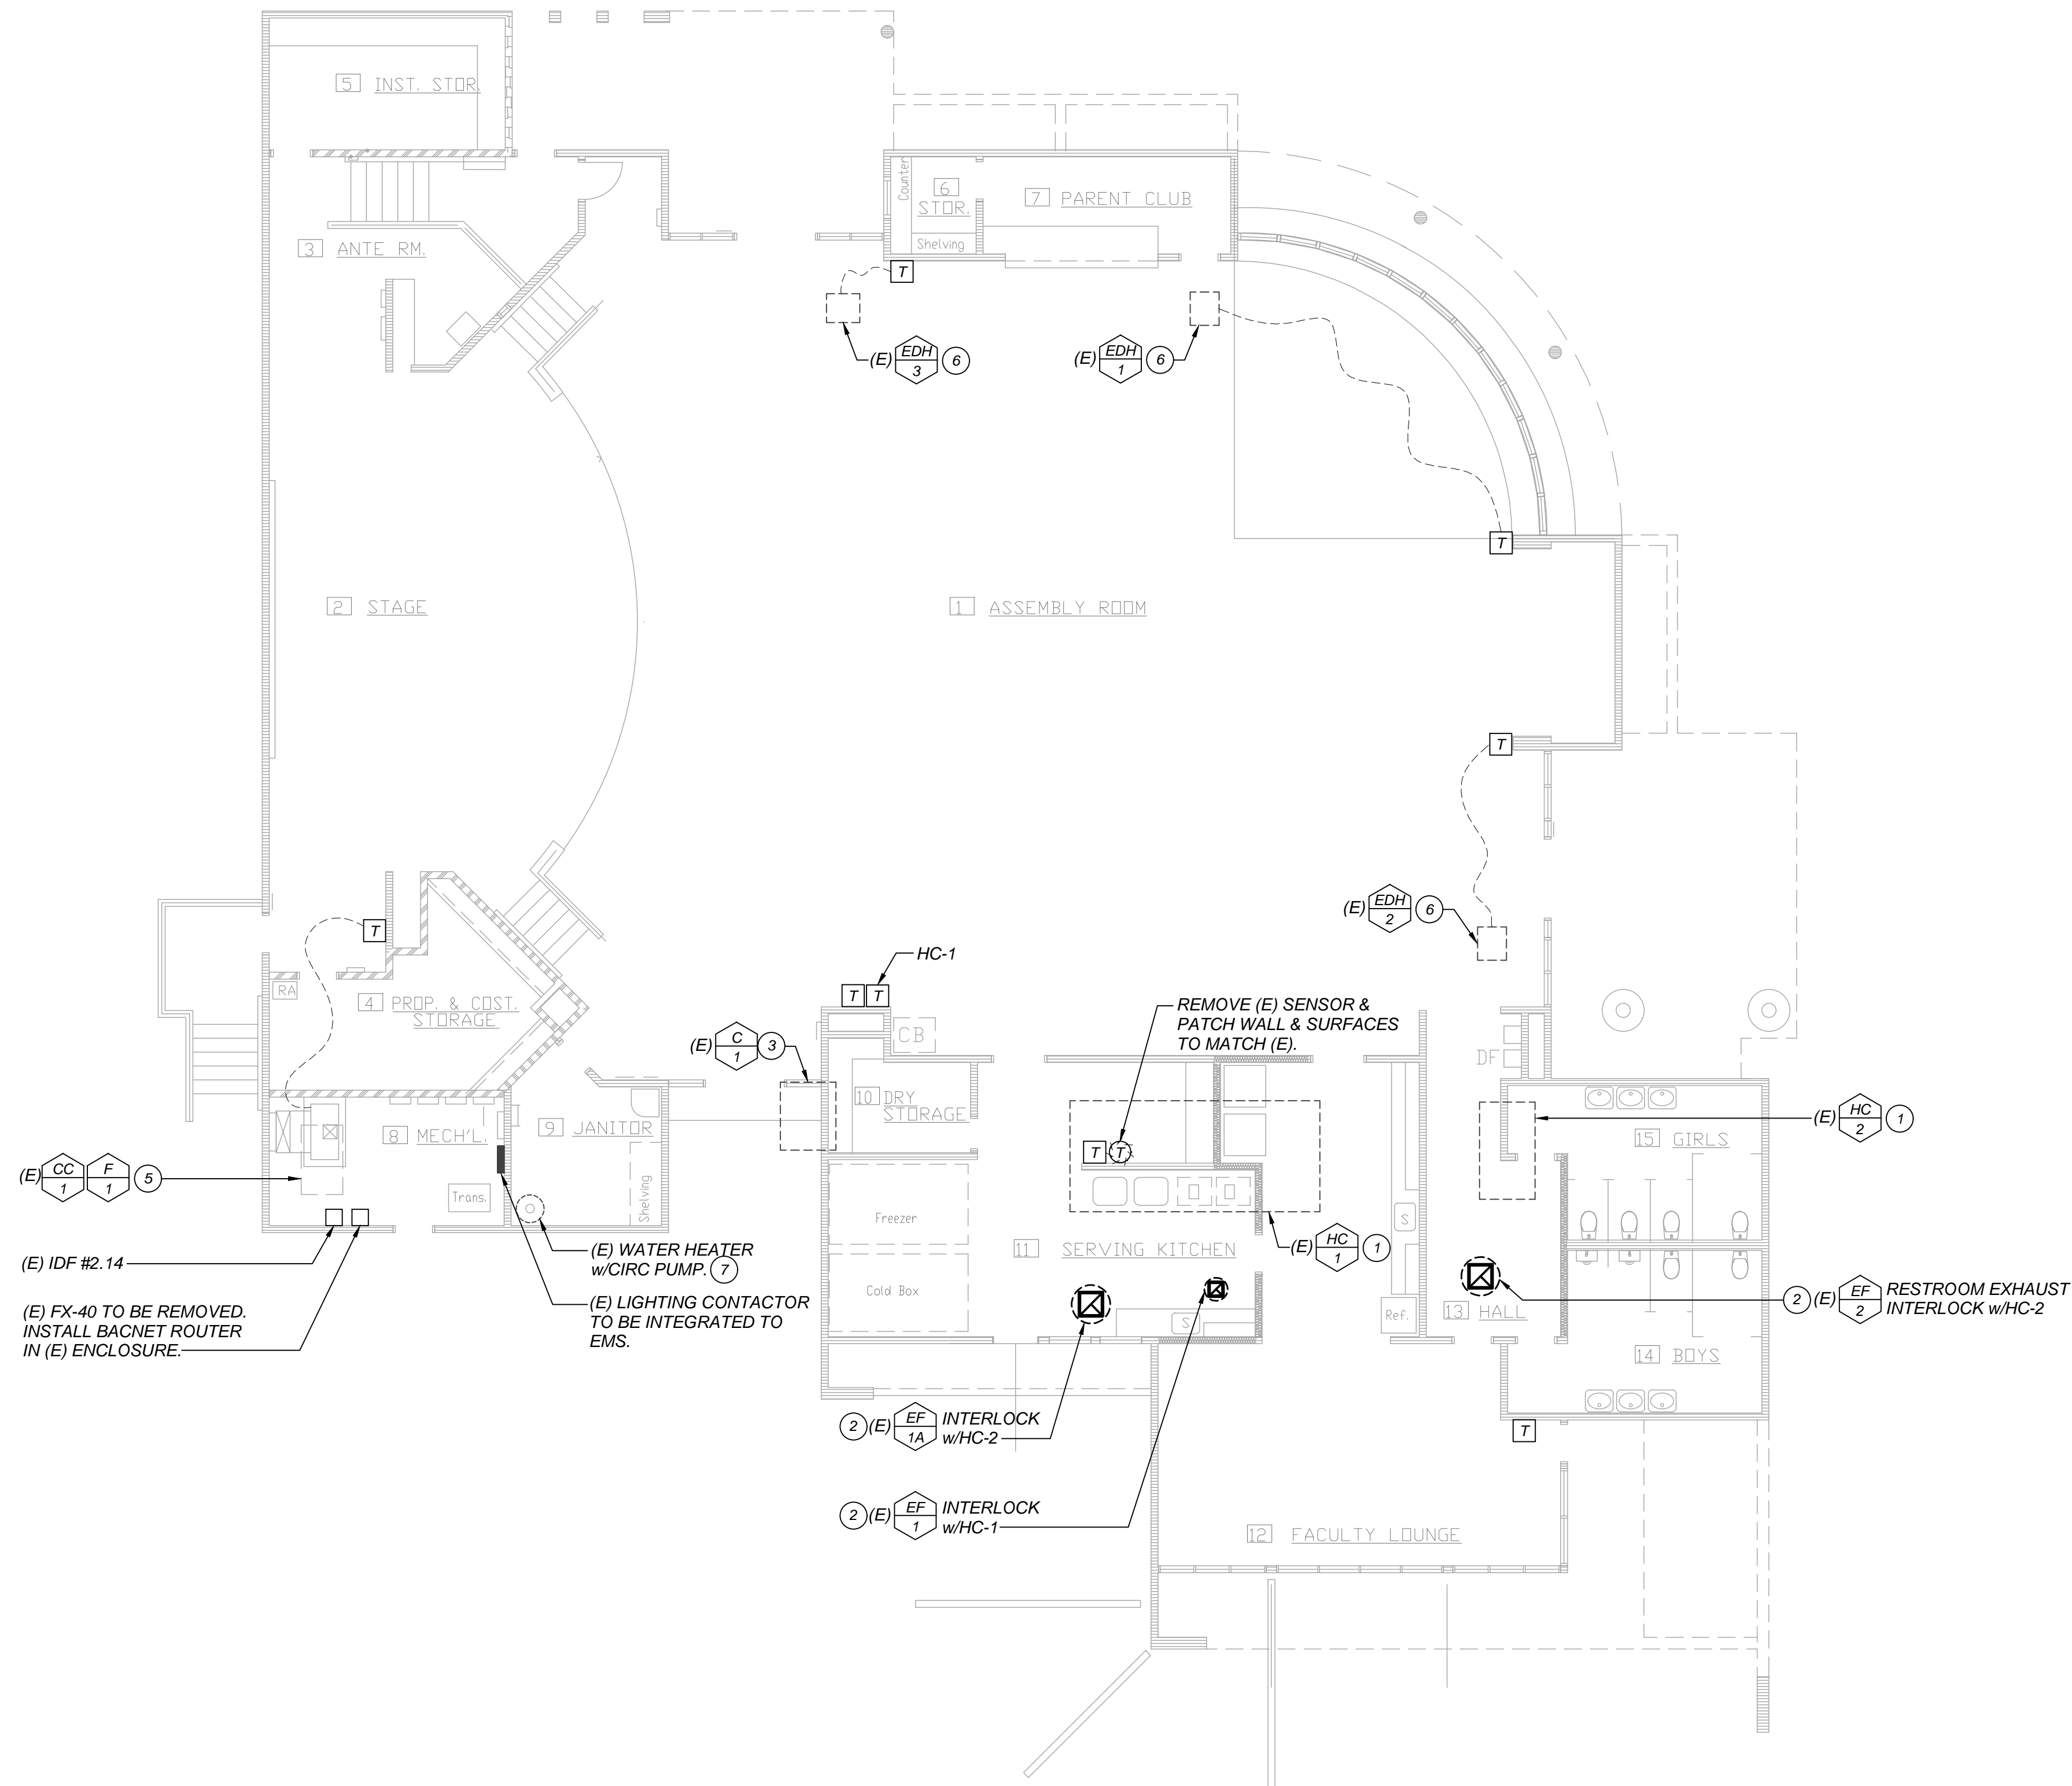

(E) IDF #2.14
(E) FX-40 TO BE REMOVED.
INSTALL BACNET ROUTER
IN (E) ENCLOSURE.

(E) WATER HEATER
w/CIRC PUMP. (E)
(E) LIGHTING CONTACTOR
TO BE INTEGRATED TO
EMS.

(E) INTERLOCK
w/HC-2
(E) INTERLOCK
w/HC-1

REMOVE (E) SENSOR &
PATCH WALL & SURFACES
TO MATCH (E).


(E) RESTROOM EXHAUST
INTERLOCK w/HC-2




BUILDING. C - MULTI-PURPOSE ROOM
SCALE: 1/8" = 1'-0"



KEYPLAN
SCALE: NONE

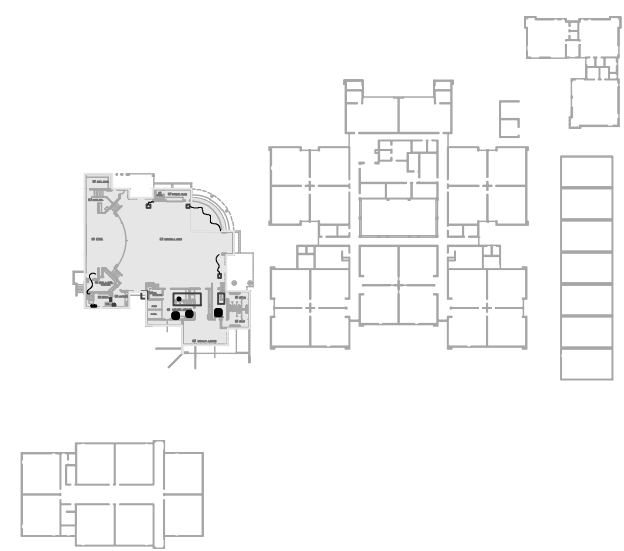

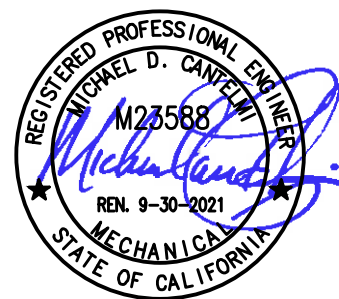

EMS REPLACEMENT
ROWELL ELEMENTARY SCHOOL
3460 EAST MCKENZIE AVE. FRESNO, CA 93702
FRESNO UNIFIED SCHOOL DISTRICT
4600 N. BRAWLEY AVE. FRESNO, CA.


REVISIONS
4/22/21 EMS REVISIONS

LAWRENCE
ENGINEERING GROUP
Fresno, CA 93720
(559) 431-1362
7084 N. Maple Ave., Suite 101
(559) 431-0101

TITLE:
BUILDINGS
"D" AND "E"
EMS PLAN

SHEET:
M3
PROJECT 20139



BUILDING D

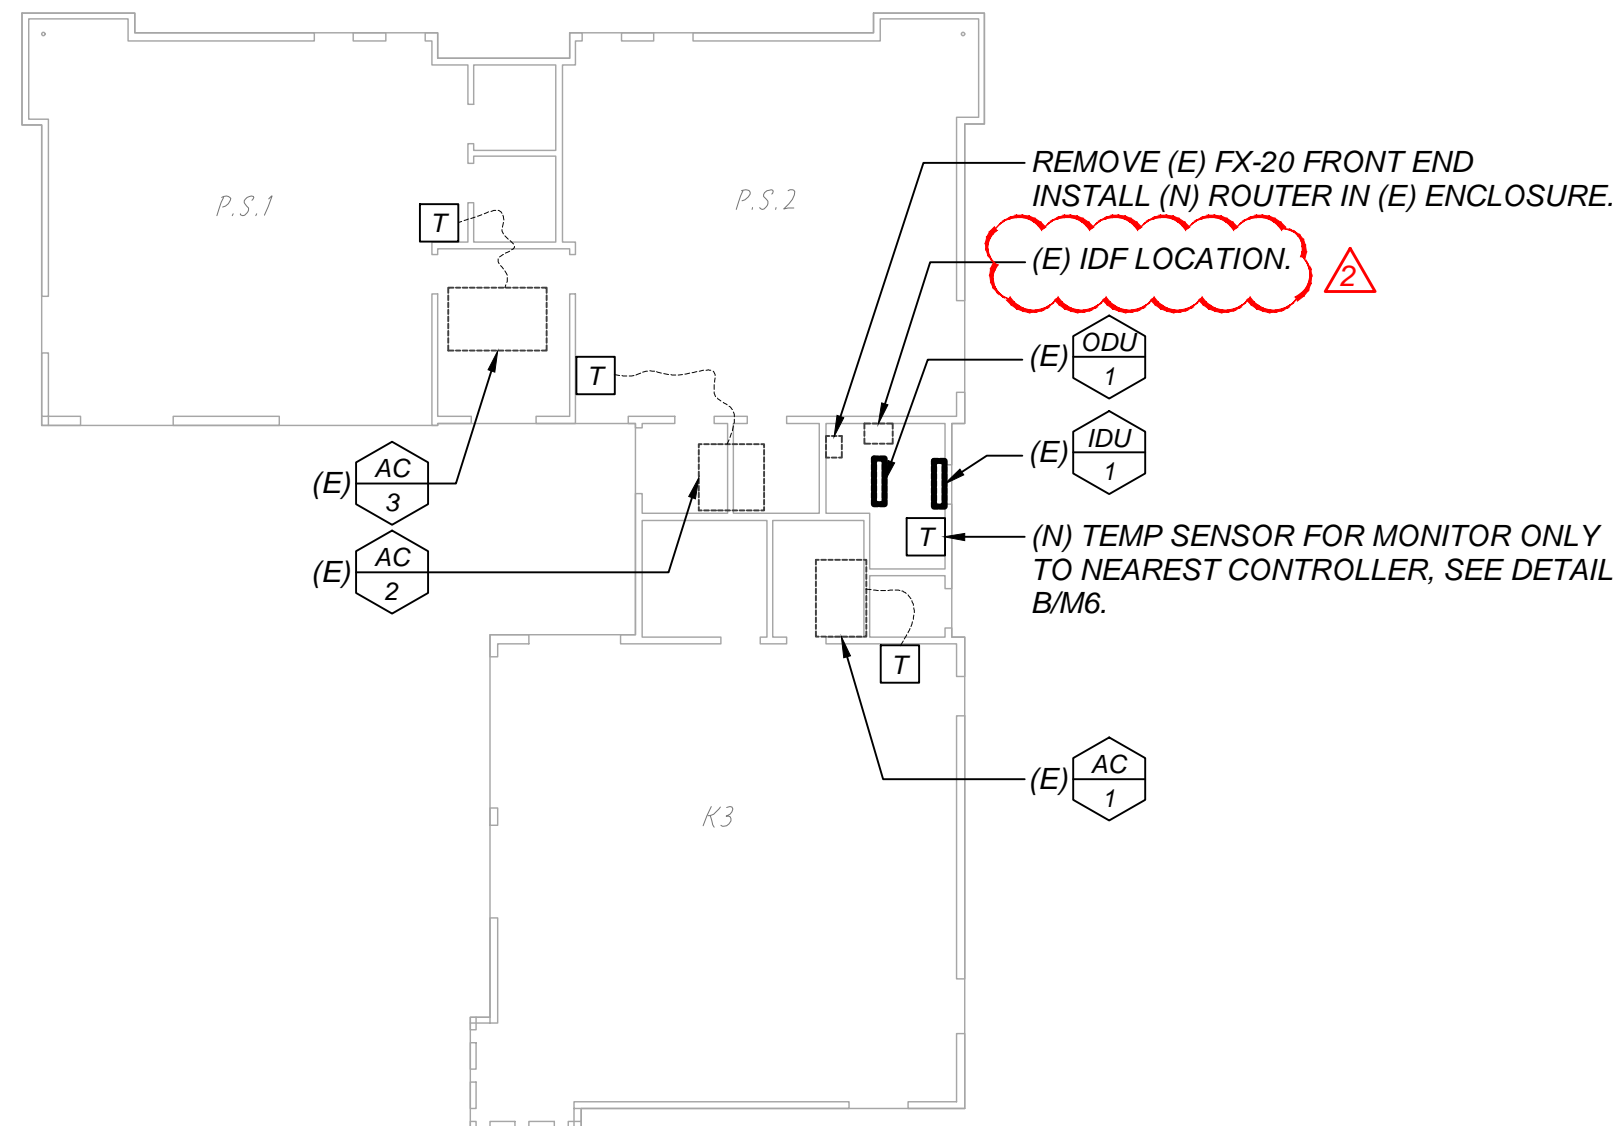

KEYNOTES: (THIS SHEET ONLY)

1 CONNECT TO IDF IN CLASSROOM #29.


PORTABLE BLDG.

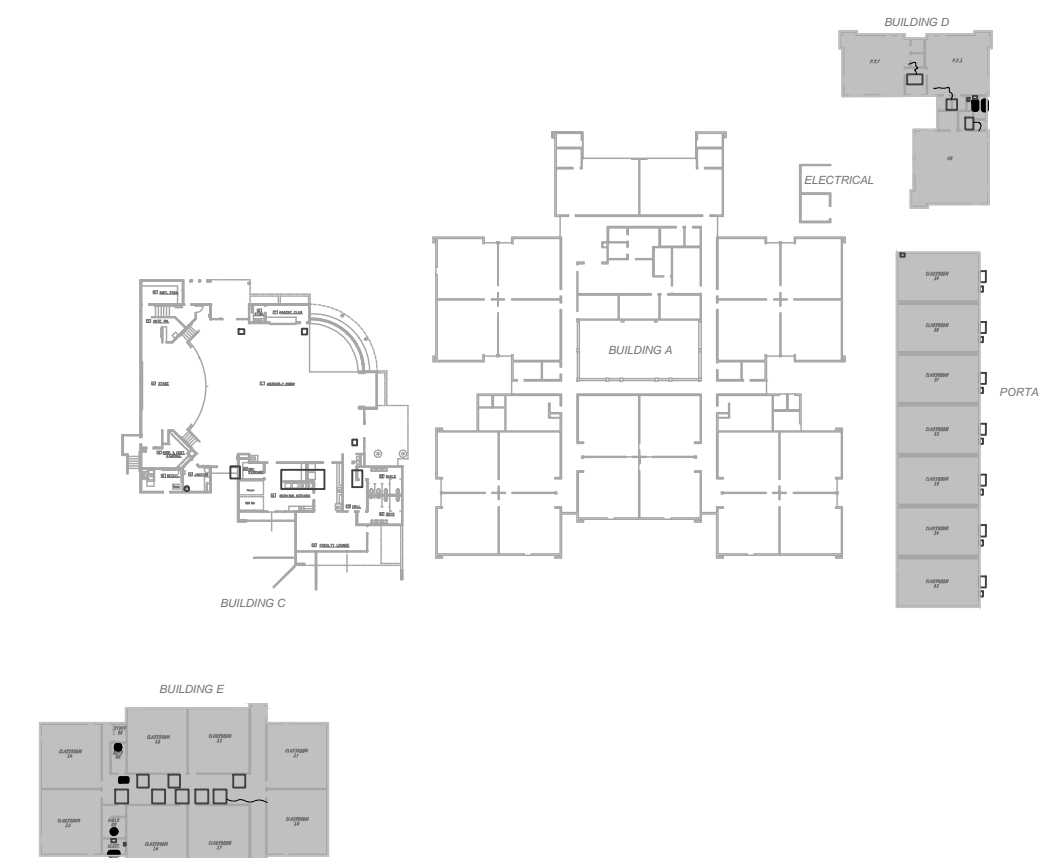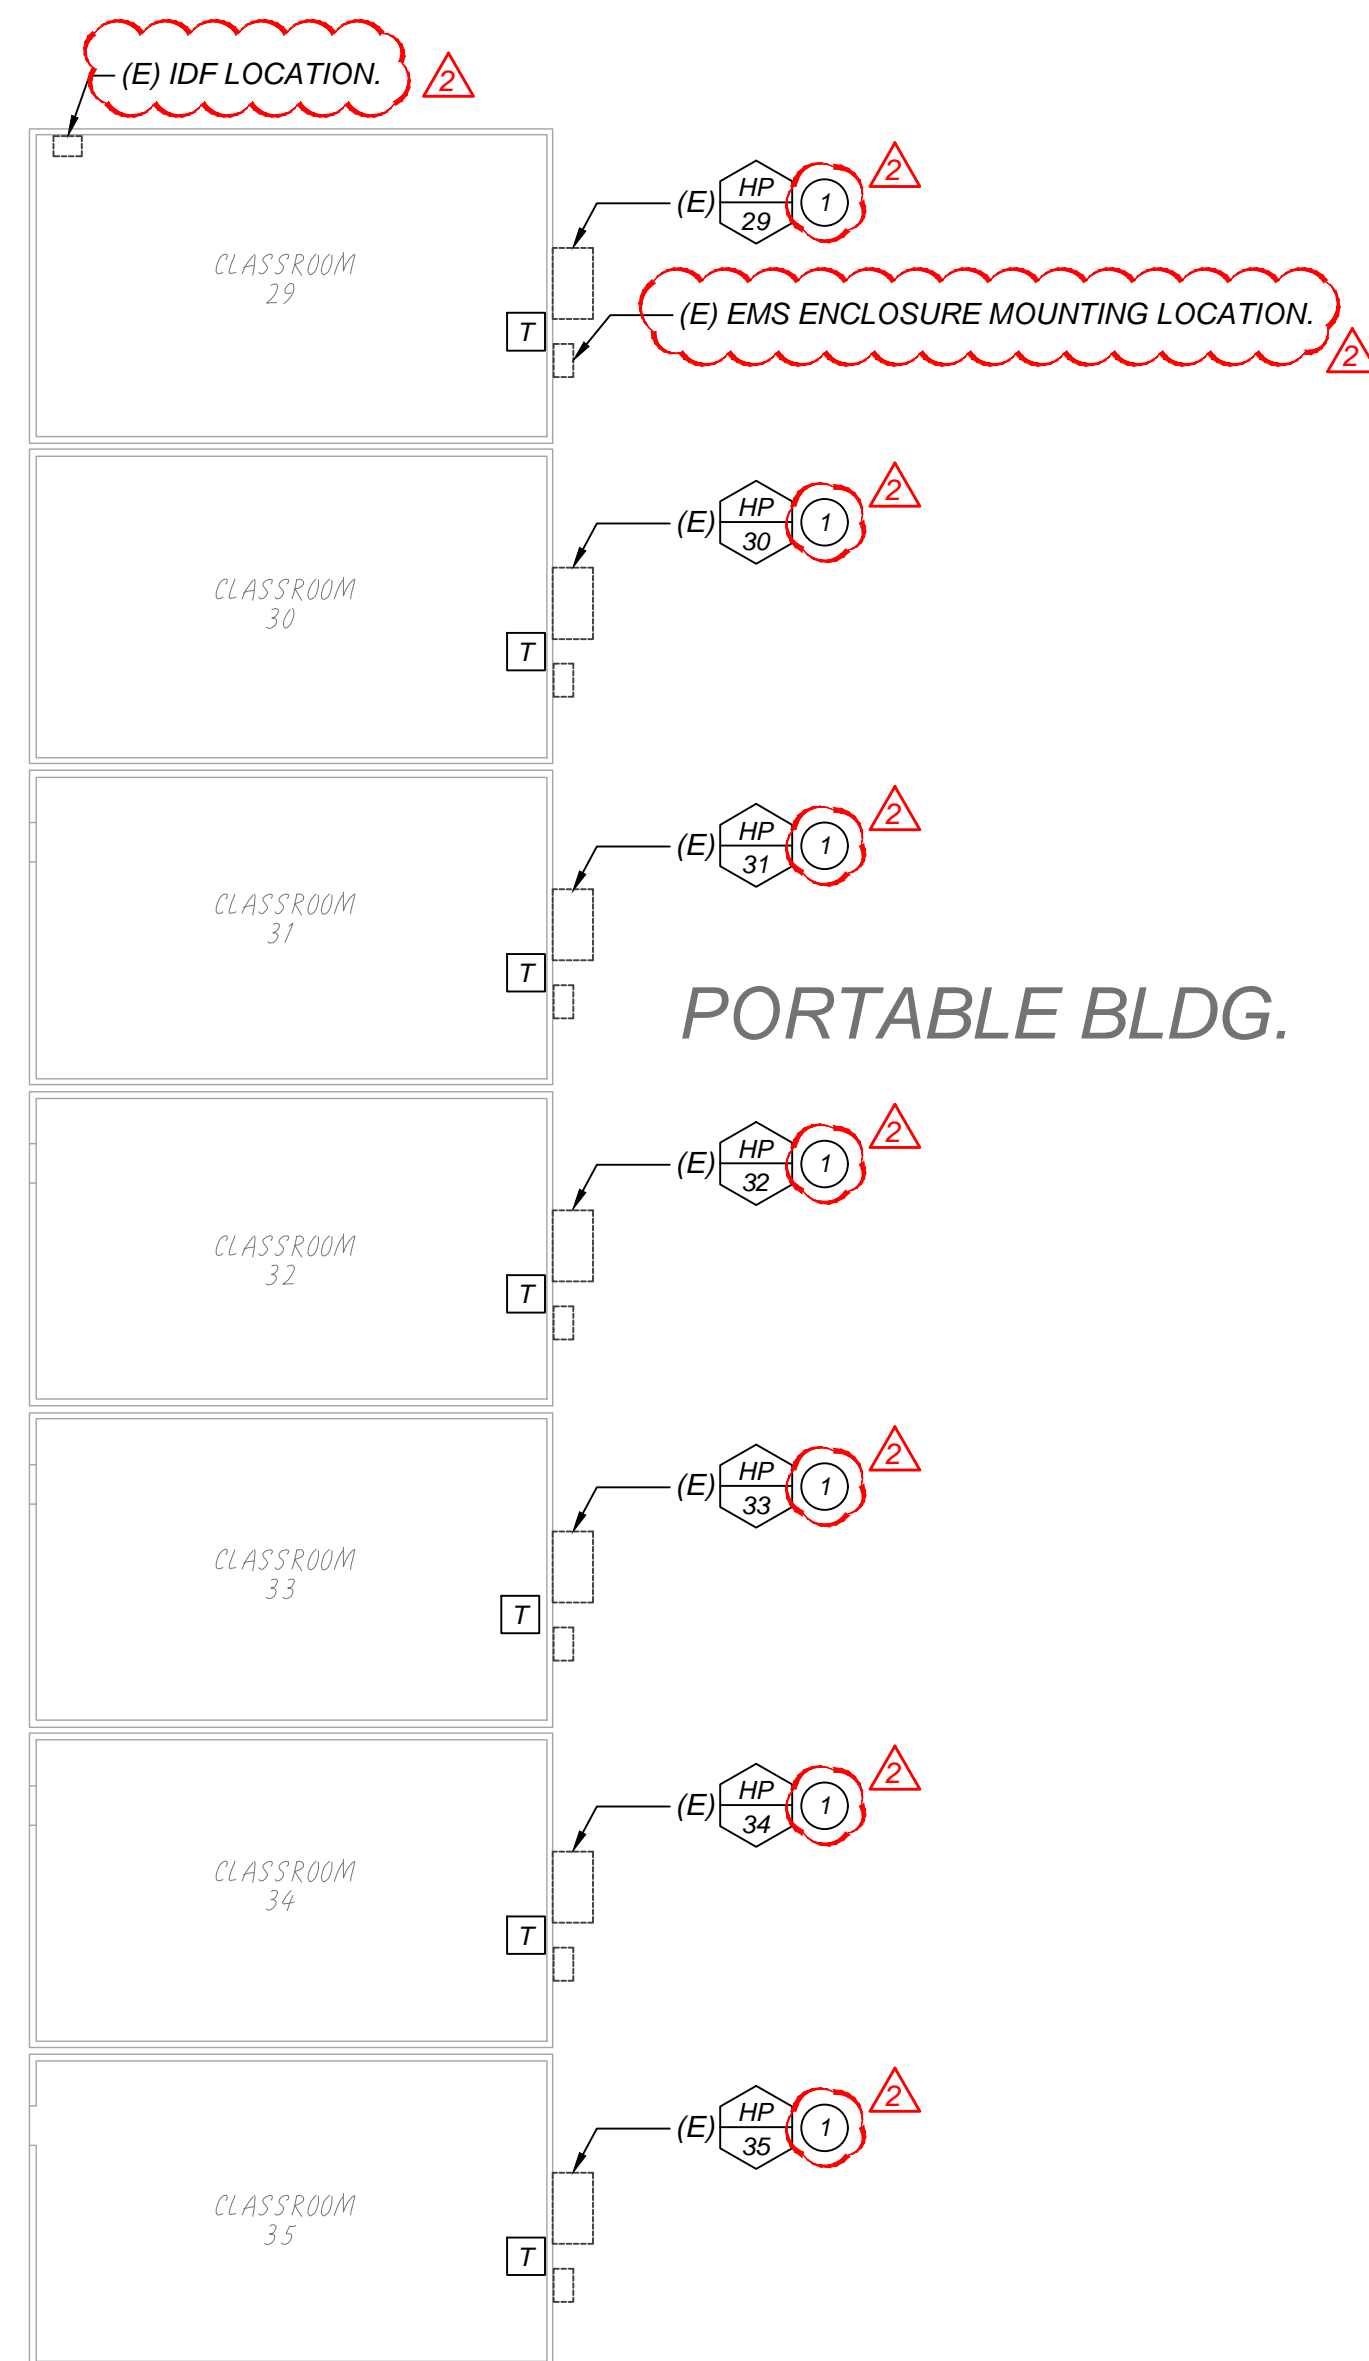

KEYPLAN
SCALE: 1"=200'-0"


BUILDING E - EMS PLAN


SCALE: 1"=10'-0"

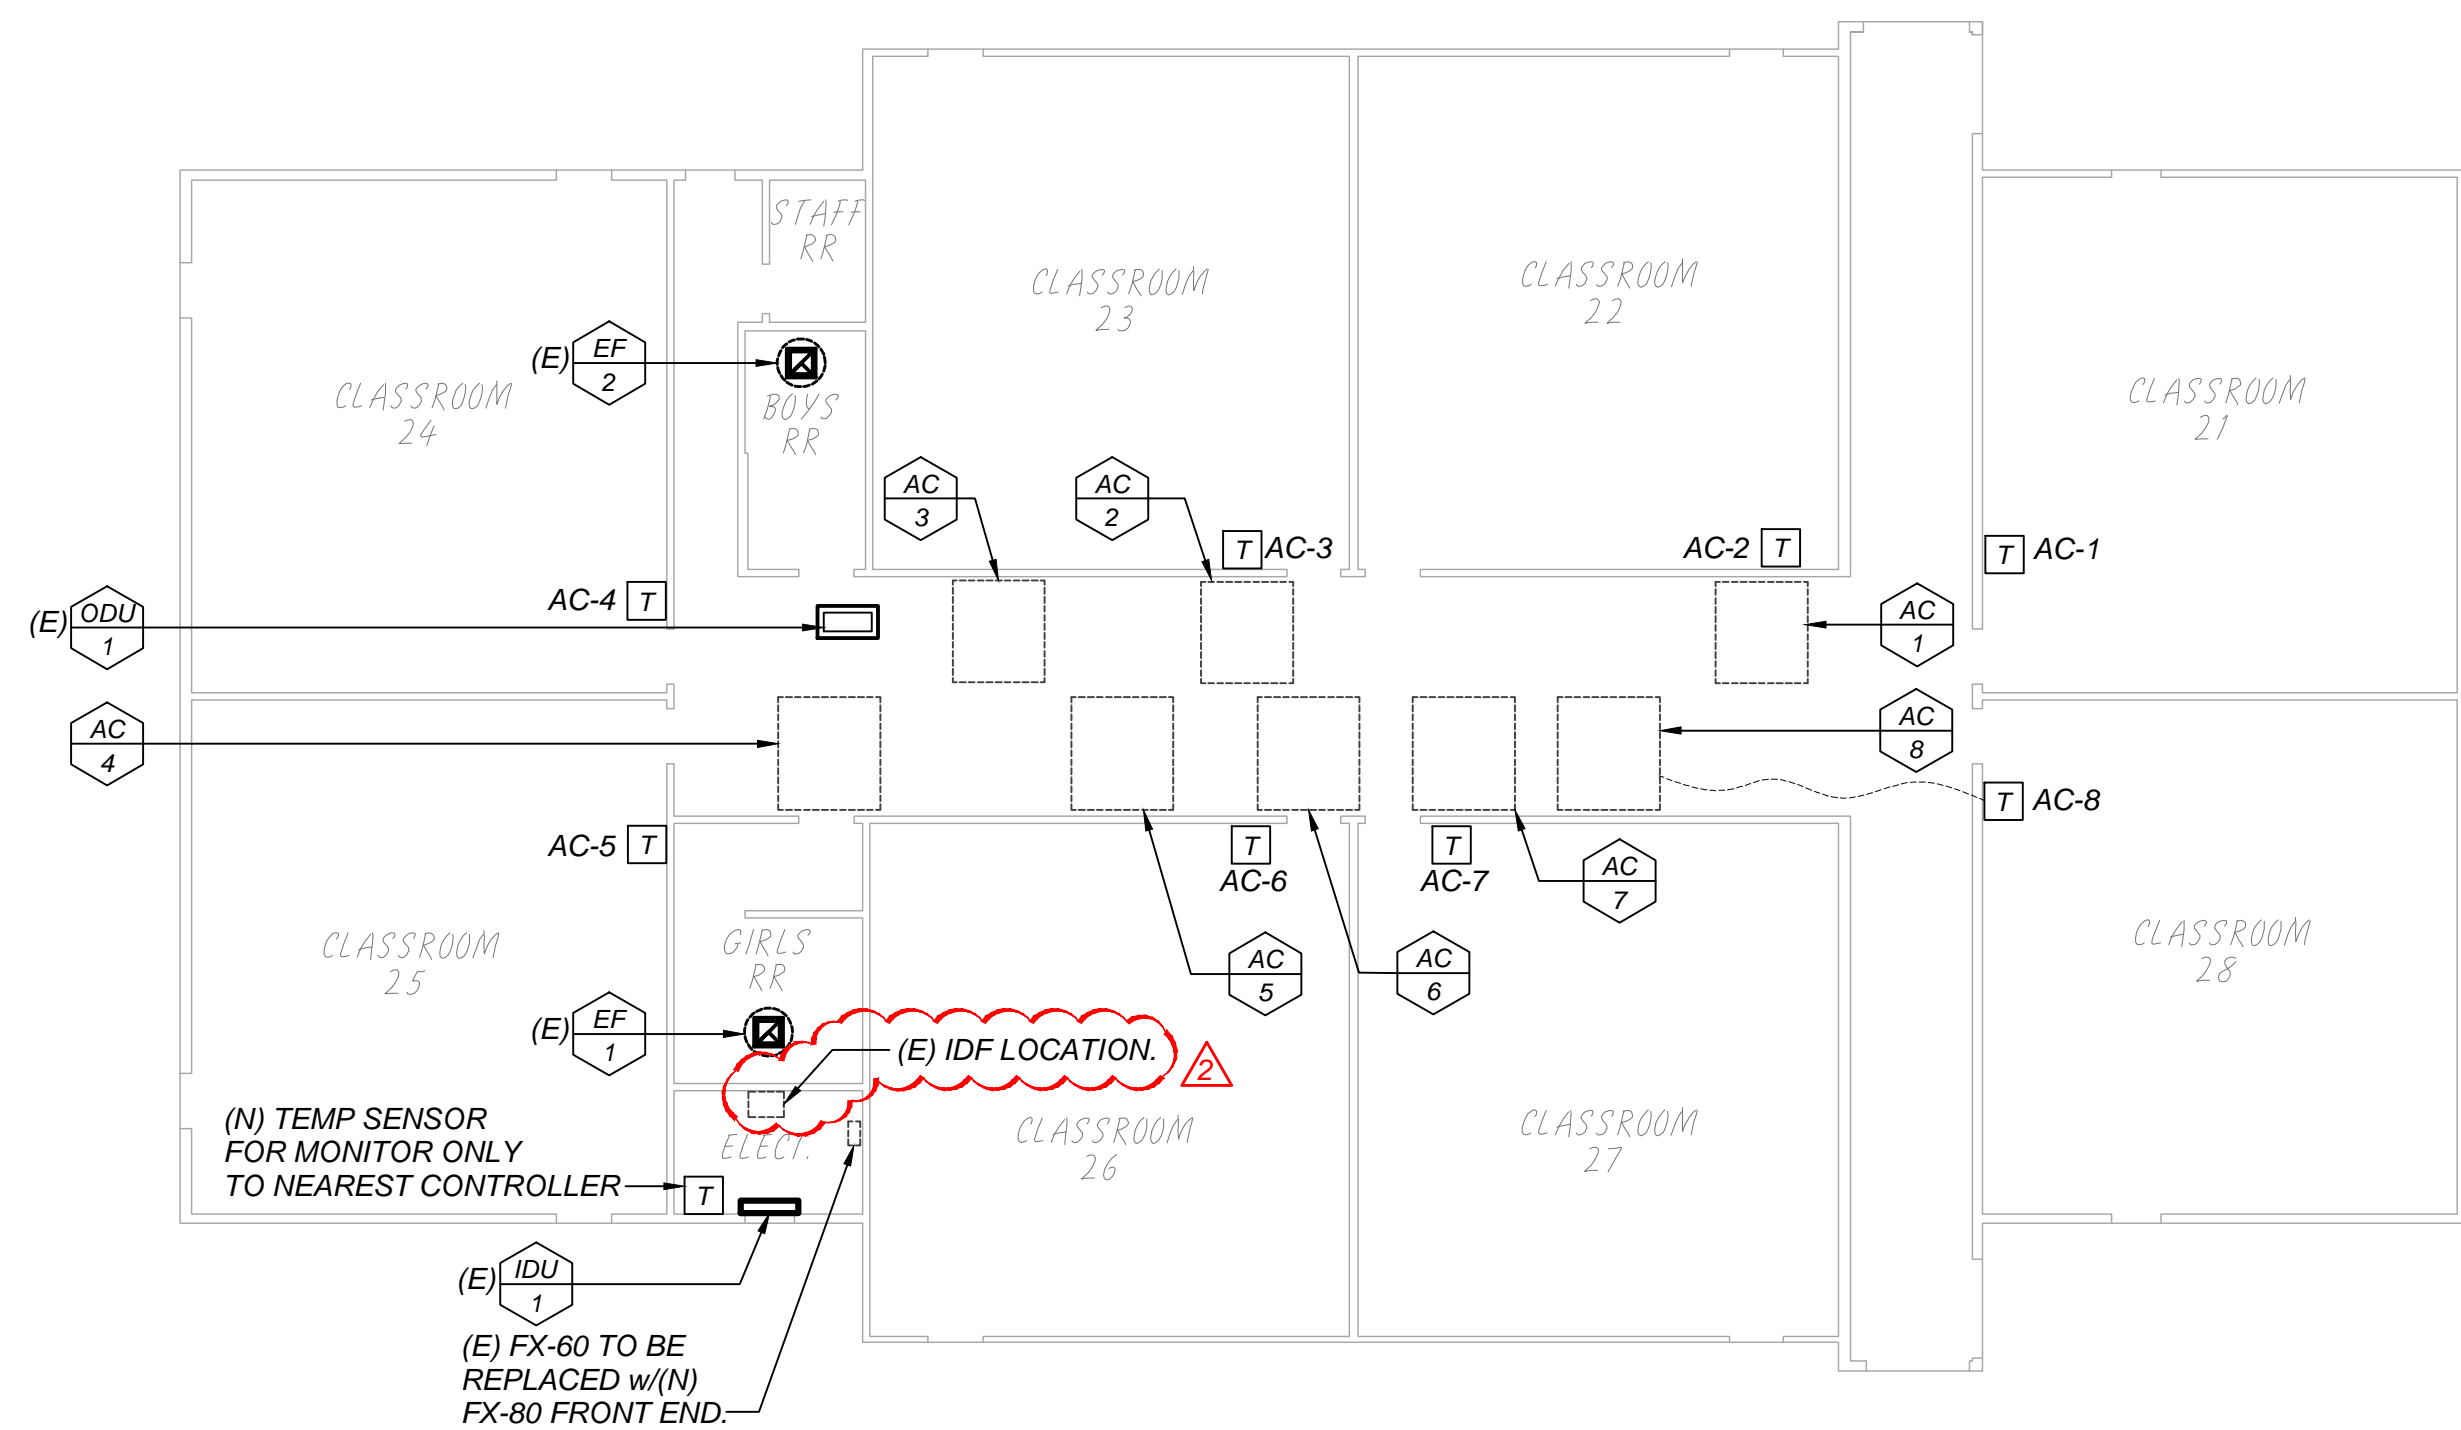

BUILDING D AND PORTABLES - EMS PLAN

SCALE: 1"=40'-0"

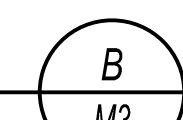

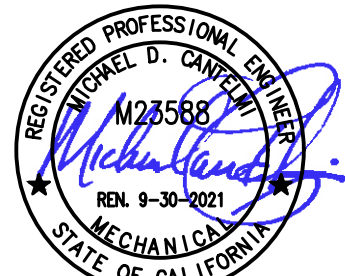

DATE: 11-25-2020

EMS REPLACEMENT
ROWELL ELEMENTARY SCHOOL
3460 EAST MCKENZIE AVE. FRESNO, CA 93702
FRESNO UNIFIED SCHOOL DISTRICT
4600 N. BRAWLEY AVE. FRESNO, CA.

REVISIONS
4/22/21 EMS REVISIONS

LAWRENCE
ENGINEERING GROUP
Fresno, CA 93720
(559) 431-0101
7084 N. Maple Ave., Suite 101
FAX (559) 431-1362

TITLE:

SHEET:
M4
PROJECT 20139

- Sheet Notes
1. DEFAULT IP ADDRESS TO BE CHANGED DURING COMMISSIONING.
 2. IP ADDRESSES TO BE PROVIDED BY FUSD.
 3. REFER TO DETAIL BM10.
 4. BOTH ENDS OF ALL CAT-6 CABLES MUST BE LABELED WITH THE ROOM NUMBER, EQUIPMENT TYPE, AND PATCH PANEL NUMBER I.E. ROOM # __ EQUIP. TYPE - PORT #

JACE Notes

HOST ID:
SERIAL NUMBER:
PRIMARY IP: 192.168.1.149
SECONDARY IP: 192.168.10.10

PROVIDE PANDUIT CJ688TGYL CONNECTOR IS REQUIRED BETWEEN ALL IP DEVICES & THE NETWORK SWITCH, TYP.

NOTE: RING TOPOLOGY IS ACCEPTABLE FOR PORTABLE BUILDING.

ROWELL ELEMENTARY SCHOOL CONTROL REFERENCES


Room Name	Room No.	A/C Mark No.	System Type	Description or Notes	See Detail
BUILDING A - CLASSROOM & ADMIN					
See Plans		MZ-3	MZ AH	8 zones, (N) 7.5 HP SA & 1.5 HP EXH. Fan Motor and VFD	C/M-5
See Plans		MZ-1	MZ AH	8 zones, (N) 7.5 HP SA & 5 HP RA Fan Motor and VFD	C/M-5
See Plans		MZ-4	MZ AH	8 zones, (N) 7.5 HP SA & 5 HP RA Fan Motor and VFD	C/M-5
See Plans		MZ-2	MZ AH	6 zones, (N) 10HP SA & 5 HP RA Fan Motor and VFD	C/M-5
Storage		EF-6	R/R Exhaust Fan	Interlock with MZU-4	E/M-9
Water Heater		EF-5	R/R Exhaust Fan	Interlock with MZU-4	E/M-9
		EF-860	R/R Exhaust Fan	Interlock with lights	C/M-9
		EF-870	R/R Exhaust Fan	Interlock with lights	C/M-9
Storage		IDU-1/ODU-1	Split HP	Intergrate to Nearest UI, Monitor Only	B/M-6
BUILDING C					
Assembly Room	1	HC-1	G/E	Unit has 3 Electric Duct Heaters, Economizer and Powered Exhaust	A/M-8
Stage	2	F-1/CC-1/ C-1	Split G/E	Gas Furnace w/ DX Cooling Coil, and Air Cooled Condenser	A/M-7
Mech'l	8			Intergrate Lighting Contactor to Nearest UI	F/M-9
Janitor	9		WH w/ Circ Pump	Intergrate Pump ON/OFF to nearest UI	D/M-9
Serving Kitchen	11	EF-1	Exhaust Fan	INTERLOCK w/ HC-2	E/M9
Faculty Lounge	12	HC-2	G/E	Interlock with HC-2	C/M-7
Faculty Lounge	12	EF-2	Exhaust Fan	Interlock with HC-2	E/M-9
BUILDING D					
Classroom	K3	AC-1	G/E	Rooftop Packaged Unit	C/M-7
Classroom	P.S.1	AC-2	G/E	Rooftop Packaged Unit	C/M-7
Classroom	P.S.2	AC-3	G/E	Rooftop Packaged Unit	C/M-7
Electrical Room		IDU-1/ODU-1	Split HP	Intergrate to Nearest UI, Monitor Only	B/M-6
BUILDING E					
Classroom	21	AC-1	G/E	Rooftop Packaged Unit	C/M-7
Classroom	22	AC-2	G/E	Rooftop Packaged Unit	C/M-7
Classroom	23	AC-3	G/E	Rooftop Packaged Unit	C/M-7
Classroom	24	AC-4	G/E	Rooftop Packaged Unit	C/M-7
Classroom	25	AC-5	G/E	Rooftop Packaged Unit	C/M-7
Classroom	26	AC-6	G/E	Rooftop Packaged Unit	C/M-7
Classroom	27	AC-7	G/E	Rooftop Packaged Unit	C/M-7
Classroom	28	AC-8	G/E	Rooftop Packaged Unit	C/M-7
Electrical	-	IDU-1/ODU-1	Split HP	Intergrate to Nearest UI, Monitor Only	B/M-6
Boys RR	-	EF-2	R/R Exhaust Fan	Interlock with lights	C/M-9
Girls RR	-	EF-1	R/R Exhaust Fan	Interlock with lights	C/M-9
PORTABLES					
CLASSROOM	29	HP-29	Wall Mounted HP		C/M-8
CLASSROOM	30	HP-30	Wall Mounted HP		A/M-9
CLASSROOM	31	HP-31	Wall Mounted HP		A/M-9
CLASSROOM	32	HP-32	Wall Mounted HP		C/M-8
CLASSROOM	33	HP-33	Wall Mounted HP		A/M-9
CLASSROOM	34	HP-34	Wall Mounted HP		A/M-9
CLASSROOM	35	HP-35	Wall Mounted HP		A/M-9
SITE					
Exterior Lighting					F/M-9

NOTES:


1. System Type Abbreviations: G/E - Gas Heating/Electric Cooling; HP - Heat Pump
CP - Central Plant Hot or Chilled Water
LS - Light Switch
UV - Unit Ventilator
MUA- Make-up Air
HW- Hot Water
DHW- Domestic Hot Water
MZ - Multizone
AH - Air handler
WH- Domestic Water Heater
Fur - Furnance

LAN ARCHITECTURE DETAIL

A
M-4

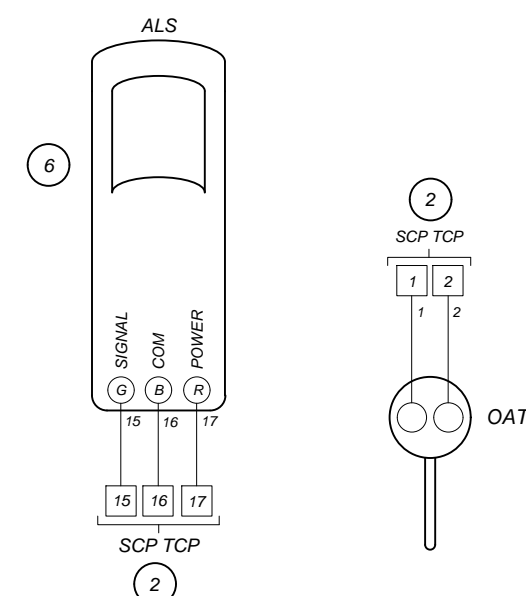


OUTDOOR PHOTOCELL AND TEMP SENSOR DETAIL

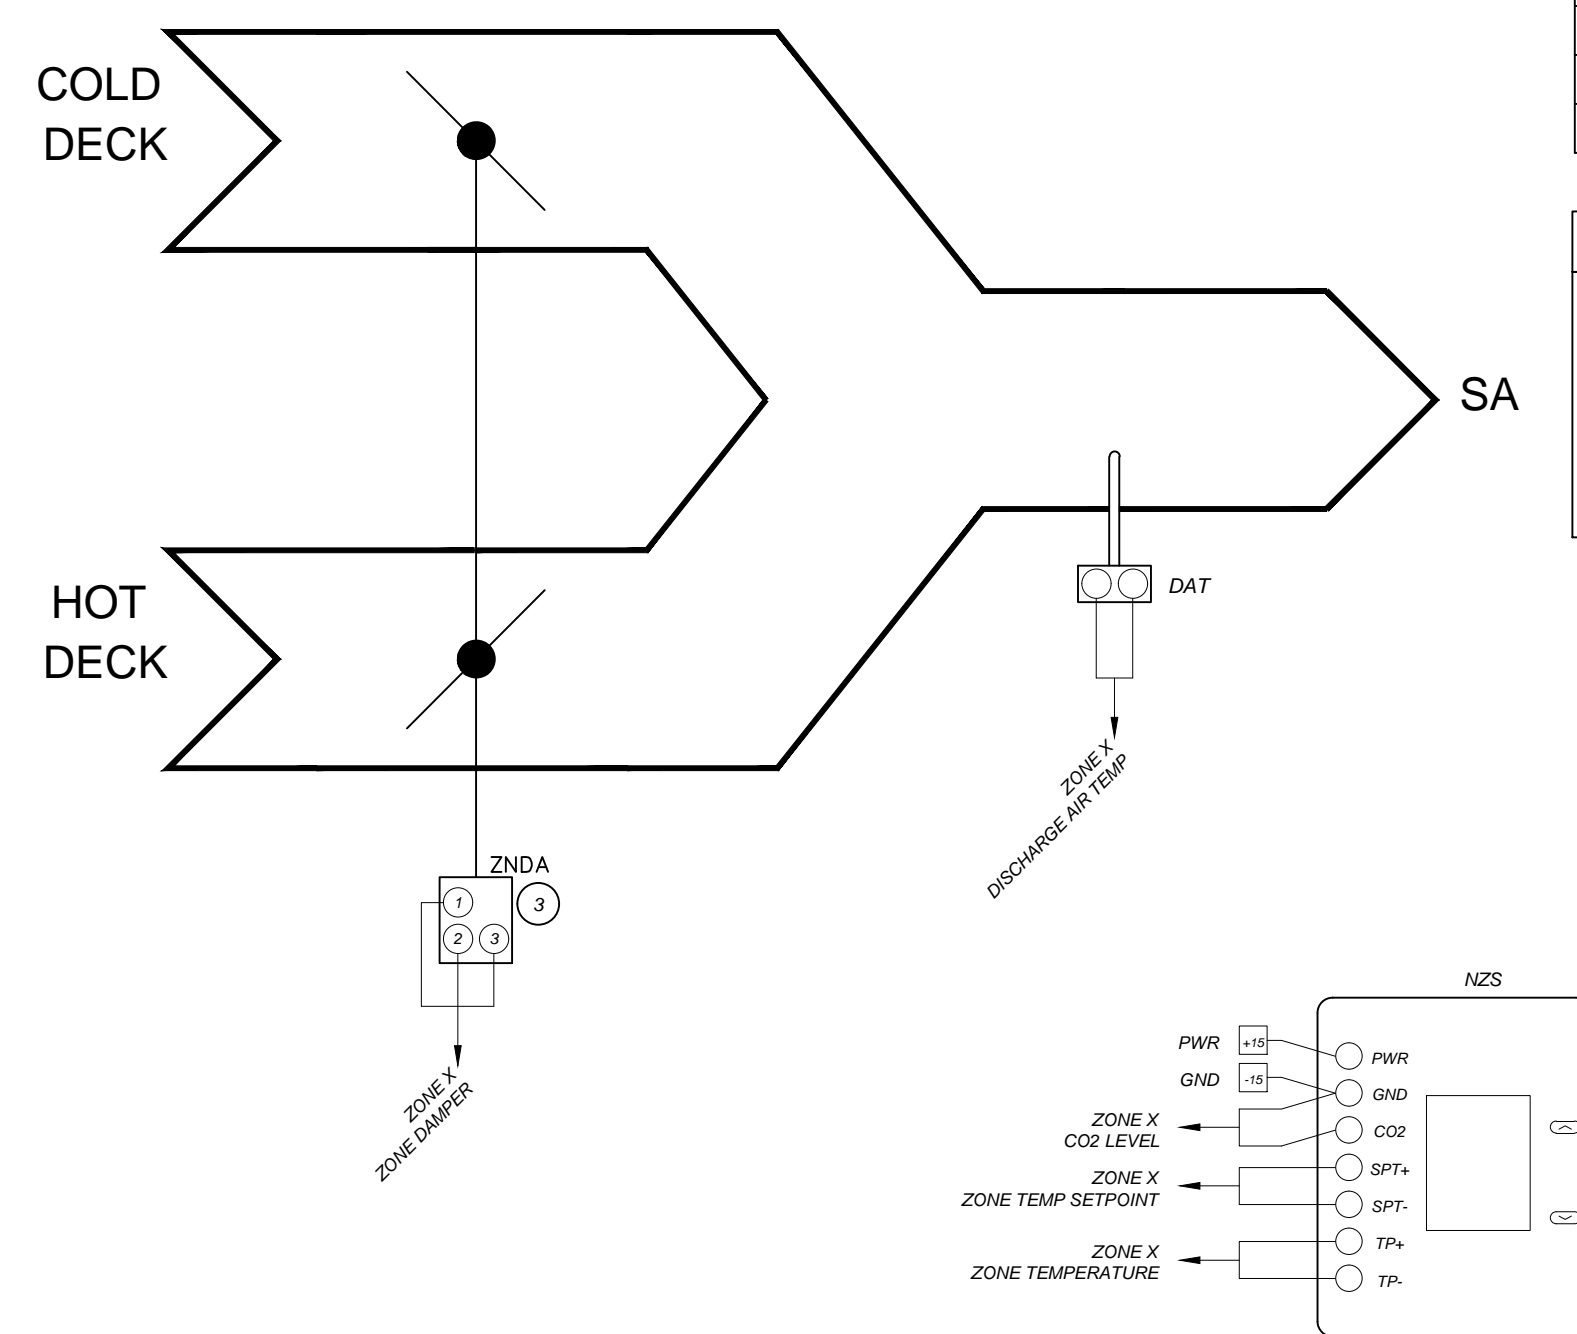

ZONE CONTROL DETAIL

Detail Notes	
1	LINE VOLTAGE & CONDUIT BY DIVISION 16.
2	CONTROL COMPONENTS PROVIDED BY TOTAL CONTROL CONTACT DEVEN PUTNAM AT 559-291-1000.
3	PROVIDE (N) ACTUATOR.

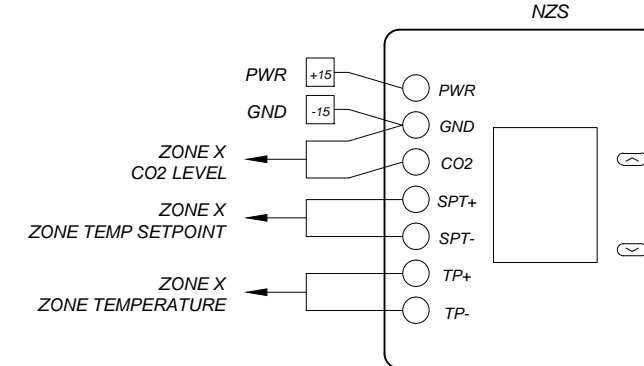


$\frac{D}{M-5}$

B
M-6

Control Components	
TAG	DESCRIPTION
DAT	DUCT TEMP SENSOR
SFCS/CCUS	CURRENT SENSOR
RIB	24VAC RELAY IN A BOX
NZS	NETWORK ZONE SENSOM W/ CO

Detail Notes
1 LINE VOLTAGE & CONDUIT BY DIVISION 16.
2 UNIT SHALL SHUT DOWN UPON DETECTION OF SMOKE. WIRE ACCORDINGLY.
3 CONTROL COMPONENTS PROVIDED BY TOTAL CONTROL CONTACT DEVEN PUTNAM AT 559-291-1000.
4 SEE DETAIL BM-7 FOR TCP DIAGRAM.

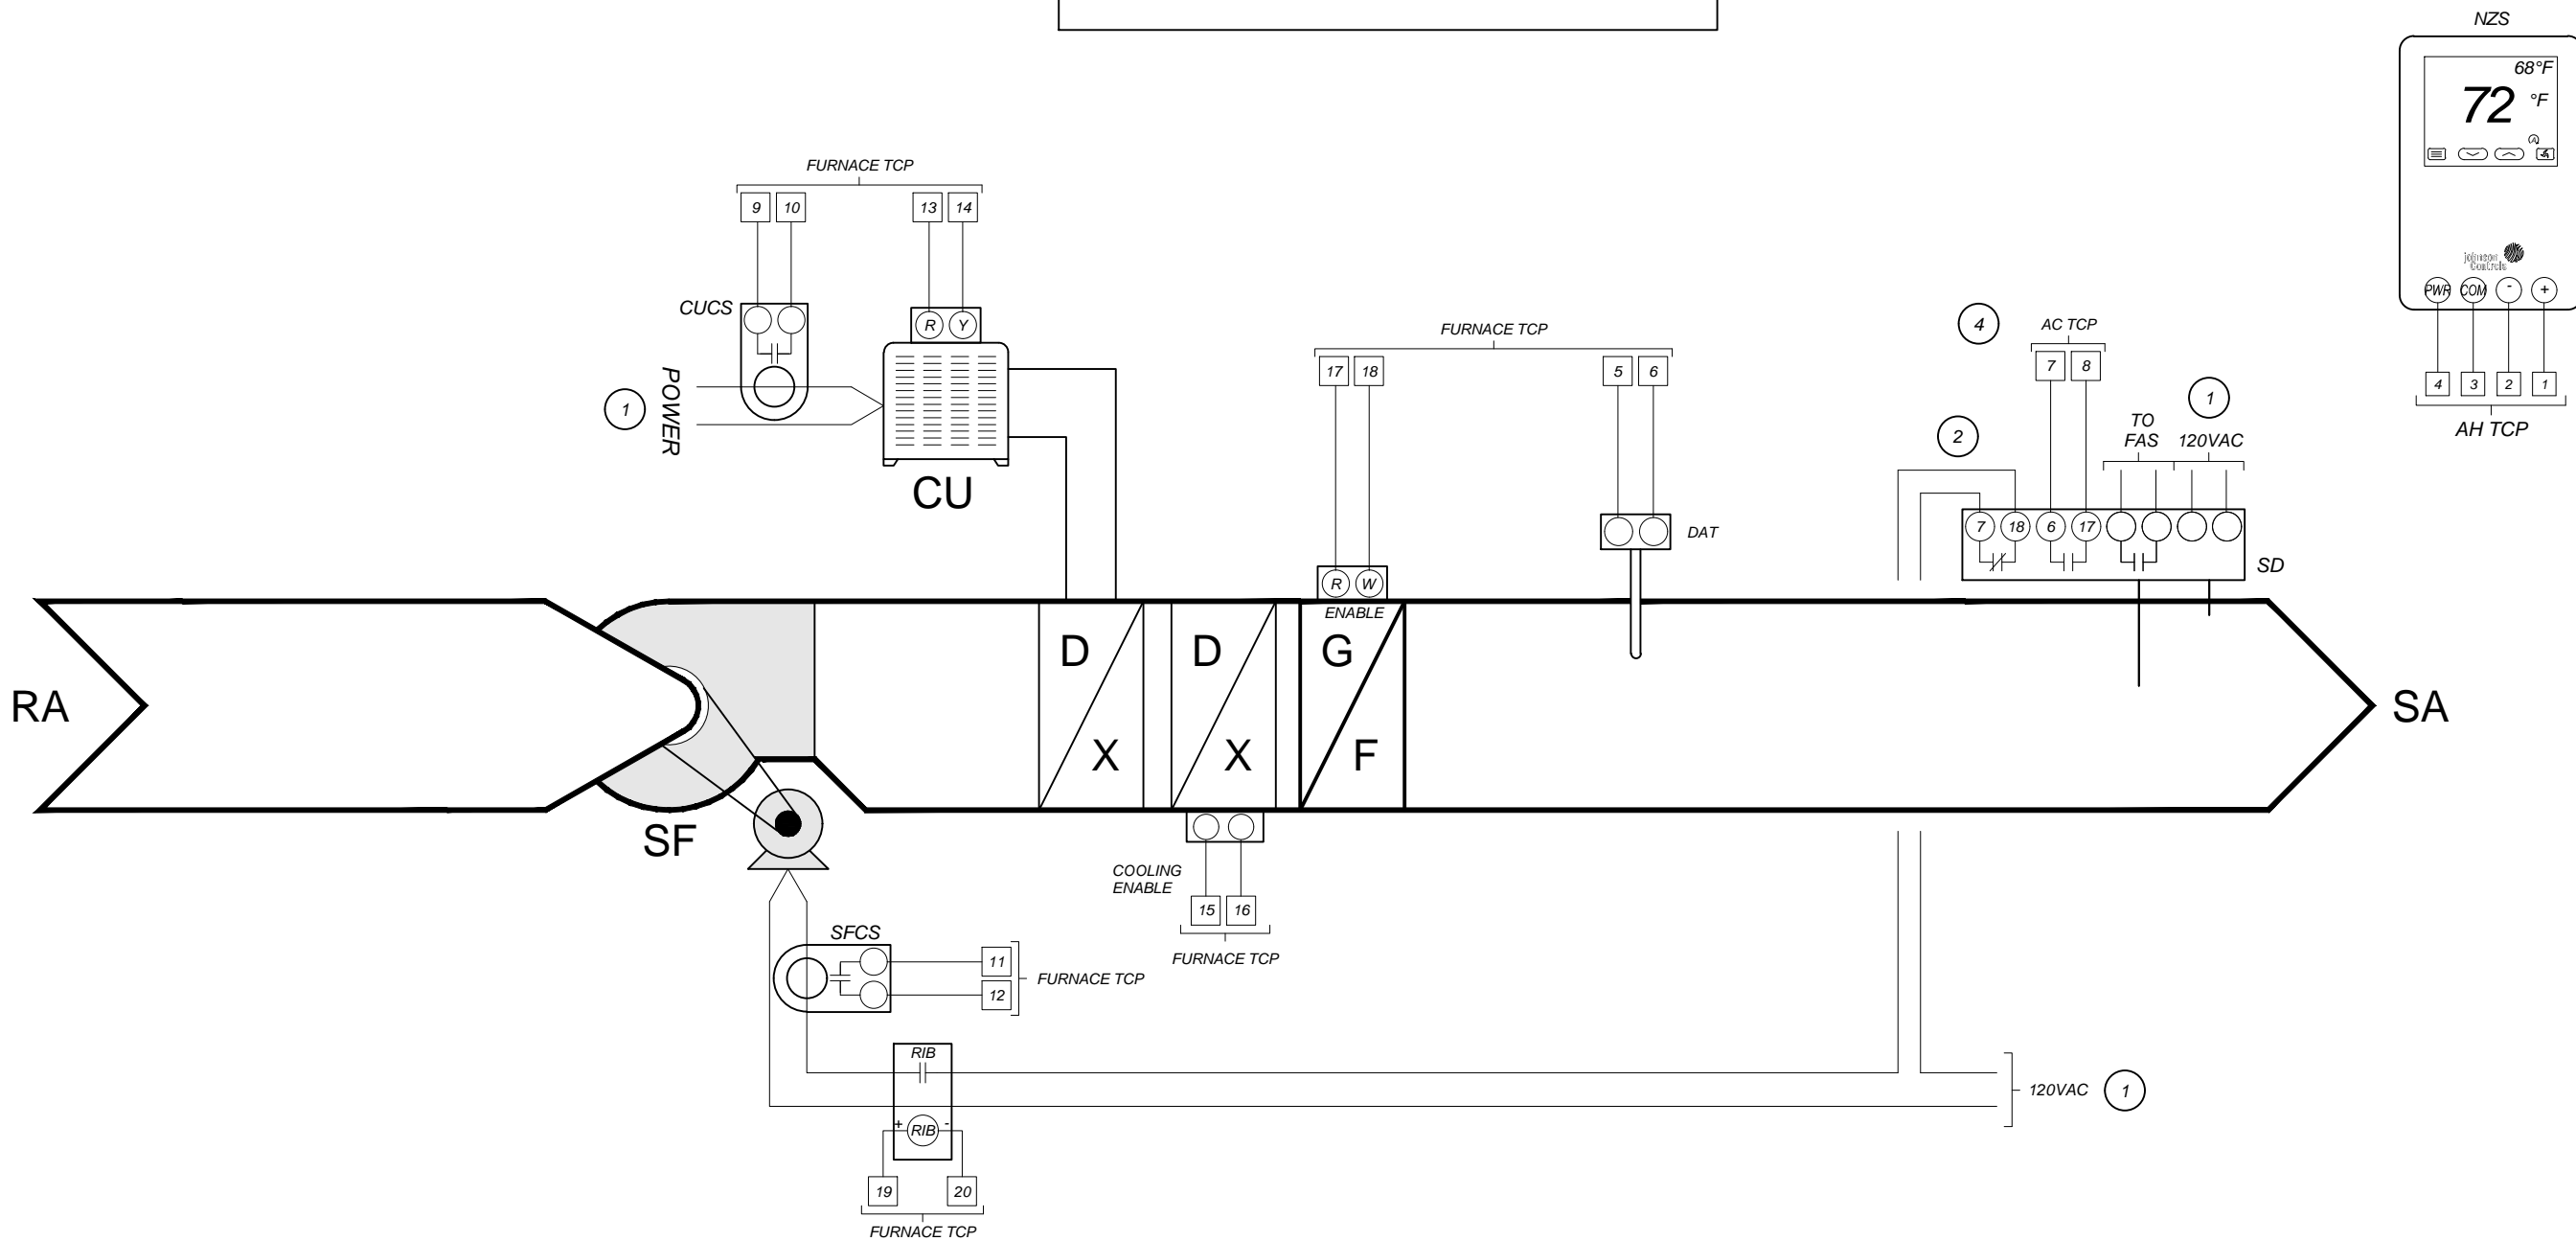


FURNACE C1/F-1 CONTROL DETAIL

A
M-7


Control Components	
TAG	DESCRIPTION
DAT	DUCT TEMP SENSOR
CCS,SFCS	CURRENT SENSOR
NZS	NETWORK ZONE SENSOR W/ CO
OAD/RAD	SPRING RETURN DAMPER ACTUATOR

Detail Notes
1 LINE VOLTAGE & CONDUIT BY DIVISION 16.
2 OAT GLOBALLY SHARED SOFTWARE POINT
3 CONTROL COMPONENTS PROVIDED BY TOTAL CONTROL CONTACT DEVEN PUTNAM AT 559-291-1000.
4 SEE DETAIL DM-7 FOR TCP DIAGRAM.

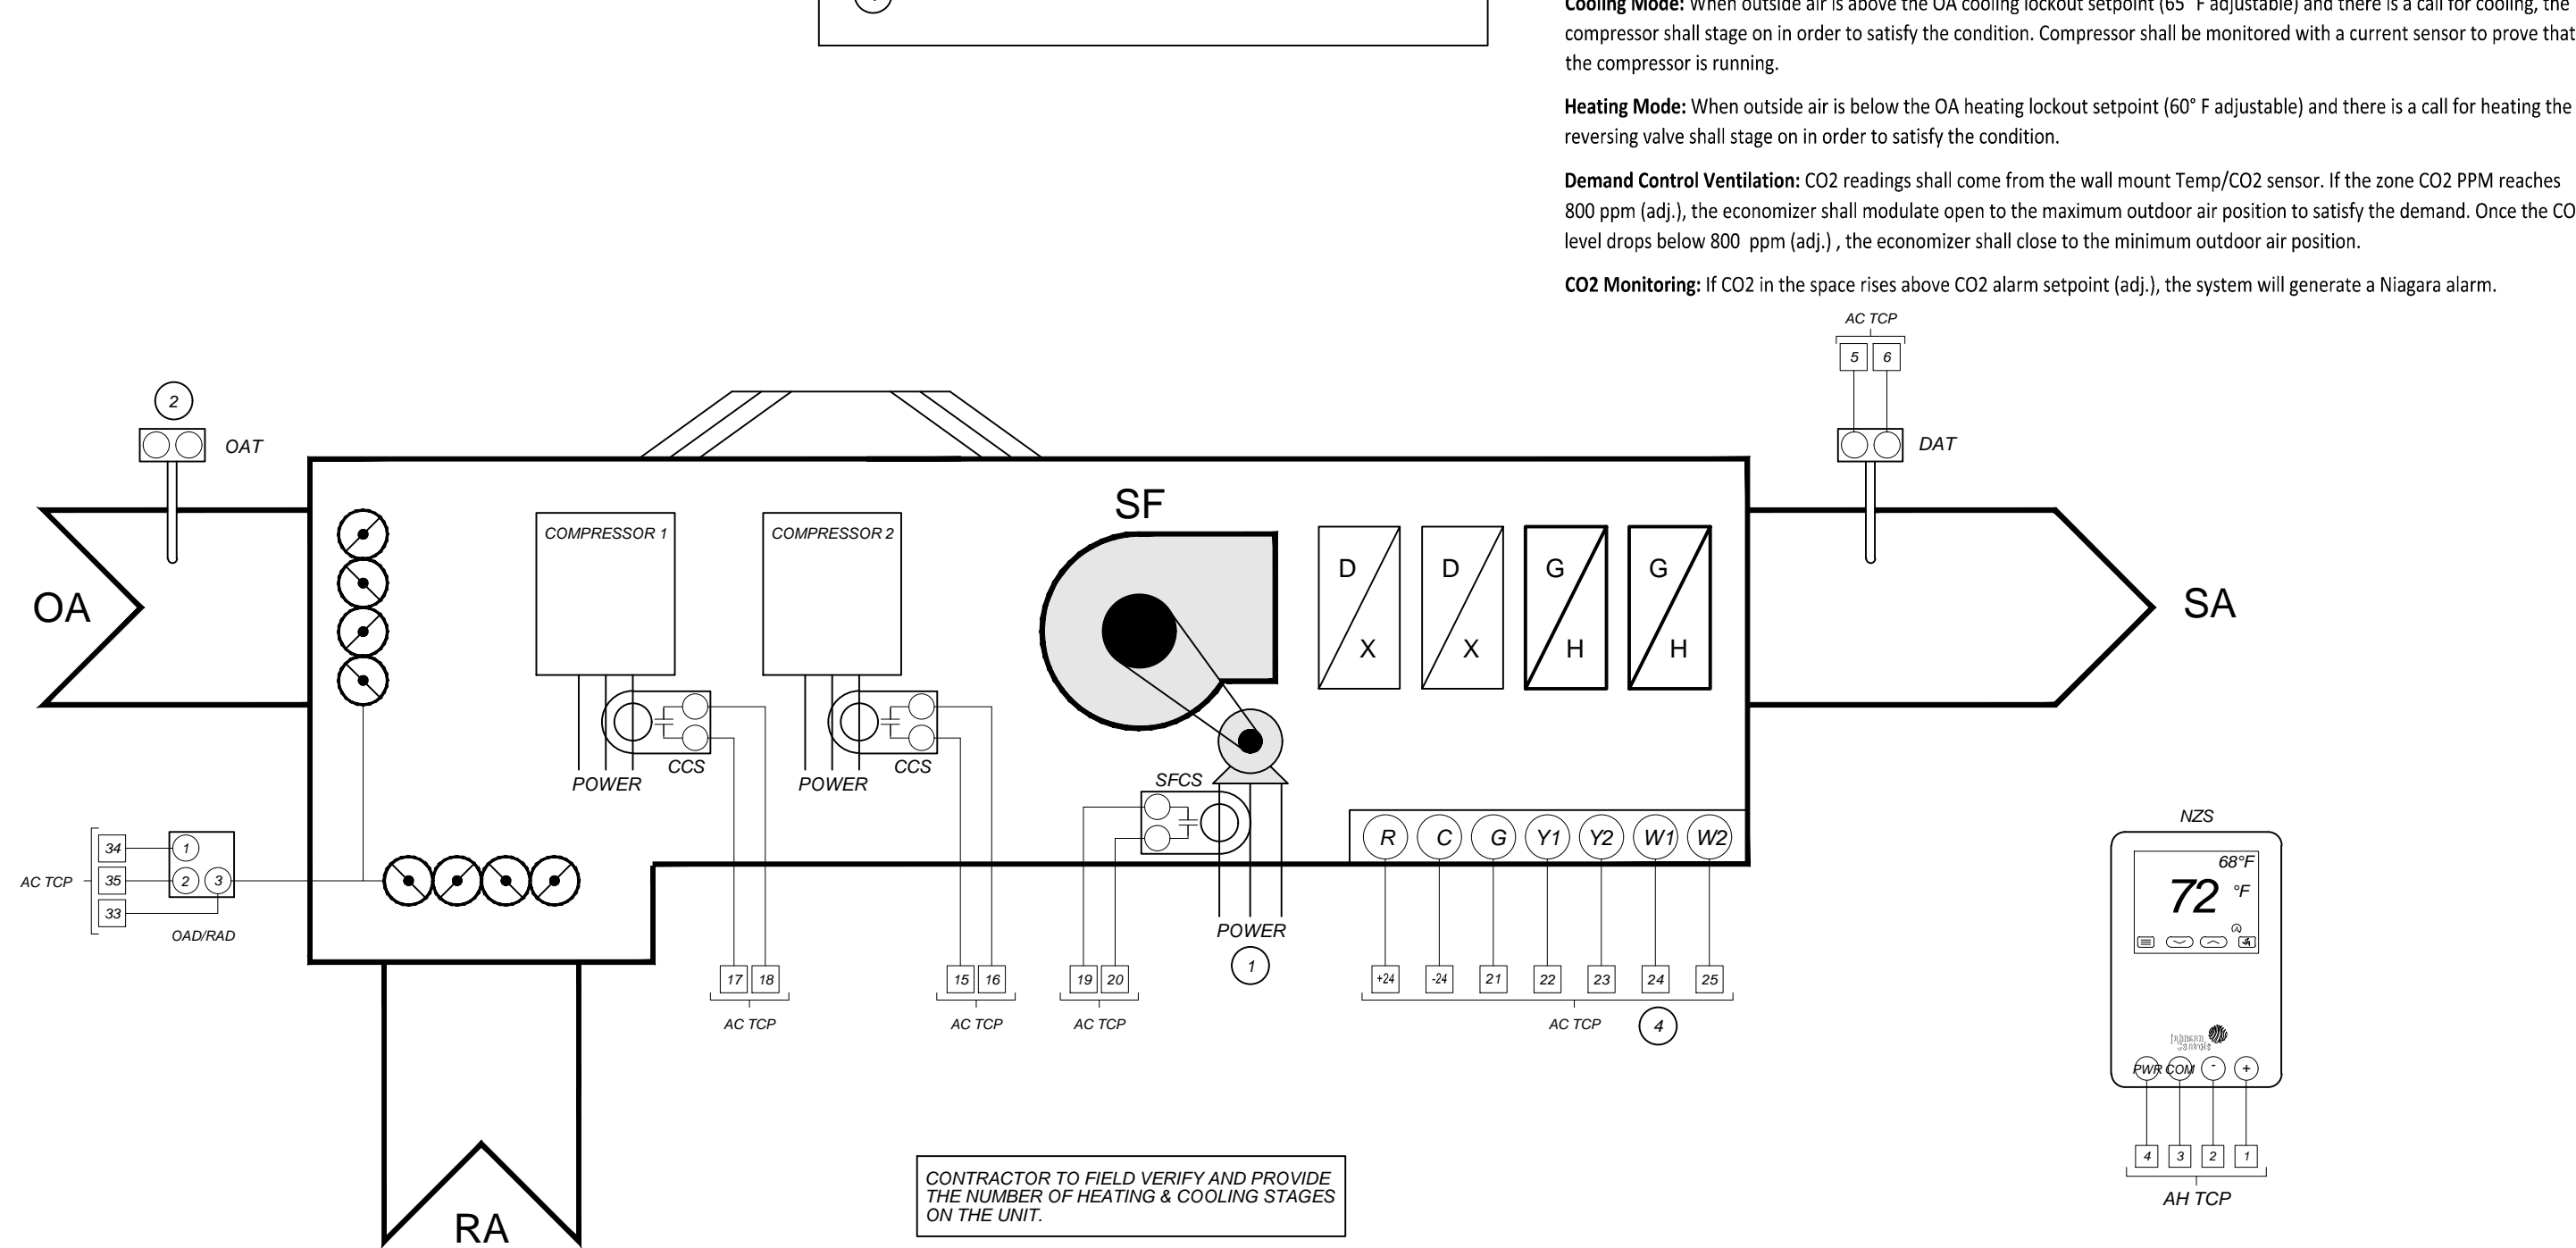


ROOF TOP UNIT CONTROL DETAIL

C
M-7

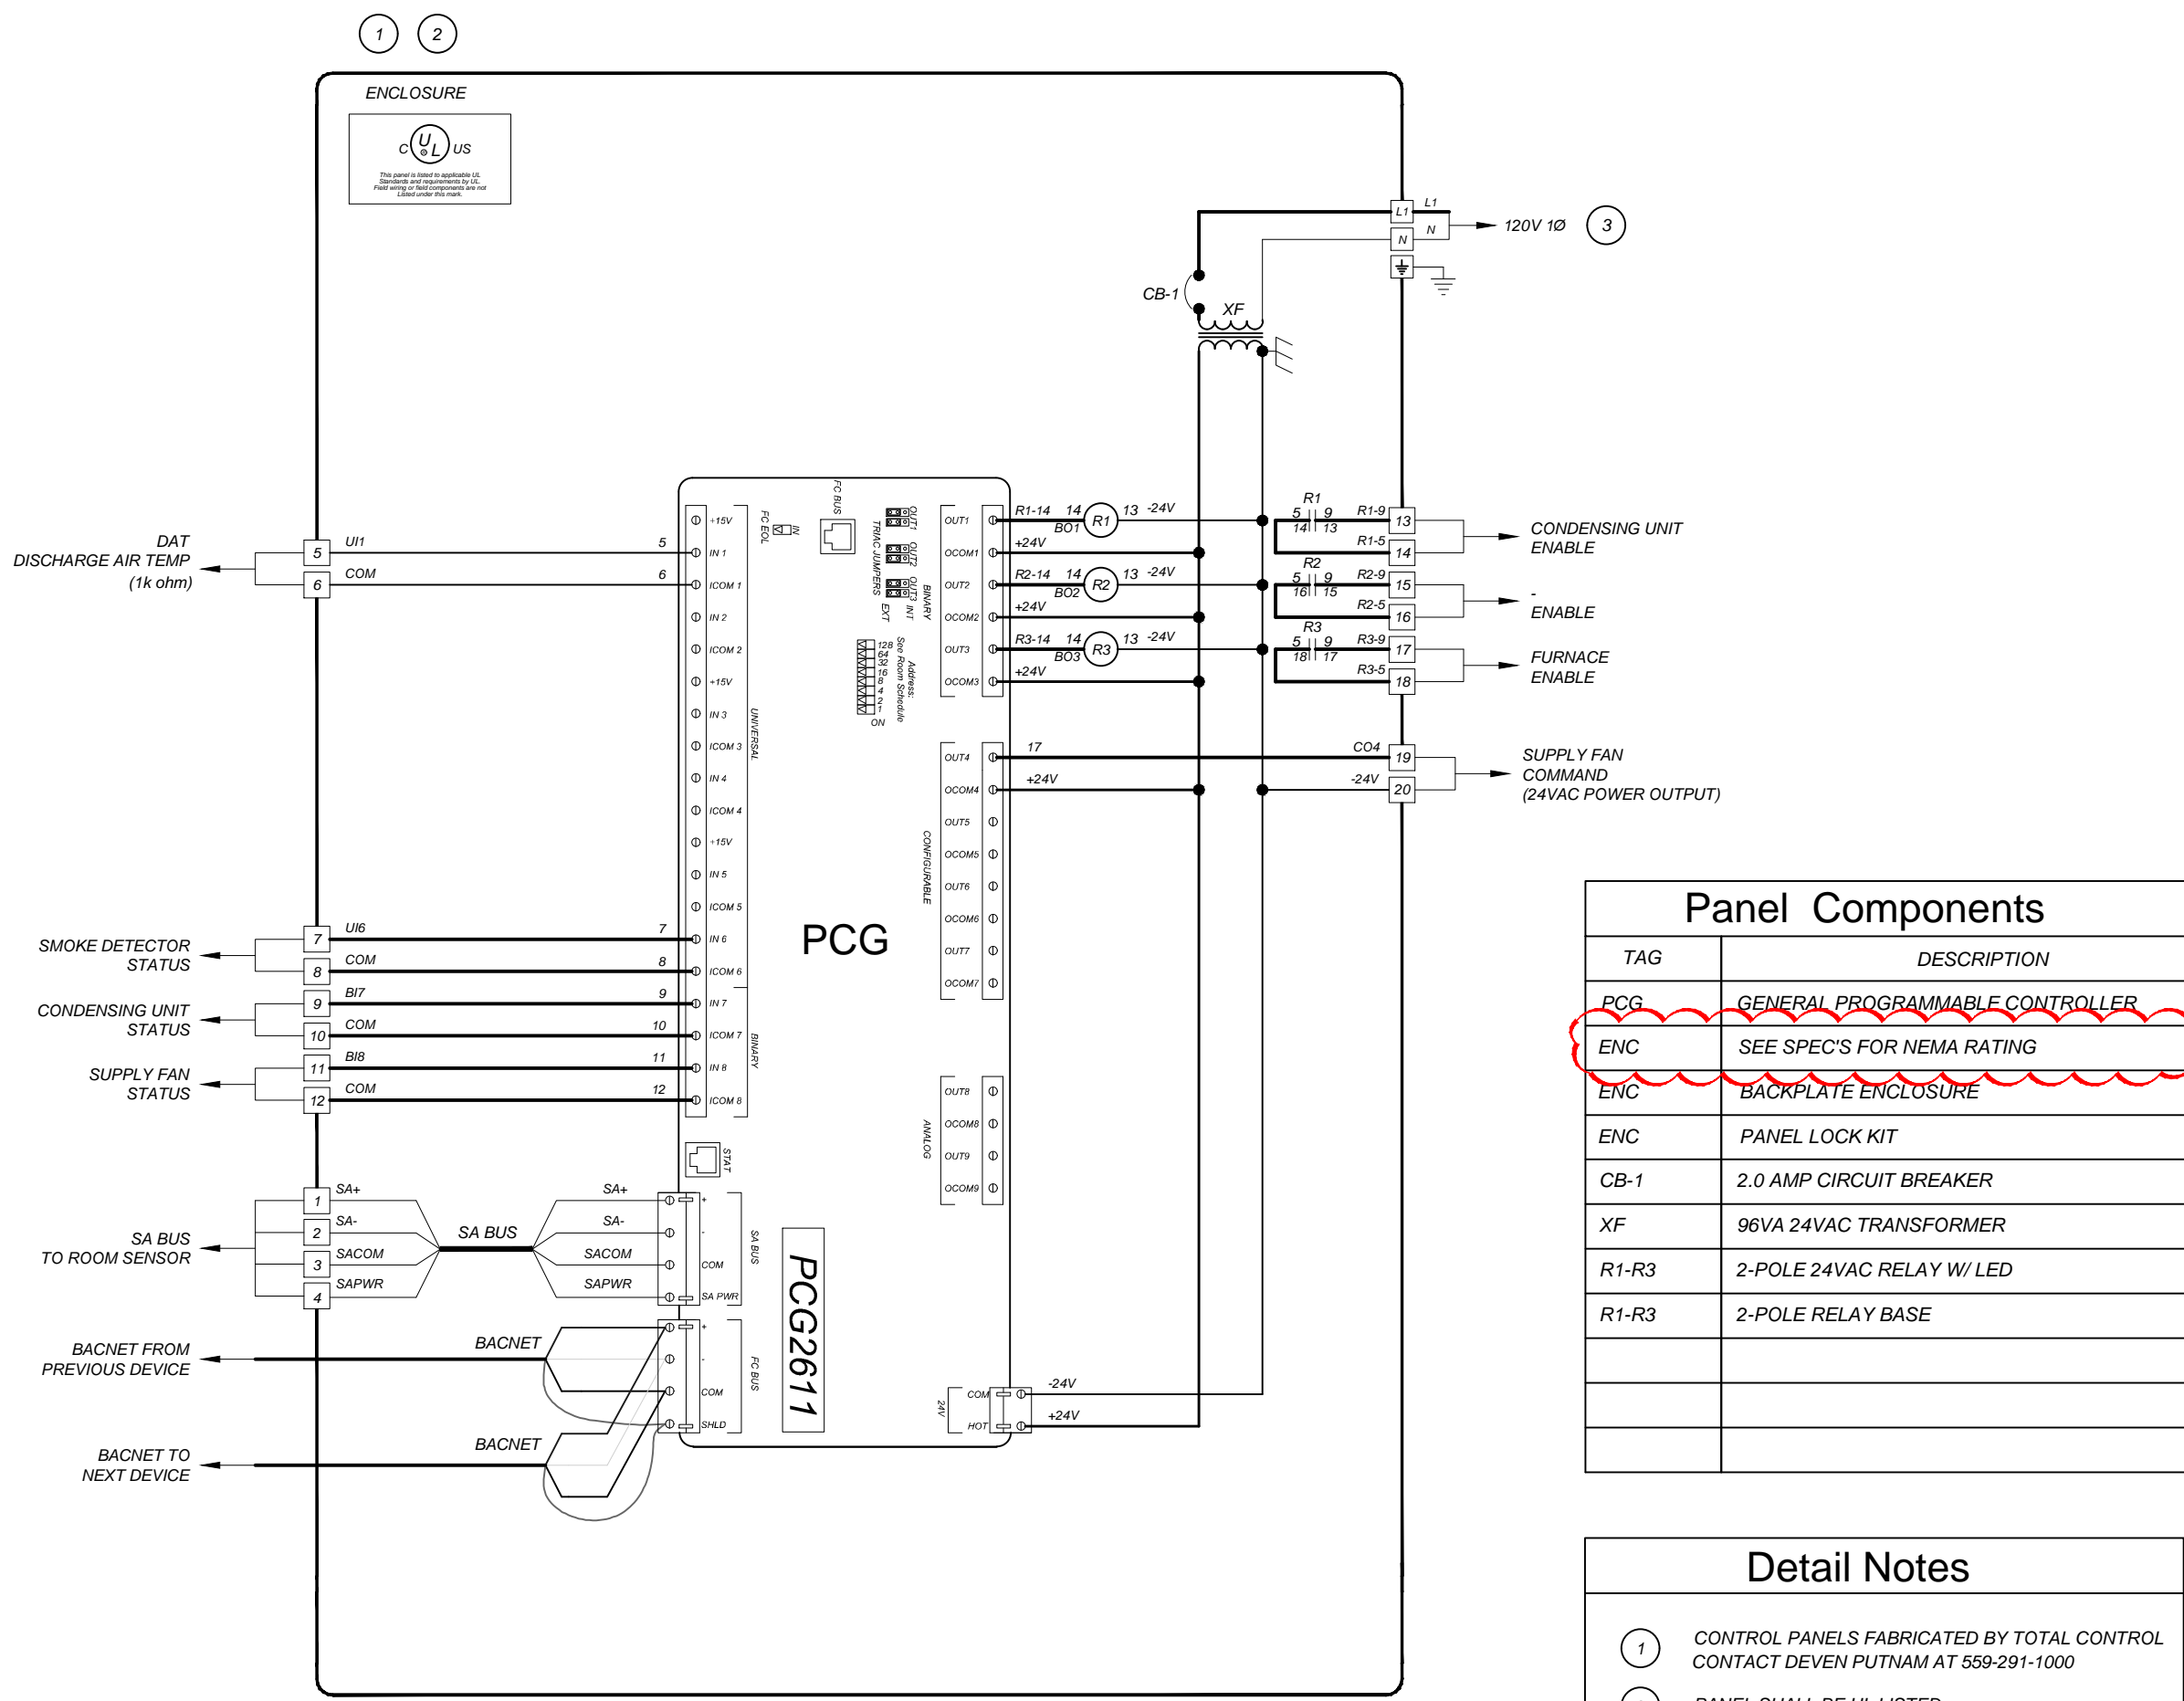

FURNACE TCP SCHEMATIC DETAIL

B
M-7

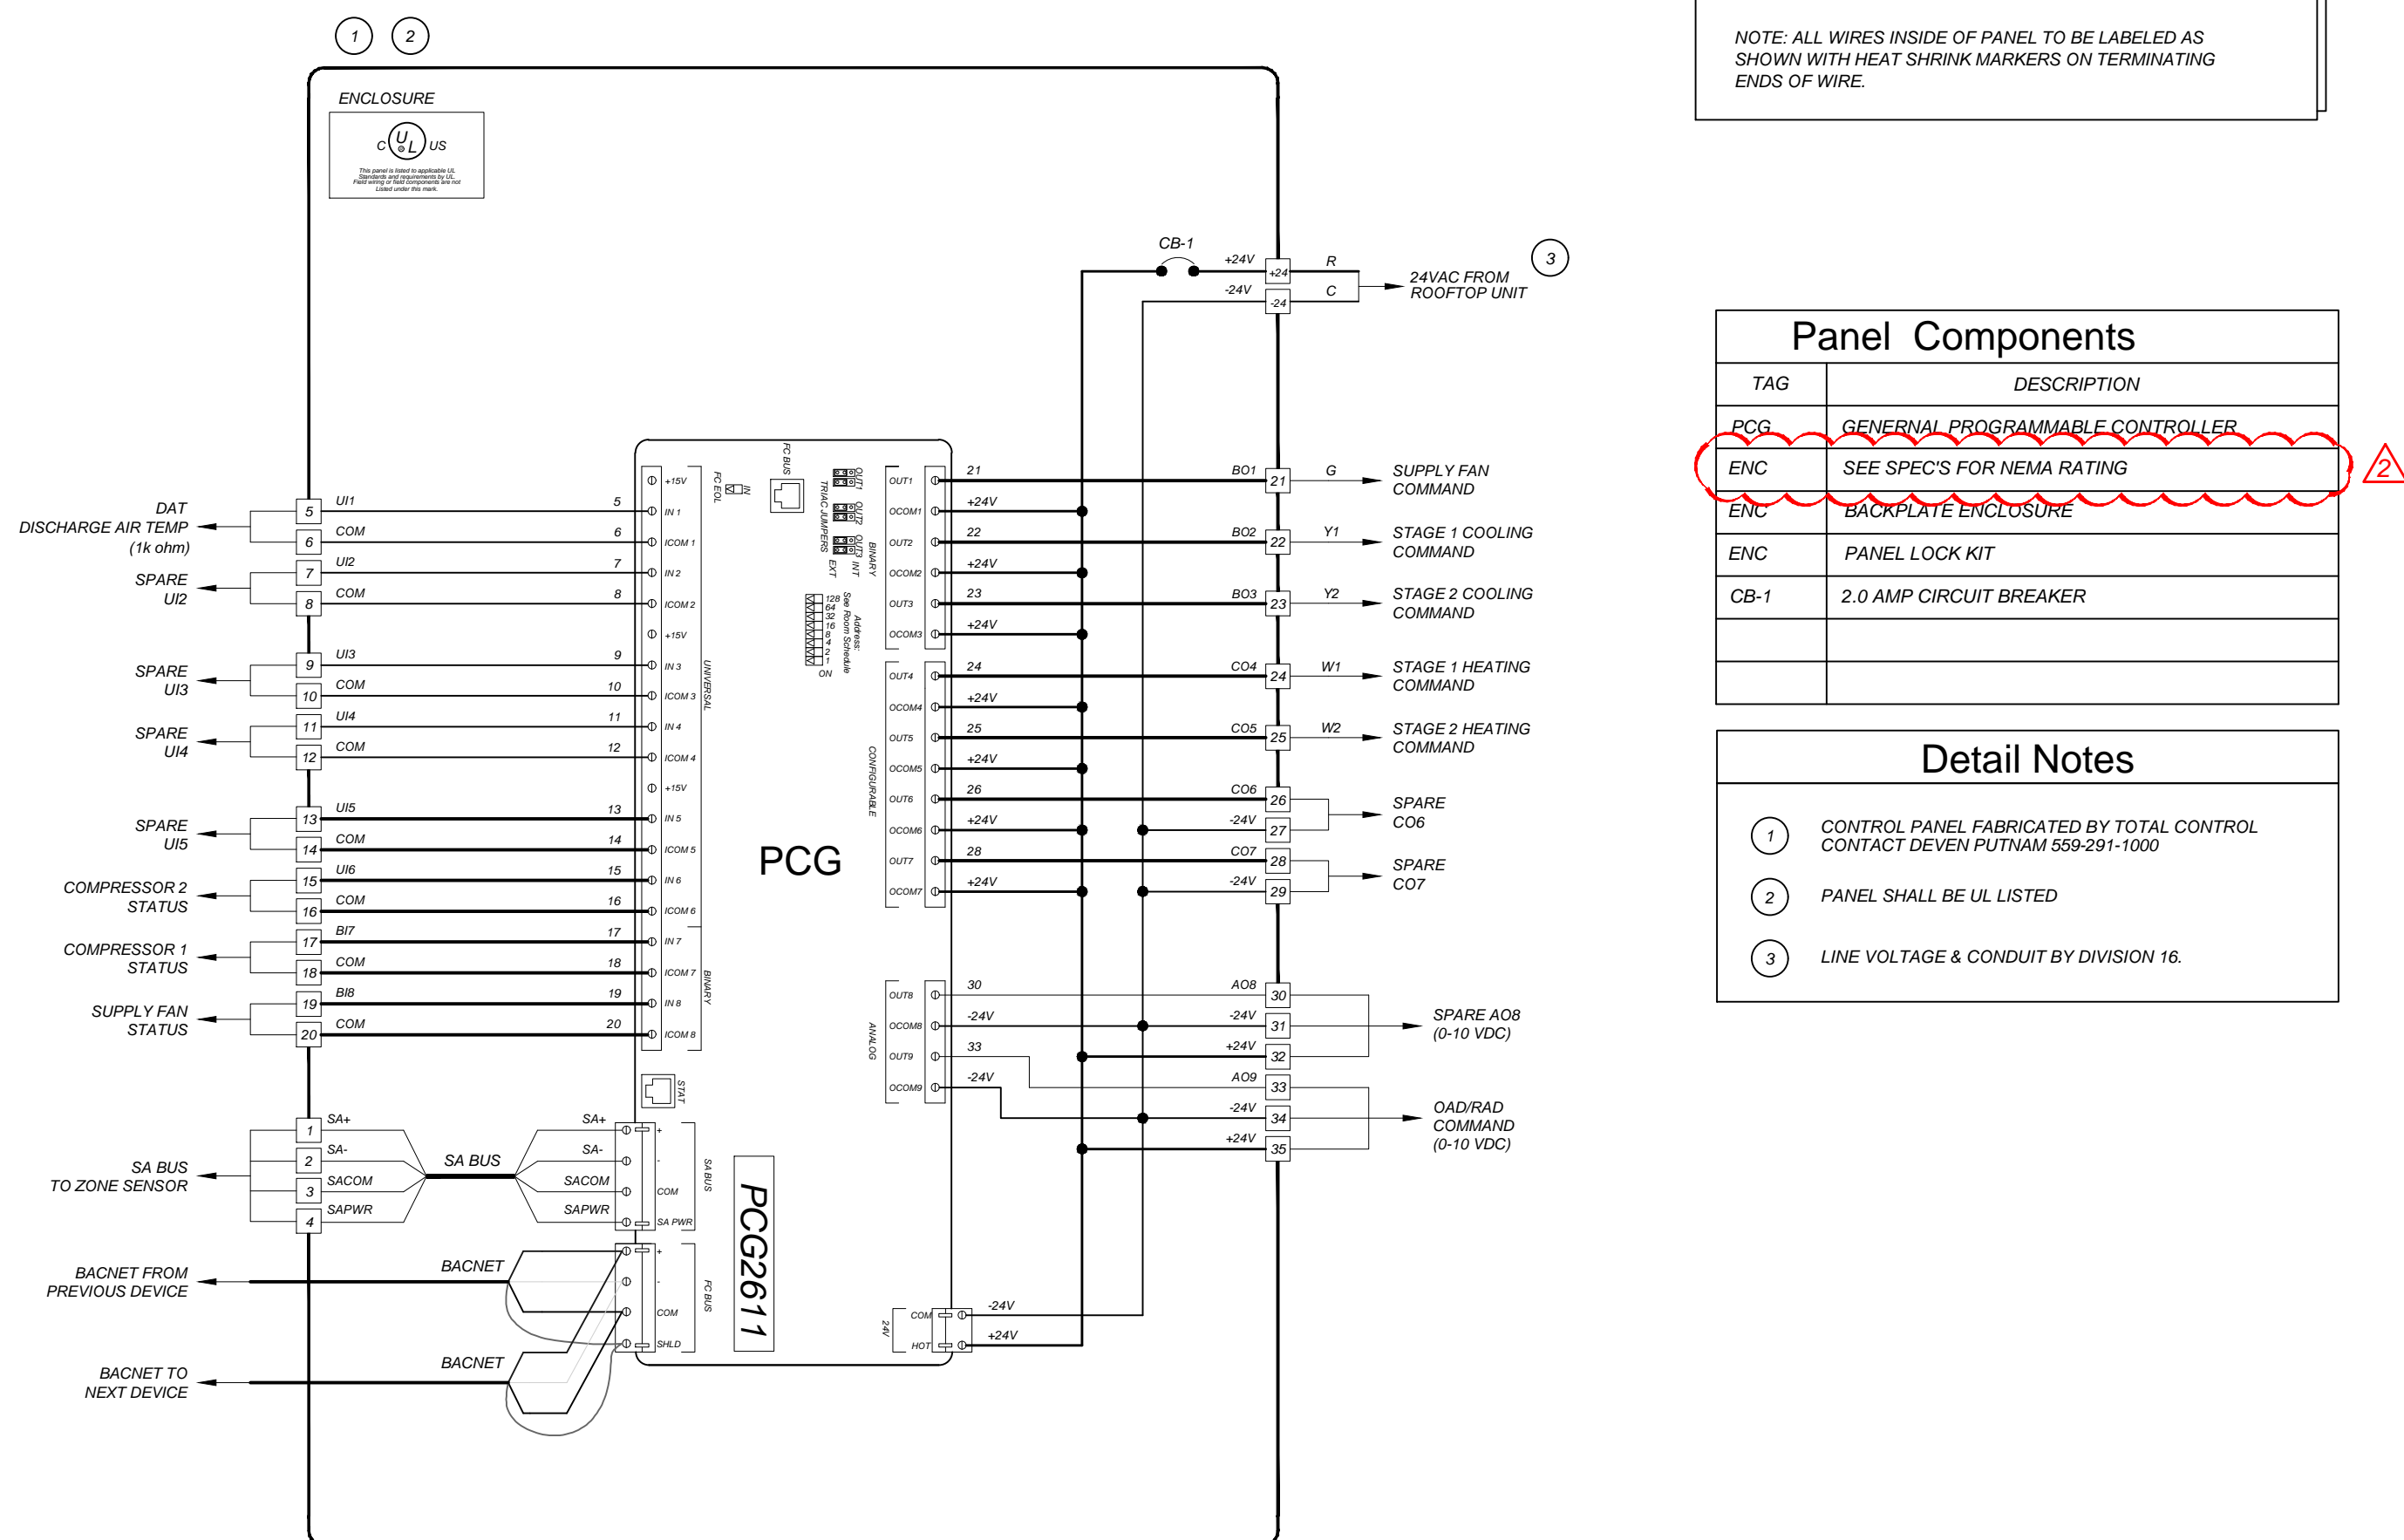

ROOF TOP UNIT TCP SCHEMATIC DETAIL

D
M-7

Package Unit

A thermostat shall be mounted in the space.

Occupied Cool Setpoint: 75°F (adjustable)

Occupied Heat Setpoint: 68°F (adjustable)

Warm/Cool Adjustment: +3°/-3°

Unoccupied Mode: The unit shall remain OFF in unoccupied mode.

Occupied Mode: The unit shall receive an occupied command from the Johnson FX Supervisory controller. The supply fan will be enabled. A current sensor on the supply fan shall prove supply fan status. When the run status is proven ON, the following modes shall be allowed to happen.

Cooling Mode: When outside air is above the OA cooling lockout setpoint (65° F adjustable) and there is a call for cooling, the compressor shall stage on in order to satisfy the condition. Compressor shall be monitored with a current sensor to prove that the compressor is running.

Heating Mode: When outside air is below the OA heating lockout setpoint (60° F adjustable) and there is a call for heating the reversing valve shall stage on in order to satisfy the condition.

Demand Control Ventilation: CO2 readings shall come from the wall mount Temp/CO2 sensor. If the zone CO2 PPM reaches 800 ppm (adj.), the economizer shall modulate open to the maximum outdoor air position to satisfy the demand. Once the CO2 level drops below 800 ppm (adj.), the economizer shall close to the minimum outdoor air position.

CO2 Monitoring: If CO2 in the space rises above CO2 alarm setpoint (adj.), the system will generate a Niagara alarm.

APPROVALS:
APPLICATION #
777777777



DATE: 11-25-2020

EMS REPLACEMENT
ROWELL ELEMENTARY SCHOOL
3460 EAST MCKENZIE AVE. FRESNO, CA 93702
FRESNO UNIFIED SCHOOL DISTRICT
4600 N. BRAWLEY AVE. FRESNO, CA.

REVISIONS
4/22/21 EMS REVISIONS

Panel Components	
TAG	DESCRIPTION
PCG	GENERAL PROGRAMMABLE CONTROLLER
ENC	SEE SPECS FOR NEMA RATING
ENC	BACKPLATE ENCLOSURE
ENC	PANEL LOCK KIT
CB-1	2.0 AMP CIRCUIT BREAKER

Detail Notes
1 CONTROL PANELS FABRICATED BY TOTAL CONTROL CONTACT DEVEN PUTNAM 559-291-1000
2 PANEL SHALL BE UL LISTED
3 LINE VOLTAGE & CONDUIT BY DIVISION 16.


LAWRENCE
ENGINEERING GROUP
Fresno, CA 93720
(559) 431-1362
7084 N. Maple Ave., Suite 101
(559) 431-0101

TITLE:
ENERGY
MANAGEMENT
DETAILS

SHEET:
M7
PROJECT 20139


Control Components	
TAG	DESCRIPTION
DAT,MAT,RAT	DUCT TEMP SENSOR
CCS,SFCS	CURRENT SENSOR
NZS	NETWORK ZONE SENSOR WITH CO
OAD/RAD	SPRING RETURN DAMPER ACTUATOR
BSP	PRESSURE TRANSDUCER

Sheet Notes	
1	LINE VOLTAGE & CONDUIT BY DIVISION 16.
2	OAT GLOBALLY SHARED SOFTWARE POINT
3	CONTROL COMPONENTS PROVIDED BY TOTAL CONTROL CONTACT DEVEN PUTNAM AT 559-291-1000.
4	SEE DETAIL B4M-8 FOR TCP DIAGRAM.

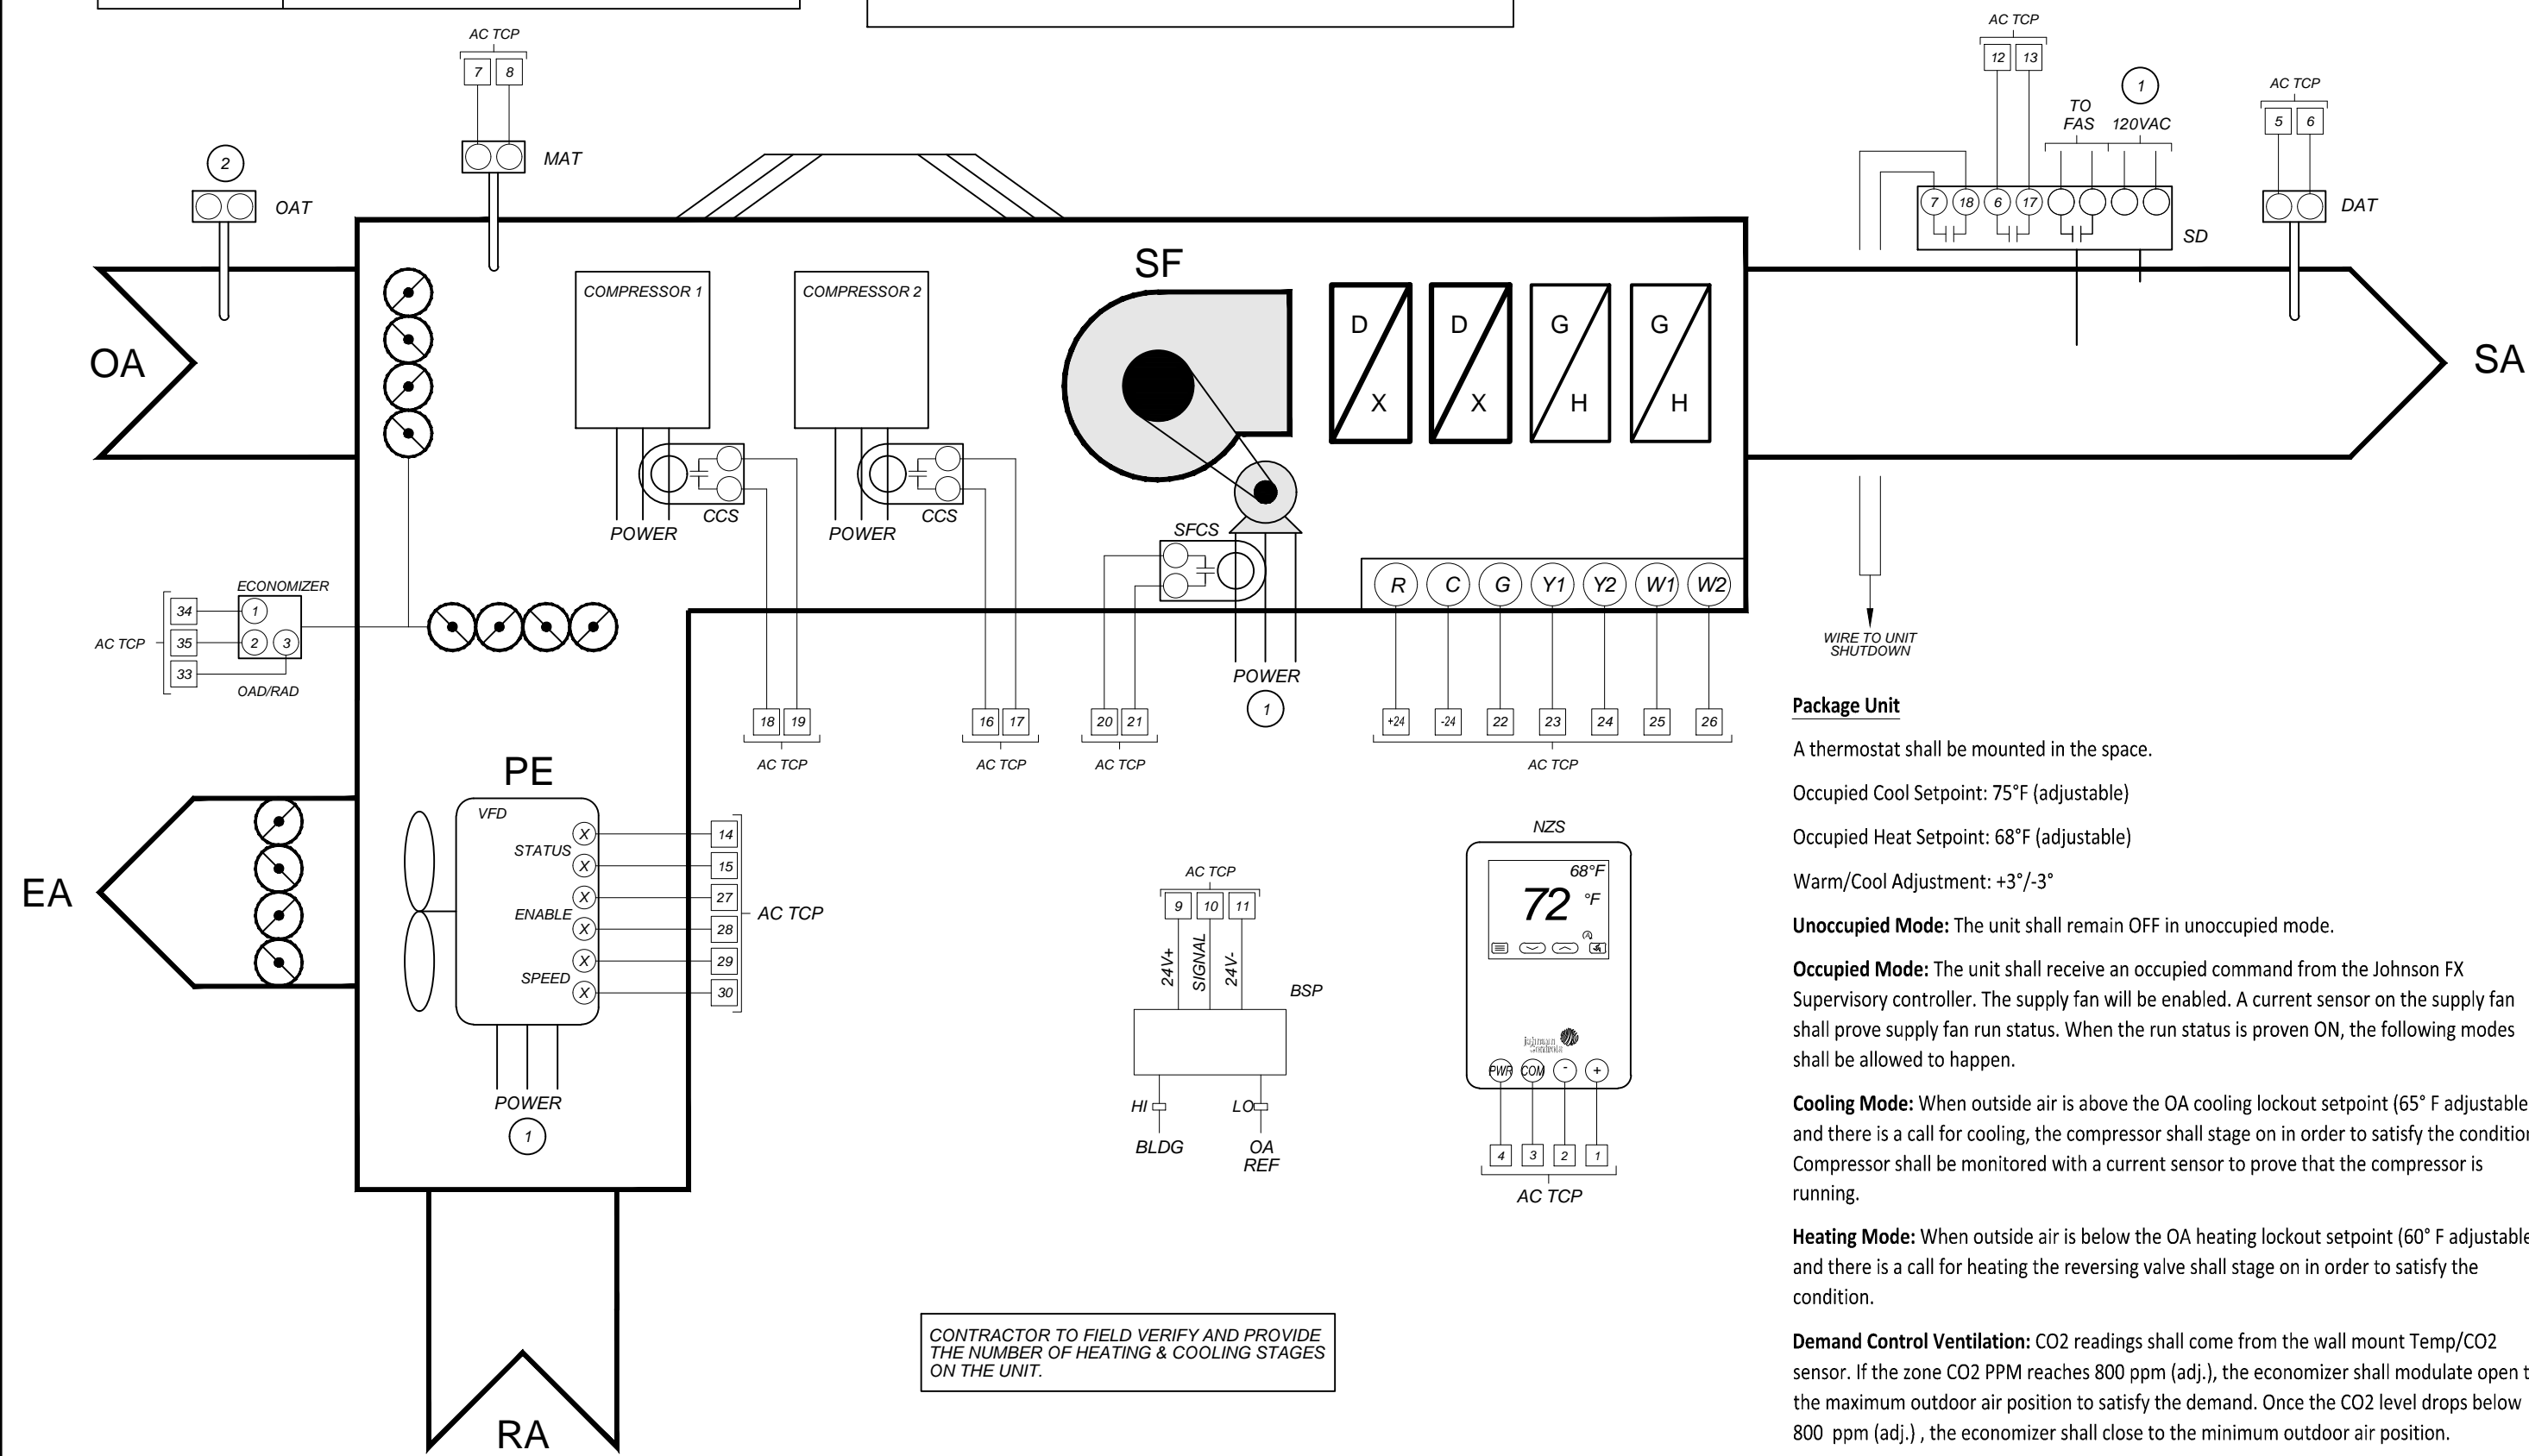

ROOF TOP UNIT CONTROL

A
M-8

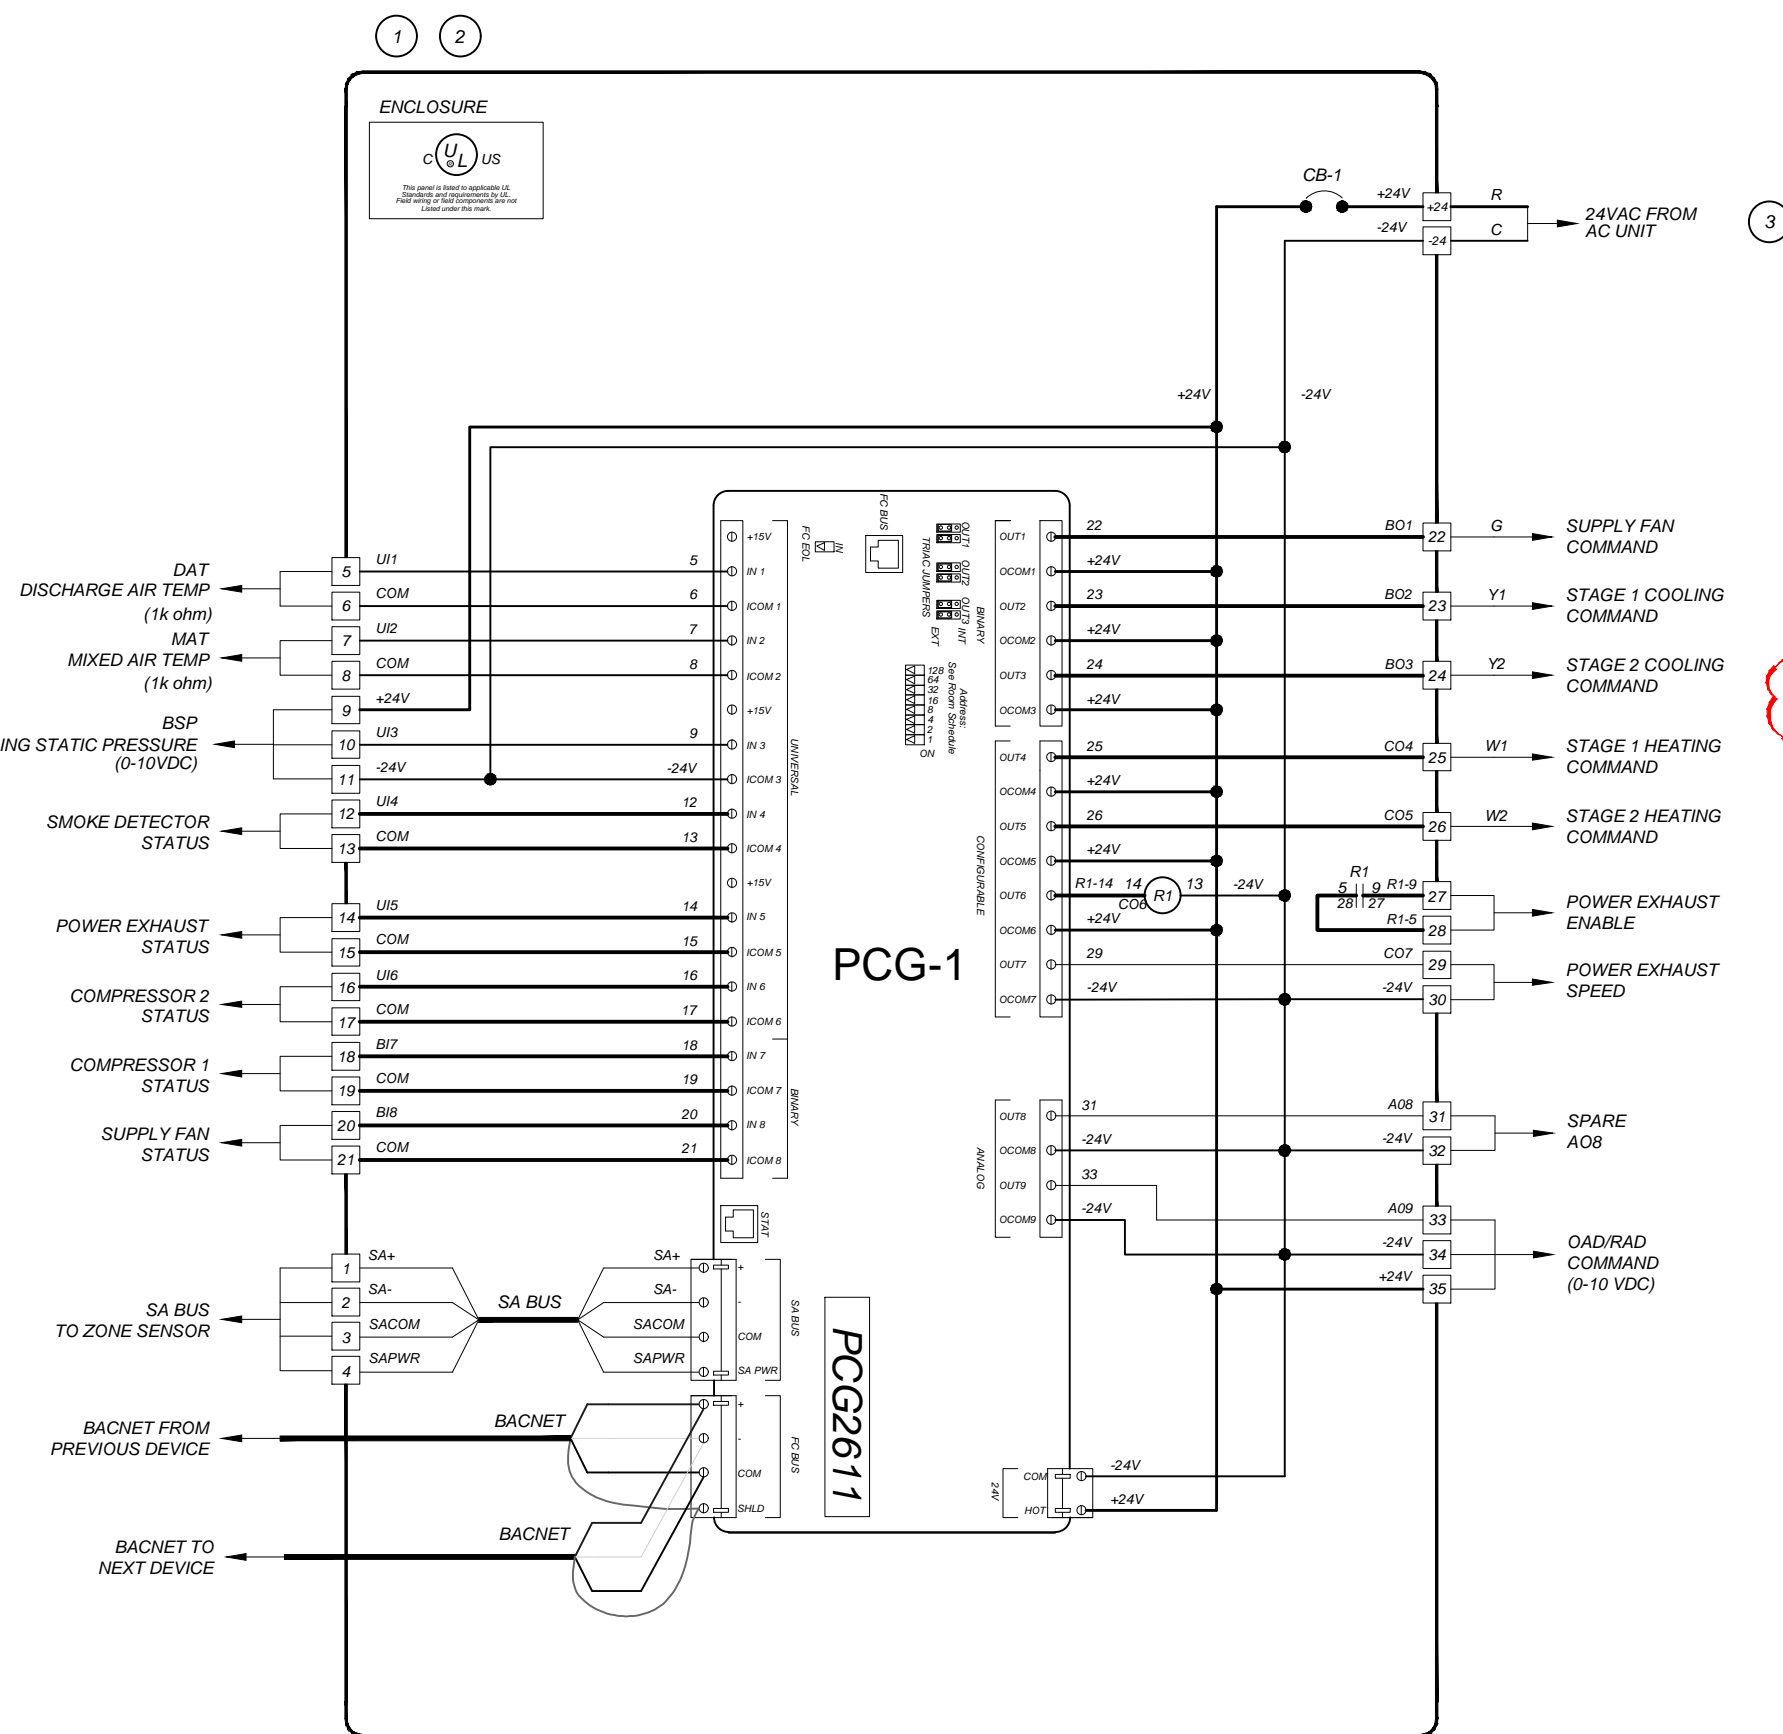


ROOF TOP UNIT TCP SCHEMATIC

HC-2

B
M-8


Control Components	
TAG	DESCRIPTION
DAT,MAT,RAT	DUCT TEMP SENSOR
OAD/RAD	SPRING RETURN DAMPER ACTUATOR
NZS	NETWORK ZONE SENSOR W/ CO

Detail Notes	
1	LINE VOLTAGE & CONDUIT BY DIVISION 16.
2	OAT GLOBALLY SHARED SOFTWARE POINT
3	CONTROL COMPONENTS PROVIDED BY TOTAL CONTROL CONTACT DEVEN PUTNAM AT 559-291-1000.
4	SEE DETAIL B4M-8 FOR TCP DIAGRAM.

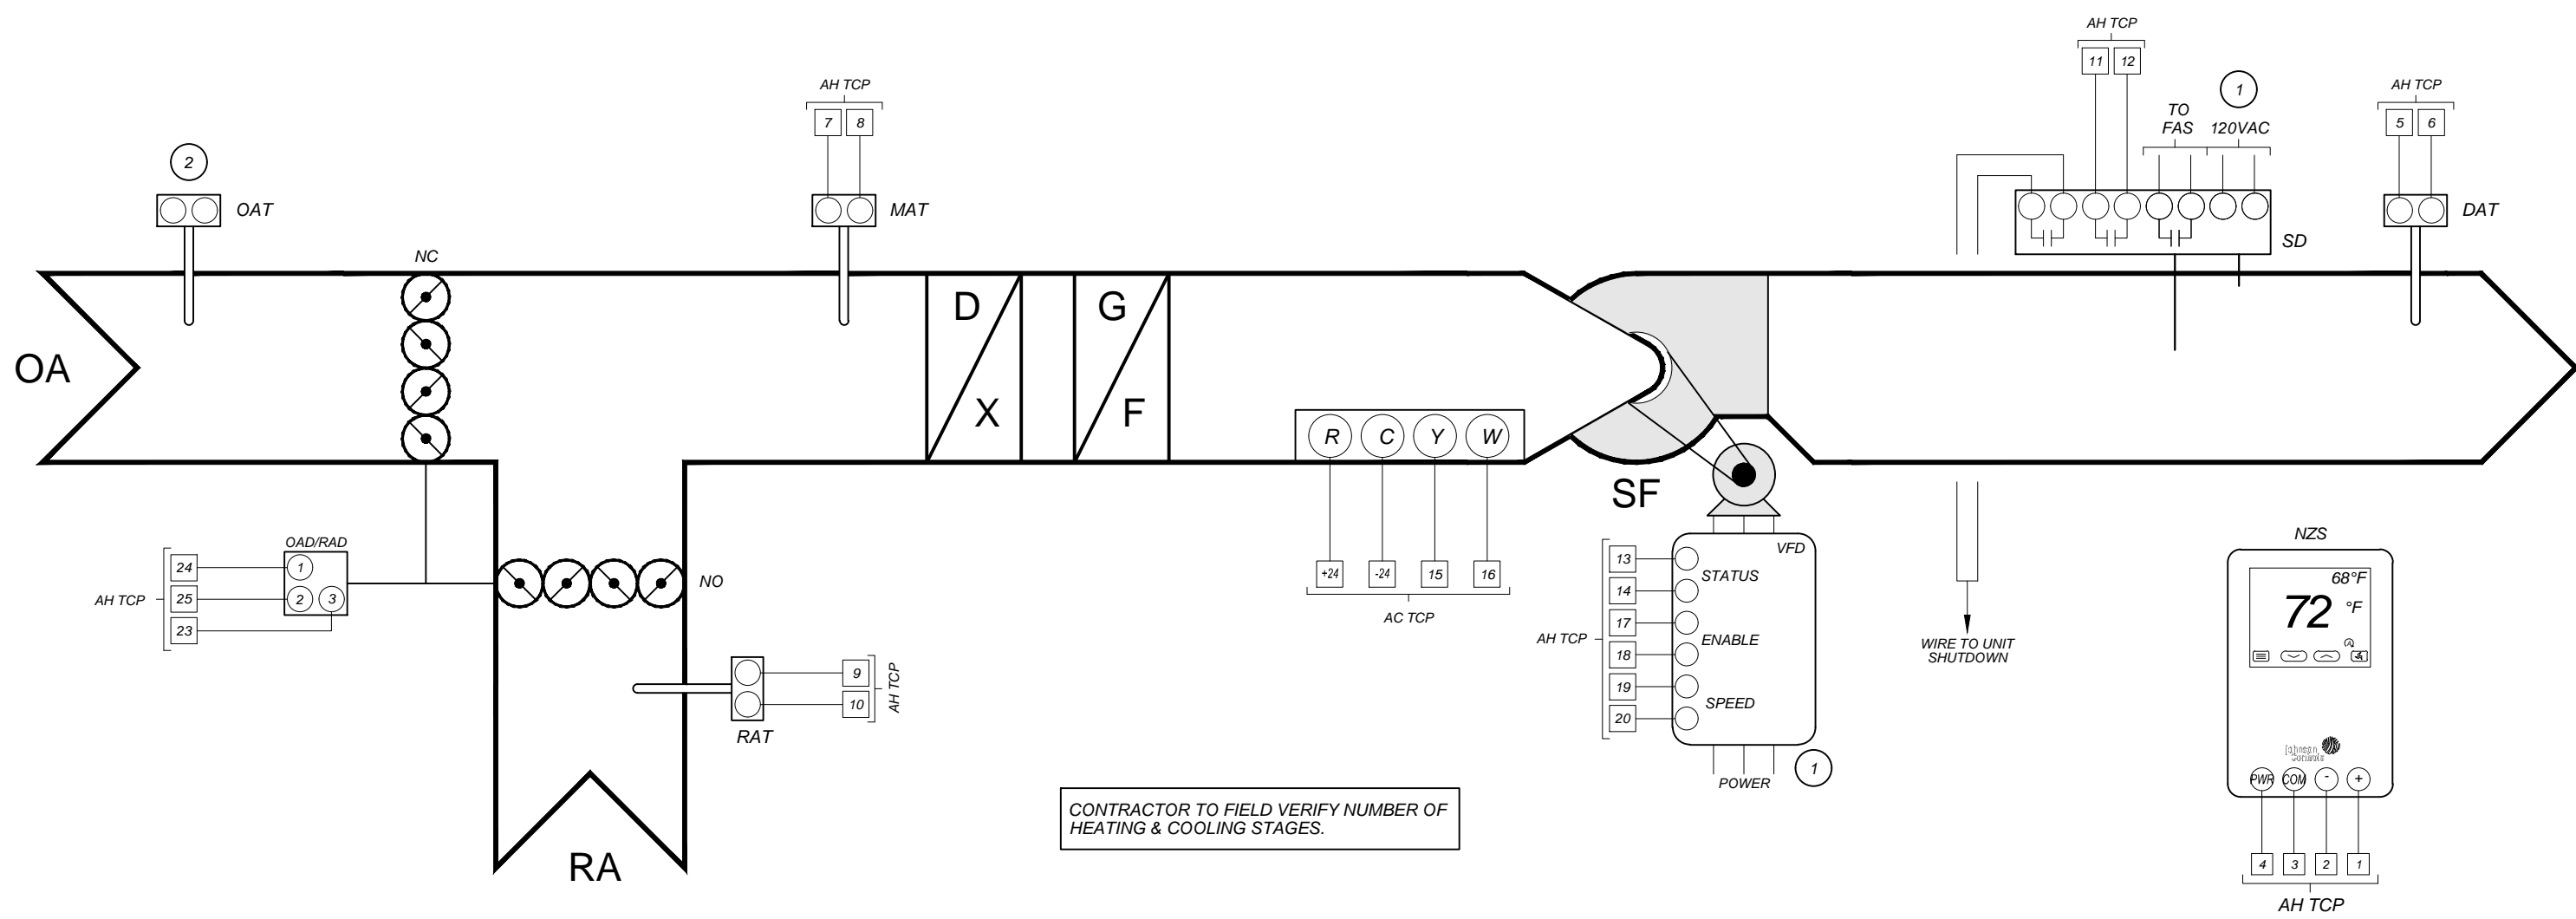

AIR HANDLER CONTROL DETAIL

C
M-8

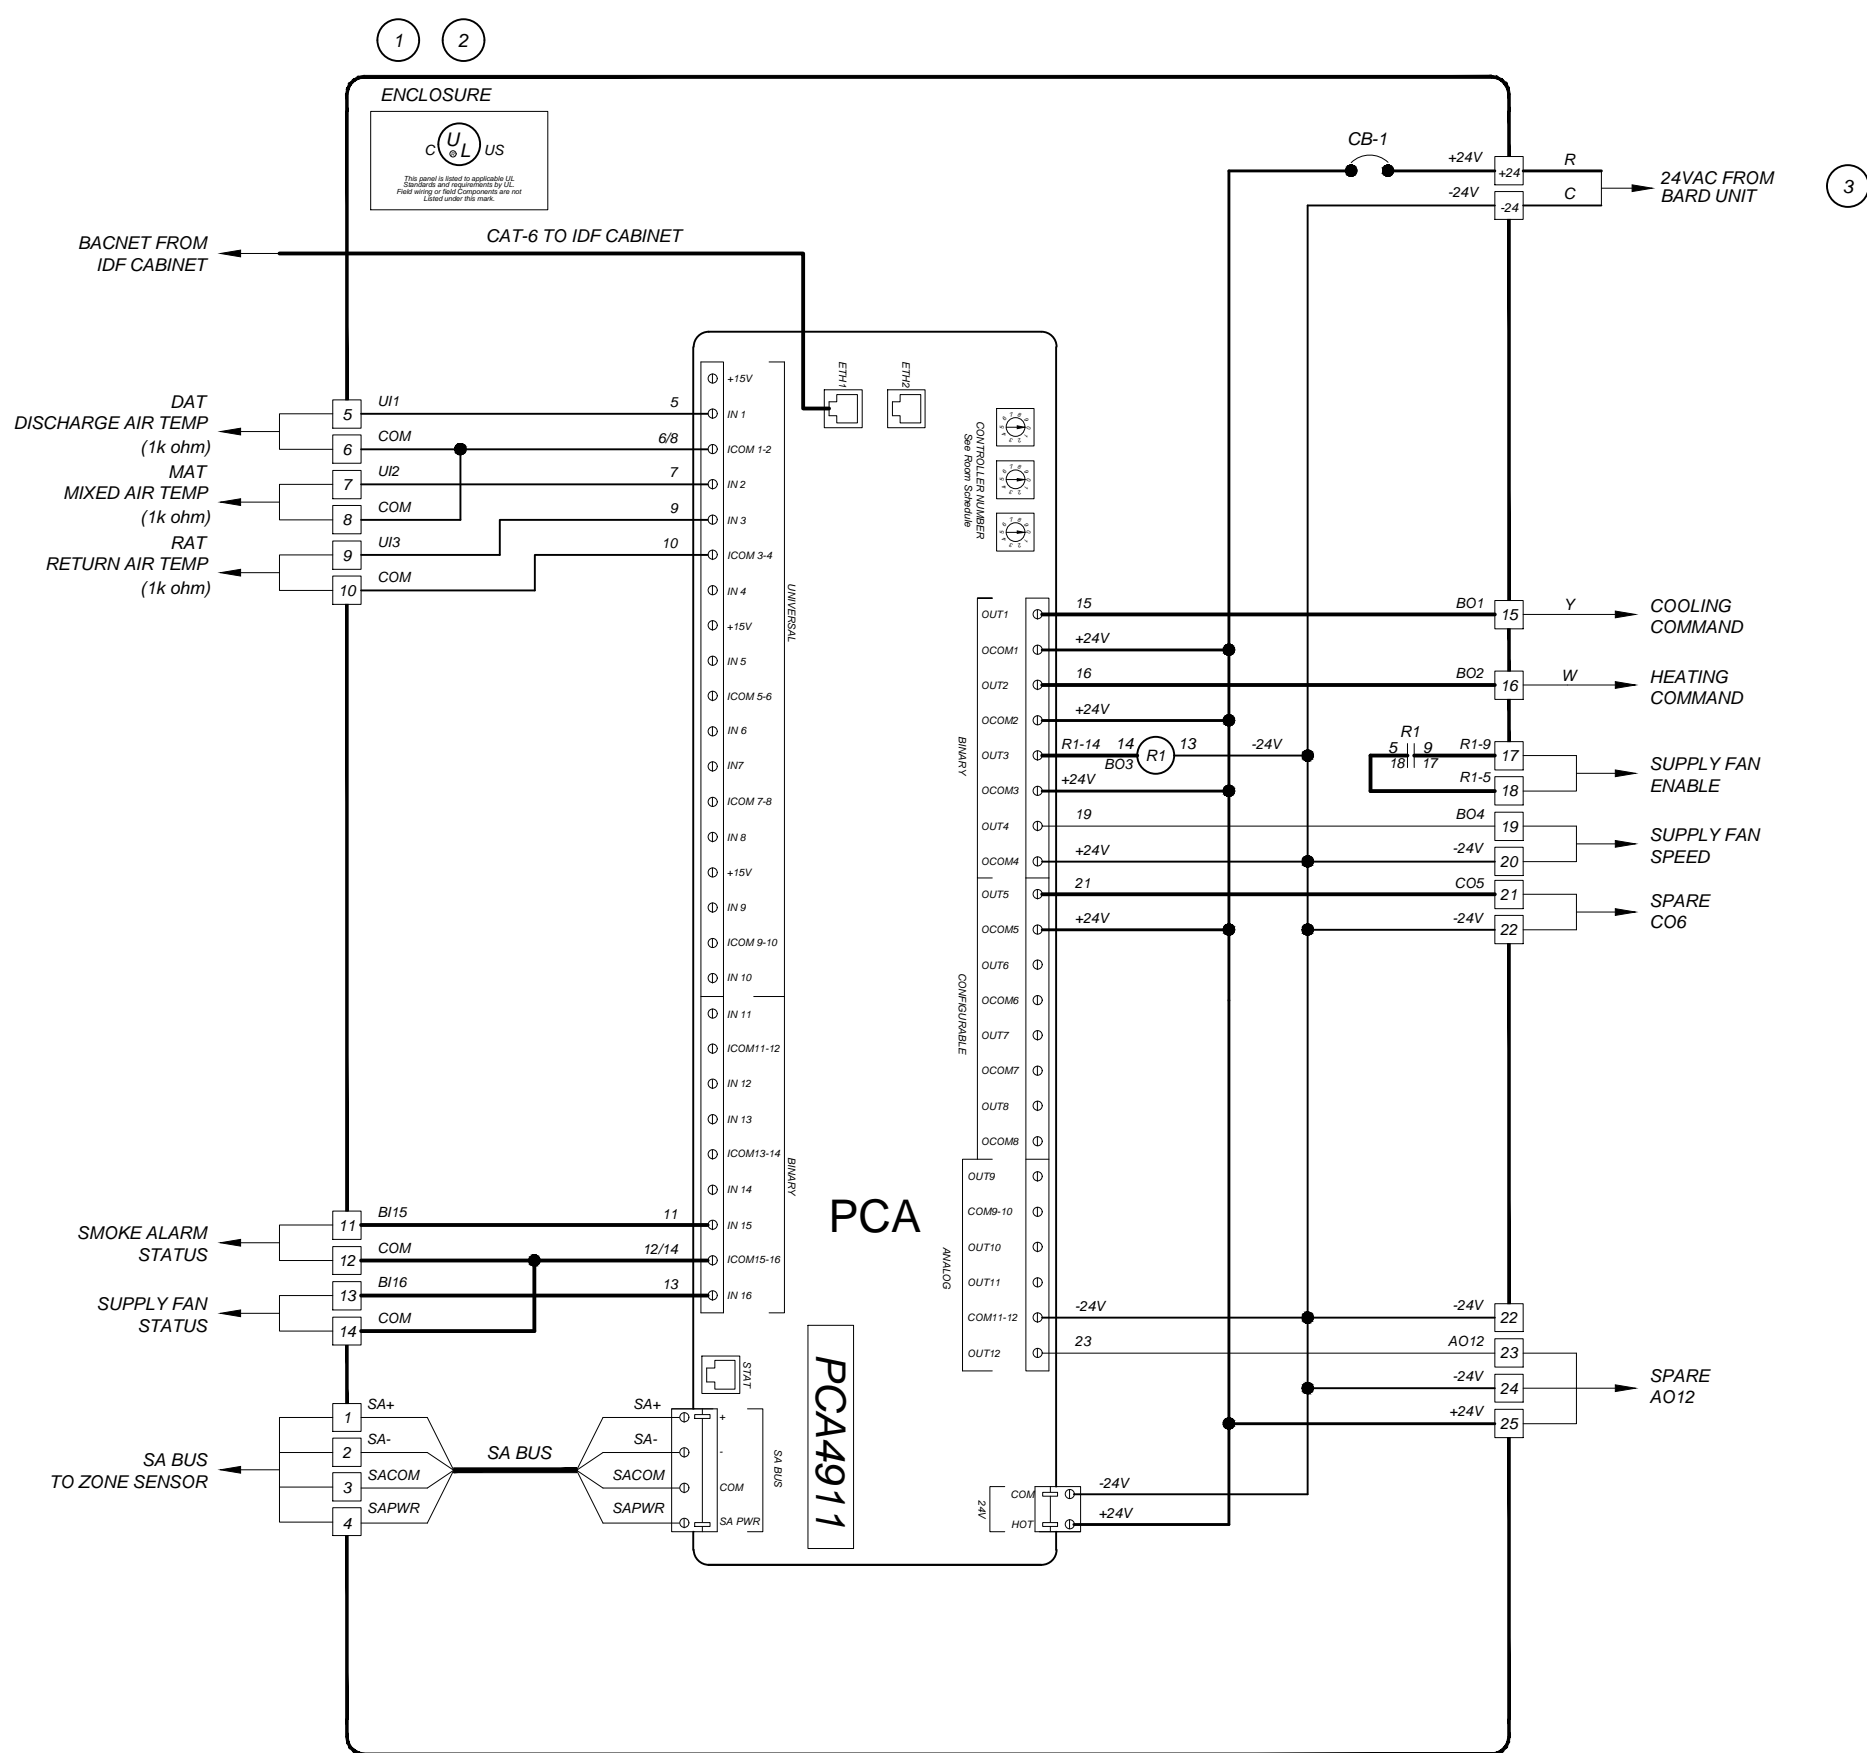

AIR HANDLER TCP SCHEMATIC DETAIL

D
M-8

Panel Components	
TAG	DESCRIPTION
PCG	GENERAL PROGRAMMABLE CONTROLLER
ENC	SEE SPEC'S FOR NEMA RATING
ENC	BACKPLATE ENCLOSURE
ENC	PANEL LOCK KIT
CB-1	2.0 AMP CIRCUIT BREAKER
R1	2-POLE 24VAC RELAY W/ LED
R1	2-POLE RELAY BASE

Sheet Notes	
1	CONTROL PANEL FABRICATED BY TOTAL CONTROL CONTACT DEVEN PUTNAM AT 559-291-1000
2	PANEL SHALL BE UL LISTED
3	LINE VOLTAGE & CONDUIT BY DIVISION 16.

Panel Components	
TAG	DESCRIPTION
PCA	ADVANCED PROGRAMMABLE CONTROLLER
ENC	SEE SPEC'S FOR NEMA RATING
ENC	BACKPLATE ENCLOSURE
ENC	PANEL LOCK KIT
CB-1	MANUAL RESET 2.0 AMP CIRCUIT BREAKER
R1	2-POLE 24VAC RELAY W/ LED
R1	2-POLE RELAY BASE

Detail Notes	
1	CONTROL PANEL FABRICATED BY TOTAL CONTROL CONTACT DEVEN PUTNAM AT 559-291-1000.
2	PANEL SHALL BE UL LISTED
3	LINE VOLTAGE & CONDUIT BY DIVISION 16.

APPROVALS:
APPLICATION #
777777777



DATE: 11-25-2020

EMS REPLACEMENT
ROWELL ELEMENTARY SCHOOL
3460 EAST MCKENZIE AVE. FRESNO, CA 93702
FRESNO UNIFIED SCHOOL DISTRICT
4600 N. BRAWLEY AVE. FRESNO, CA.

REVISIONS	
4/22/21	EMS REVISIONS
1	
2	
3	
4	


LAWRENCE
ENGINEERING GROUP
FRESNO, CA 93720
(559) 431-0101

TITLE:
ENERGY
MANAGEMENT
DETAILS

SHEET:
M8
PROJECT 20139

Control Components	
TAG	DESCRIPTION
DAT	DUCT TEMP SENSOR
SFCS, CCS	CURRENT SENSOR
NZS	NETWORK ZONE SENSOR WITH CO2
OAD	DAMPER ACTUATOR


Sheet Notes	
1	LINE VOLTAGE & CONDUIT BY DIVISION 16.
2	CONTROL COMPONENTS PROVIDED BY TOTAL CONTROL CONTACT DEVEN PUTNAM AT 559-291-1000
3	SEE DETAIL B/M-9 FOR TCP DIAGRAM.

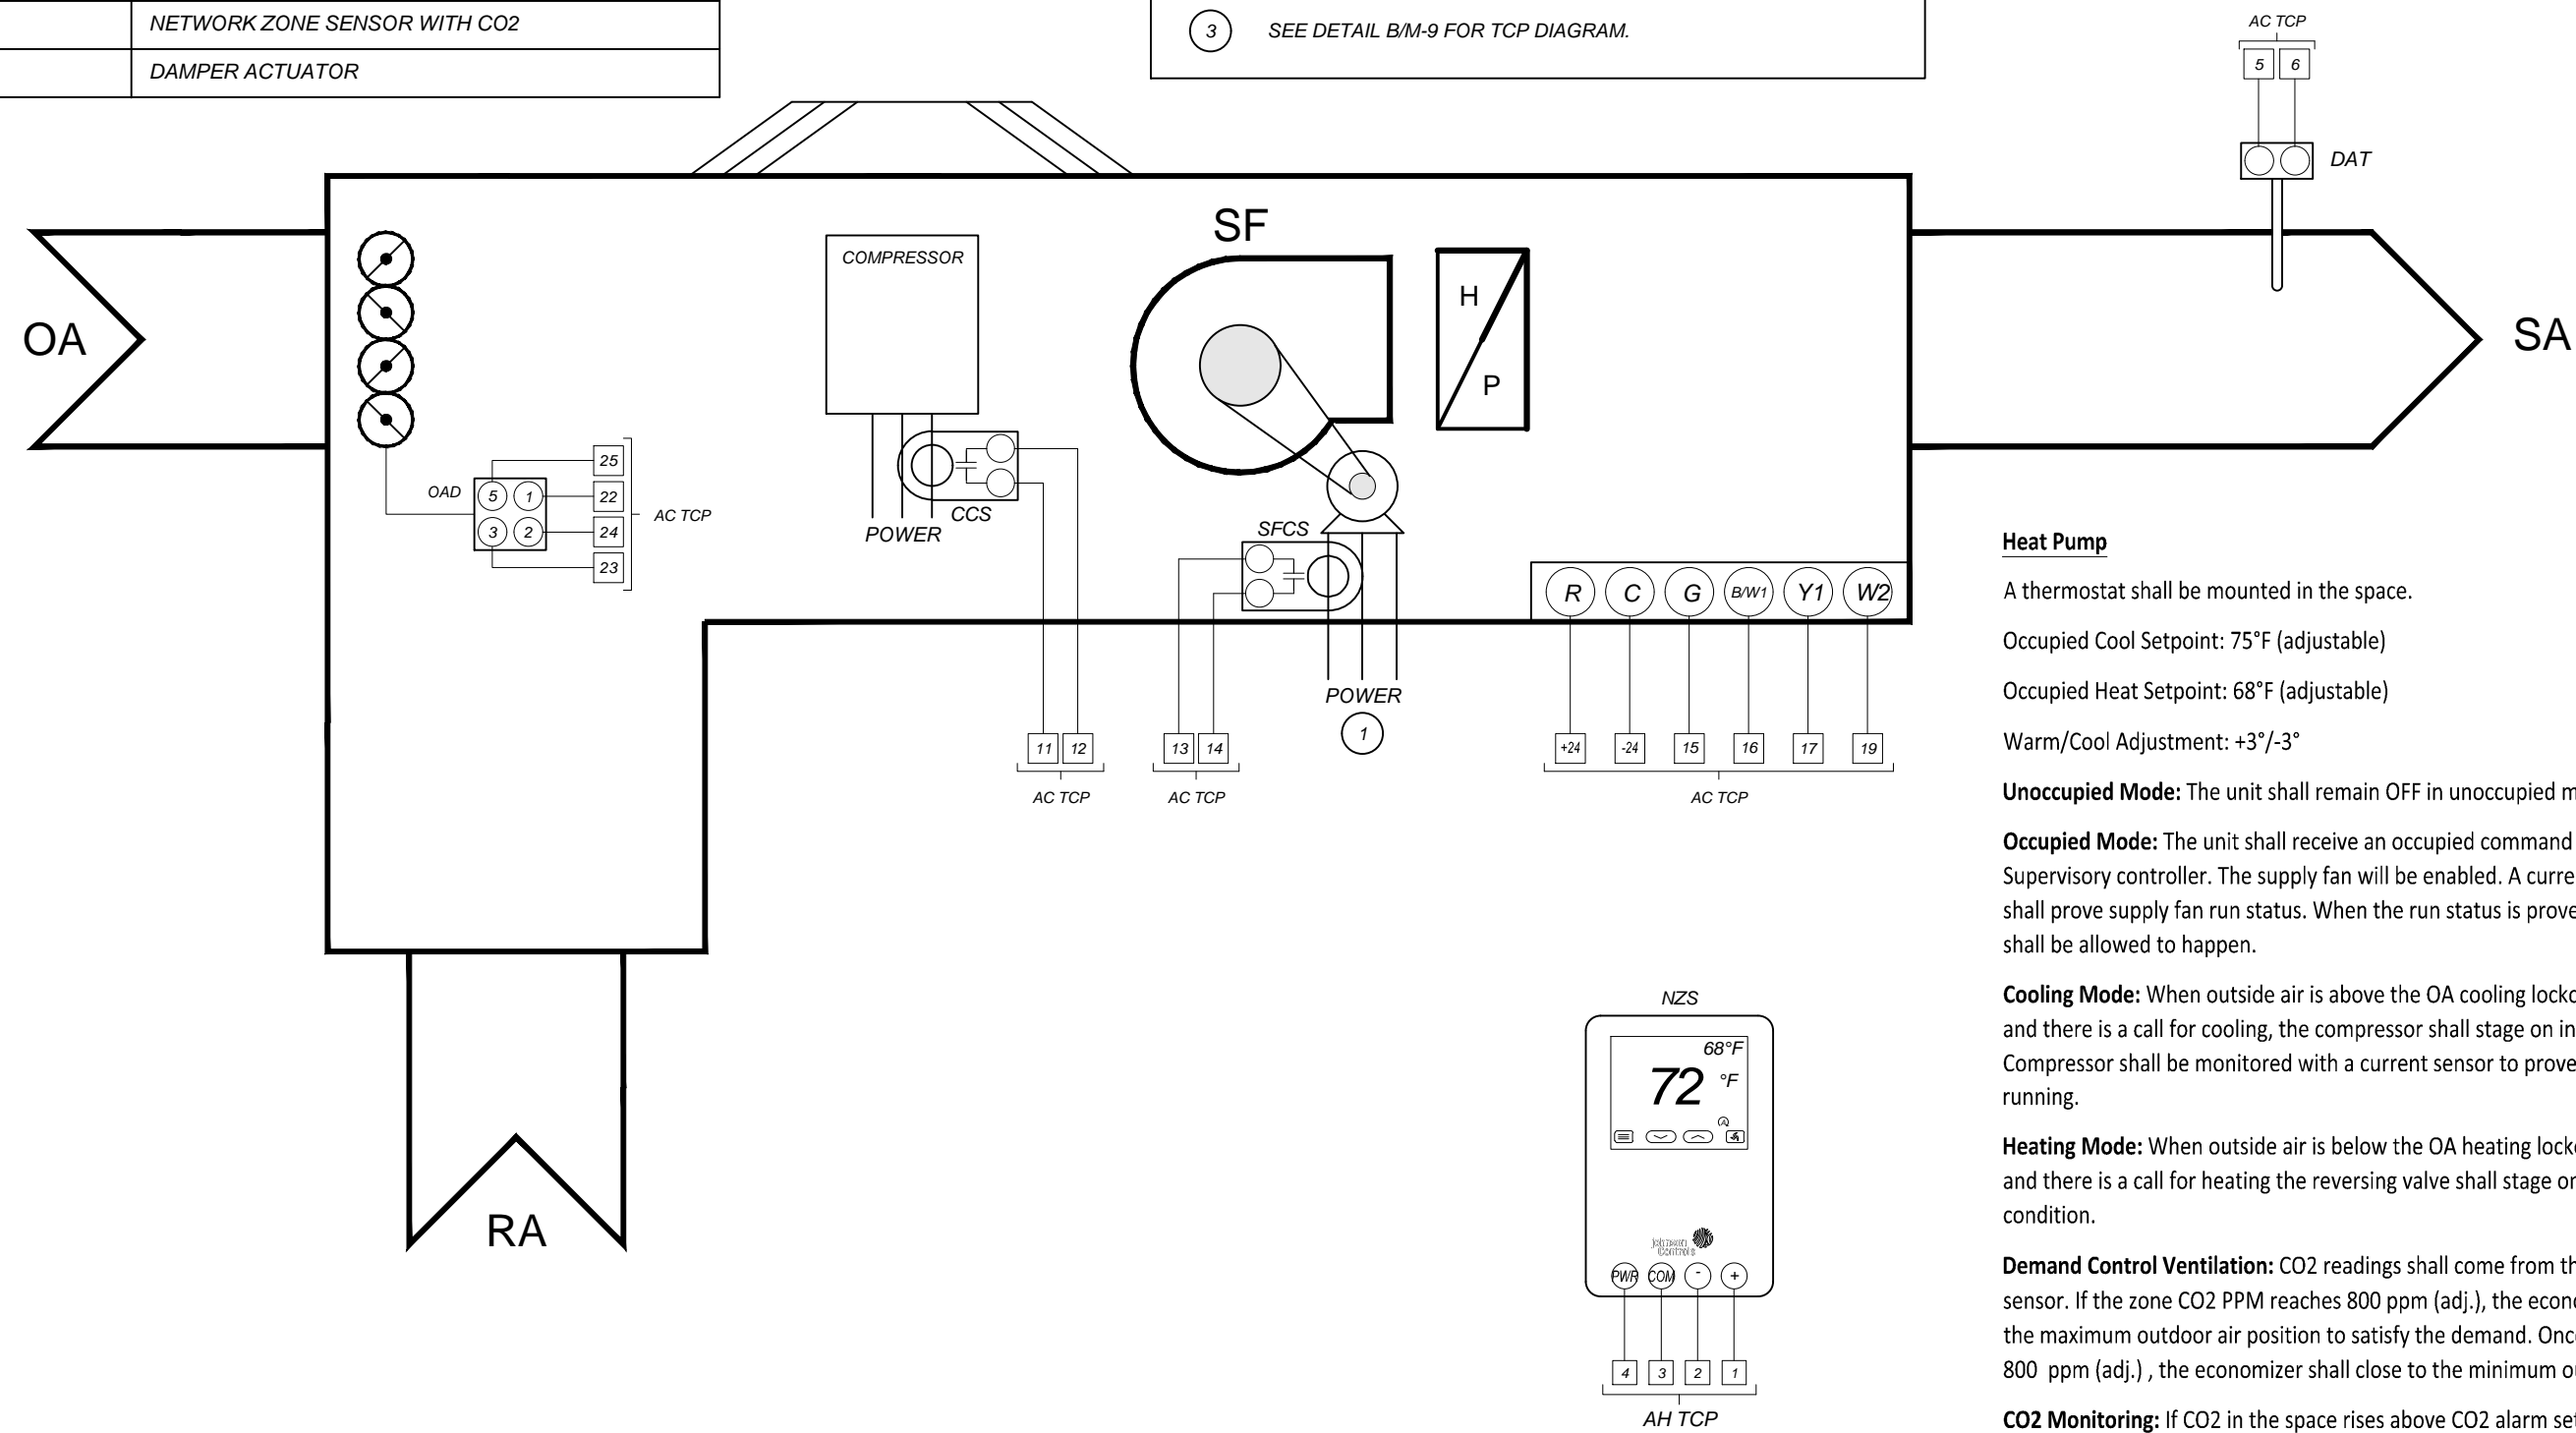

Heat Pump
A thermostat shall be mounted in the space.
Occupied Cool Setpoint: 75°F (adjustable)
Occupied Heat Setpoint: 68°F (adjustable)
Warm/Cool Adjustment: +3°/-3°
Unoccupied Mode: The unit shall remain OFF in unoccupied mode.
Occupied Mode: The unit shall receive an occupied command from the Johnson FX Supervisory controller. The supply fan will be enabled. A current sensor on the supply fan shall prove supply fan run status. When the run status is proven ON, the following modes shall be allowed to happen.
Cooling Mode: When outside air is above the OA cooling lockout setpoint (65° F adjustable) and there is a call for cooling, the compressor shall stage on in order to satisfy the condition. Compressor shall be monitored with a current sensor to prove that the compressor is running.
Heating Mode: When outside air is below the OA heating lockout setpoint (60° F adjustable) and there is a call for heating the reversing valve shall stage on in order to satisfy the condition.
Demand Control Ventilation: CO2 readings shall come from the wall mount Temp/CO2 sensor. If the zone CO2 PPM reaches 800 ppm (adj.), the economizer shall modulate open to the maximum outdoor air position to satisfy the demand. Once the CO2 level drops below 800 ppm (adj.), the economizer shall close to the minimum outdoor air position.
CO2 Monitoring: If CO2 in the space rises above CO2 alarm setpoint (adj.), the system will generate a Niagara alarm.


WALL MOUNTED HEAT PUMP UNIT CONTROL DETAIL

A
M-9

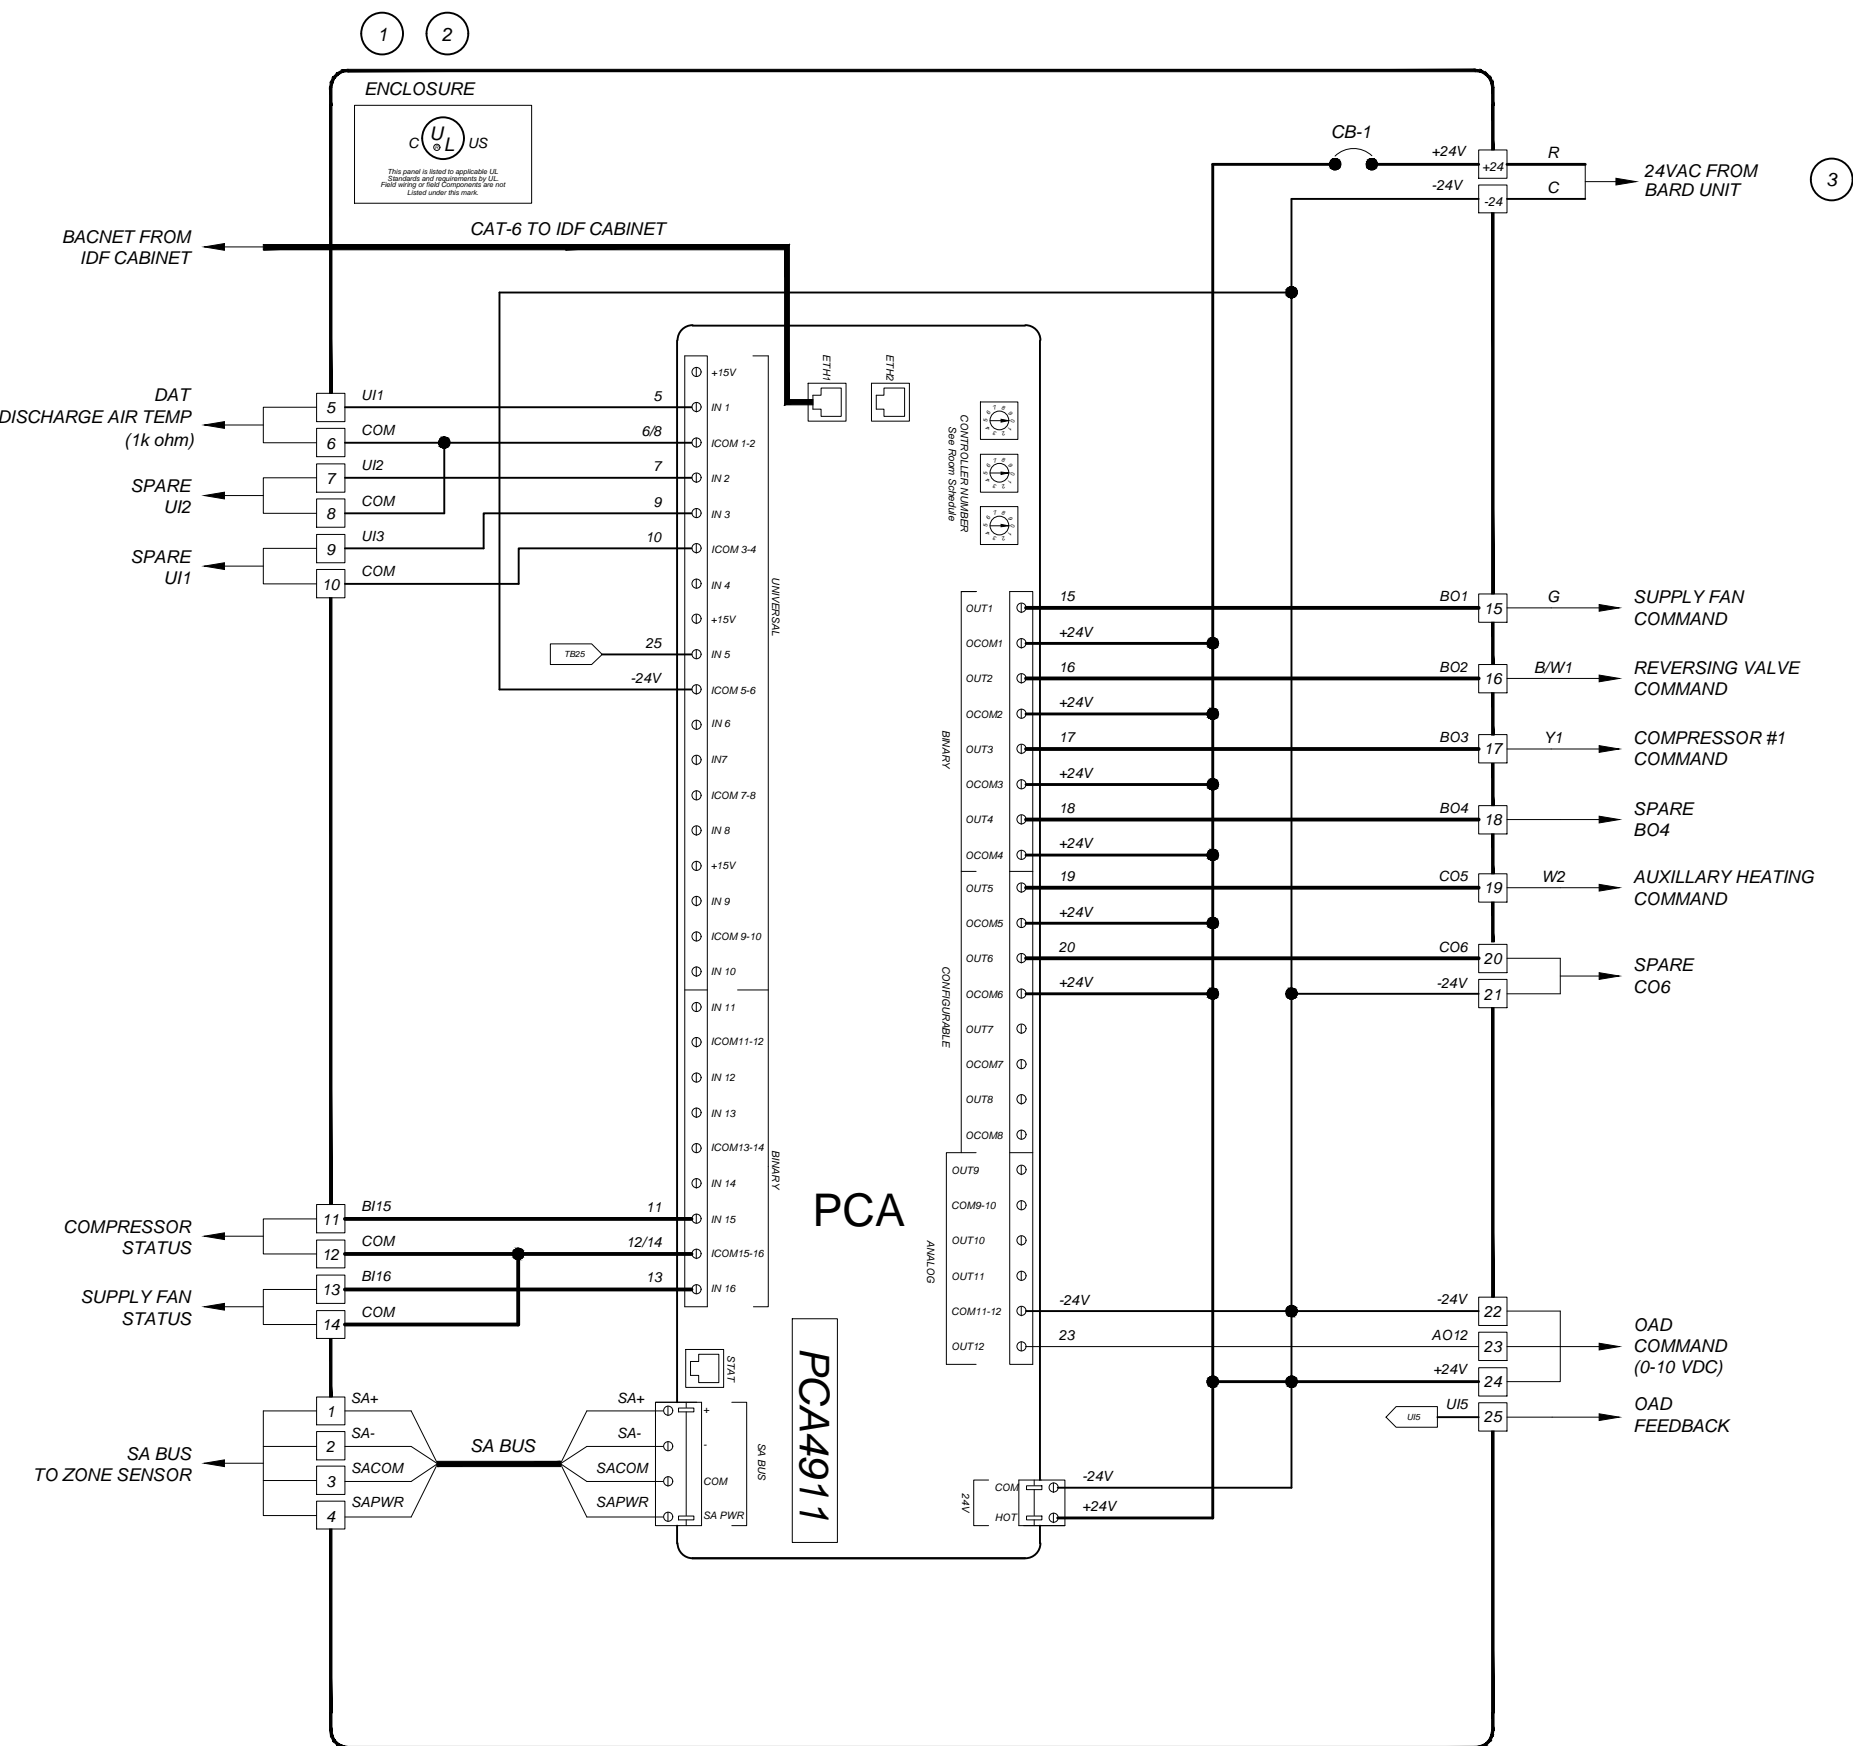

Panel Components	
TAG	DESCRIPTION
PCA	ADVANCED PROGRAMMABLE CONTROLLER
CB-1	MANUAL RESET 2.0 AMP CIRCUIT BREAKER
ENC	SEE SPECS FOR NEMA RATING
ENC	BACKPLATE ENCLOSURE
ENC	PANEL LOCK KIT
TCP	TCP LABEL


Sheet Notes	
1	CONTROL PANEL FABRICATED BY TOTAL CONTROL CONTACT DEVEN PUTNAM AT 559-291-1000.
2	PANEL SHALL BE UL LISTED
3	LINE VOLTAGE & CONDUIT BY DIVISION 16.

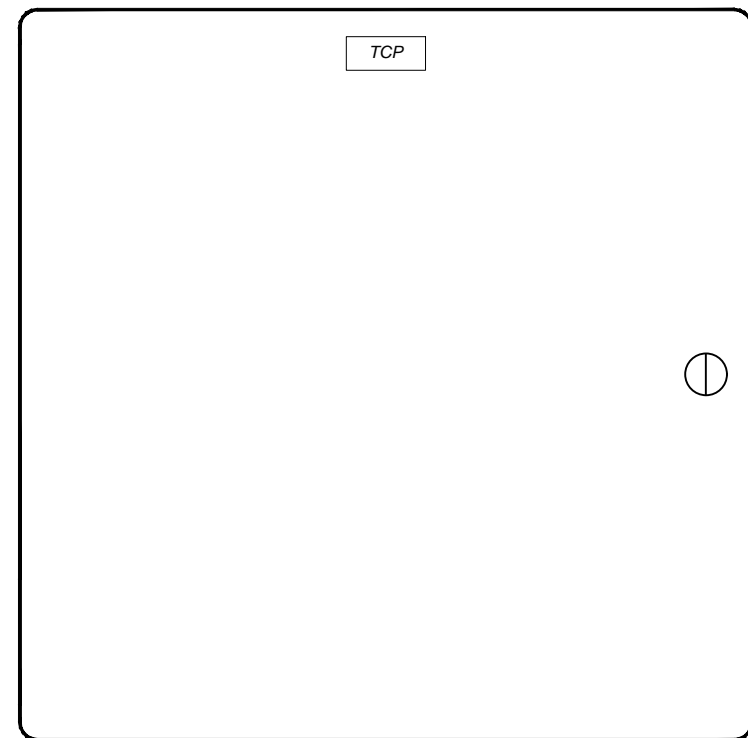

PANEL DOOR LAYOUT

B
M-9


WALL MOUNTED HEAT PUMP TCP SCHEMATIC DETAIL

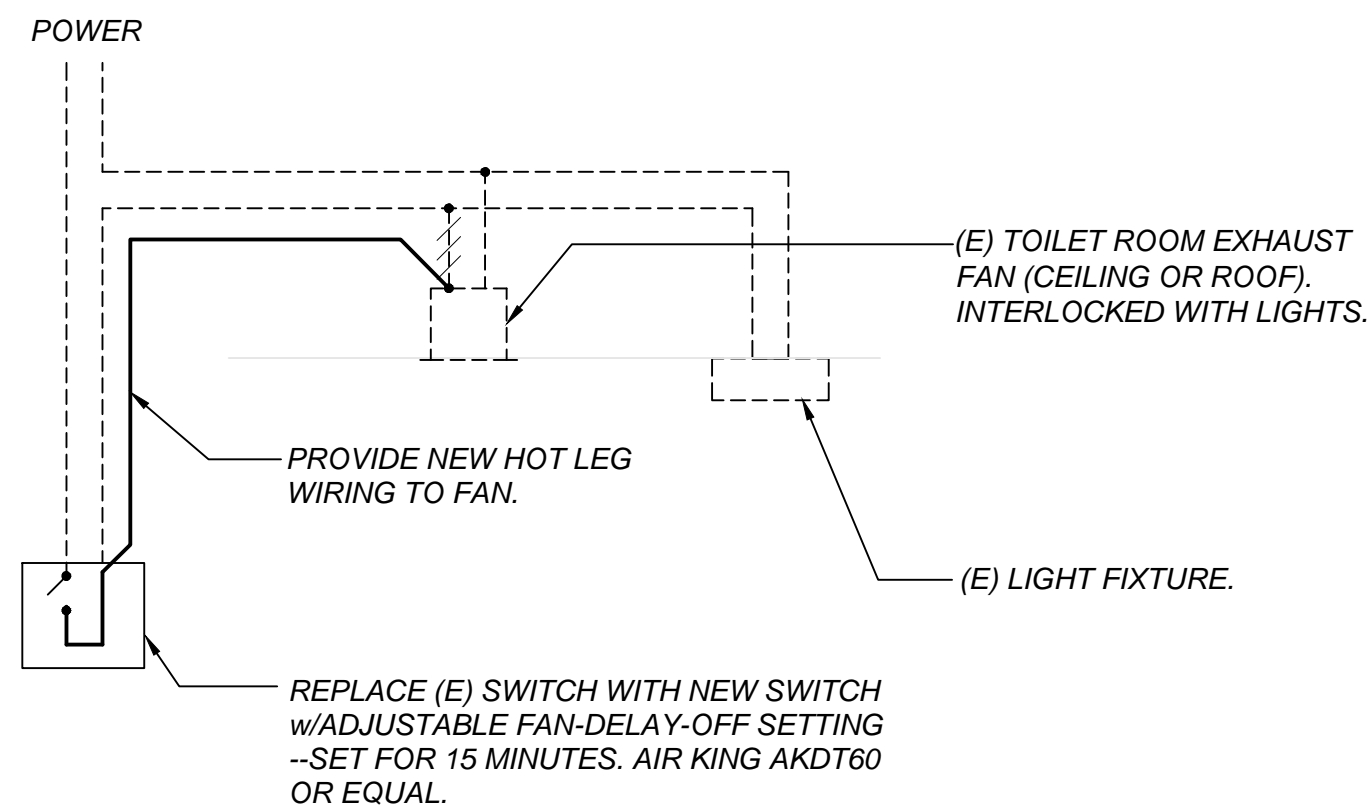

LIGHT / EXHAUST TIMER SWITCH

SCALE: NONE


C
M-9

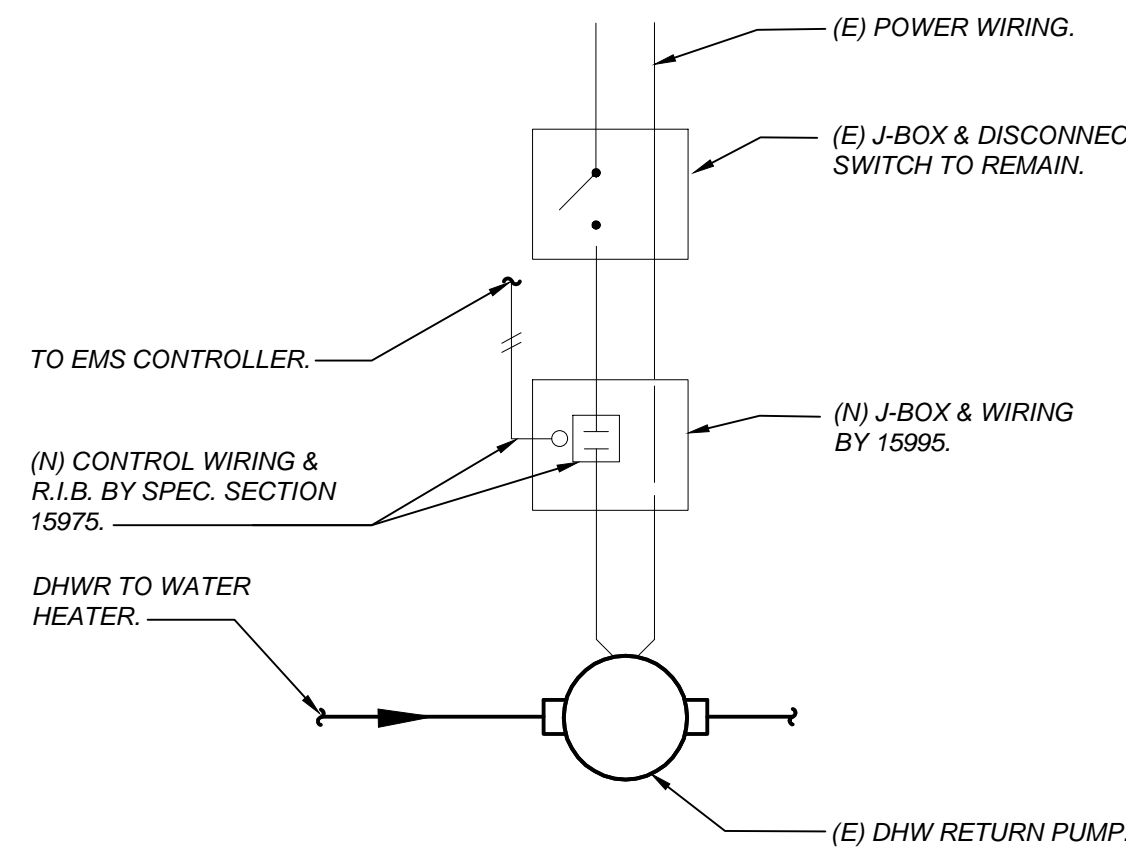

DOMESTIC H.W.R. PUMP CONTROL

SCALE: NONE


D
M-9

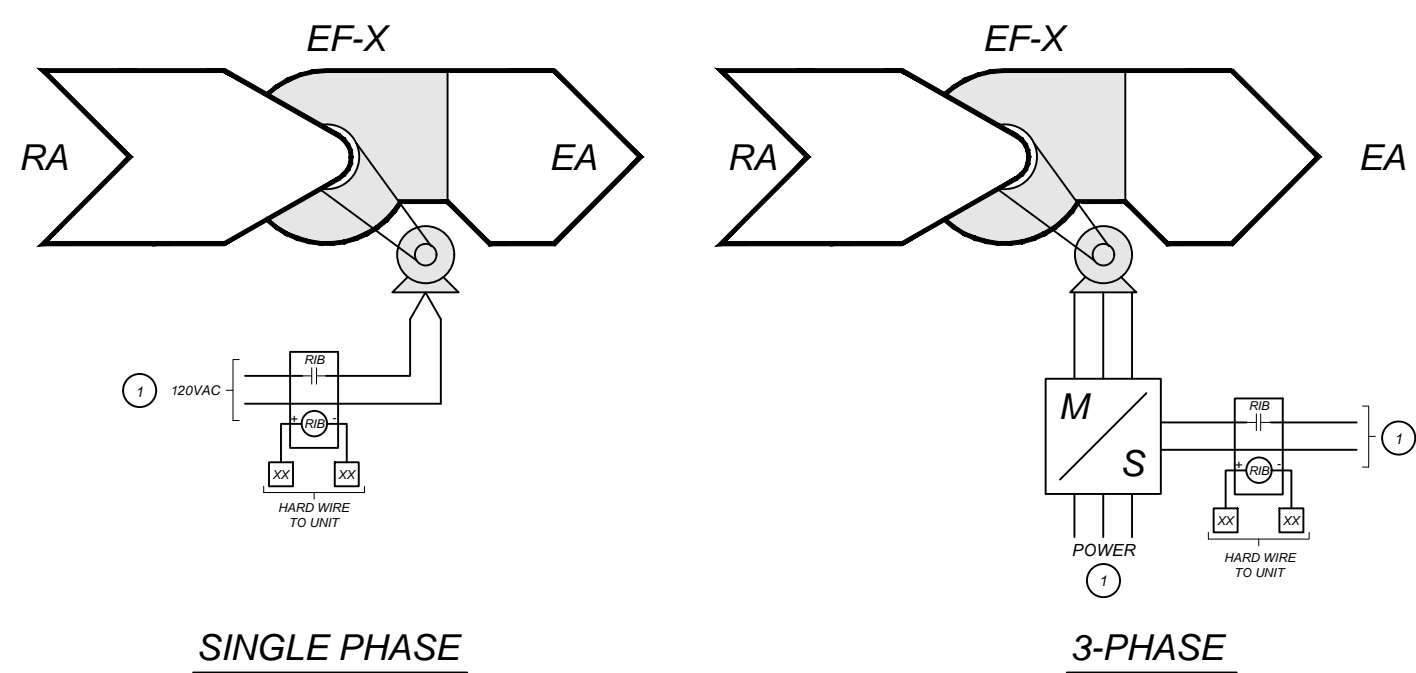

EXHAUST FAN INTERLOCK CONTROL

SCALE: NONE

E
M-9

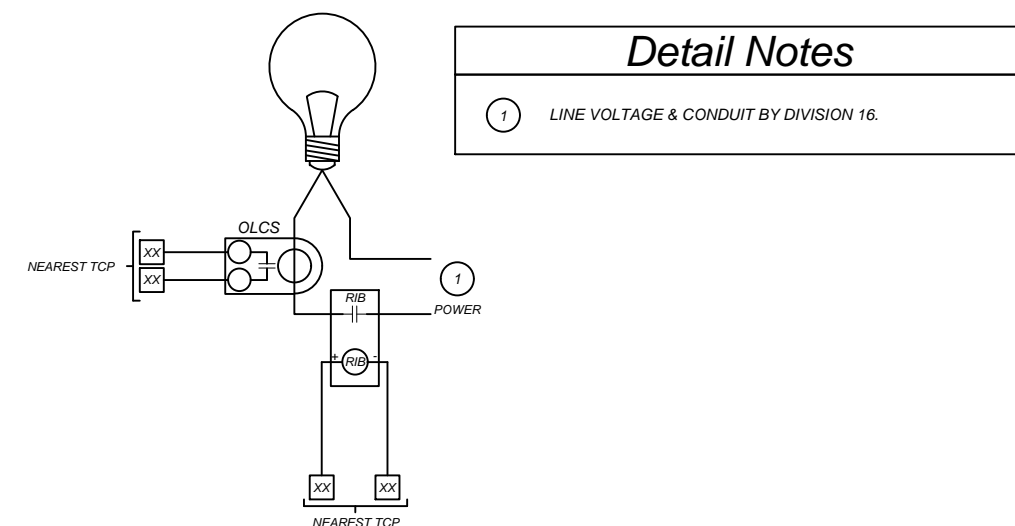


LIGHTING CONTROL

EXTERIOR LIGHTING CONTROL DETAIL

SCALE: NONE

F
M-9

APPROVALS:
APPLICATION #
77777777

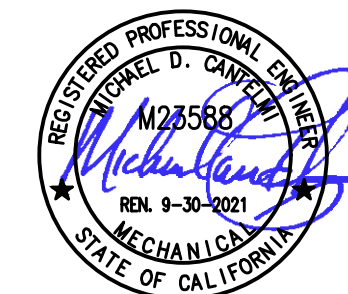

DATE: 11-25-2020


EMS REPLACEMENT
ROWELL ELEMENTARY SCHOOL
3460 EAST MCKENZIE AVE. FRESNO, CA 93702
FRESNO UNIFIED SCHOOL DISTRICT
4600 N. BRAWLEY AVE. FRESNO, CA.

REVISIONS	
4/22/21	EMS REVISIONS
1	
2	
3	
4	
5	

LAWRENCE
ENGINEERING GROUP
Fresno, CA 93720
7084 N. Maple Ave., Suite 101
(559) 431-0101
FAX (559) 431-1362

TITLE:
ENERGY
MANAGEMENT
DETAILS

SHEET:
M9
PROJECT 20139

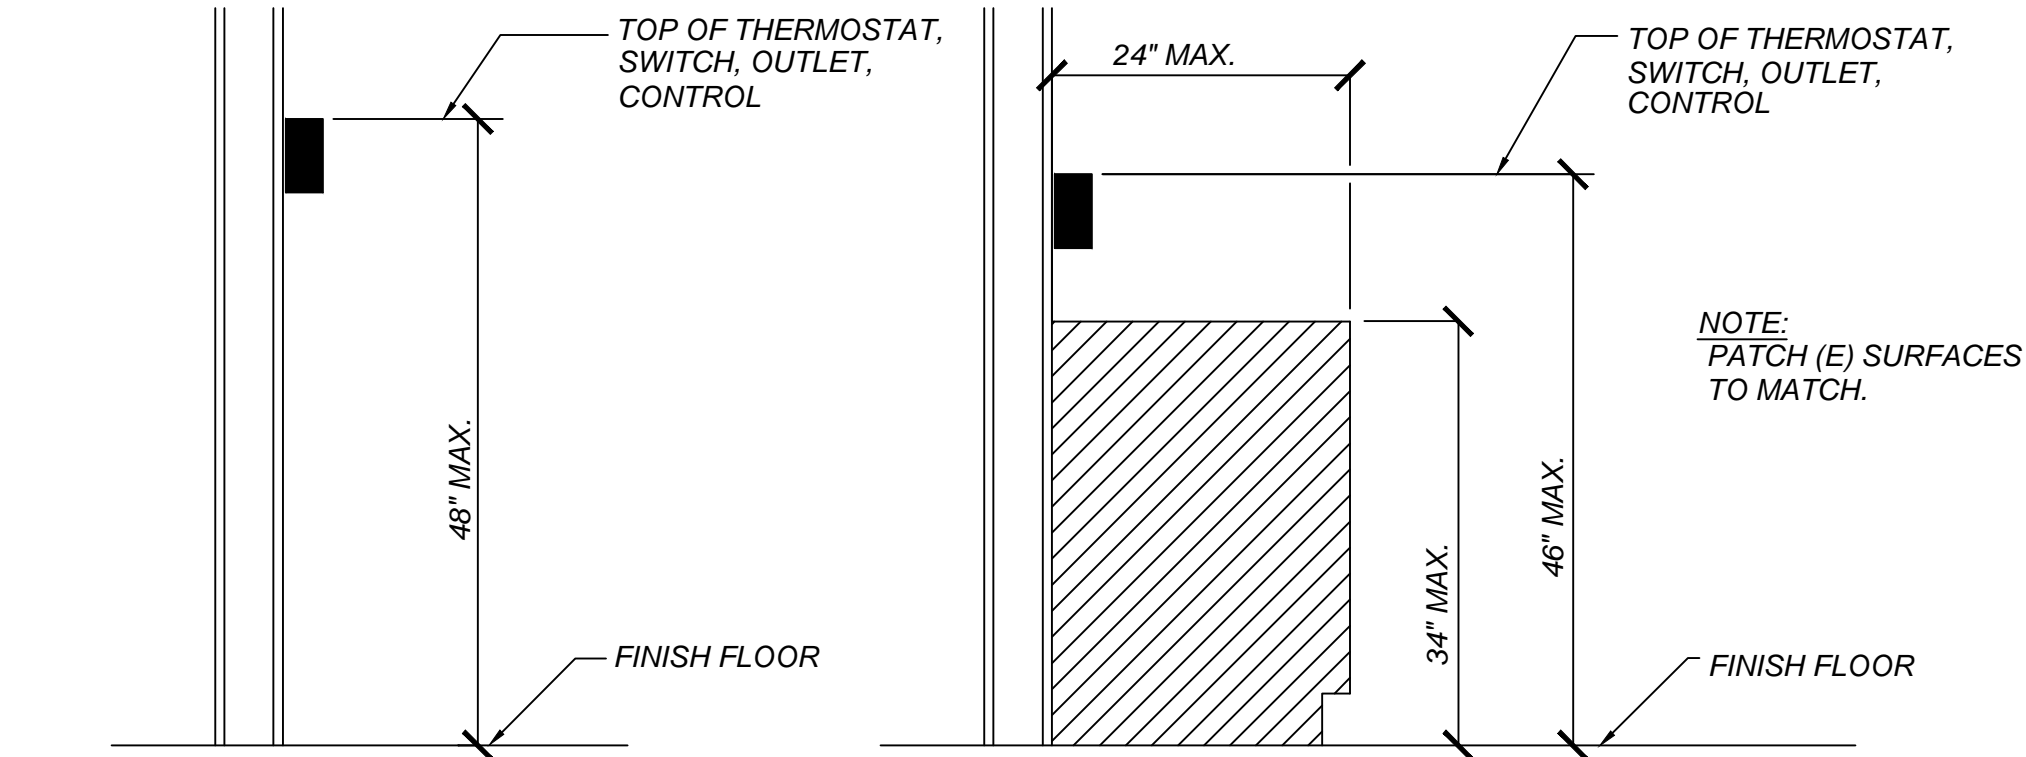


MOUNTING HEIGHT OVER OBSTRUCTION

THERMOSTAT MOUNTING

SCALE: NONE

A
M-10

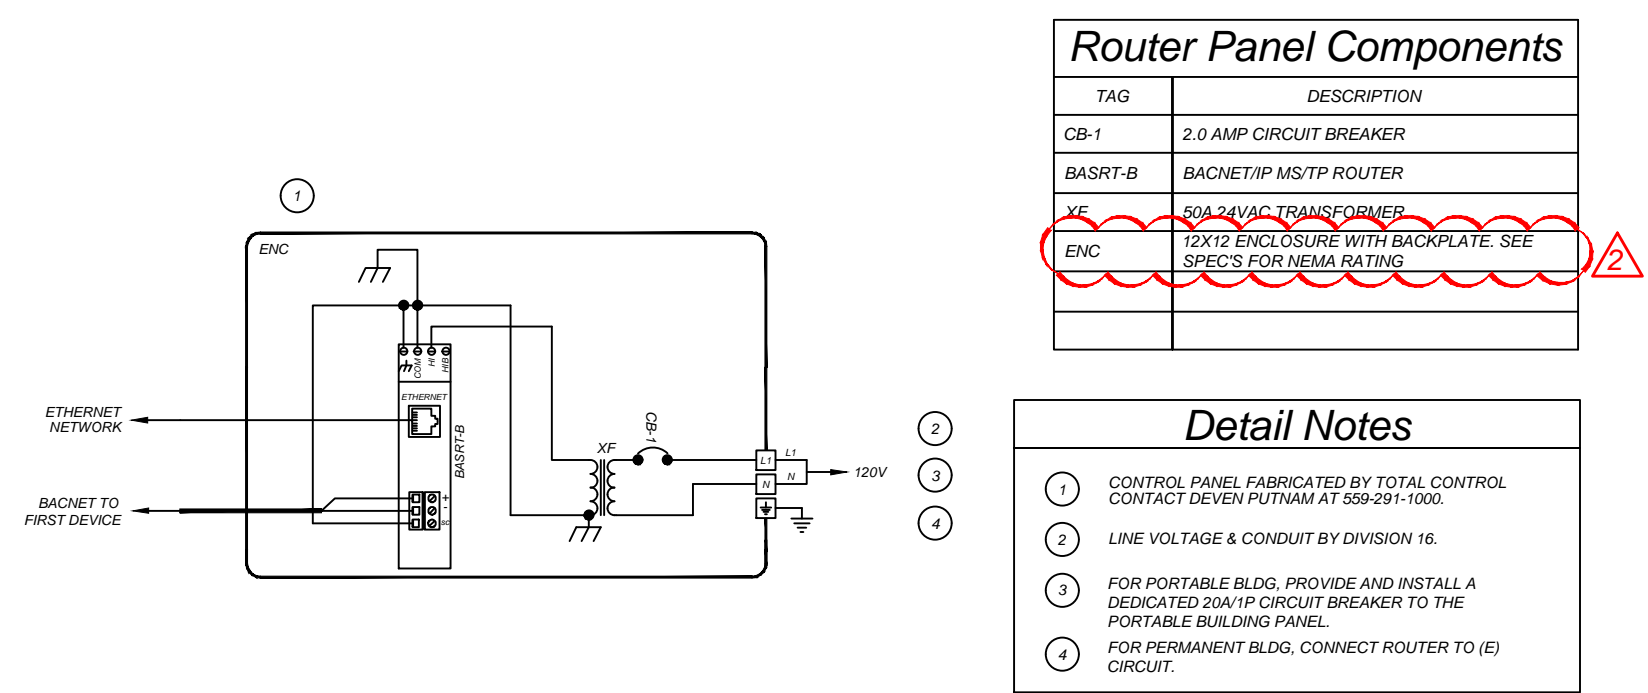

BACNET/IP MS/TP ROUTER PANEL DETAIL

SCALE: NONE

B
M-10

APPROVALS:
APPLICATION #
????????



DATE: 11-25-2020


EMS REPLACEMENT
ROWELL ELEMENTARY SCHOOL
3460 EAST MCKENZIE AVE. FRESNO, CA 93702
FRESNO UNIFIED SCHOOL DISTRICT
4600 N. BRAWLEY AVE. FRESNO, CA.

REVISIONS					
4/22/21	EMS REVISIONS				



TITLE:
ENERGY
MANAGEMENT
DETAILS

SHEET:
M10
PROJECT 20139

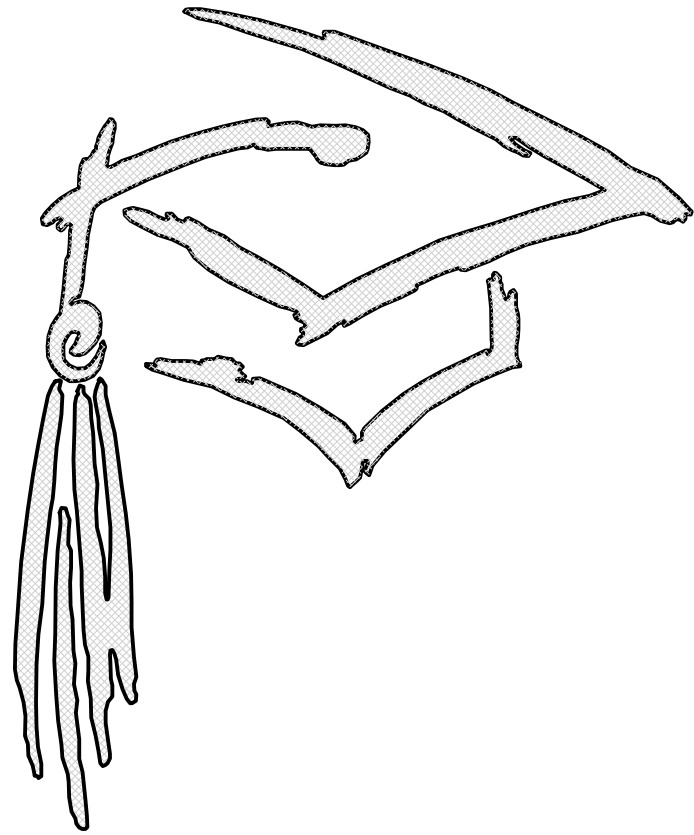

FRESNO UNIFIED SCHOOL DISTRICT

BURROUGHS ELEMENTARY SCHOOL

EMS REPLACEMENT

166 N. SIERRA VISTA AVE.
FRESNO, CALIFORNIA 93702

OWNER
FRESNO UNIFIED SCHOOL DISTRICT

4600 N. BRAWLEY AVE.
FRESNO, CA 93722
(559) 457-3064

CONTACT: DANNY ANDERSON

MECHANICAL ENGINEER
LAWRENCE ENGINEERING GROUP

7084 NORTH MAPLE AVE. SUITE 101
FRESNO, CA 93720
(559) 431-0101

CONTACT: MIKE CANTelmi

ELECTRICAL ENGINEER
HARDIN-DAVIDSON ENGINEERING, INC.
356 POLLASKY AVE. SUITE 200
CLOVIS, CA 93612
(559) 323-4965

CONTACT: RICH HARDIN

GENERAL NOTES:


- ALL WORK SHALL CONFORM TO 2019 EDITION TITLE 24, CALIFORNIA CODE OF REGULATIONS (CCR).
- CHANGE TO THE APPROVED DRAWINGS AND SPECIFICATIONS SHALL BE MADE BY ADDENDA OR CONSTRUCTION CHANGE DOCUMENT (CCD) APPROVED BY DSA, AS REQUIRED BY SECTION 4-338, PART 1, TITLE 24, CCR.
- A "DSA CERTIFIED" PROJECT INSPECTOR EMPLOYED BY THE DISTRICT (OWNER) AND APPROVED BY DSA SHALL PROVIDE CONTINUOUS INSPECTION OF THE WORK. THE DUTIES OF THE INSPECTOR ARE DEFINED IN SECTION 4-342, PART 1, TITLE 24, CCR. PROJECT REQUIRES A CLASS 3 INSPECTOR.
- A DSA ACCEPTED TESTING LABORATORY DIRECTLY EMPLOYED BY THE DISTRICT (OWNER) SHALL CONDUCT ALL THE REQUIRED TESTS AND INSPECTIONS FOR THE PROJECT.
- THE INTENT OF THESE DRAWINGS AND SPECIFICATIONS IS THAT THE WORK OF THE ALTERATION, REHABILITATION OR RECONSTRUCTION IS TO BE IN ACCORDANCE WITH TITLE 24, CCR. SHOULD ANY EXISTING CONDITIONS SUCH AS DETERIORATION OR NON-COMPLYING CONSTRUCTION BE DISCOVERED WHICH IS NOT COVERED BY THE CONTRACT DOCUMENTS WHEREIN THE FINISHED WORK WILL NOT COMPLY WITH TITLE 24, CCR, A CONSTRUCTION CHANGE DOCUMENT (CCD), OR A SEPARATE SET OF PLANS AND SPECIFICATIONS, DETAILING AND SPECIFYING THE REQUIRED WORK SHALL SUBMITTED TO AND APPROVED BY DSA BEFORE PROCEEDING WITH THE WORK. (SECTION 4-317(C), PART 1, TITLE 24, CCR)

PROJECT NOTES:

- PROVIDE ALL NEW CONTROL WIRE.
- PROVIDE ALL NEW ACTUATORS. RETURN EXISTING ACTUATORS TO DISTRICT.
- PROVIDE A NEW OUTSIDE AIR TEMPERATURE SENSOR AT EACH MULTI-ZONE.
- PROVIDE NEW CONTROLS FOR ALL EXHAUST FANS.
- PROVIDE NEW CONTROLS FOR EXTERIOR LIGHTING. REFER TO FLOOR PLAN SHEETS. MOUNT HARDWARE IN NEW LOCKABLE ENCLOSURES.
- PROGRAMMING SHALL BE IN THE CONTROLLERS AT THE UNIT, NOT THE FRONT END. THE FRONT END IS A MONITORING STATUS, ON-OFF DEVICE ONLY.
- WIRING IN ATTICS SHALL BE SUPPORTED ON J-HOOKS. NO WIRING ON ROOF.
- SALVAGE ALL CONTROL EQUIPMENT AND RETURN TO OWNER.
- PROVIDE AND INSTALL A 20A/1P, DUPLEX RECEPTACLE WITH CIRCUIT AND CIRCUIT BREAKER FROM THE NEAREST 120 VOLT PANEL IS 80-FEET AWAY FIELD LOCATE. PROVIDE POWER CONNECTIONS TO EACH ENERGY MANAGEMENT RIB. REFER TO MECHANICAL/EMS PLANS FOR EQUIPMENT LOCATIONS.
- CONTRACTOR MAY REUSE (E) CONTROLLER ENCLOSURE WHERE FEASIBLE.

APPLICABLE CODES

2019 California Administrative Code - CCR Title 24, Part 1
2019 California Building Code - CCR Title 24, Part 2
2019 California Electrical Code - CCR Title 24, Part 3
2019 California Mechanical Code - CCR Title 24, Part 4
2019 California Plumbing Code - CCR Title 24, Part 5
2019 California Energy Code - CCR Title 24, Part 6
2019 California Fire Code - CCR Title 24, Part 9
2019 Existing Building Code - CCR Title 24, Part 10
2019 California Green Code - CCR Title 24, Part 11
2019 California Reference Code - CCR Title 24, Part 12
Title 19 CCR Public Safety, State Fire Marshall Regulations
2019 NFPA 72 for Fire Alarm System.
CFC CH 33 Fire Safety During Construction and Demolition

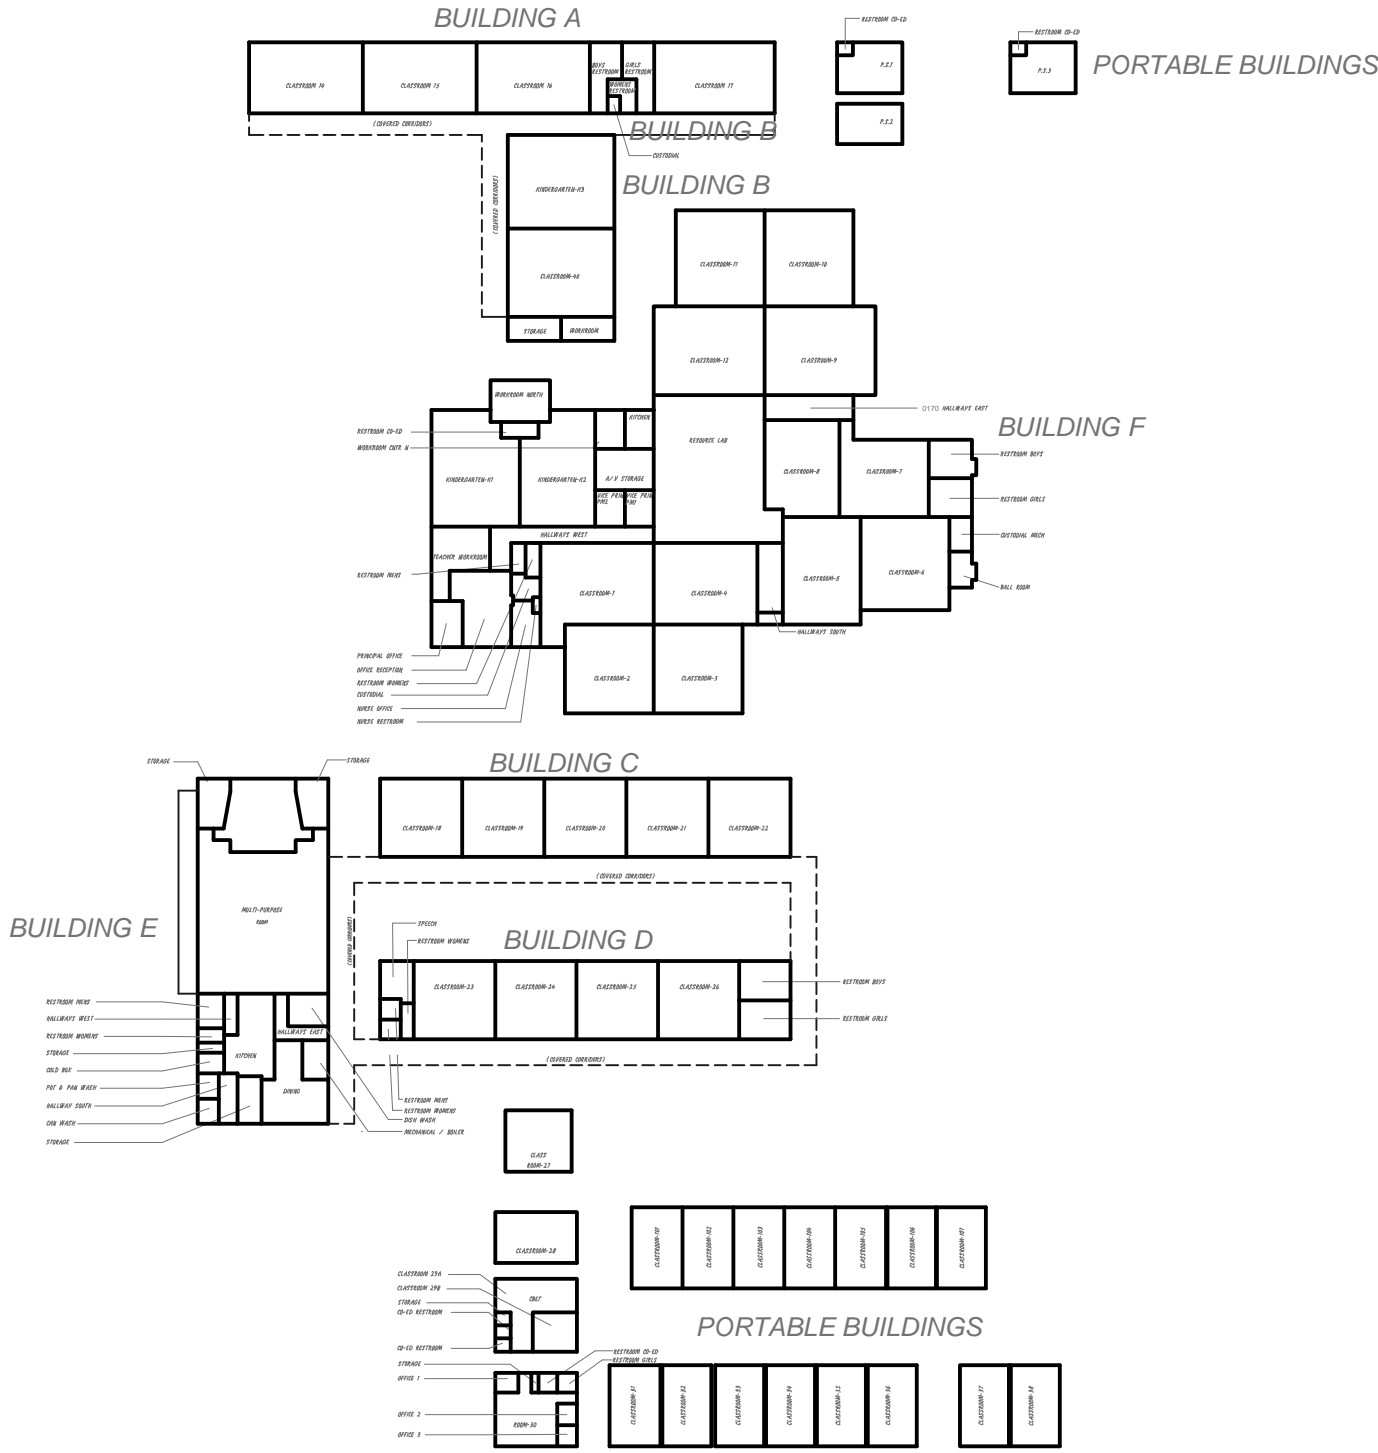

BLDG SITE PLAN

SCALE: 1" = 40'-0"

SHEET INDEX

MECHANICAL	SHEET COUNT
G1 COVER SHEET	1
M1 BLDG A & B EMS PLAN	2
M2 BLDG F EMS PLAN	3
M3 BLDG C, D, & E EMS PLAN	4
M4 PORTABLE BUILDINGS	5
M5 ENERGY MANAGEMENT DETAILS	6
M6 ENERGY MANAGEMENT DETAILS	7
M7 ENERGY MANAGEMENT DETAILS	8
M8 ENERGY MANAGEMENT DETAILS	9
M9 ENERGY MANAGEMENT DETAILS	10

ELECTRICAL

E-1 ELECTRICAL SYMBOLS AND NOTES	11
E-2 ELECTRICAL PLANS	12

SHEET COUNT TOTAL:


13

SCOPE OF WORK

THE SCOPE OF WORK IS AS INDICATED BY THE CONTRACT DRAWINGS AND SPECIFICATION AND IS SUMMARIZED AS FOLLOWS:

- REPLACE EXISTING DDC CONTROLS w/(N) JOHNSON CONTROLS FX-80
- REPLACE AND UP SIZE EXISTING MULTI-ZONE UNIT SUPPLY AND RETURN / EXHAUST FAN WITH NEW MOTOR & VFD. SEE PLANS FOR SIZE & ELECTRICAL DRAWINGS.
- PROVIDE AN EXISTING CONDITION DUCT TRAVERSE FOR EACH SUPPLY ZONE, OUTSIDE AIR, & RETURN AIR ON MULTI-ZONE UNIT MZU-1, MZU-2, MZU-3 AND MZU-4 PRIOR TO START OF WORK AND ALSO UPON PROJECT COMPLETION.

APPROVALS:
APPLICATION #
77777777

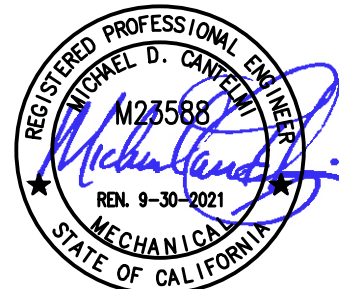

DATE: 11-25-2020


EMS REPLACEMENT
BURROUGHS ELEMENTARY SCHOOL
166 N SIERRA VISTA AVE. FRESNO, CA 93702
FRESNO UNIFIED SCHOOL DISTRICT
4600 N. BRAWLEY AVE. FRESNO, CA.

REVISIONS
4/22/21 EMS REVISIONS

LAWRENCE
ENGINEERING GROUP
FRESNO, CA 93720
(559) 431-1362
FAX (559) 431-1362
7084 N. Maple Ave., Suite 101
(559) 431-0101

TITLE: COVER

SHEET: G1
PROJECT: 20140

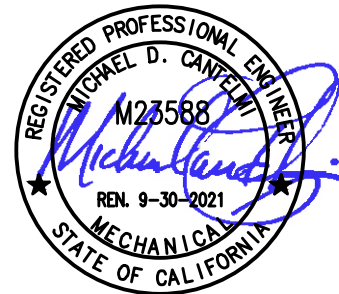



EMS REPLACEMENT
BURROUGHS ELEMENTARY SCHOOL
166 N SIERRA VISTA AVE. FRESNO, CA 93702
FRESNO UNIFIED SCHOOL DISTRICT
4600 N. BRAWLEY AVE. FRESNO, CA.

REVISIONS	4/22/21 EMS REVISIONS	
	DESCRIPTION	DATE
1		
2		
3		
4		
5		


LAWRENCE
ENGINEERING GROUP
Fresno, CA 93720
(559) 431-0101
7084 N. Maple Ave., Suite 101
FAX (559) 431-1362

TITLE:
BLDG A & BLDG B
EMS
PLAN

SHEET:
M1
PROJECT 20140

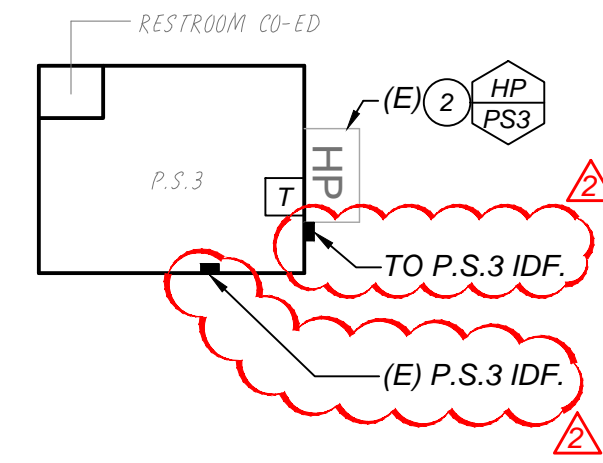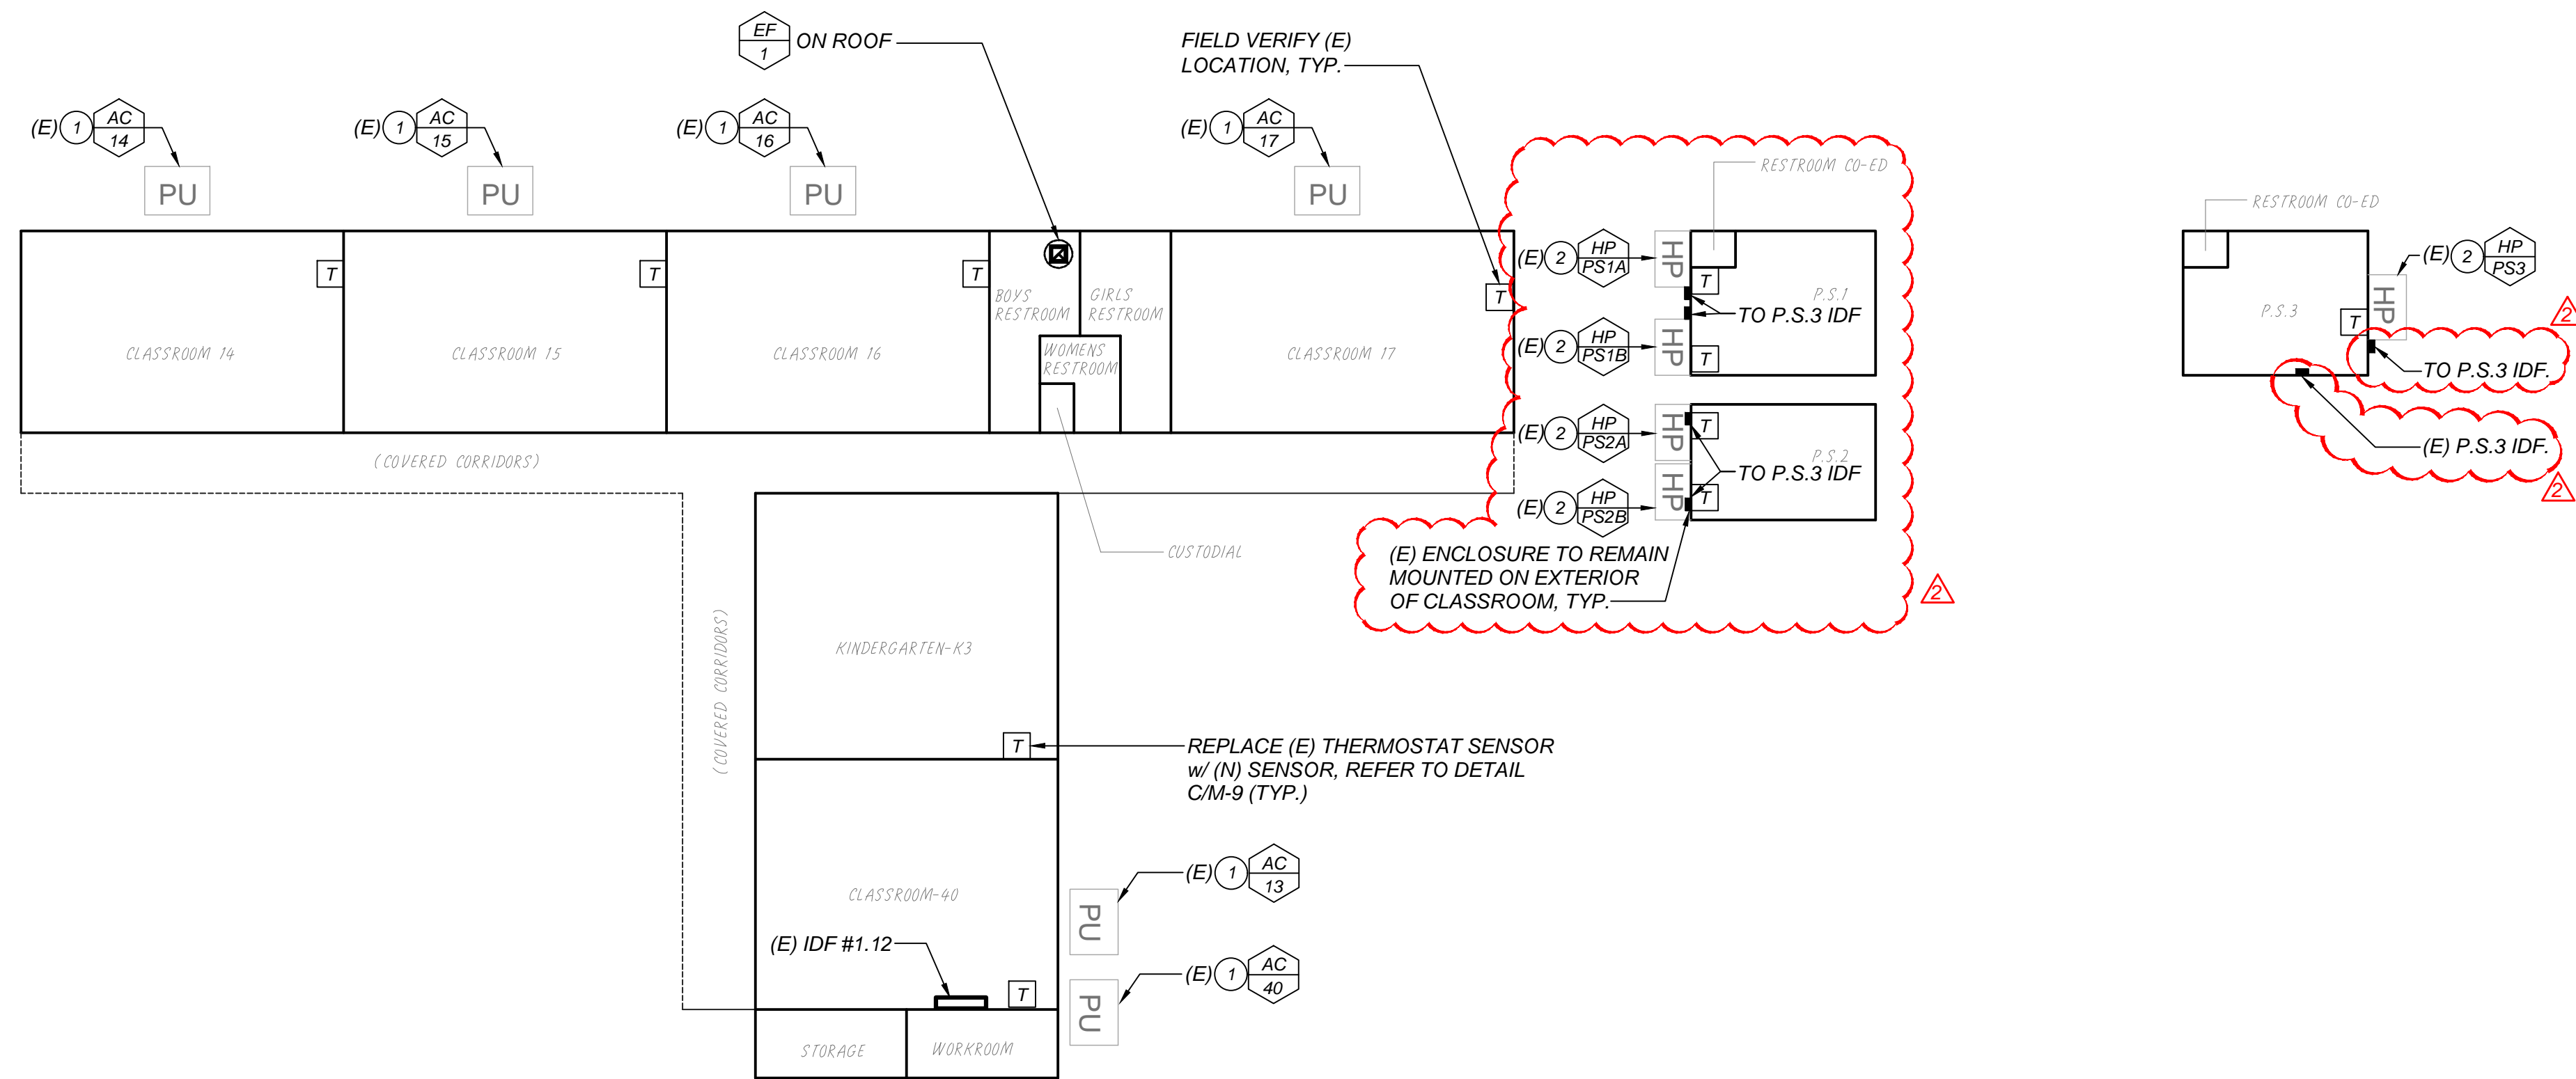


KEYNOTES: (THIS SHEET ONLY)
1 H/C UNIT MOUNTED ON GRADE.
2 WALL MOUNTED HEAT PUMP.

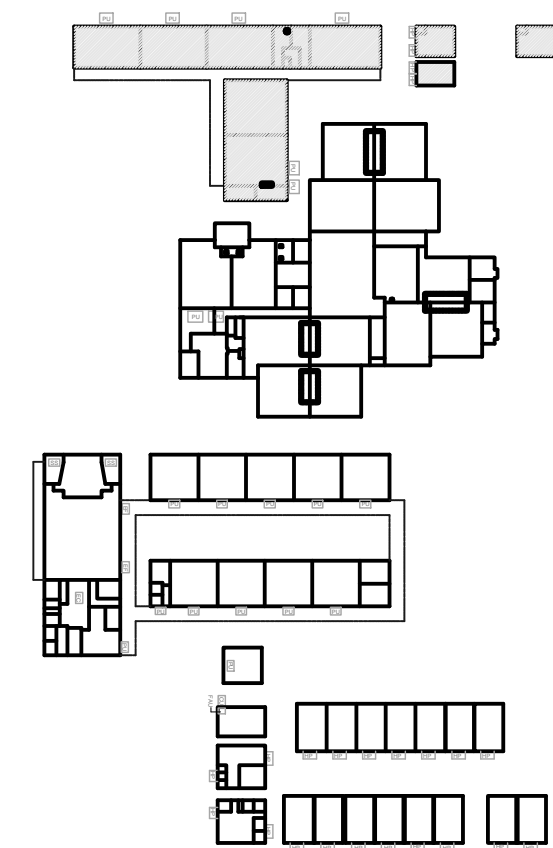

KEY PLAN

BLDG. A & BLDG. B EMS PLAN
SCALE: 1/16" = 1'-0"

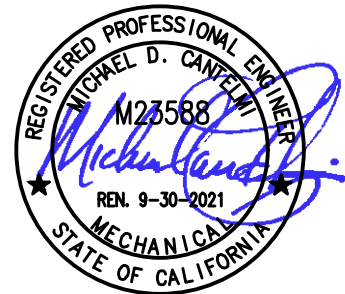


EMS REPLACEMENT
BURROUGHS ELEMENTARY SCHOOL
166 N SIERRA VISTA AVE. FRESNO, CA 93702
FRESNO UNIFIED SCHOOL DISTRICT
4600 N. BRAWLEY AVE. FRESNO, CA.

REVISIONS
4/22/21 EMS REVISIONS


LAWRENCE
ENGINEERING GROUP
Fresno, CA 93720
(559) 431-0101
7084 N. Maple Ave., Suite 101
(559) 431-1362

TITLE:
BLDG F
EMS PLAN


SHEET:
M2
PROJECT: 20140

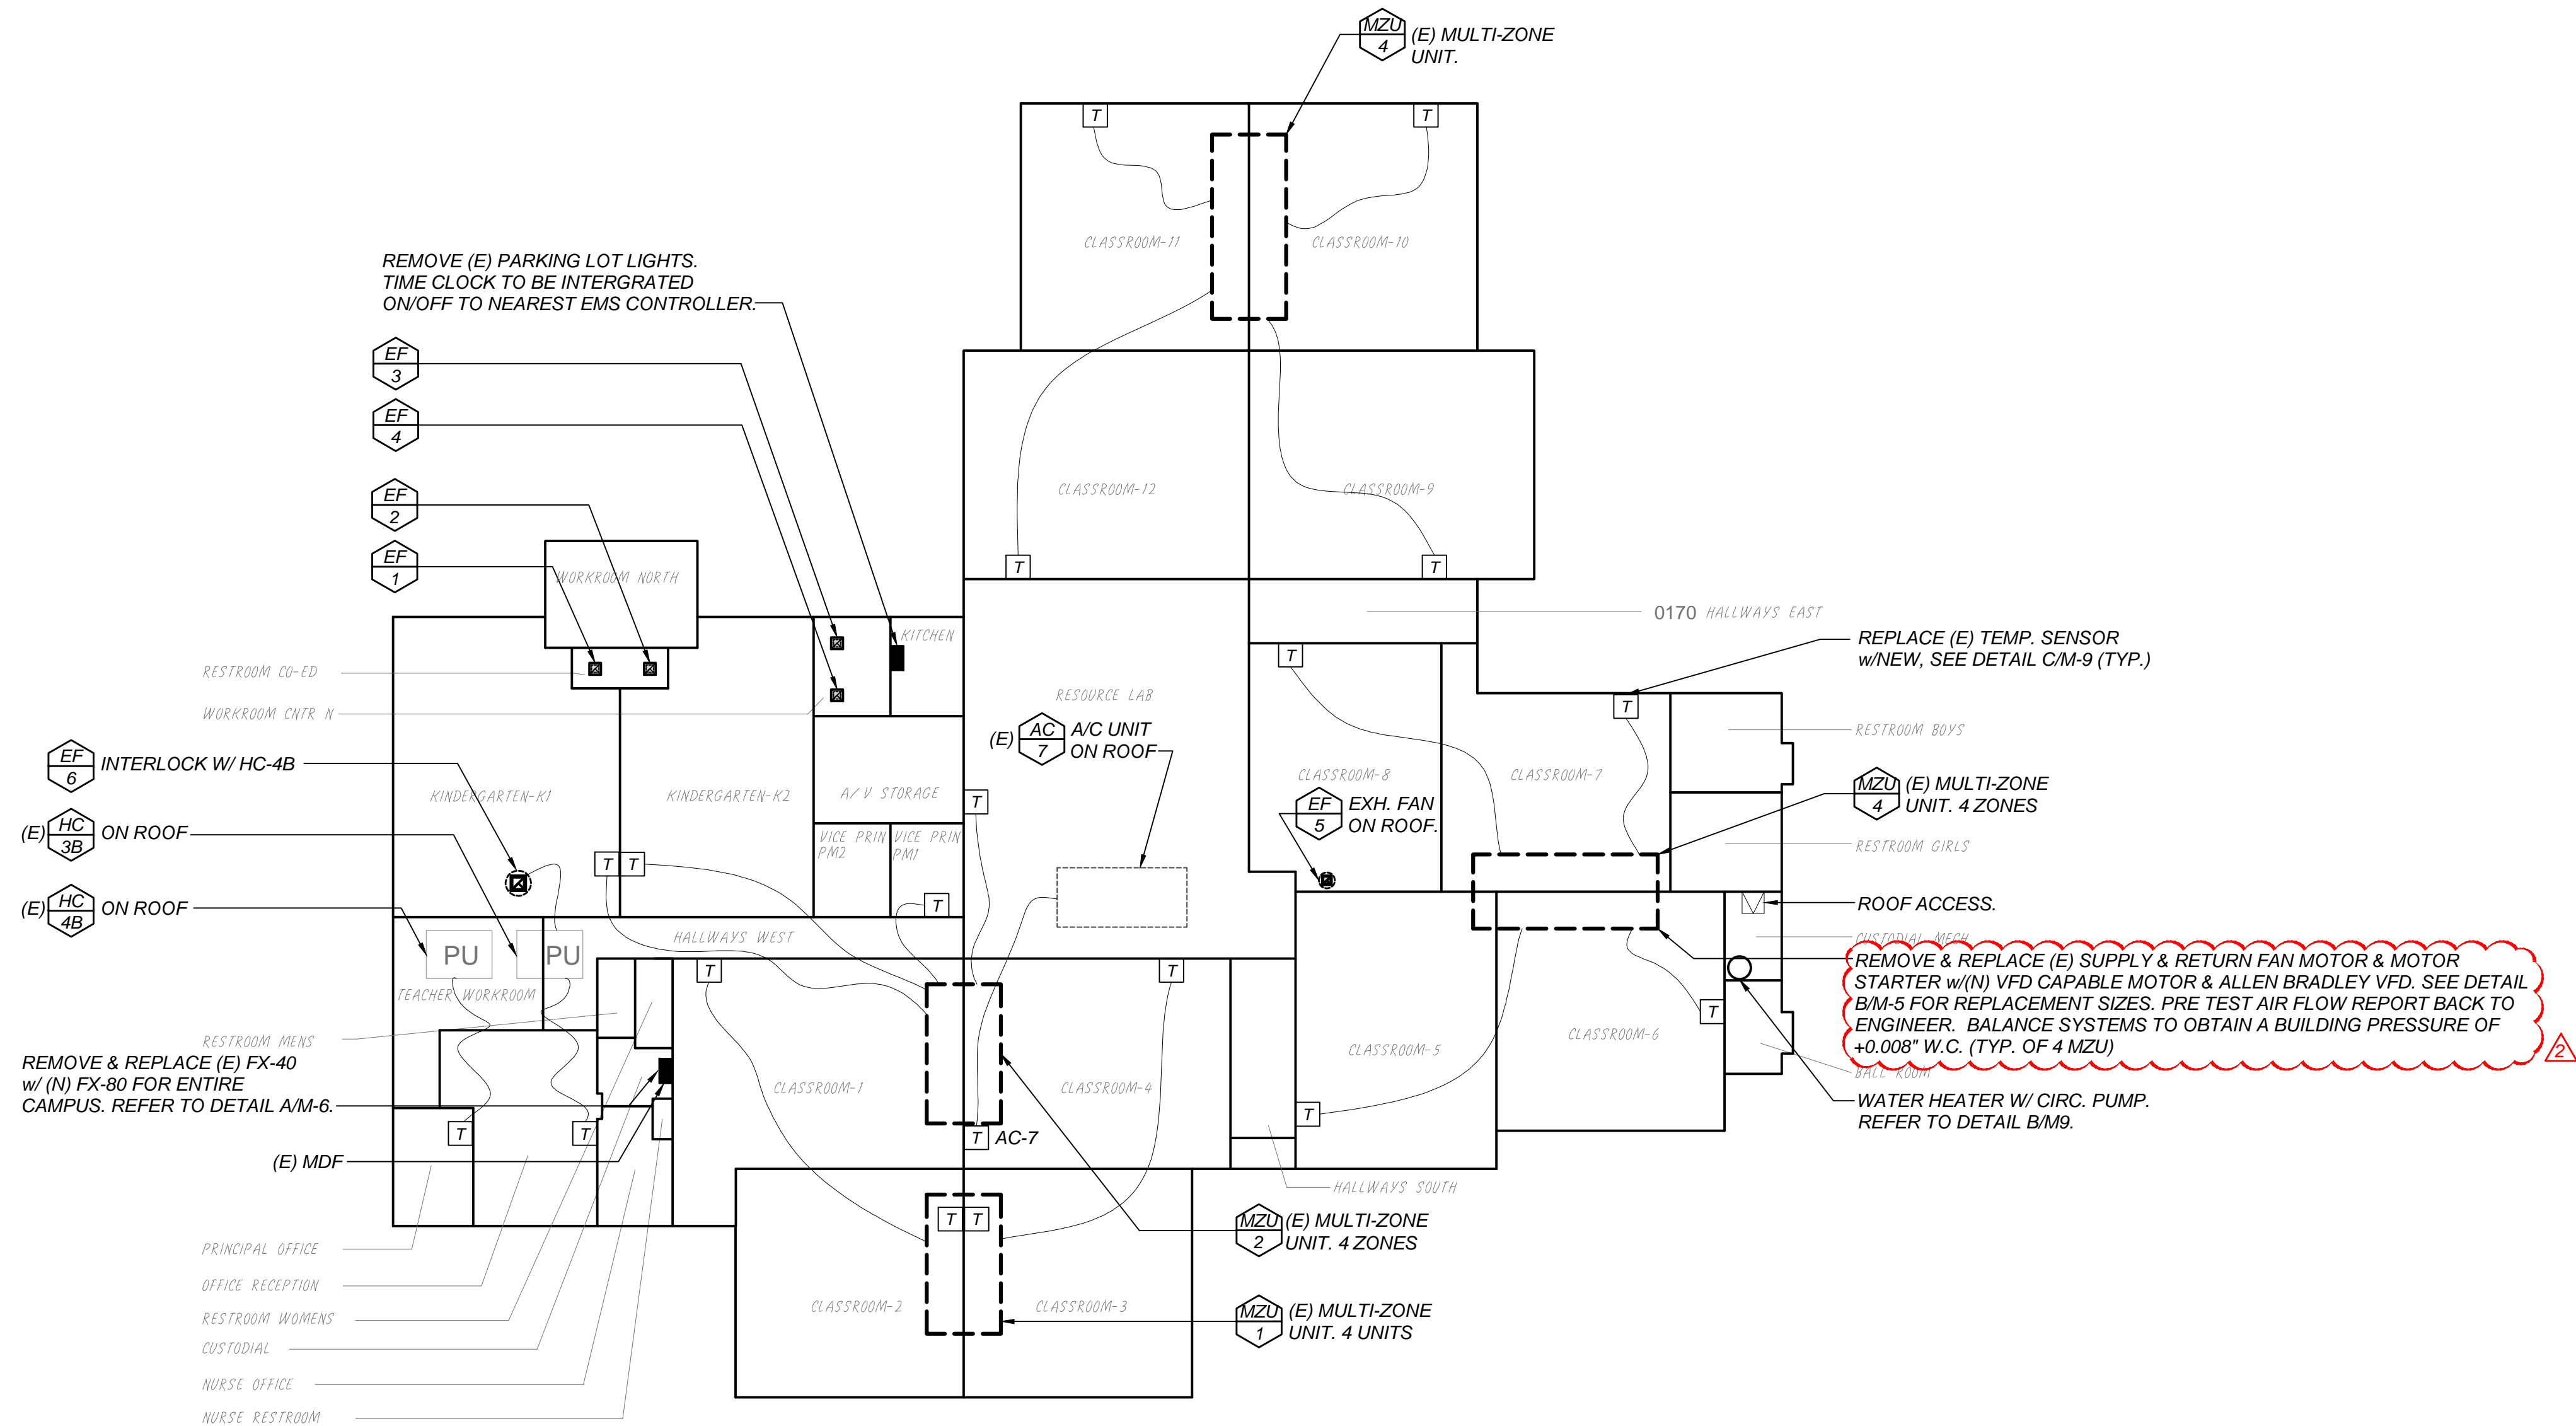

BLDG. F EMS PLAN
SCALE: 1/16" = 1'-0"

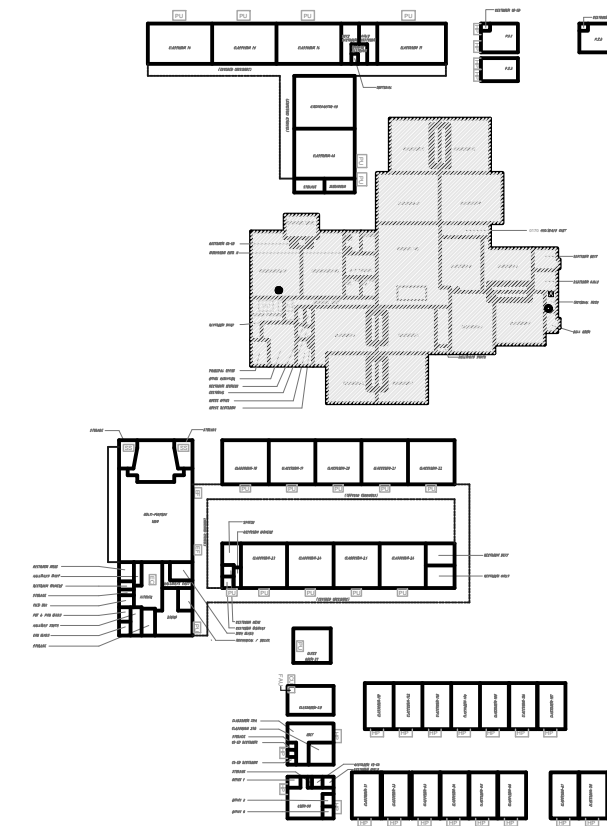

KEY PLAN

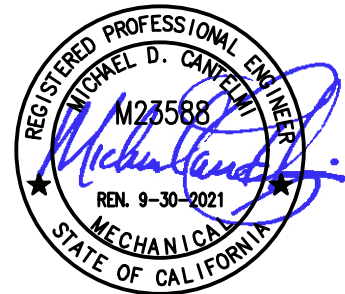


EMS REPLACEMENT
BURROUGHS ELEMENTARY SCHOOL
166 N SIERRA VISTA AVE. FRESNO, CA 93702
FRESNO UNIFIED SCHOOL DISTRICT
4600 N. BRAWLEY AVE. FRESNO, CA.

REVISIONS
4/22/21 EMS REVISIONS


LAWRENCE
ENGINEERING GROUP
Fresno, CA 93720
(559) 431-1362
7084 N. Maple Ave., Suite 101
(559) 431-0101

TITLE:
BLDG. C, D, & E
EMS PLAN

SHEET:
M3
PROJECT: 20140

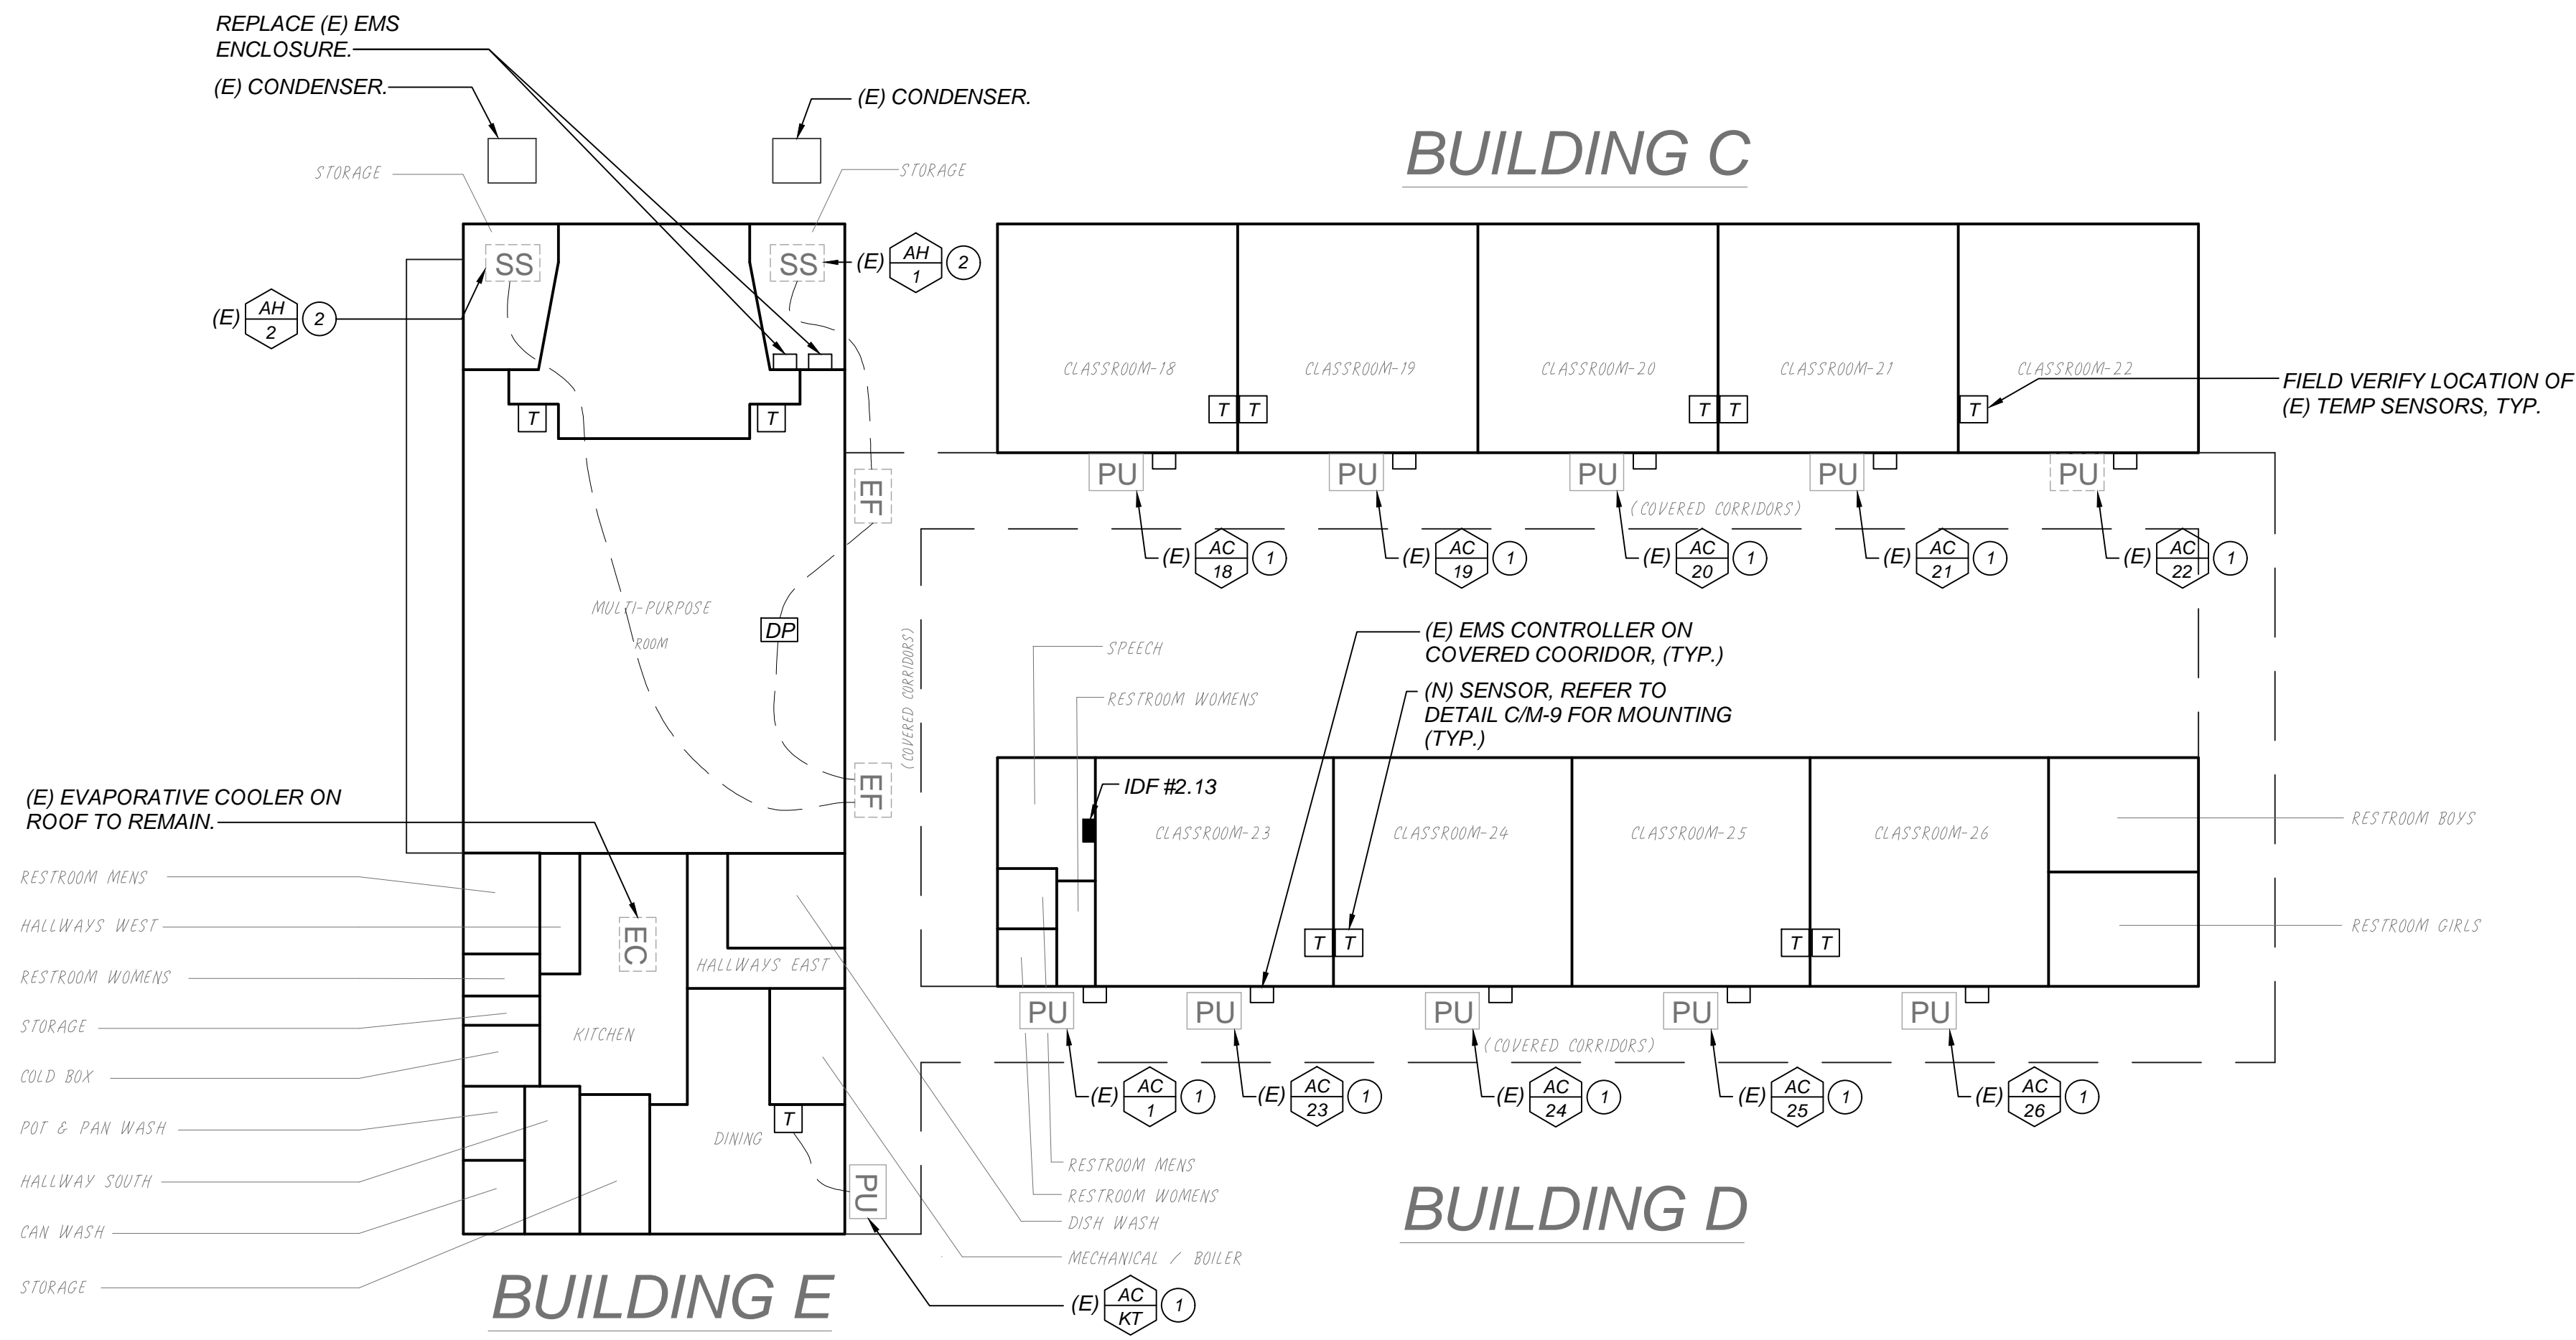


- KEYNOTES: (THIS SHEET ONLY)
- 1 HEATING & COOLING UNIT ON COVERED CORRIDOR.
 - 2 SPLIT SYSTEM VERTICAL AIR HANDLER w/GAS FURNACE, DX COOLING COIL & AIR COOLED CONDENSER ON GRADE.
 - 3 (E) EXHAUST FANS CONTROLLED w/DIFFERENTIAL PRESSURE SENSOR. INTERLOCK EXHAUST ENABLE w/ AH-1 & AH-2.

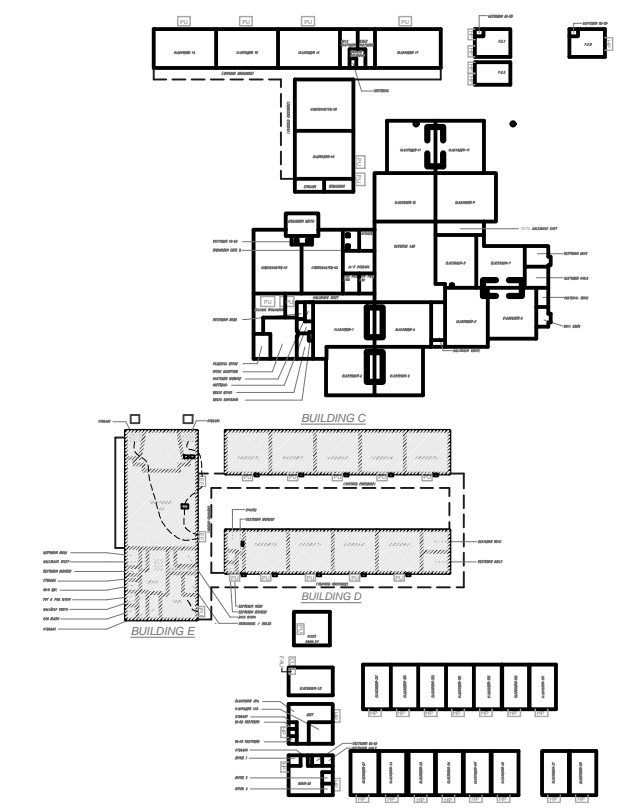

KEY PLAN

 **BLDG. C, D, & E EMS PLAN**
SCALE: 1/16" = 1'-0"

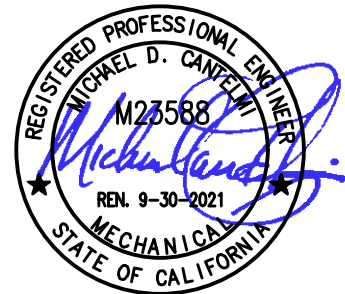


EMS REPLACEMENT
BURROUGHS ELEMENTARY SCHOOL
166 N SIERRA VISTA AVE. FRESNO, CA 93702
FRESNO UNIFIED SCHOOL DISTRICT
4600 N. BRAWLEY AVE. FRESNO, CA.

REVISIONS
42221 EMS REVISIONS

LAWRENCE
ENGINEERING GROUP
Fresno, CA 93720
(559) 431-1362
7084 N. Maple Ave., Suite 101
(559) 431-0101


TITLE:
PORTABLE
BUILDINGS

SHEET:
M4
PROJECT: 20140

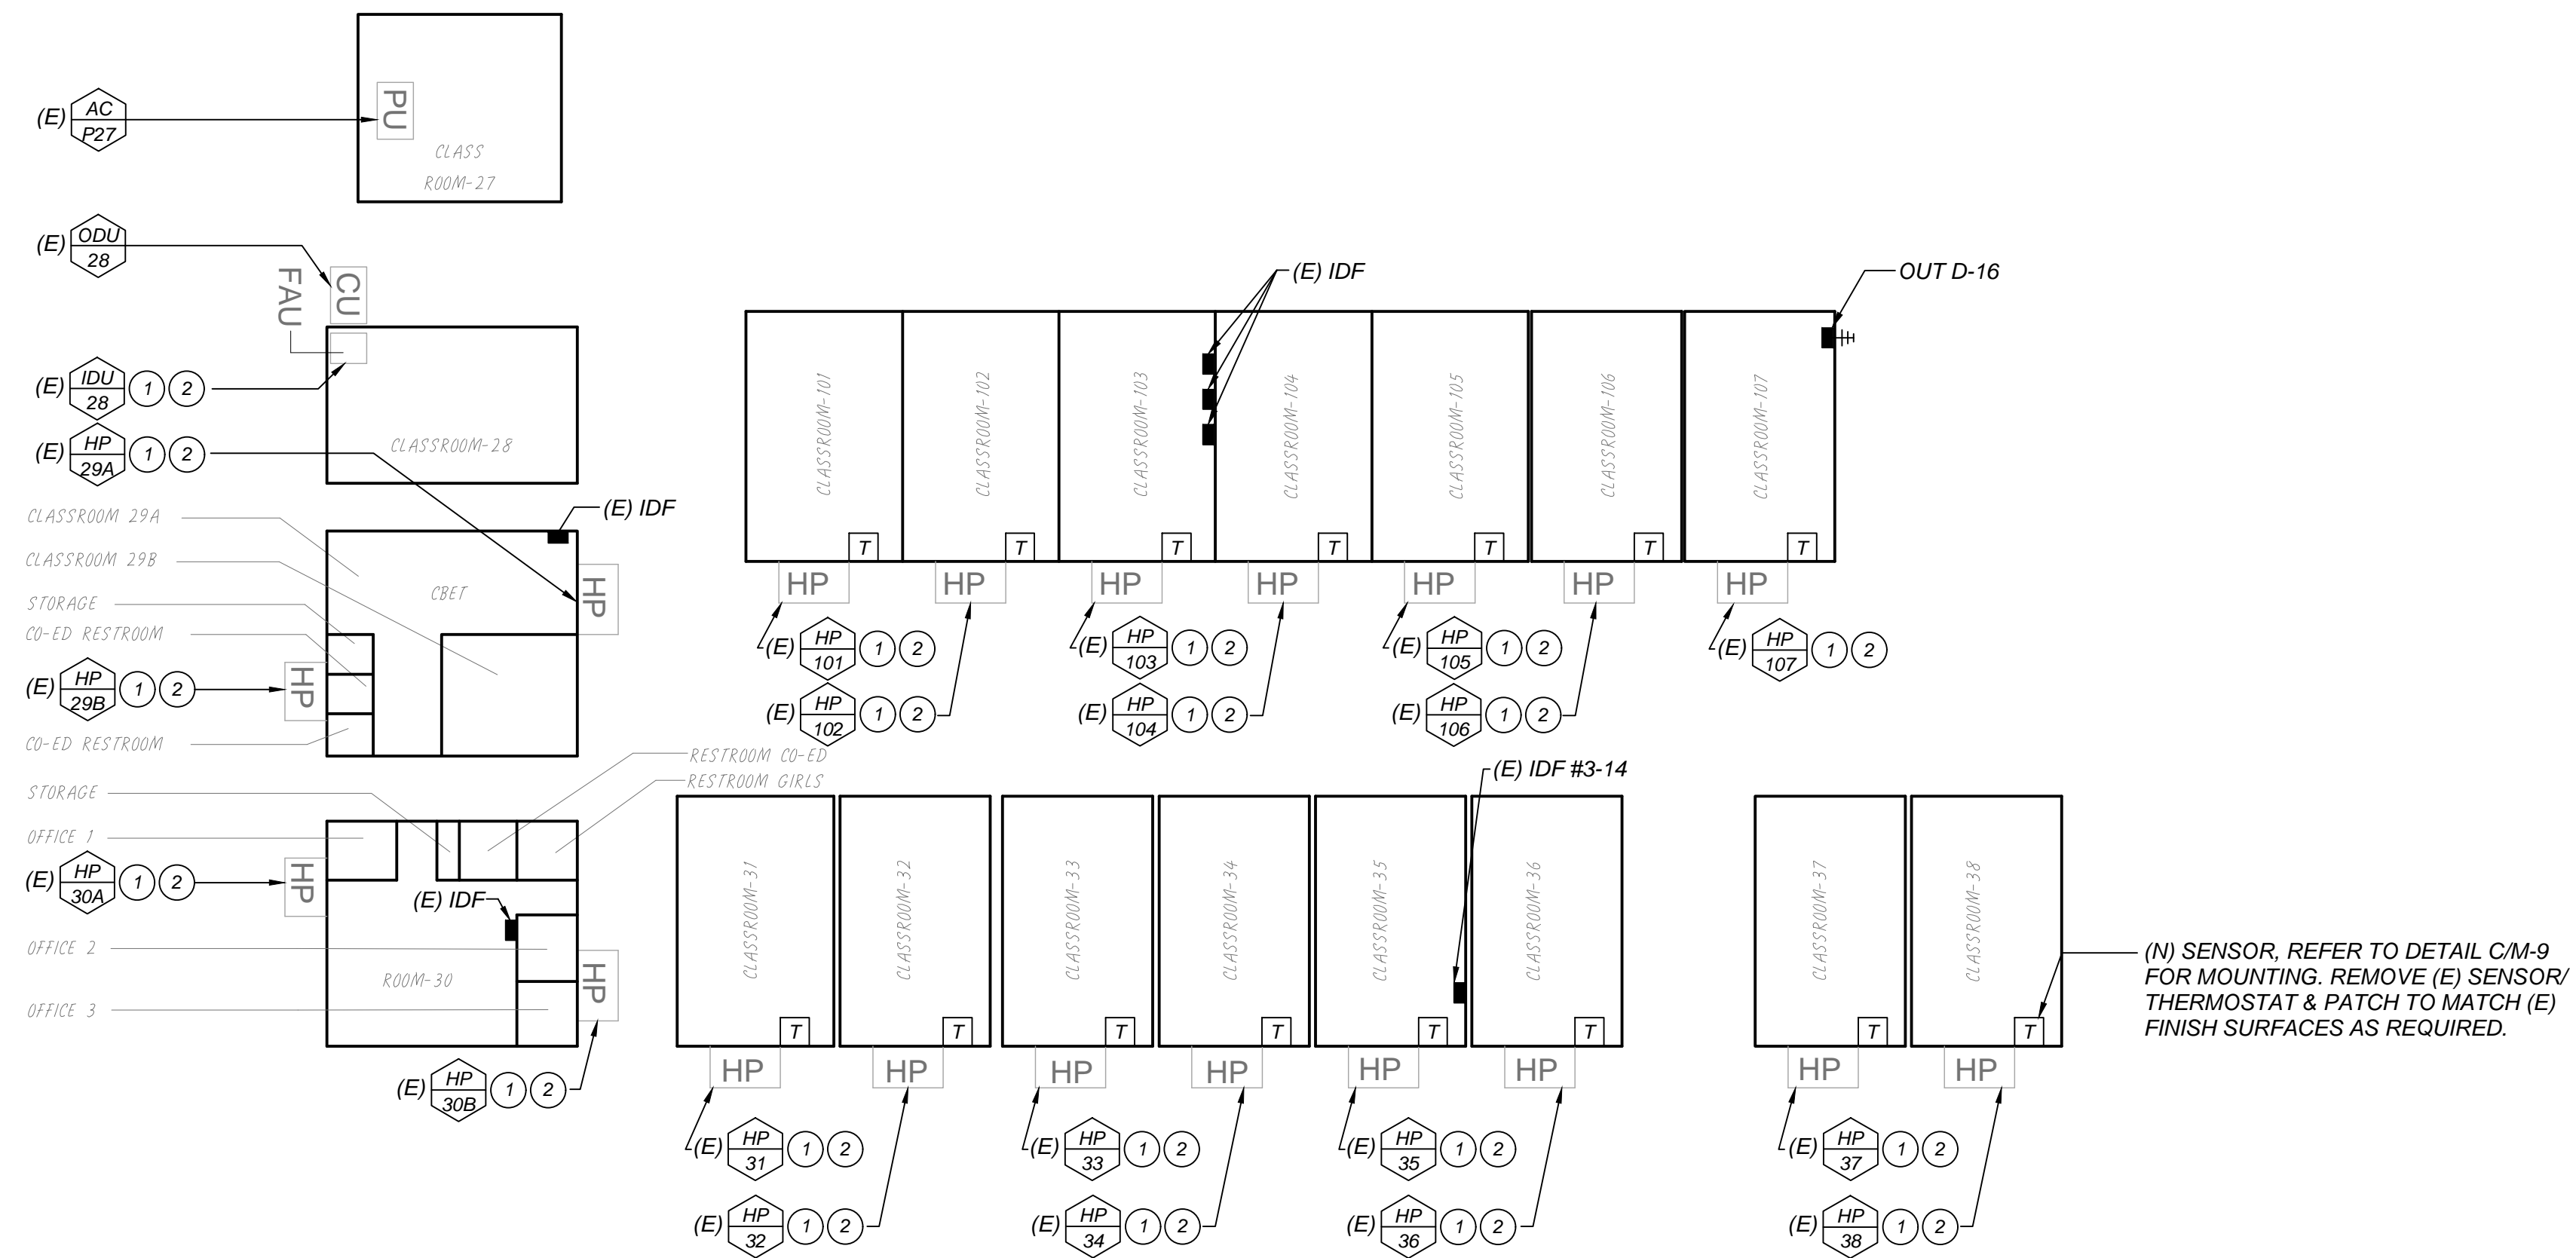


 **PORTABLE BUILDINGS**
SCALE: 1/16" = 1'-0"

- KEYNOTES: (THIS SHEET ONLY)
- 1 WALL MOUNTED HEAT PUMP.
 - 2 REVUSE (E) EMS ENCLOSURE OR PROVIDE (N) IF (E) ENCLOSURE IS NOT SALVAGEABLE.

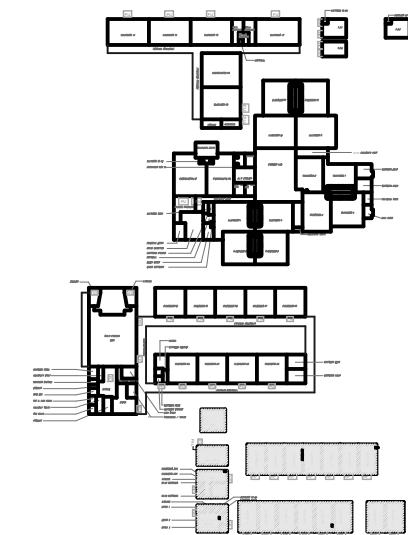

KEY PLAN

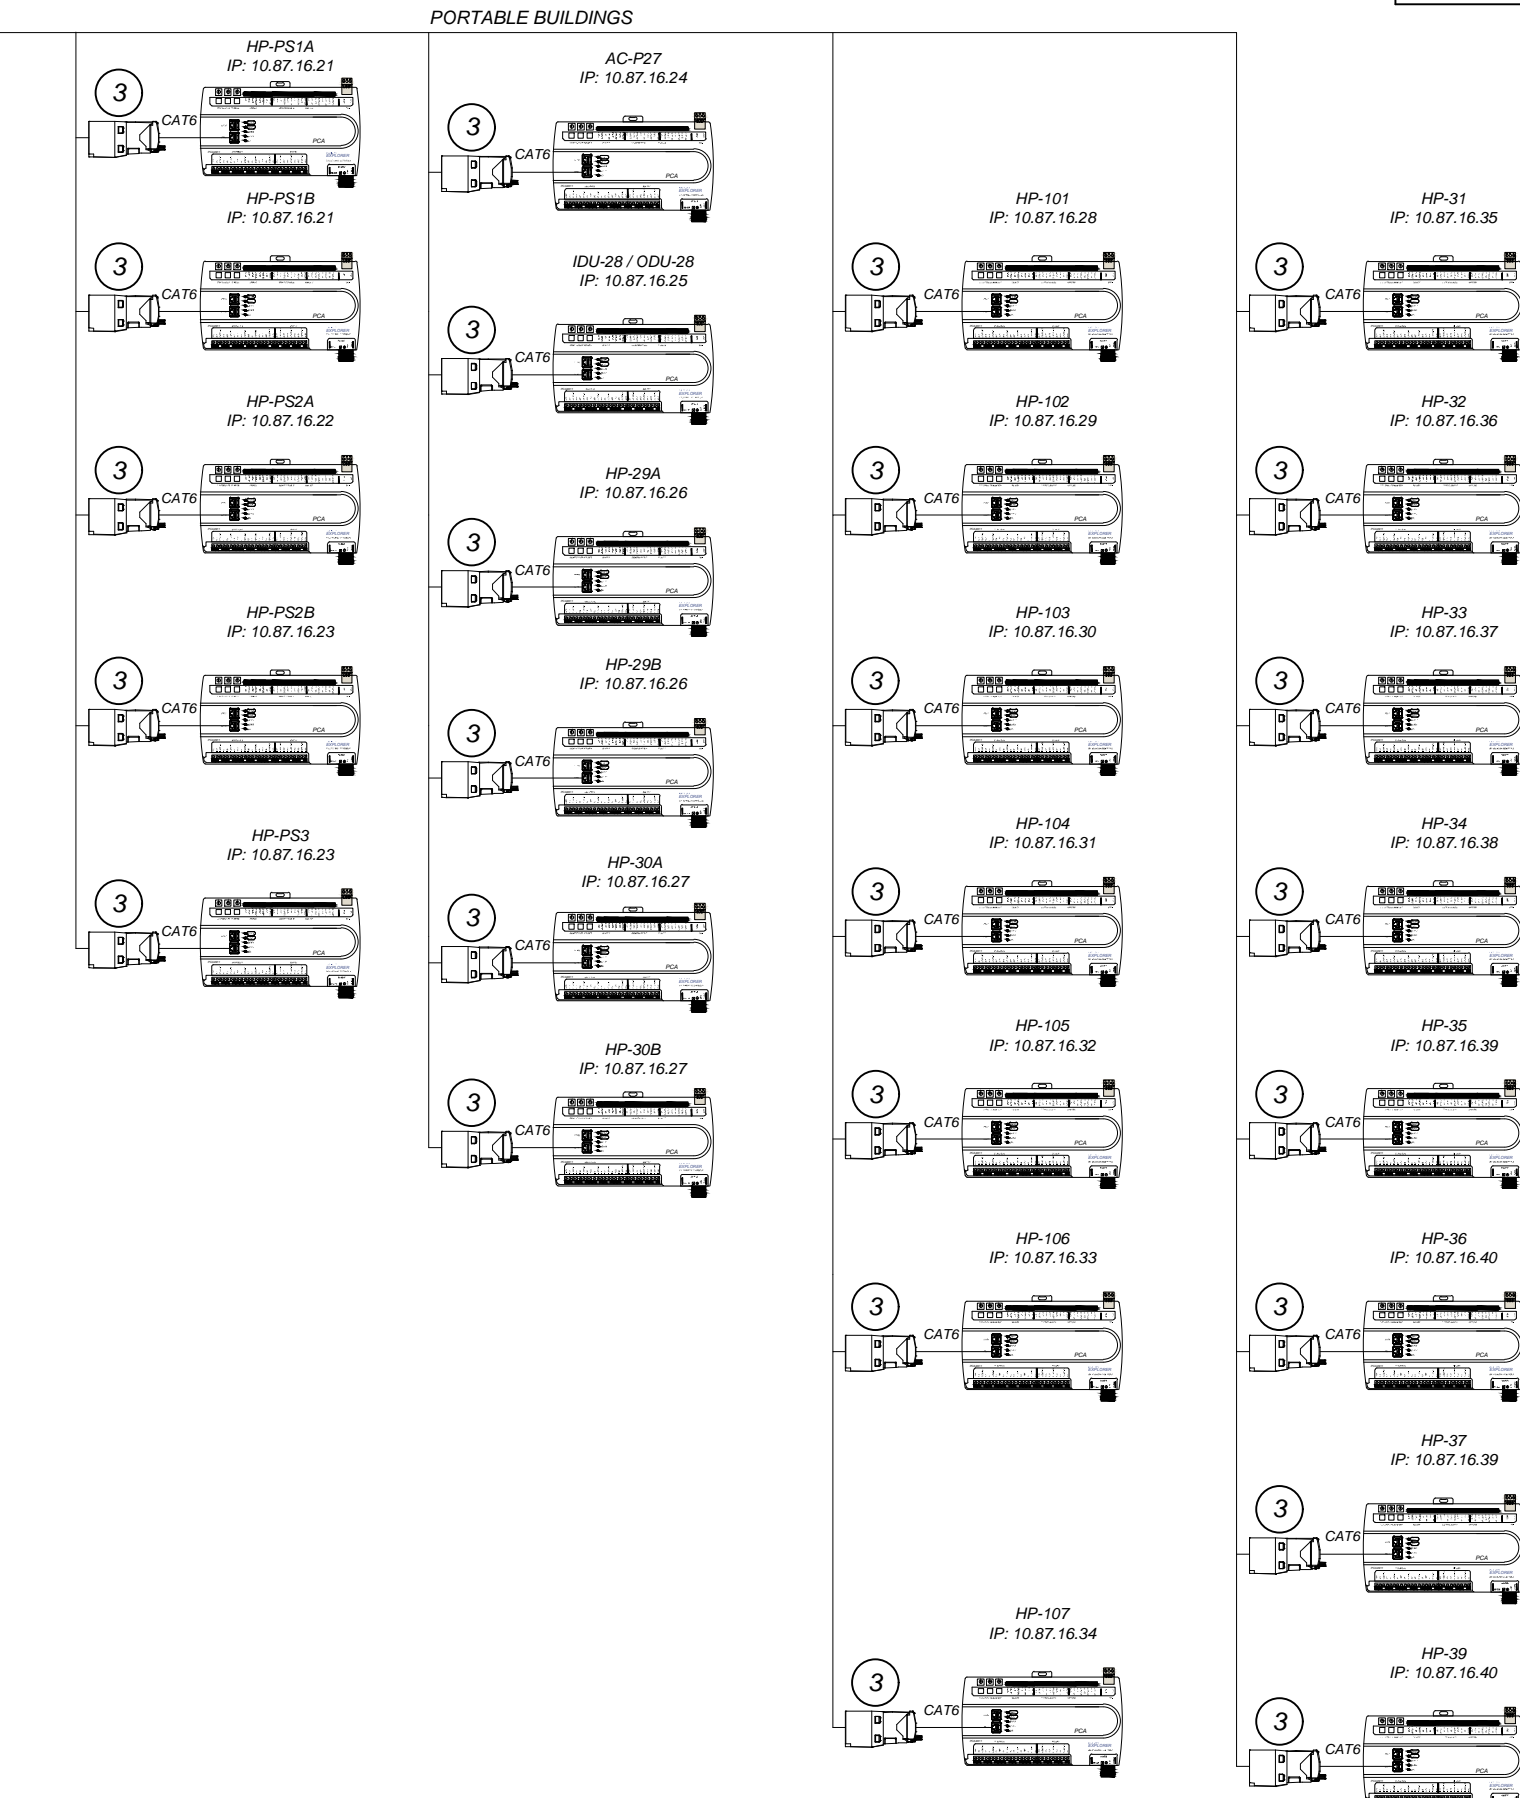

NOTE: RING TOPOLOGY IS ACCEPTABLE FOR CONTROLLERS SERVING PORTABLE BUILDINGS.

1. DEFAULT IP ADDRESS TO BE CHANGED DURING COMMISSIONING.
2. IP ADDRESSES TO BE PROVIDED BY FUSD.
3. A PANDUIT C668TGYL CONNECTOR IS REQUIRED BETWEEN ALL IP DEVICES AND THE NETWORK SWITCH.
4. BOTH ENDS OF ALL CAT-6 CABLES MUST BE LABELED WITH THE ROOM NUMBER, EQUIPMENT TYPE, AND PATCH PANEL NUMBER I.E. ROOM # EQUIP. TYPE - PORT #.

NOTES:

1. System Type Abbreviations: G/E - Gas Heating/Electric Cooling; HP - Heat Pump

CP - Central Plant Hot or Chilled Water

LS - Light Switch

UV - Unit Ventilator

MUA- Make-up Air

HW- Hot Water


DHW- Domestic Hot Water

MZ - Multizone

AH - Air handler

WH- Domestic Water Heater

Fur - Furnance

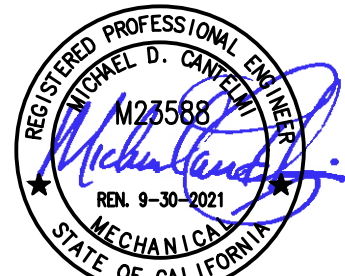

DATE: 11-25-2020


EMS REPLACEMENT
BURROUGHS ELEMENTARY SCHOOL
166 N SIERRA VISTA AVE. FRESNO, CA 93702
FRESNO UNIFIED SCHOOL DISTRICT
4600 N. BRAWLEY AVE. FRESNO, CA.

REVISIONS
4/22/21 EMS REVISIONS

LAWRENCE
ENGINEERING GROUP
Fresno, CA 93720
(559) 431-0101
7084 N. Maple Ave., Suite 101
(559) 431-1362



TITLE:
ENERGY
MANAGEMENT
DETAILS

SHEET:
M6
PROJECT 20140

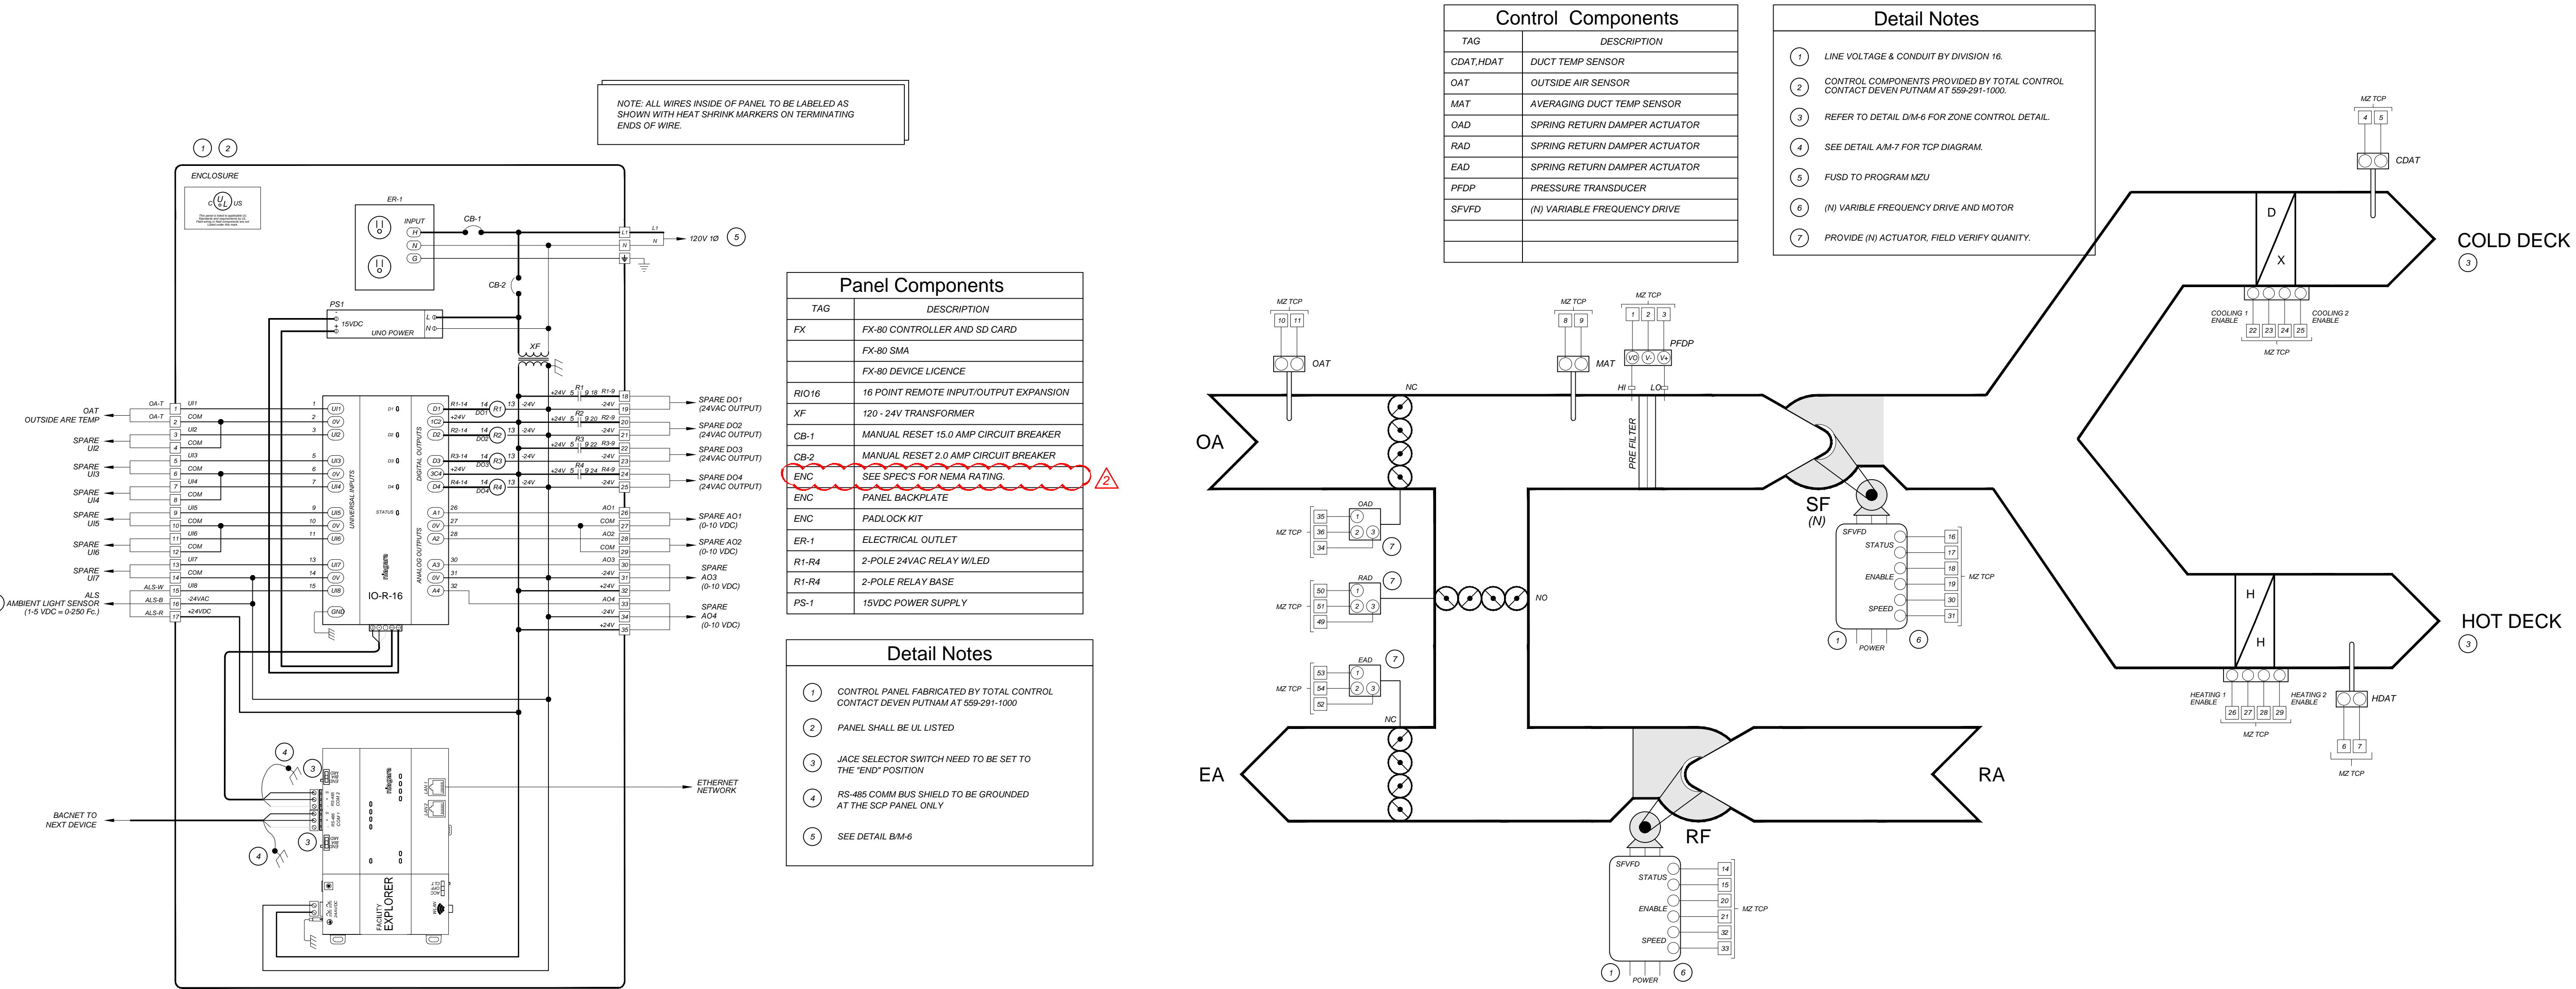


SUPERVISORY SCP SCHEMATIC DETAIL

MULTI-ZONE CONTROL DETAIL

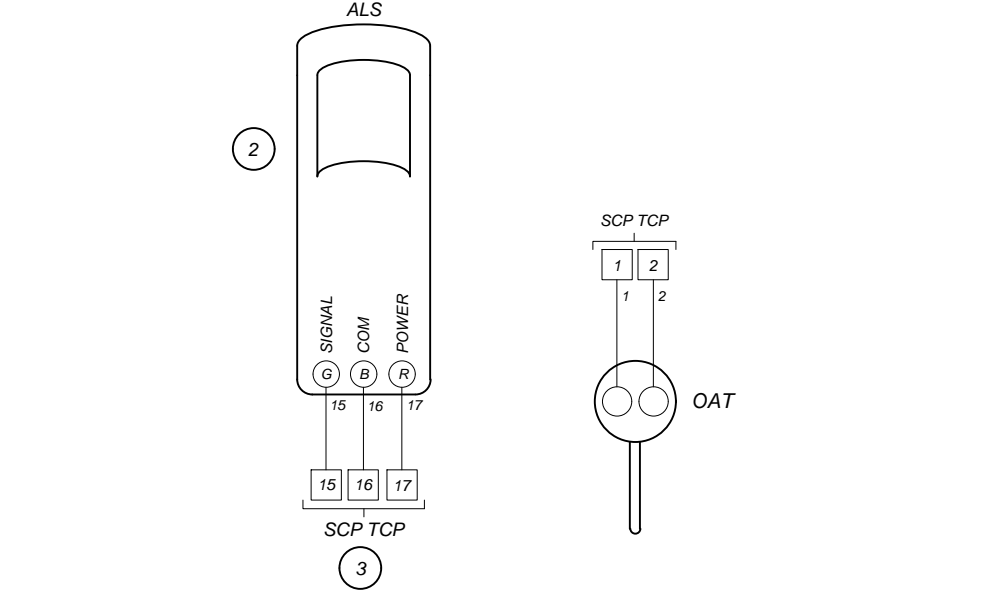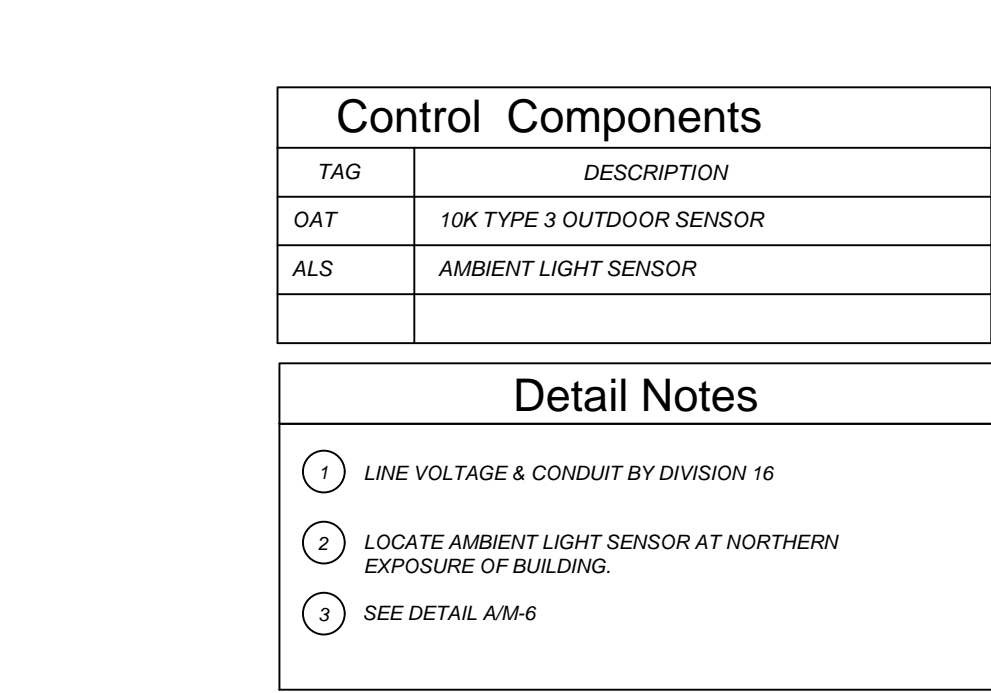


OUTDOOR PHOTOCELL AND TEMP SENSOR DETAIL

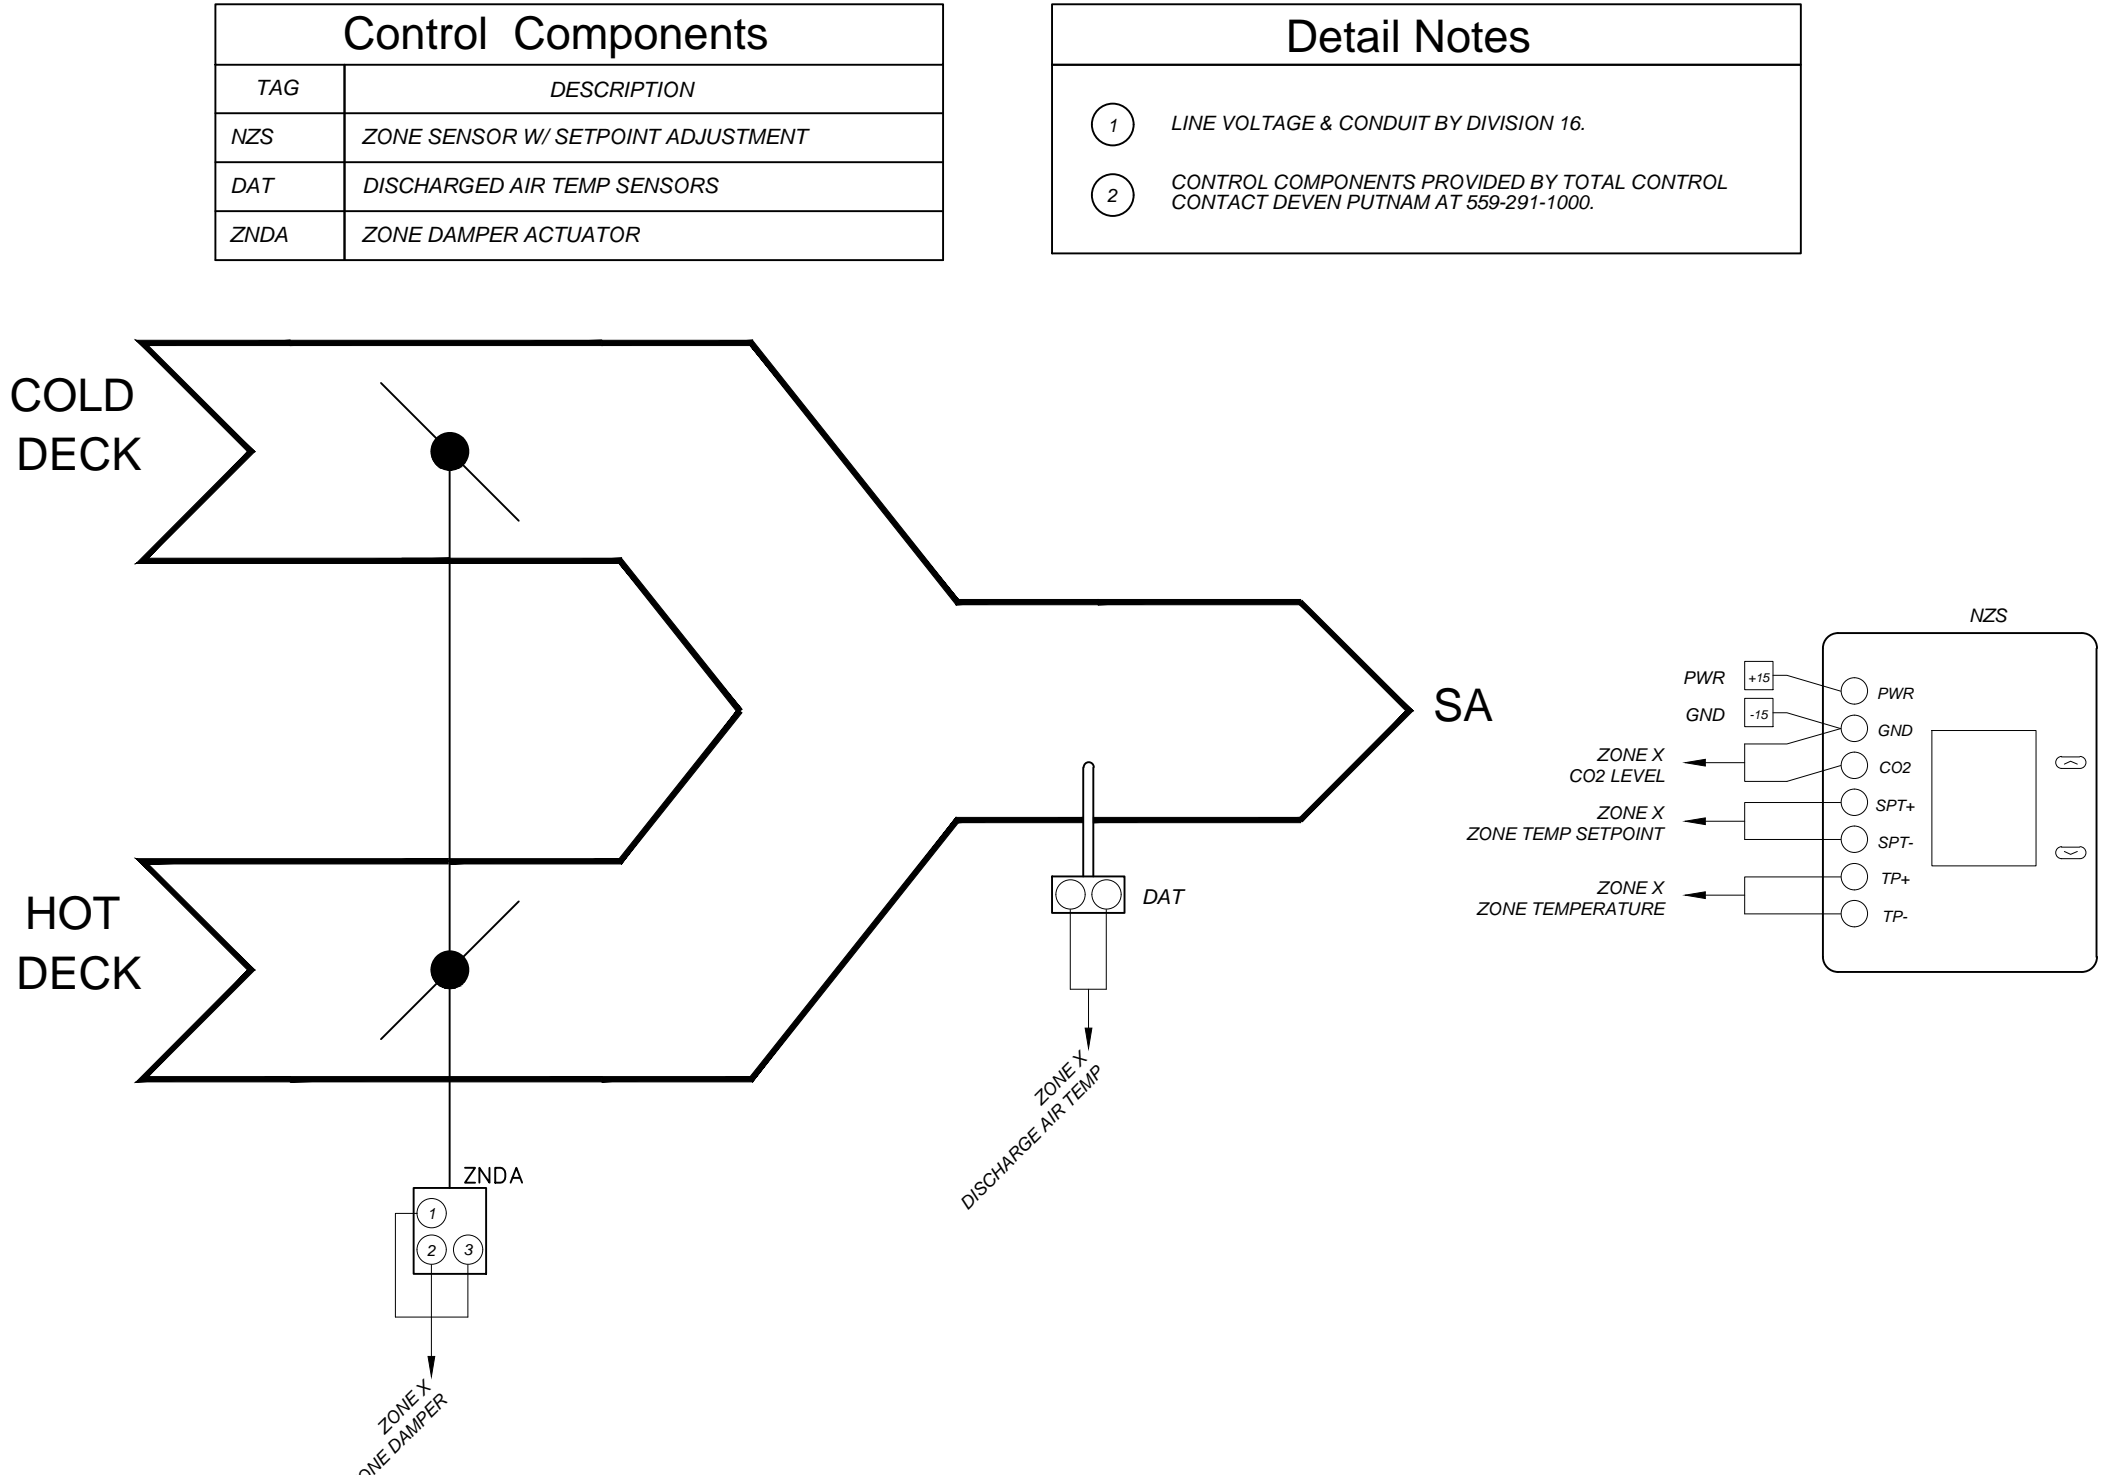

OUTDOOR PHOTOCELL AND TEMP SENSOR DETAIL

D
M-6

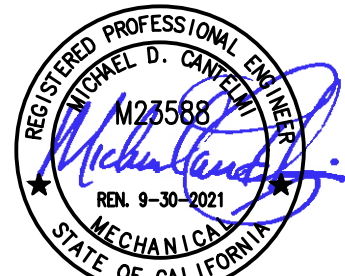

EMS REPLACEMENT
BURROUGHS ELEMENTARY SCHOOL
166 N SIERRA VISTA AVE., FRESNO, CA 93702
FRESNO UNIFIED SCHOOL DISTRICT
4600 N. BRAWLEY AVE., FRESNO, CA.

REVISIONS
42221 - EMS REVISIONS

LAWRENCE
ENGINEERING GROUP
Fresno, CA 93720
(559) 431-1362
FAX (559) 431-0101

TITLE:
ENERGY
MANAGEMENT
DETAILS

SHEET:
M7
PROJECT 20140


NOTE: ALL WIRES INSIDE OF PANEL TO BE LABELED AS SHOWN WITH HEAT SHRINK MARKERS ON TERMINATING ENDS OF WIRE.

Detail Notes

- CONTROL PANELS FABRICATED BY TOTAL CONTROL CONTACT DEVEN PUTNAM AT 559-291-1000
- PANEL SHALL BE UL LISTED
- LINE VOLTAGE AND CONDUIT BY DIVISION 16.

Panel Components

TAG	DESCRIPTION
PCG	GENERAL PROGRAMMABLE CONTROLLER
ENC	SEE SPEC'S FOR NEMA RATING
ENC	SOLID PANEL BACKPLATE
ENC	PANEL LOCK KIT
CB-1	2.0 AMP CIRCUIT BREAKER
XF	96VA 24VAC TRANSFORMER
R1-R6	2-POLE 24VAC RELAY W/ LED
R1-R6	2-POLE RELAY BASE
PCX	I/O EXPANSION MODULE
PS-1	15VDC POWER SUPPLY

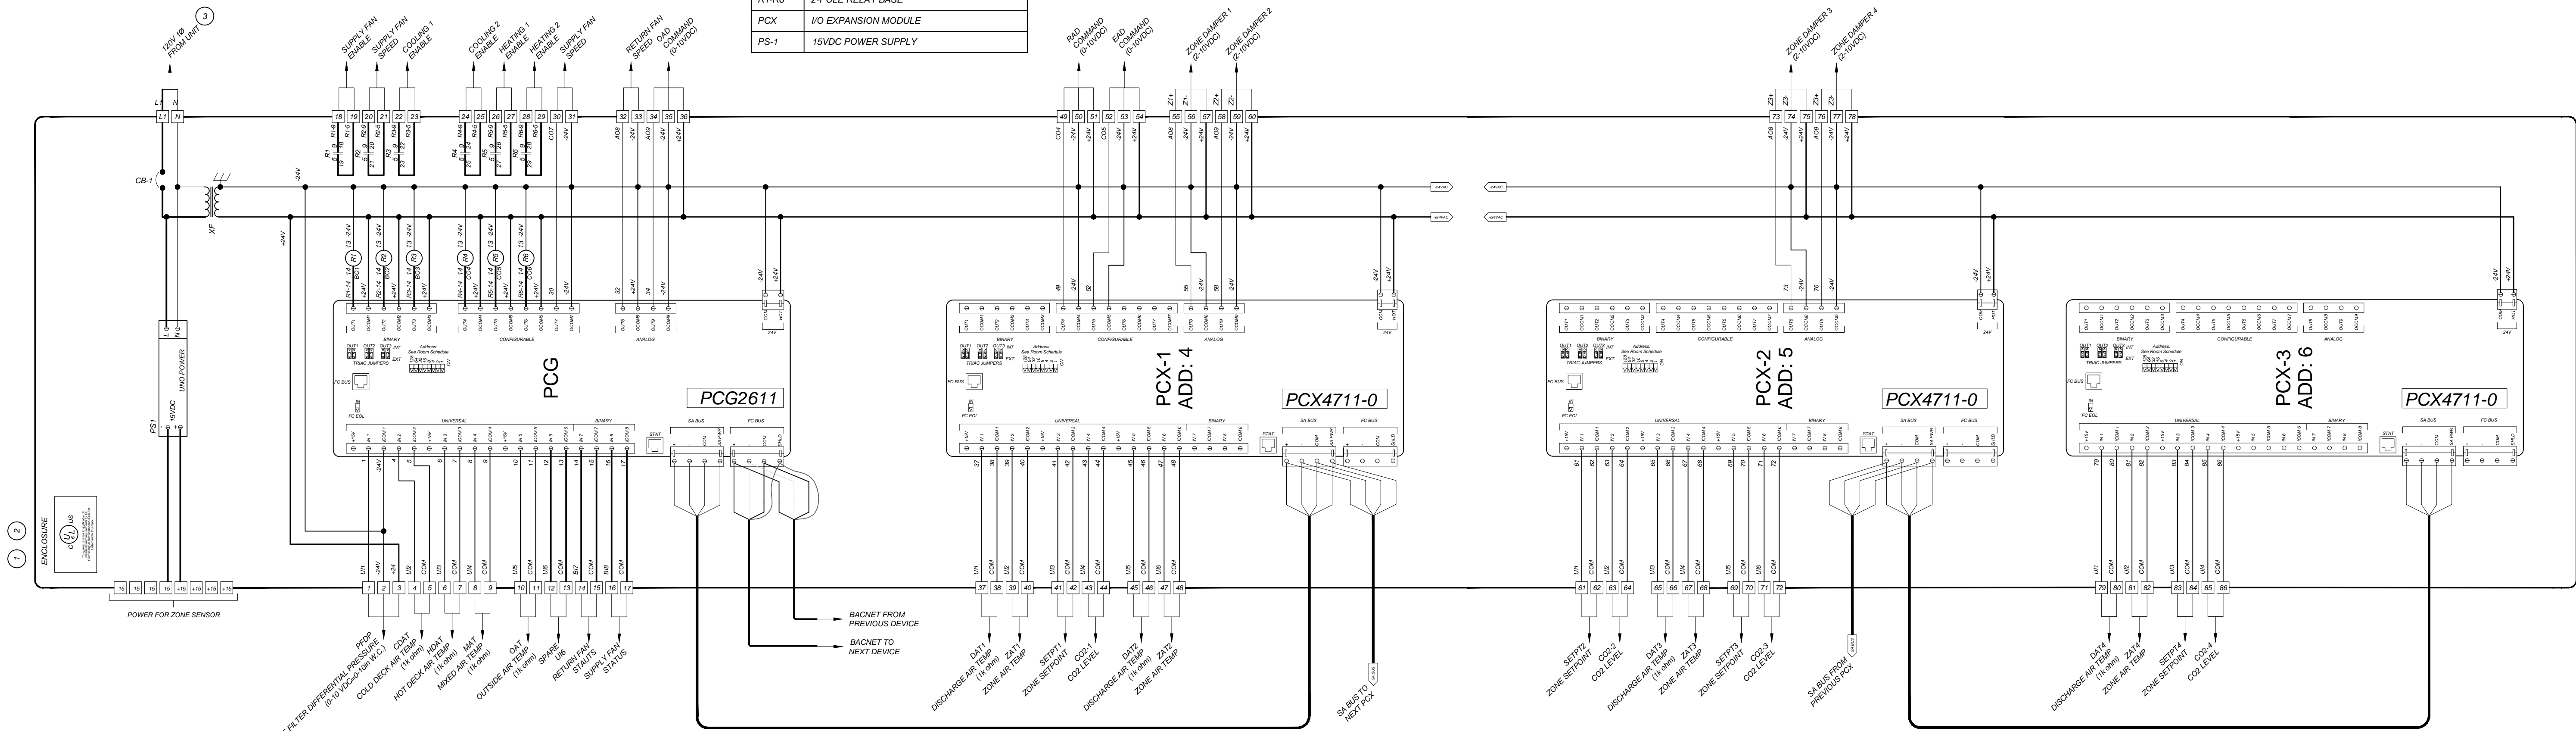

MULTI-ZONE SCHEMATIC DETAIL

Package Unit

A thermostat shall be mounted in the space.

Occupied Cool Setpoint: 75°F (adjustable)

Occupied Heat Setpoint: 68°F (adjustable)

Warm/Cool Adjustment: +3°/-3°

Unoccupied Mode: The unit shall remain OFF in unoccupied mode.

Occupied Mode: The unit shall receive an occupied command from the Johnson FX Supervisory controller. The supply fan will be enabled. A current sensor on the supply fan shall prove supply fan run status. When the run status is proven ON, the following modes shall be allowed to happen.

Cooling Mode: When outside air is above the OA cooling lockout setpoint (65° F adjustable) and there is a call for cooling, the compressor shall stage on in order to satisfy the condition. Compressor shall be monitored with a current sensor to prove that the compressor is running.

Heating Mode: When outside air is below the OA heating lockout setpoint (60° F adjustable) and there is a call for heating the reversing valve shall stage on in order to satisfy the condition.

Demand Control Ventilation: CO2 readings shall come from the wall mount Temp/CO2 sensor. If the zone CO2 PPM reaches 800 ppm (adj.), the economizer shall modulate open to the maximum outdoor air position to satisfy the demand. Once the CO2 level drops below 800 ppm (adj.), the economizer shall close to the minimum outdoor air position.


CO2 Monitoring: If CO2 in the space rises above CO2 alarm setpoint (adj.), the system will generate a Niagara alarm.

Detail Notes


- LINE VOLTAGE & CONDUIT BY DIVISION 16.
- OAT GLOBALLY SHARED SOFTWARE POINT
- CONTROL COMPONENTS PROVIDED BY TOTAL CONTROL CONTACT DEVEN PUTNAM AT 559-291-1000.
- SEE DETAIL C-M-7 FOR TCP DIAGRAM.
- FIELD VERIFY NUMBER OF COOLING & HEATING STAGES.

Control Components

TAG	DESCRIPTION
DAT	DUCT TEMP SENSOR
CCS,SPCS	CURRENT SENSOR
NZS	NETWORK ZONE SENSOR W/ CO
OAD/RAD	SPRING RETURN DAMPER ACTUATOR

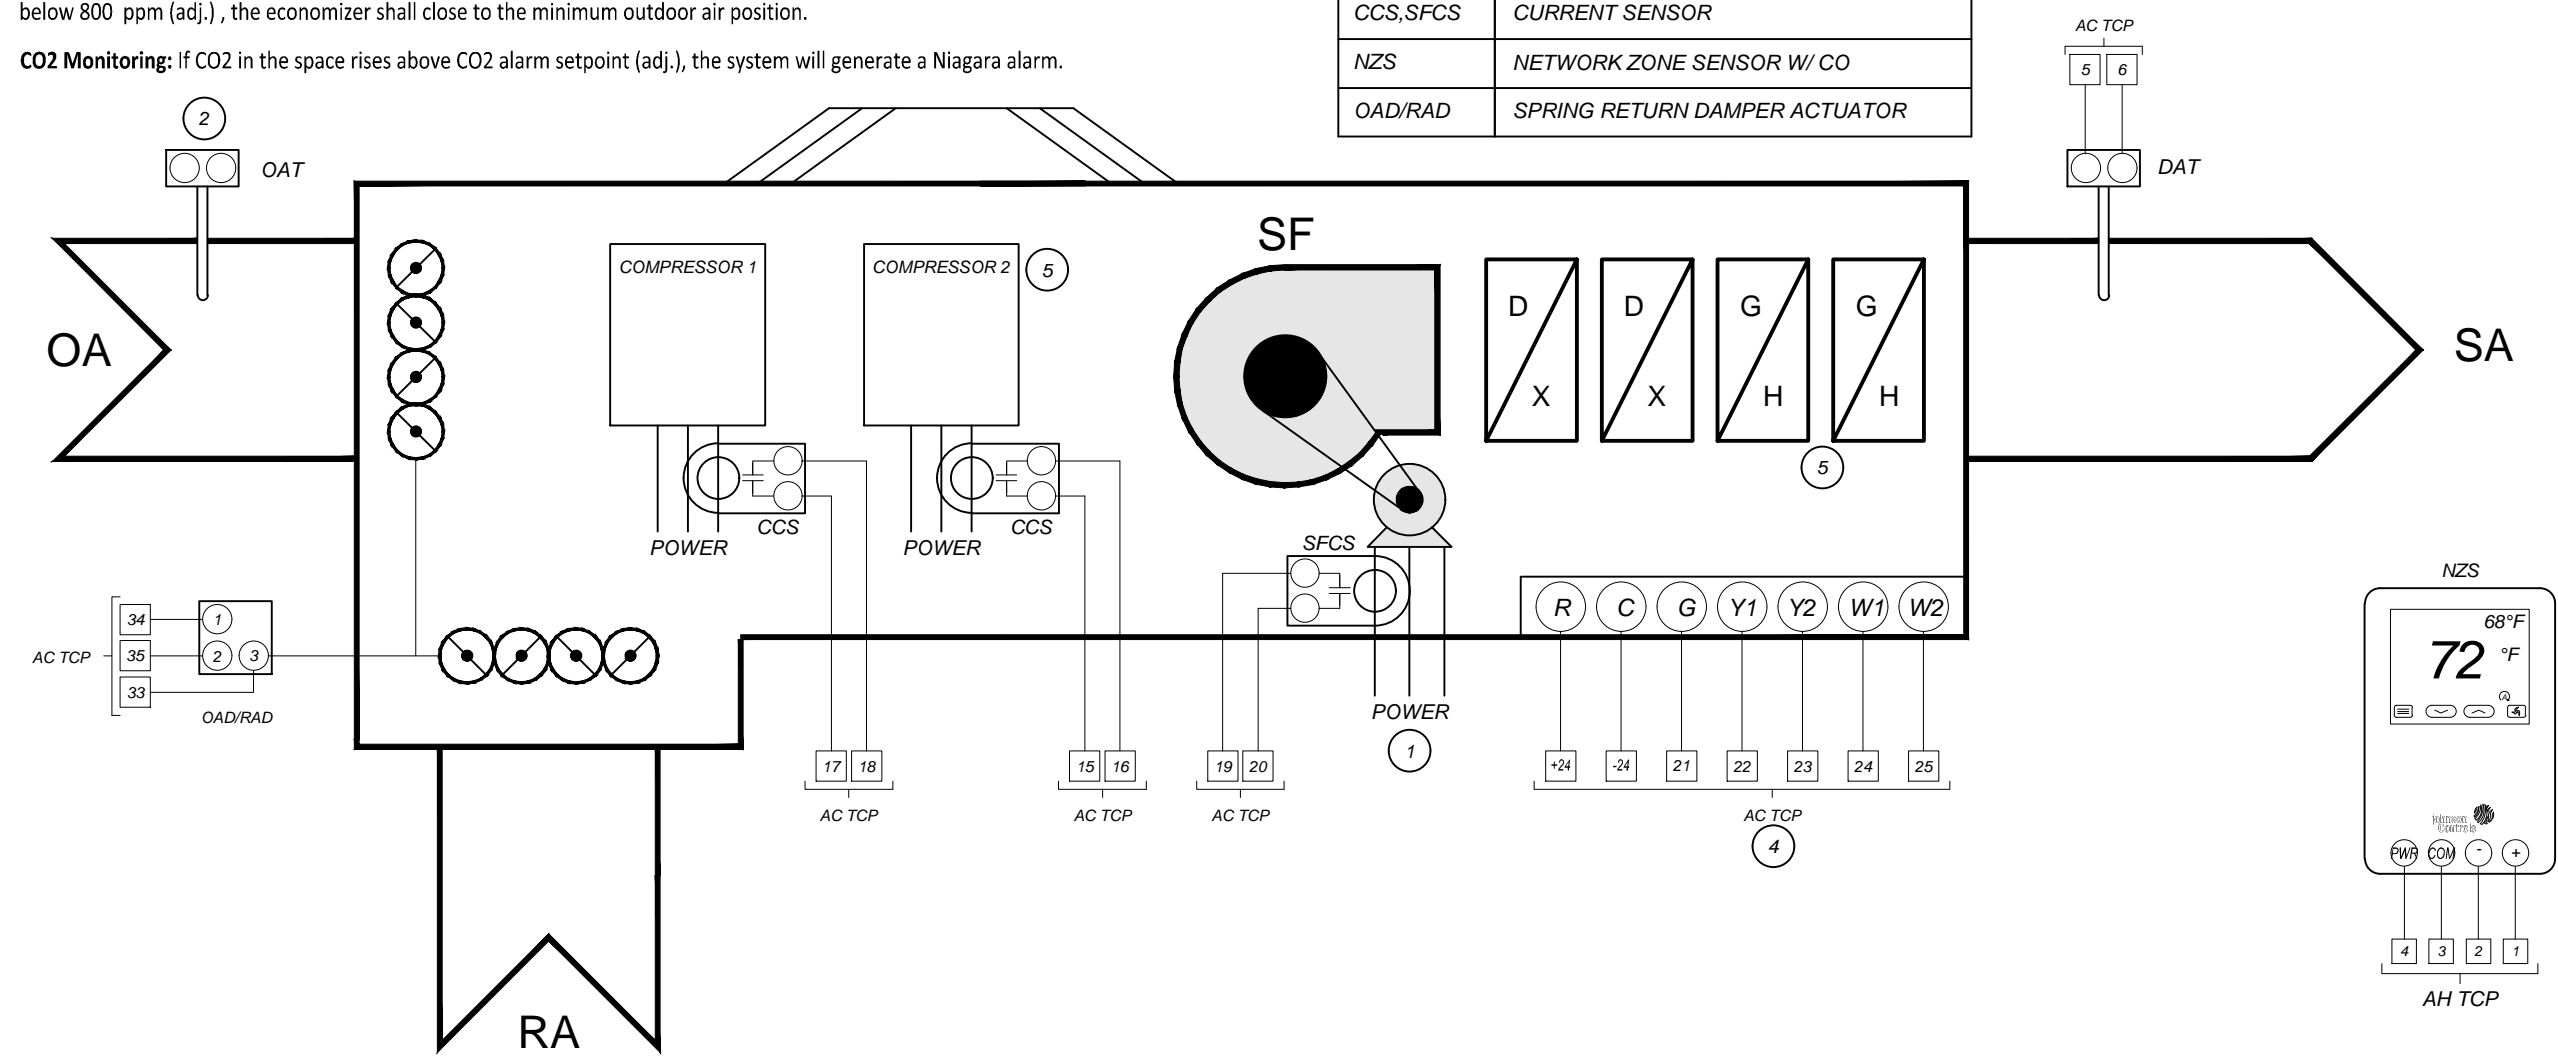

H/C UNIT CONTROL DETAIL

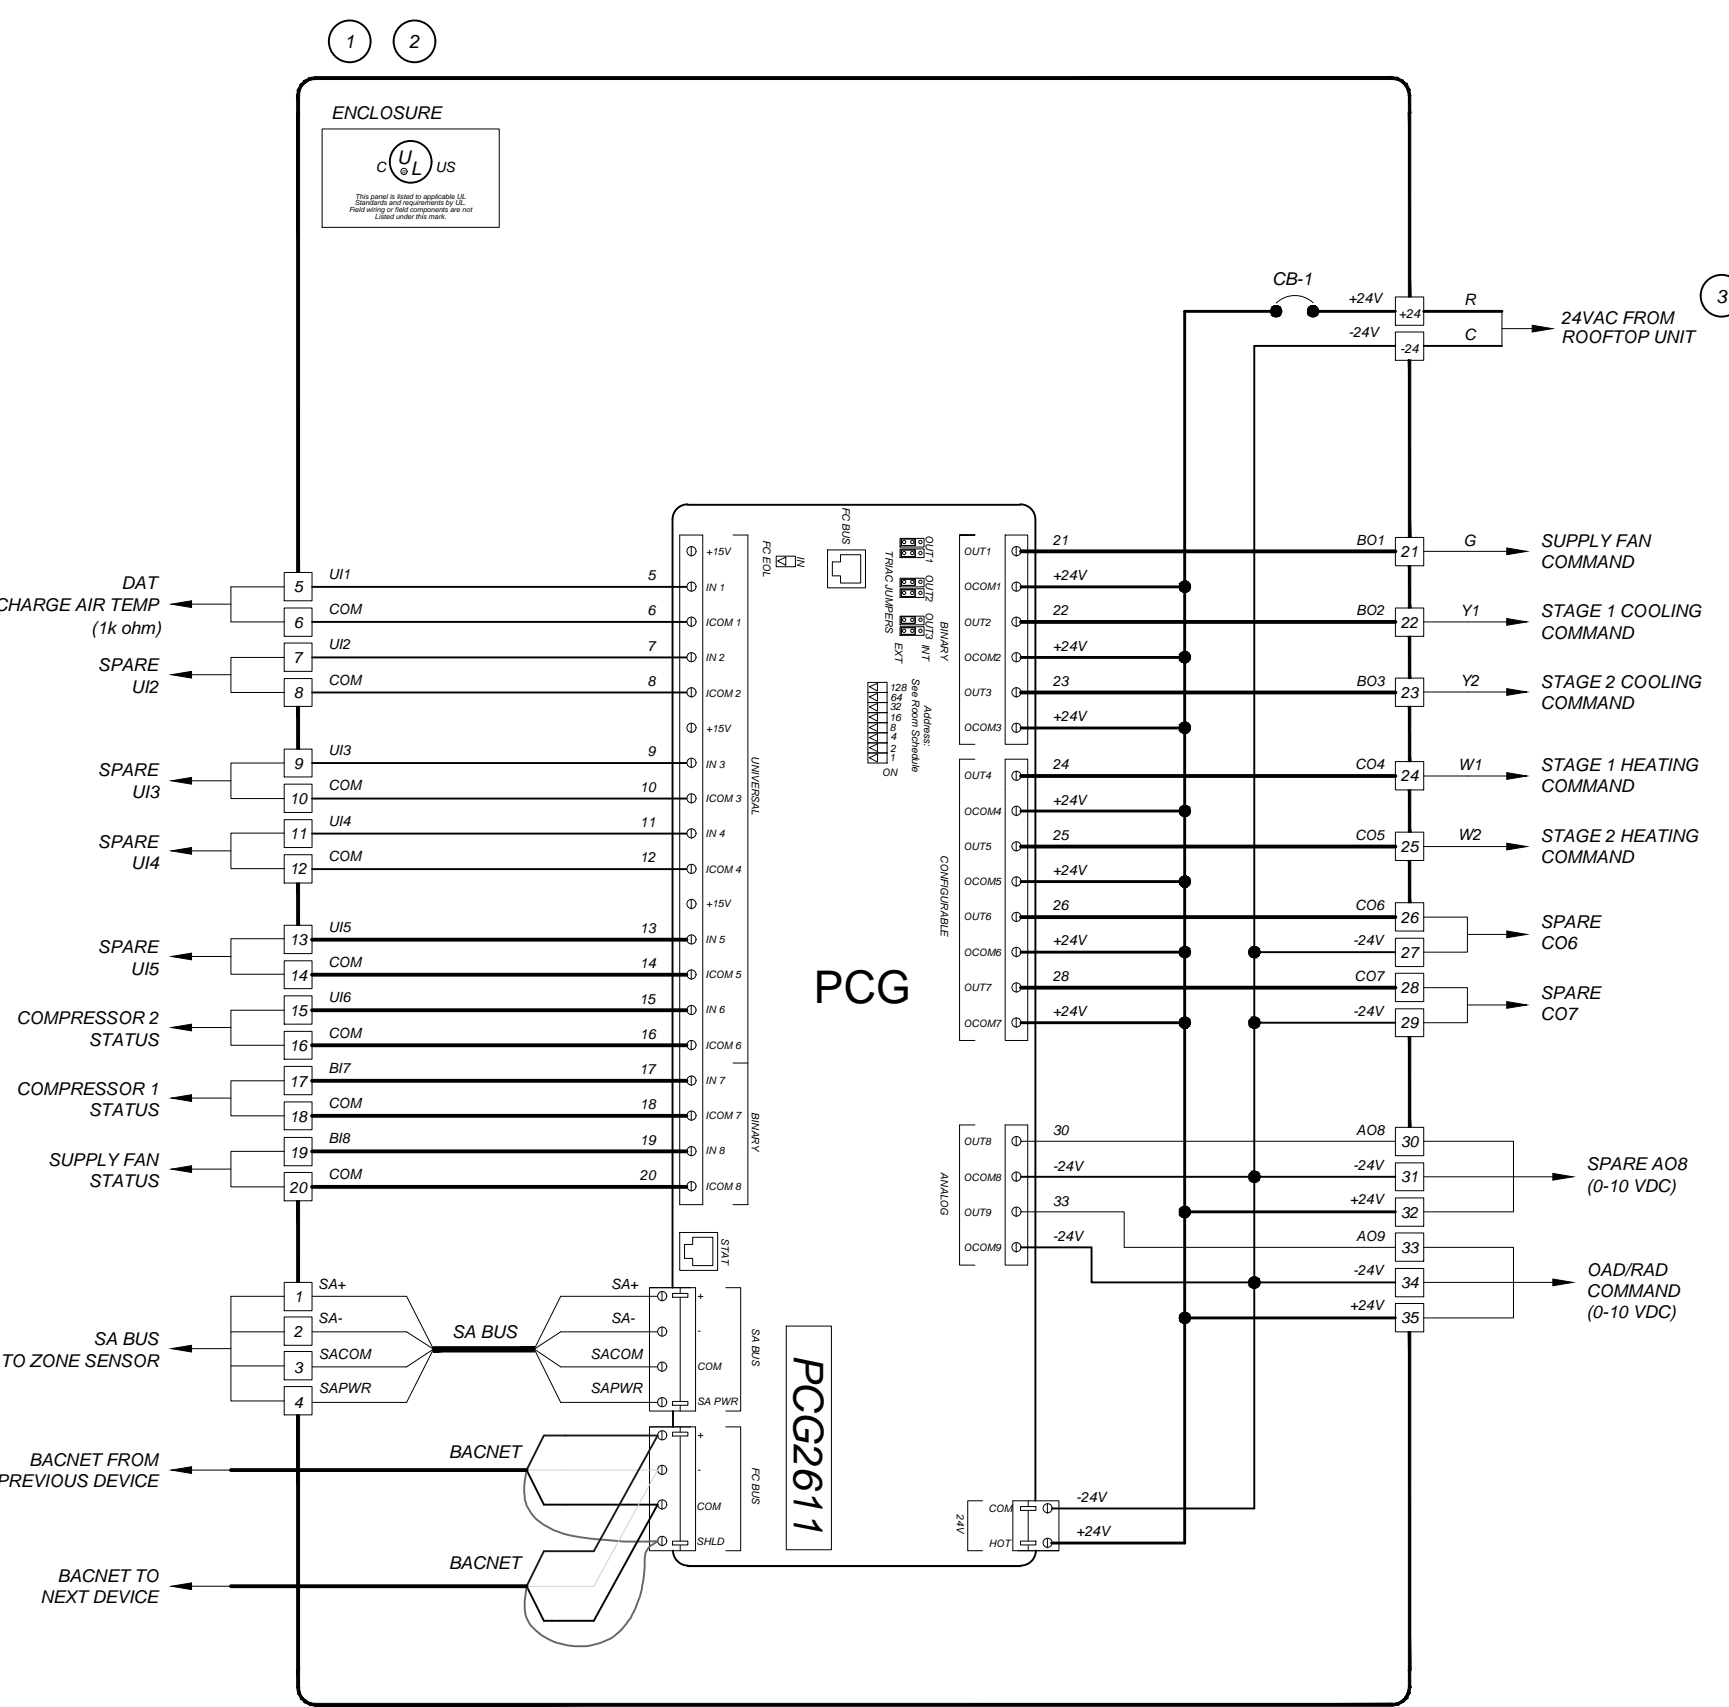

ROOF TOP UNIT TCP SCHEMATIC DETAIL 1


NOTE: ALL WIRES INSIDE OF PANEL TO BE LABELED AS SHOWN WITH HEAT SHRINK MARKERS ON TERMINATING ENDS OF WIRE.

Panel Components

TAG	DESCRIPTION
PCG	GENERAL PROGRAMMABLE CONTROLLER
ENC	SEE PLANS FOR NEMA RATING
ENC	BACKPLATE ENCLOSURE
ENC	PANEL LOCK KIT
CB-1	2.0 AMP CIRCUIT BREAKER

Details Notes

- CONTROL PANEL FABRICATED BY TOTAL CONTROL CONTACT DEVEN PUTNAM 559-291-1000
- PANEL SHALL BE UL LISTED
- LINE VOLTAGE & CONDUIT BY DIVISION 16.

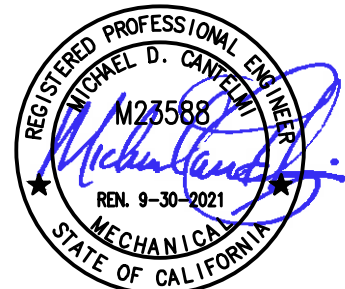

EMS REPLACEMENT
BURROUGHS ELEMENTARY SCHOOL
166 N SIERRA VISTA AVE., FRESNO, CA 93702
FRESNO UNIFIED SCHOOL DISTRICT
4600 N. BRAWLEY AVE., FRESNO, CA.

REVISIONS	
4/22/21	EMS REVISIONS
1	
2	
3	
4	
5	


LAWRENCE
ENGINEERING GROUP
Fresno, CA 93720
(559) 431-0101
7084 N. Maple Ave., Suite 101
(559) 431-1362

TITLE:
ENERGY
MANAGEMENT
DETAILS

SHEET:
M8
PROJECT 20140

Control Components	
TAG	DESCRIPTION
DAT	DUCT TEMP SENSOR
SFCS/CUCS	CURRENT SENSOR
RIB	24VAC RELAY IN A BOX
NZS	NETWORK ZONE SENSOR W/ CO

Detail Notes	
1	LINE VOLTAGE & CONDUIT BY DIVISION 16.
2	UNIT SHALL SHUT DOWN UPON DETECTION OF SMOKE. WIRE ACCORDINGLY.
3	CONTROL COMPONENTS PROVIDED BY TOTAL CONTROL CONTACT DEVEN PUTNAM AT 559-291-1000.
4	SEE DETAIL B/M-8 FOR TCP DIAGRAM.

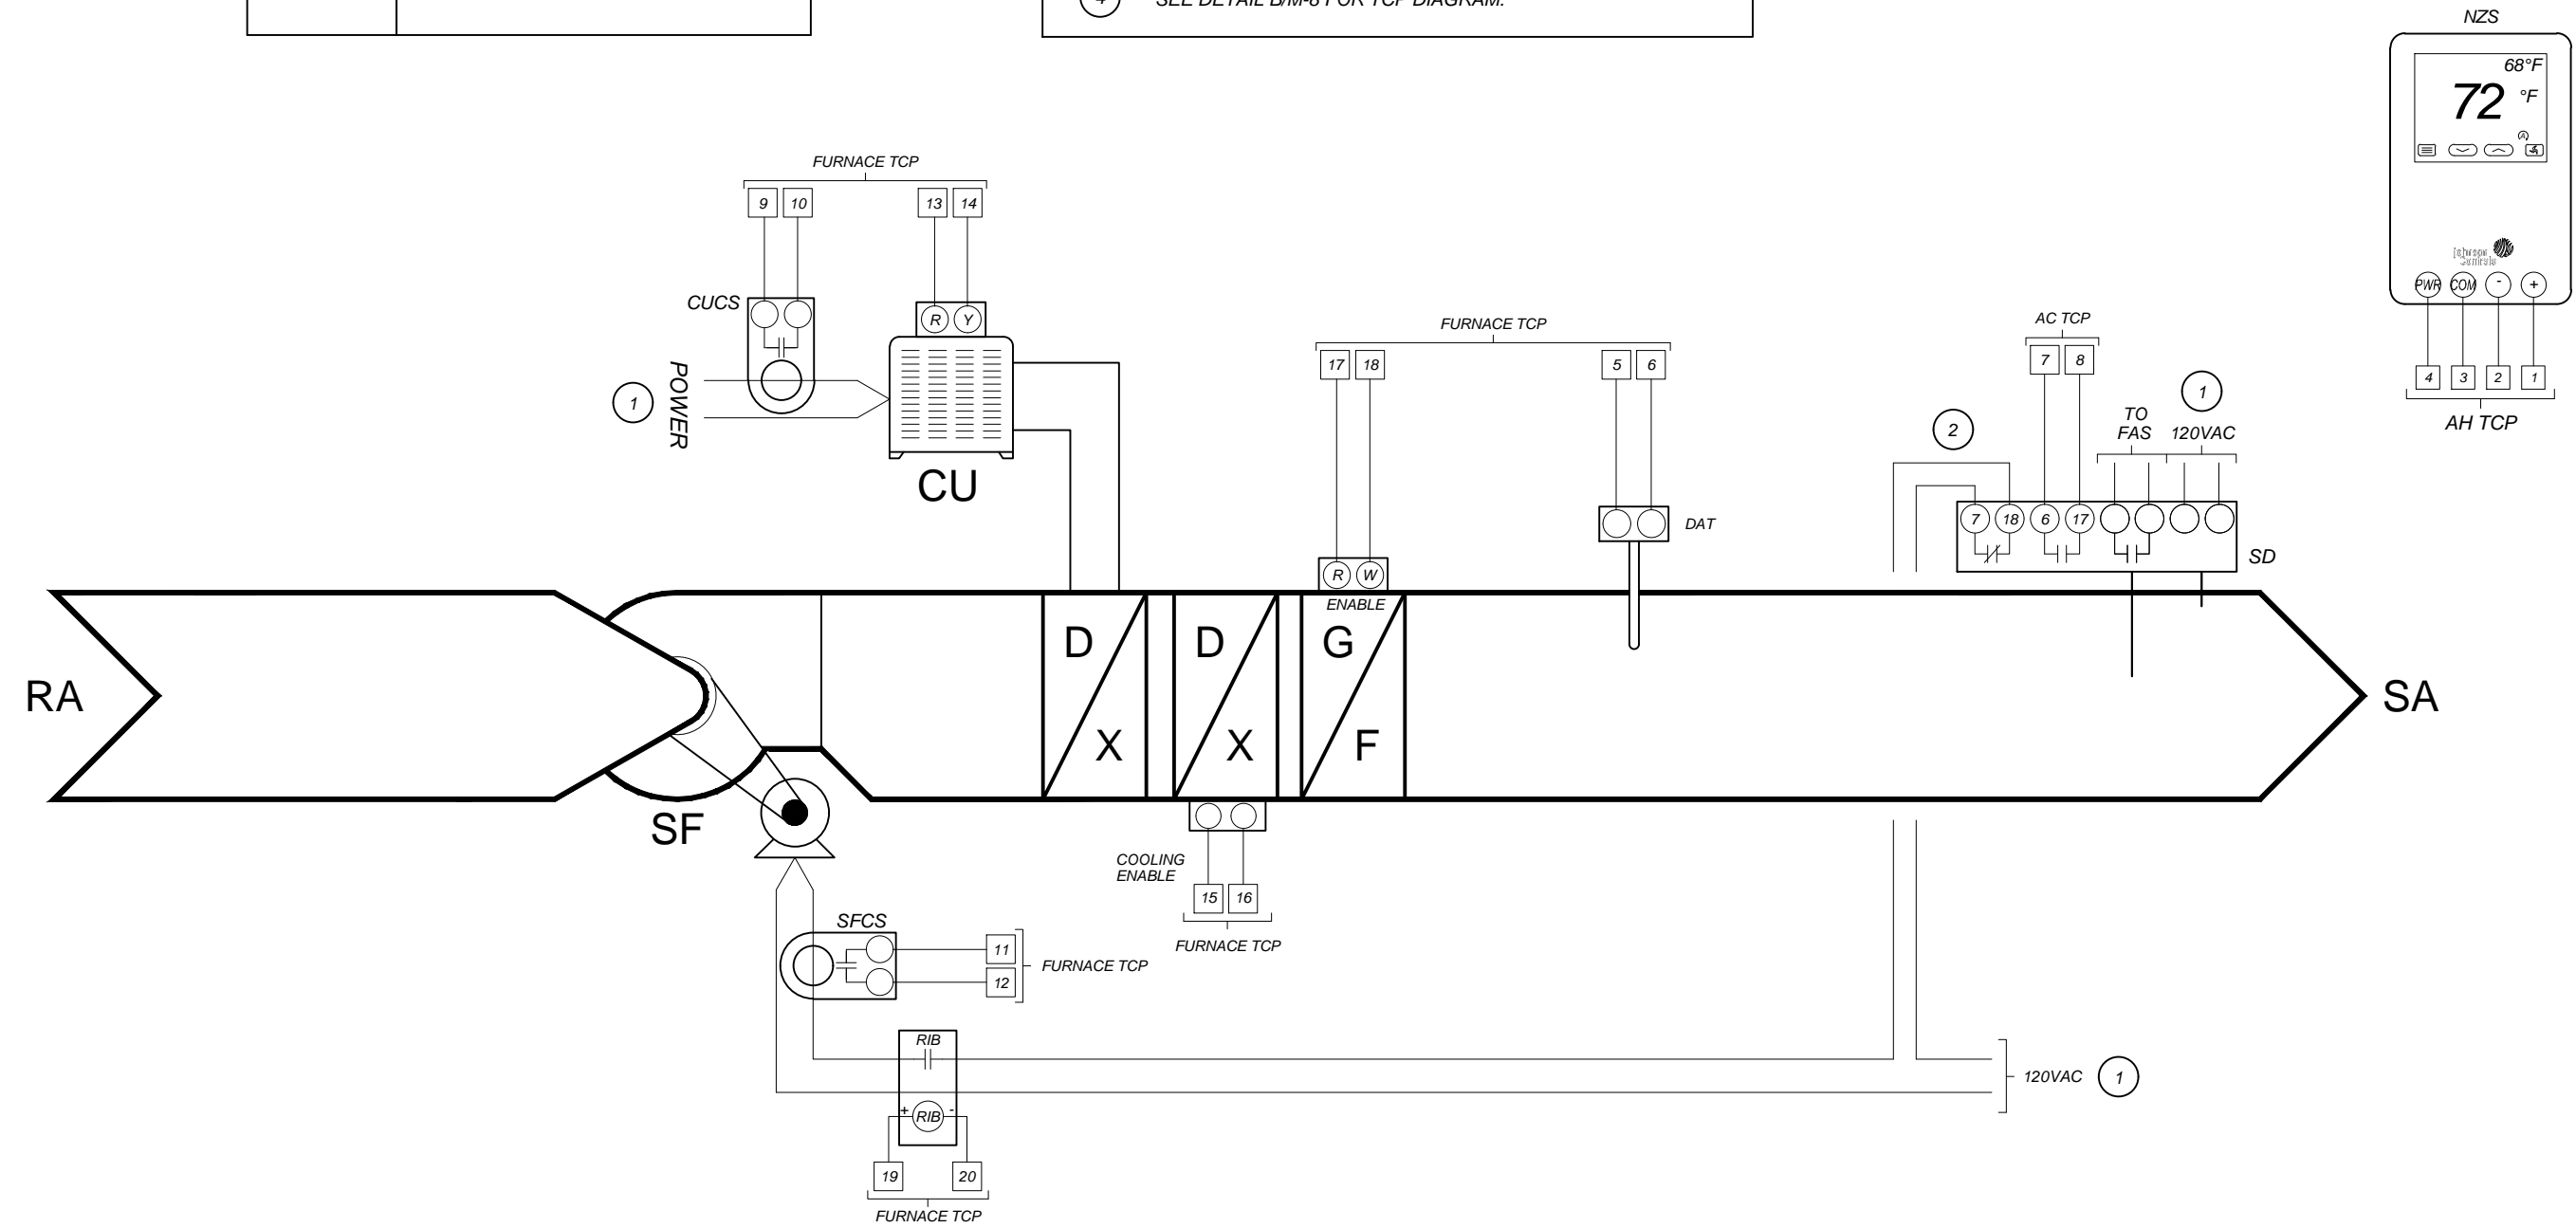


FURNACE C1/F-1 CONTROL DETAIL

A
M-8

Panel Components	
TAG	DESCRIPTION
PCG	GENERAL PROGRAMMABLE CONTROLLER
ENC	SEE SPEC'S FOR NEMA RATING
ENC	BACKPLATE ENCLOSURE
ENC	PANEL LOCK KIT
CB-1	2.0 AMP CIRCUIT BREAKER
XF	96VA 24VAC TRANSFORMER
R1-R3	2-POLE 24VAC RELAY W/ LED
R1-R3	2-POLE RELAY BASE

Detail Notes	
1	CONTROL PANELS FABRICATED BY TOTAL CONTROL CONTACT DEVEN PUTNAM AT 559-291-1000
2	PANEL SHALL BE UL LISTED
3	LINE VOLTAGE AND CONDUIT BY DIVISION 16.

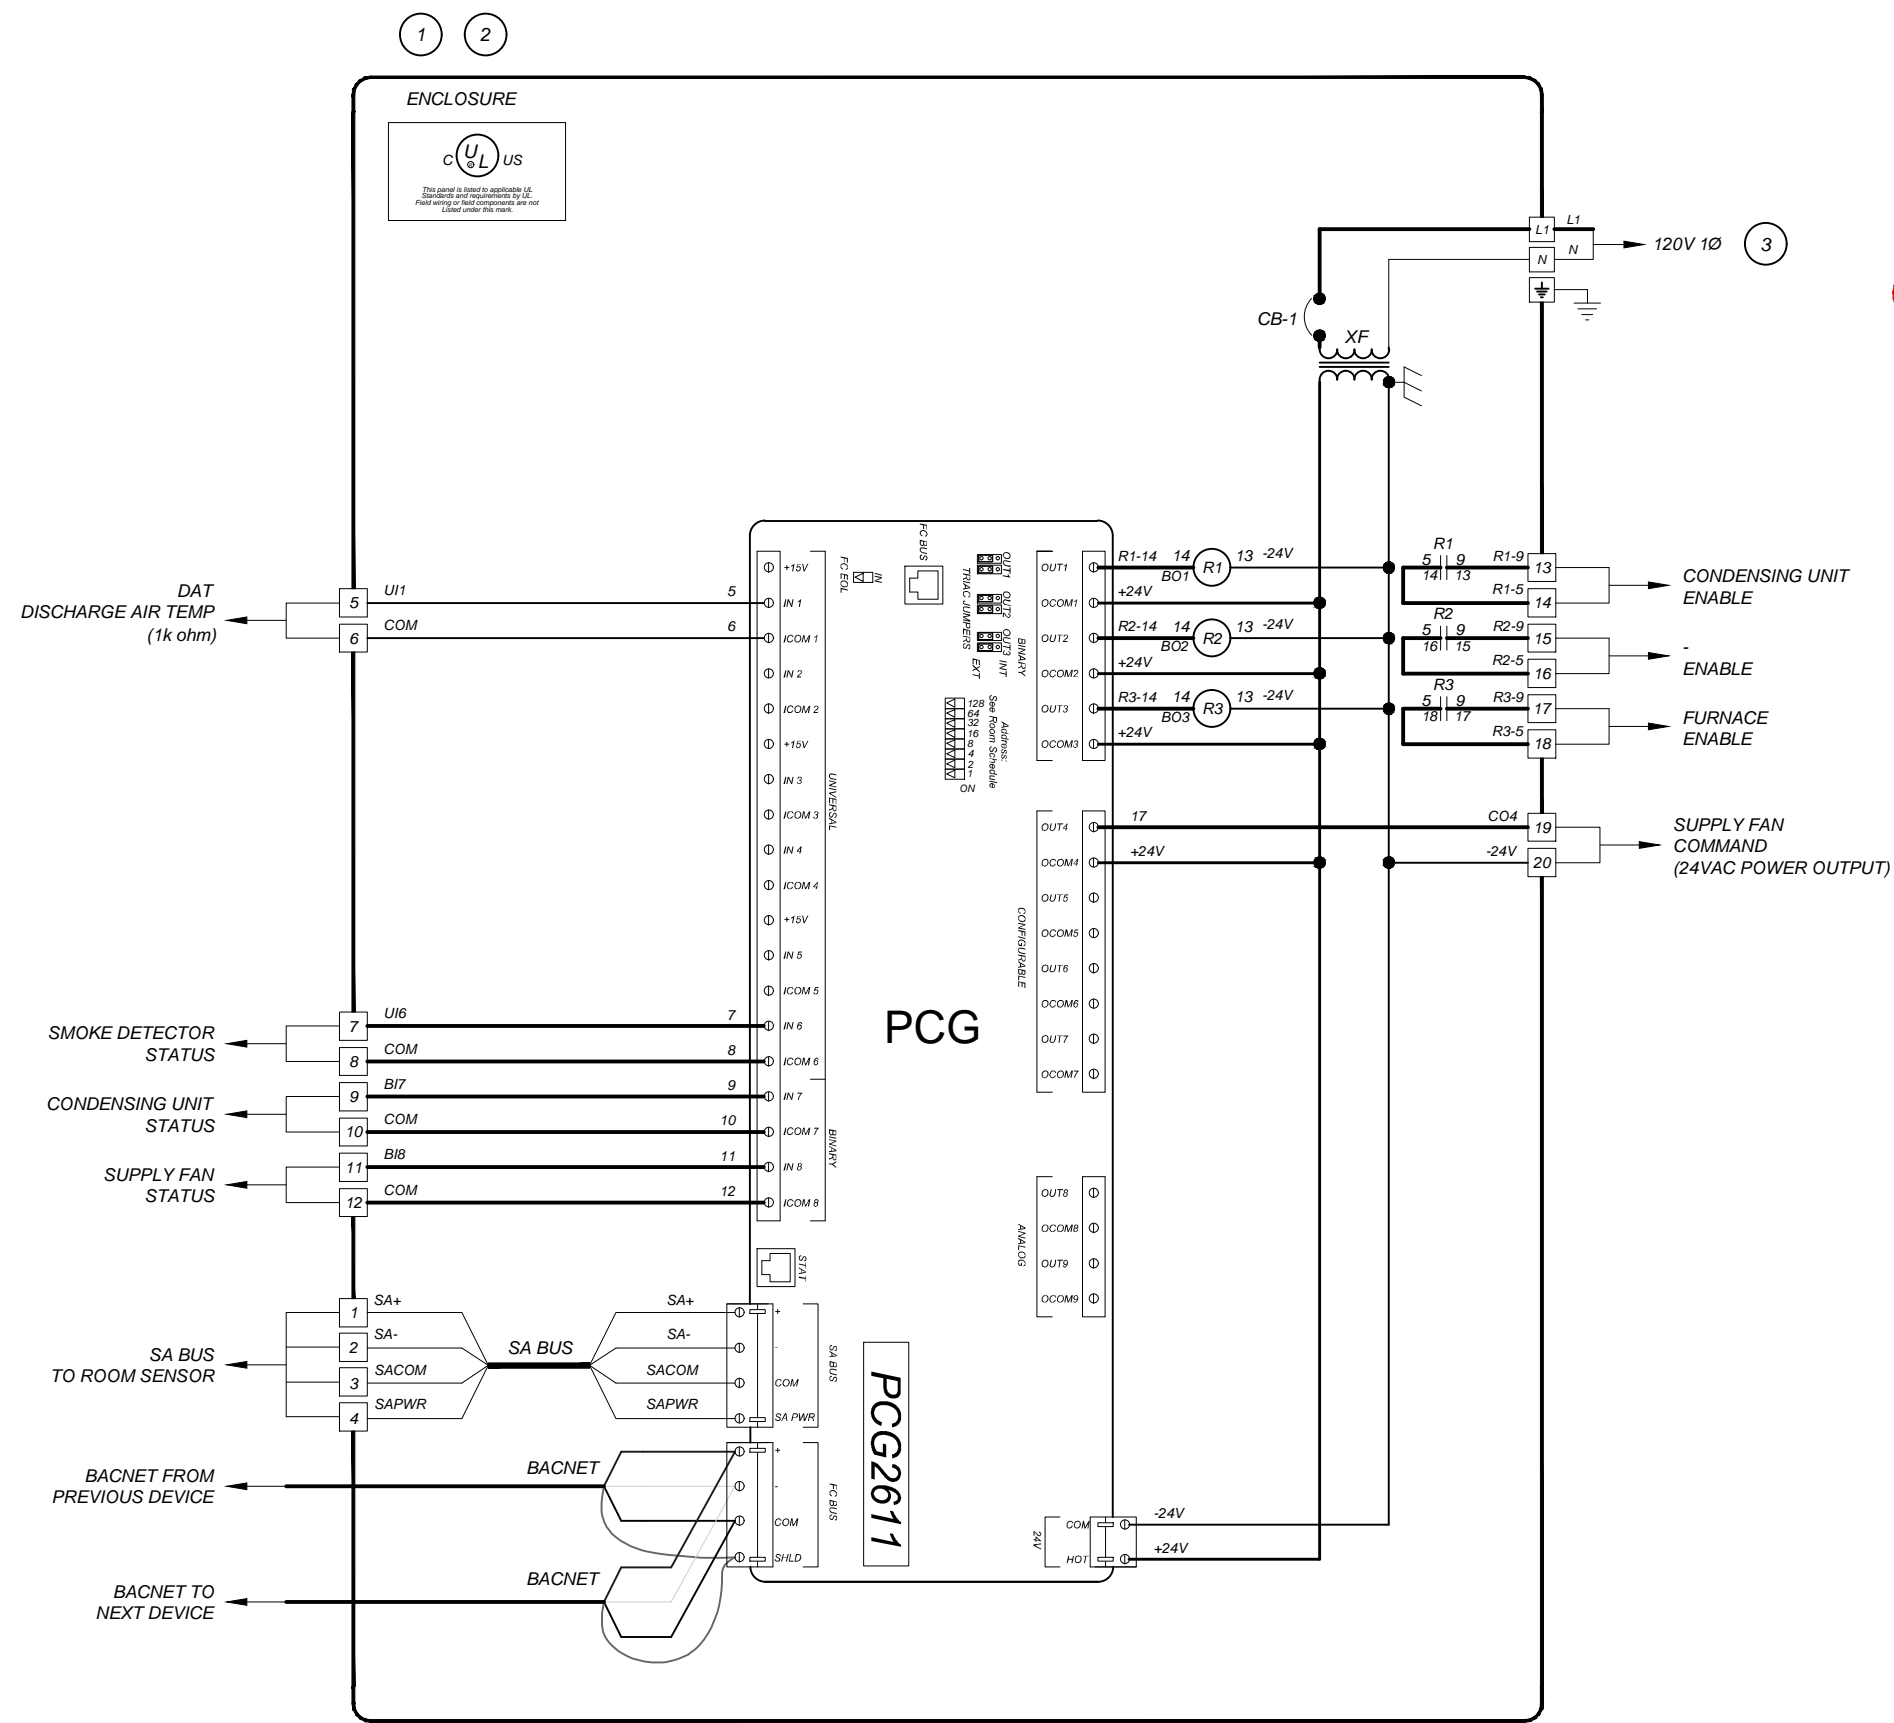


FURNACE TCP SCHEMATIC DETAIL

B
M-8

Control Components	
TAG	DESCRIPTION
DAT	DUCT TEMP SENSOR
SFCS, CCS	CURRENT SENSOR
NZS	NETWORK ZONE SENSOR WITH CO2
OAD	DAMPER ACTUATOR

Sheet Notes	
1	LINE VOLTAGE & CONDUIT BY DIVISION 16.
2	CONTROL COMPONENTS PROVIDED BY TOTAL CONTROL CONTACT DEVEN PUTNAM AT 559-291-1000
3	SEE DETAIL D/M-8 FOR TCP DIAGRAM.

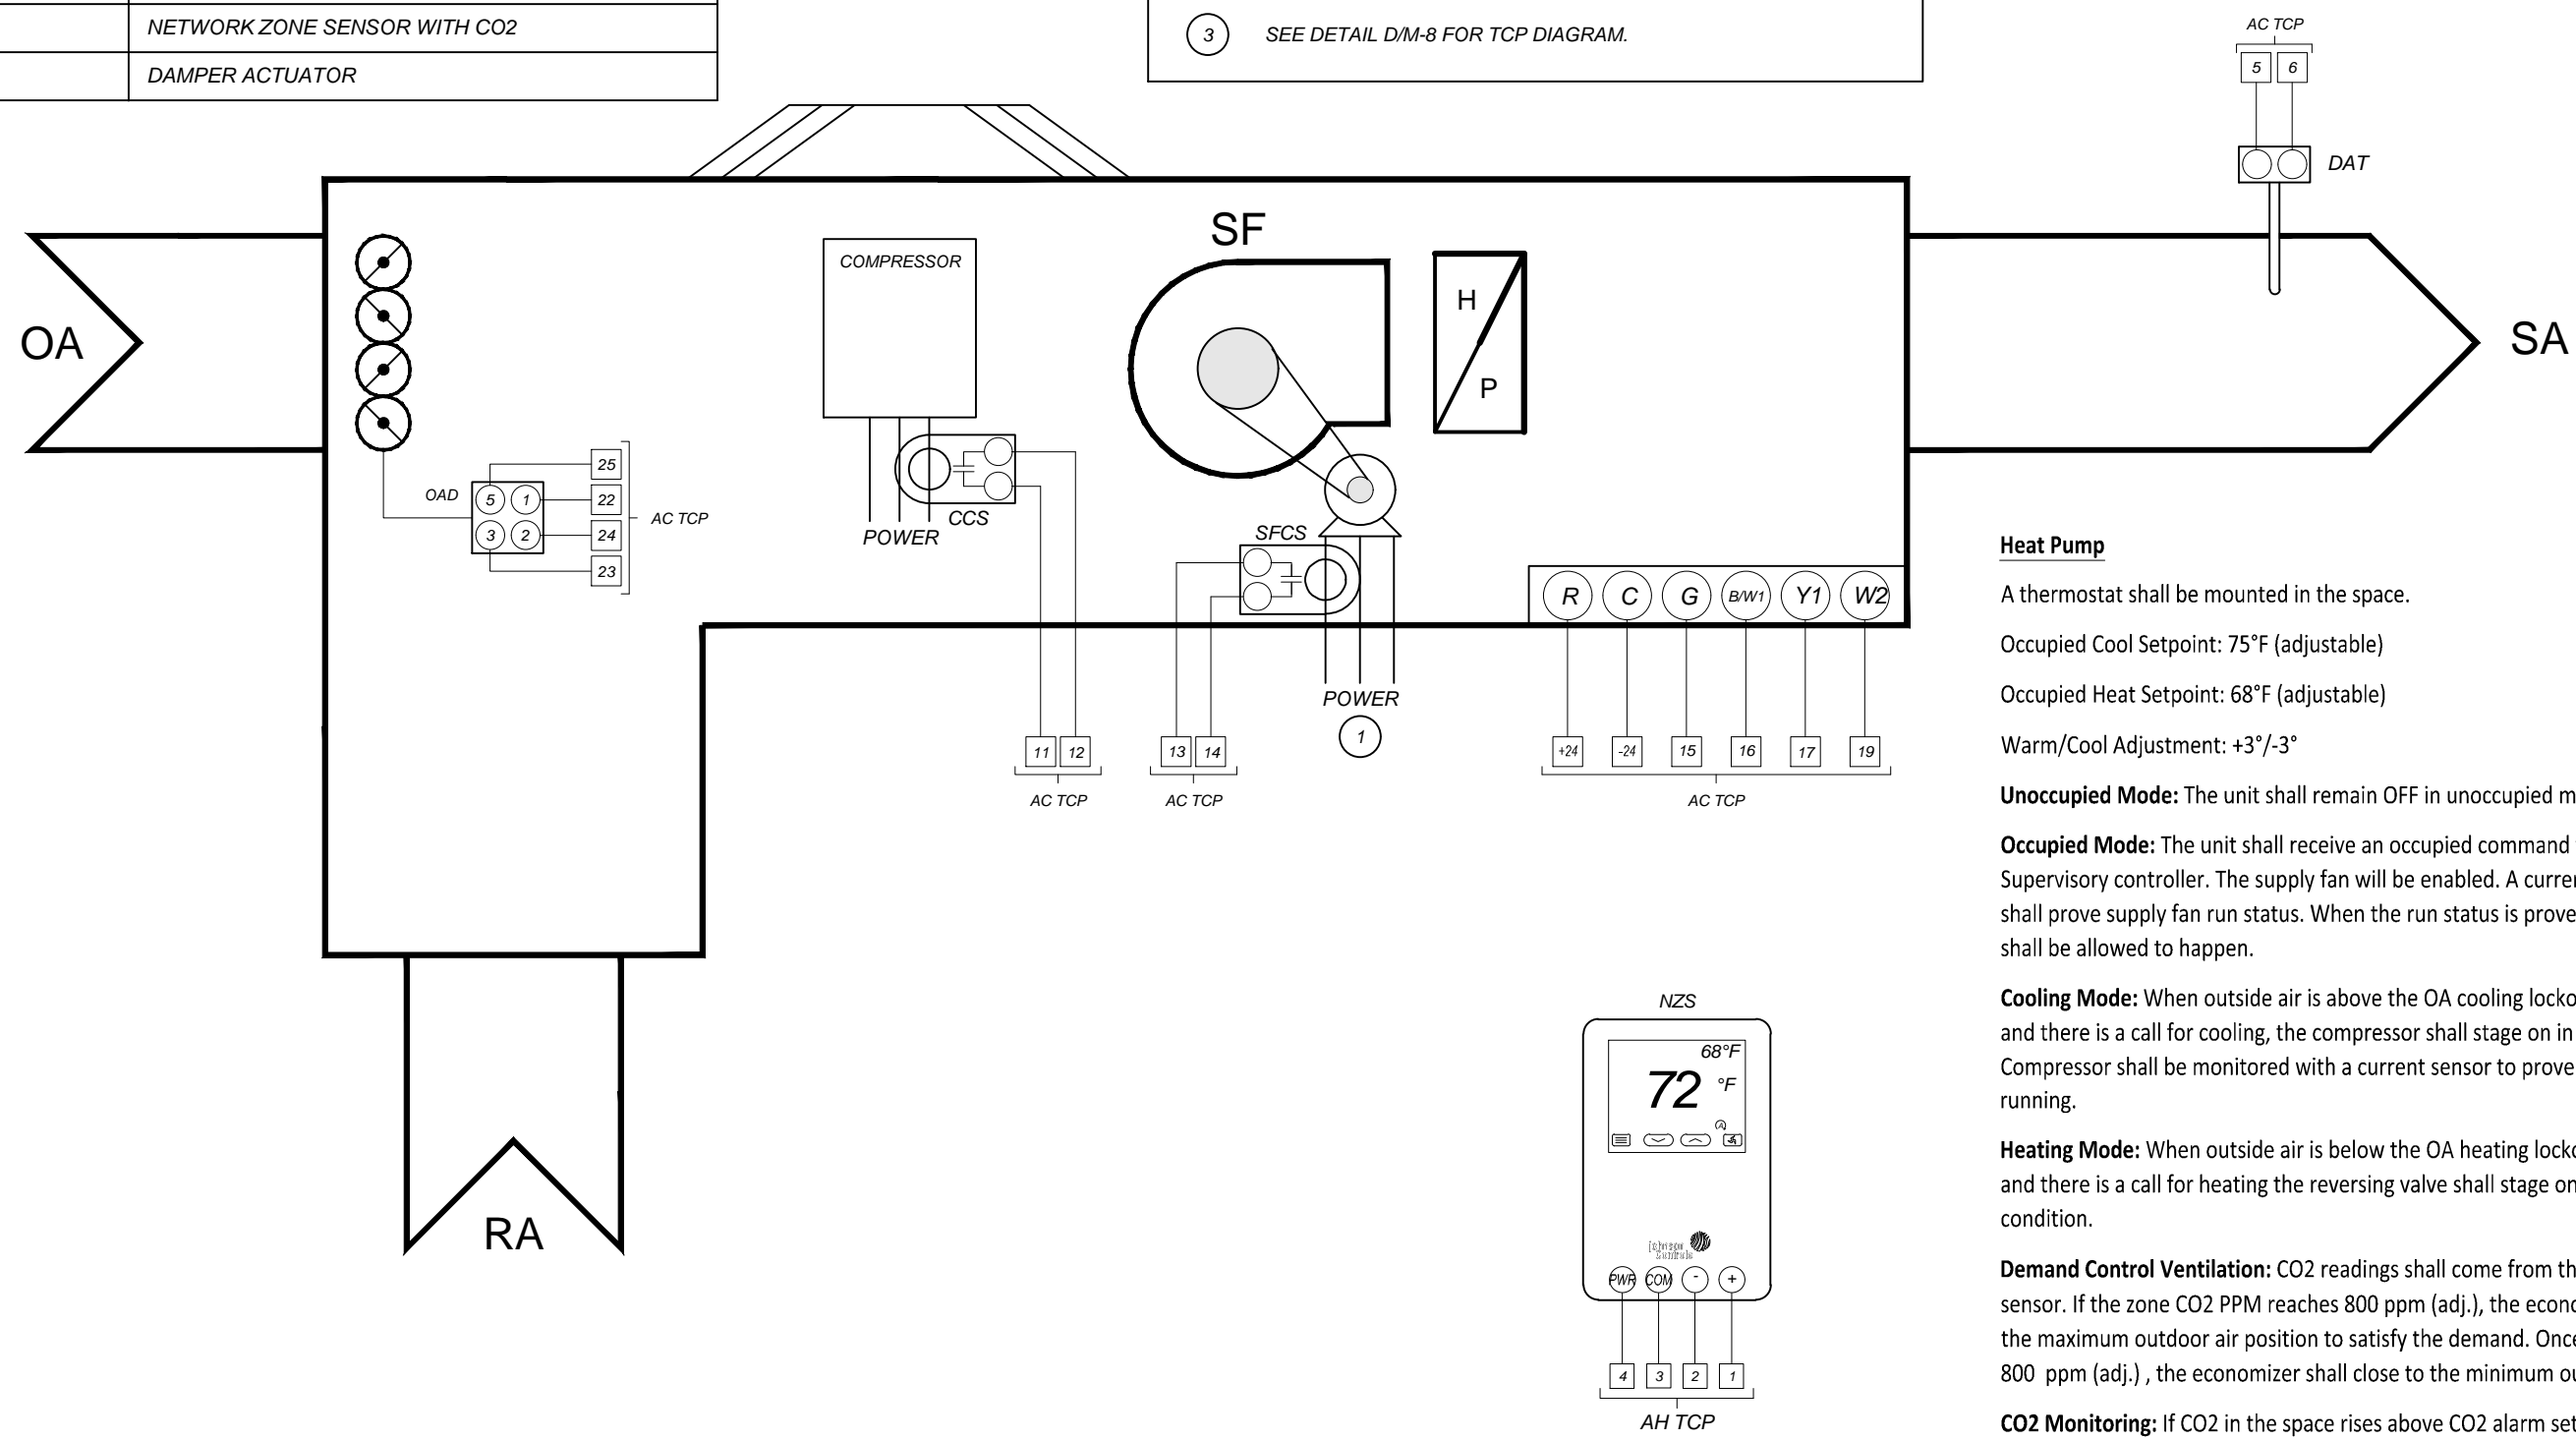

WALL MOUNTED HEAT PUMP CONTROL DETAIL

C
M-8

Heat Pump

A thermostat shall be mounted in the space.

Occupied Cool Setpoint: 75°F (adjustable)

Occupied Heat Setpoint: 68°F (adjustable)

Warm/Cool Adjustment: +3°/-3°

Unoccupied Mode: The unit shall remain OFF in unoccupied mode.


Occupied Mode: The unit shall receive an occupied command from the Johnson FX Supervisory controller. The supply fan will be enabled. A current sensor on the supply fan shall prove supply fan run status. When the run status is proven ON, the following modes shall be allowed to happen.

Cooling Mode: When outside air is above the OA cooling lockout setpoint (65° F adjustable) and there is a call for cooling, the compressor shall stage on in order to satisfy the condition. Compressor shall be monitored with a current sensor to prove that the compressor is running.

Heating Mode: When outside air is below the OA heating lockout setpoint (60° F adjustable) and there is a call for heating the reversing valve shall stage on in order to satisfy the condition.

Demand Control Ventilation: CO2 readings shall come from the wall mount Temp/CO2 sensor. If the zone CO2 PPM reaches 800 ppm (adj.), the economizer shall modulate open to the maximum outdoor air position to satisfy the demand. Once the CO2 level drops below 800 ppm (adj.), the economizer shall close to the minimum outdoor air position.

CO2 Monitoring: If CO2 in the space rises above CO2 alarm setpoint (adj.), the system will generate a Niagara alarm.

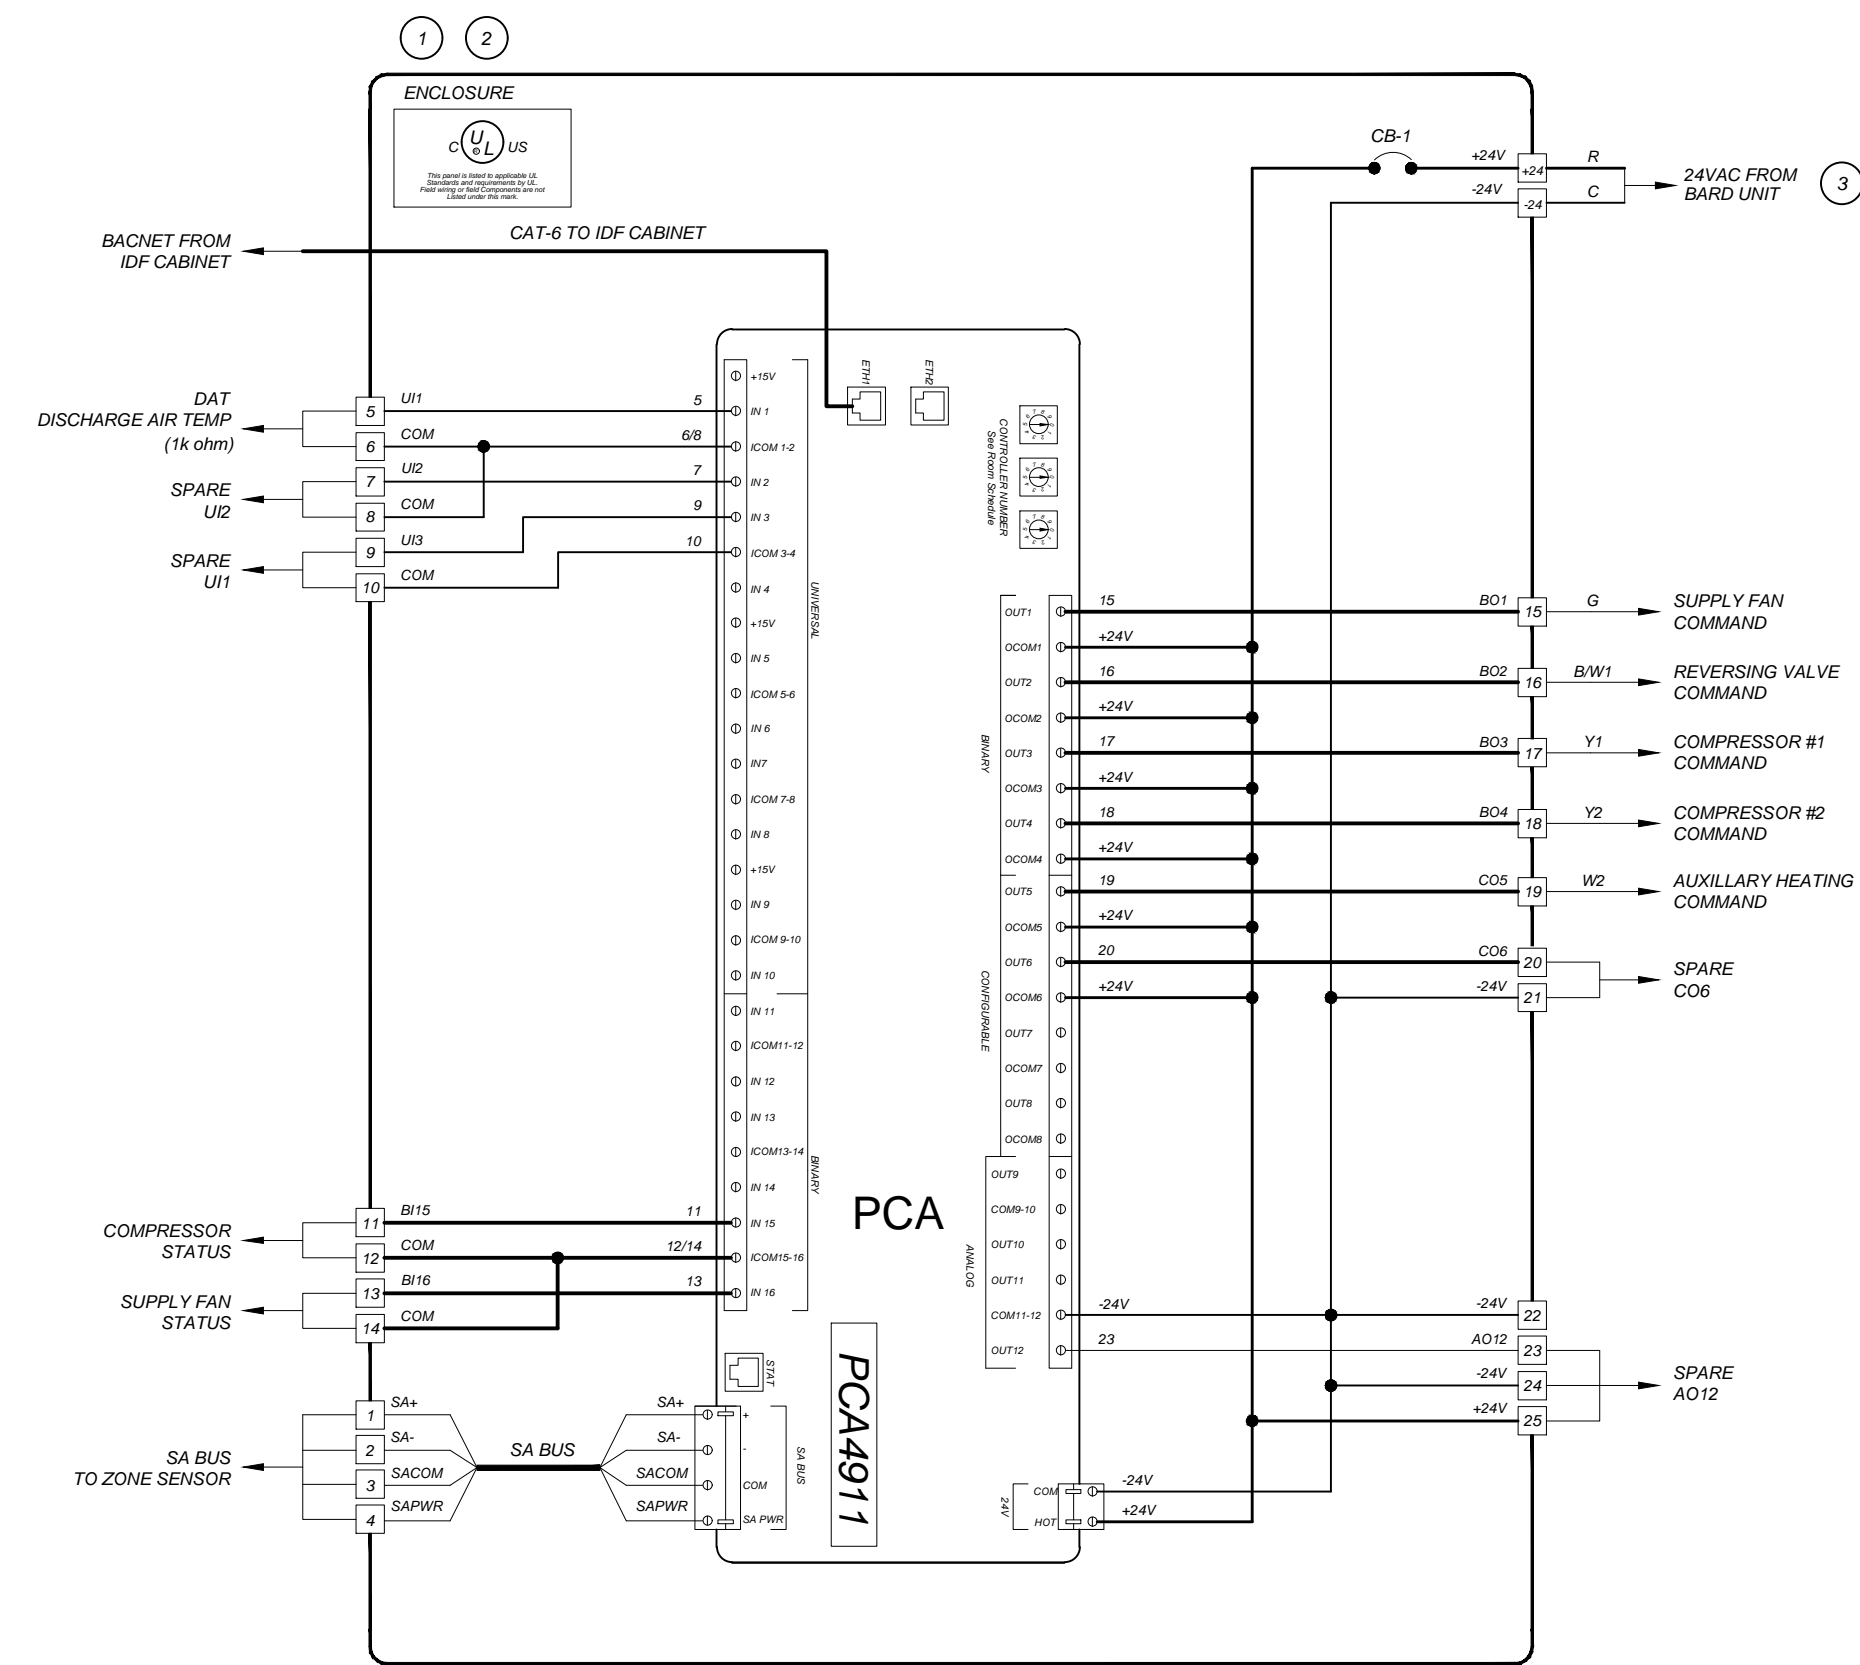


WALL MOUNTED HEAT PUMP TCP SCHEMATIC DETAIL


D
M-8

Panel Components	
TAG	DESCRIPTION
PCA	ADVANCED PROGRAMMABLE CONTROLLER
CB-1	MANUAL RESET 2.0 AMP CIRCUIT BREAKER
ENC	SEE SPEC'S FOR NEMA RATING
ENC	BACKPLATE ENCLOSURE
ENC	PANEL LOCK KIT
TCP	TCP LABEL

Details Notes	
1	CONTROL PANEL FABRICATED BY TOTAL CONTROL CONTACT DEVEN PUTNAM AT 559-291-1000.
2	PANEL SHALL BE UL LISTED
3	LINE VOLTAGE & CONDUIT BY DIVISION 16.

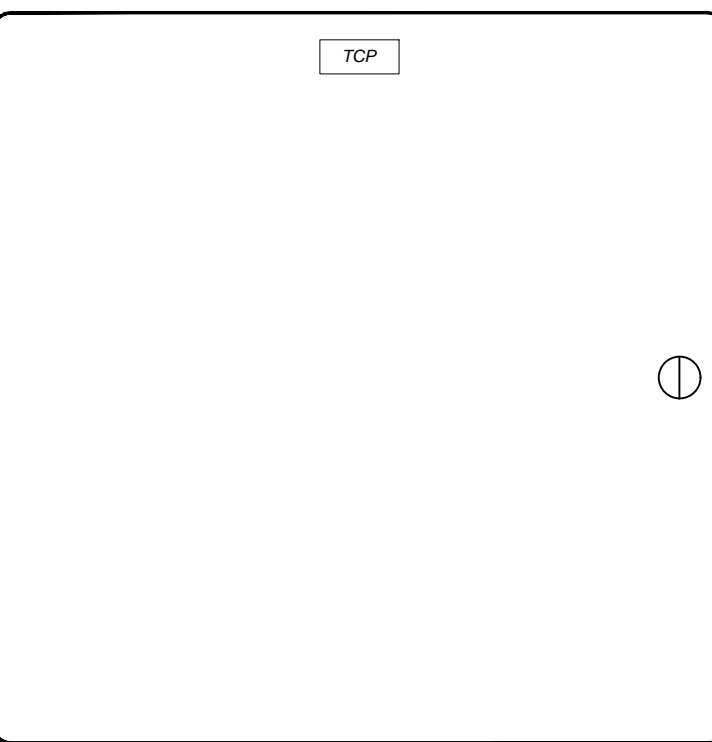

PANEL DOOR LAYOUT

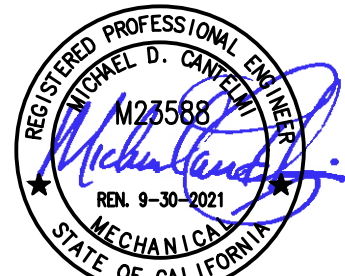

DATE: 11-25-2020

EMS REPLACEMENT
BURROUGHS ELEMENTARY SCHOOL
166 N SIERRA VISTA AVE. FRESNO, CA 93702
FRESNO UNIFIED SCHOOL DISTRICT
4600 N. BRAWLEY AVE. FRESNO, CA.

REVISIONS	
4/22/21	EMS REVISIONS
1	
2	
3	
4	
5	

LAWRENCE
ENGINEERING GROUP
Fresno, CA 93720
(559) 431-1362
7084 N. Maple Ave., Suite 101
(559) 431-0101

TITLE:
ENERGY
MANAGEMENT
DETAILS

SHEET:
M9
PROJECT: 20140

Control Components		
TAG	QTY	DESCRIPTION
DAT	-	DUCT TEMP SENSOR
CCS,SFCS	-	CURRENT SENSOR
NZS	-	NETWORK ZONE SENSOR WITH CO2
OAD/RAD	-	SPRING RETURN DAMPER ACTUATOR

Sheet Notes	
1	LINE VOLTAGE & CONDUIT BY DIVISION 16.
2	OAT GLOBALLY SHARED SOFTWARE POINT
3	CONTROL COMPONENTS PROVIDED BY TOTAL CONTROL CONTACT DEVEN PUTNAM AT 559-291-1000.
4	REFER TO DETAIL F1M9

Package Unit

A thermostat shall be mounted in the space.

Occupied Cool Setpoint: 75°F (adjustable)

Occupied Heat Setpoint: 68°F (adjustable)

Warm/Cool Adjustment: +3/-3°

Unoccupied Mode: The unit shall remain OFF in unoccupied mode.


Occupied Mode: The unit shall receive an occupied command from the Johnson FX Supervisory controller. The supply fan will be enabled. A current sensor on the supply fan shall prove supply fan run status. When the run status is proven ON, the following modes shall be allowed to happen.

Cooling Mode: When outside air is above the OA cooling lockout setpoint (65° F adjustable) and there is a call for cooling, the compressor shall stage on in order to satisfy the condition. Compressor shall be monitored with a current sensor to prove that the compressor is running.

Heating Mode: When outside air is below the OA heating lockout setpoint (60° F adjustable) and there is a call for heating the reversing valve shall stage on in order to satisfy the condition.

Demand Control Ventilation: CO2 readings shall come from the wall mount Temp/CO2 sensor. If the zone CO2 PPM reaches 800 ppm (adj.), the economizer shall modulate open to the maximum outdoor air position to satisfy the demand. Once the CO2 level drops below 800 ppm (adj.), the economizer shall close to the minimum outdoor air position.

CO2 Monitoring: If CO2 in the space rises above CO2 alarm setpoint (adj.), the system will generate a Niagara alarm.

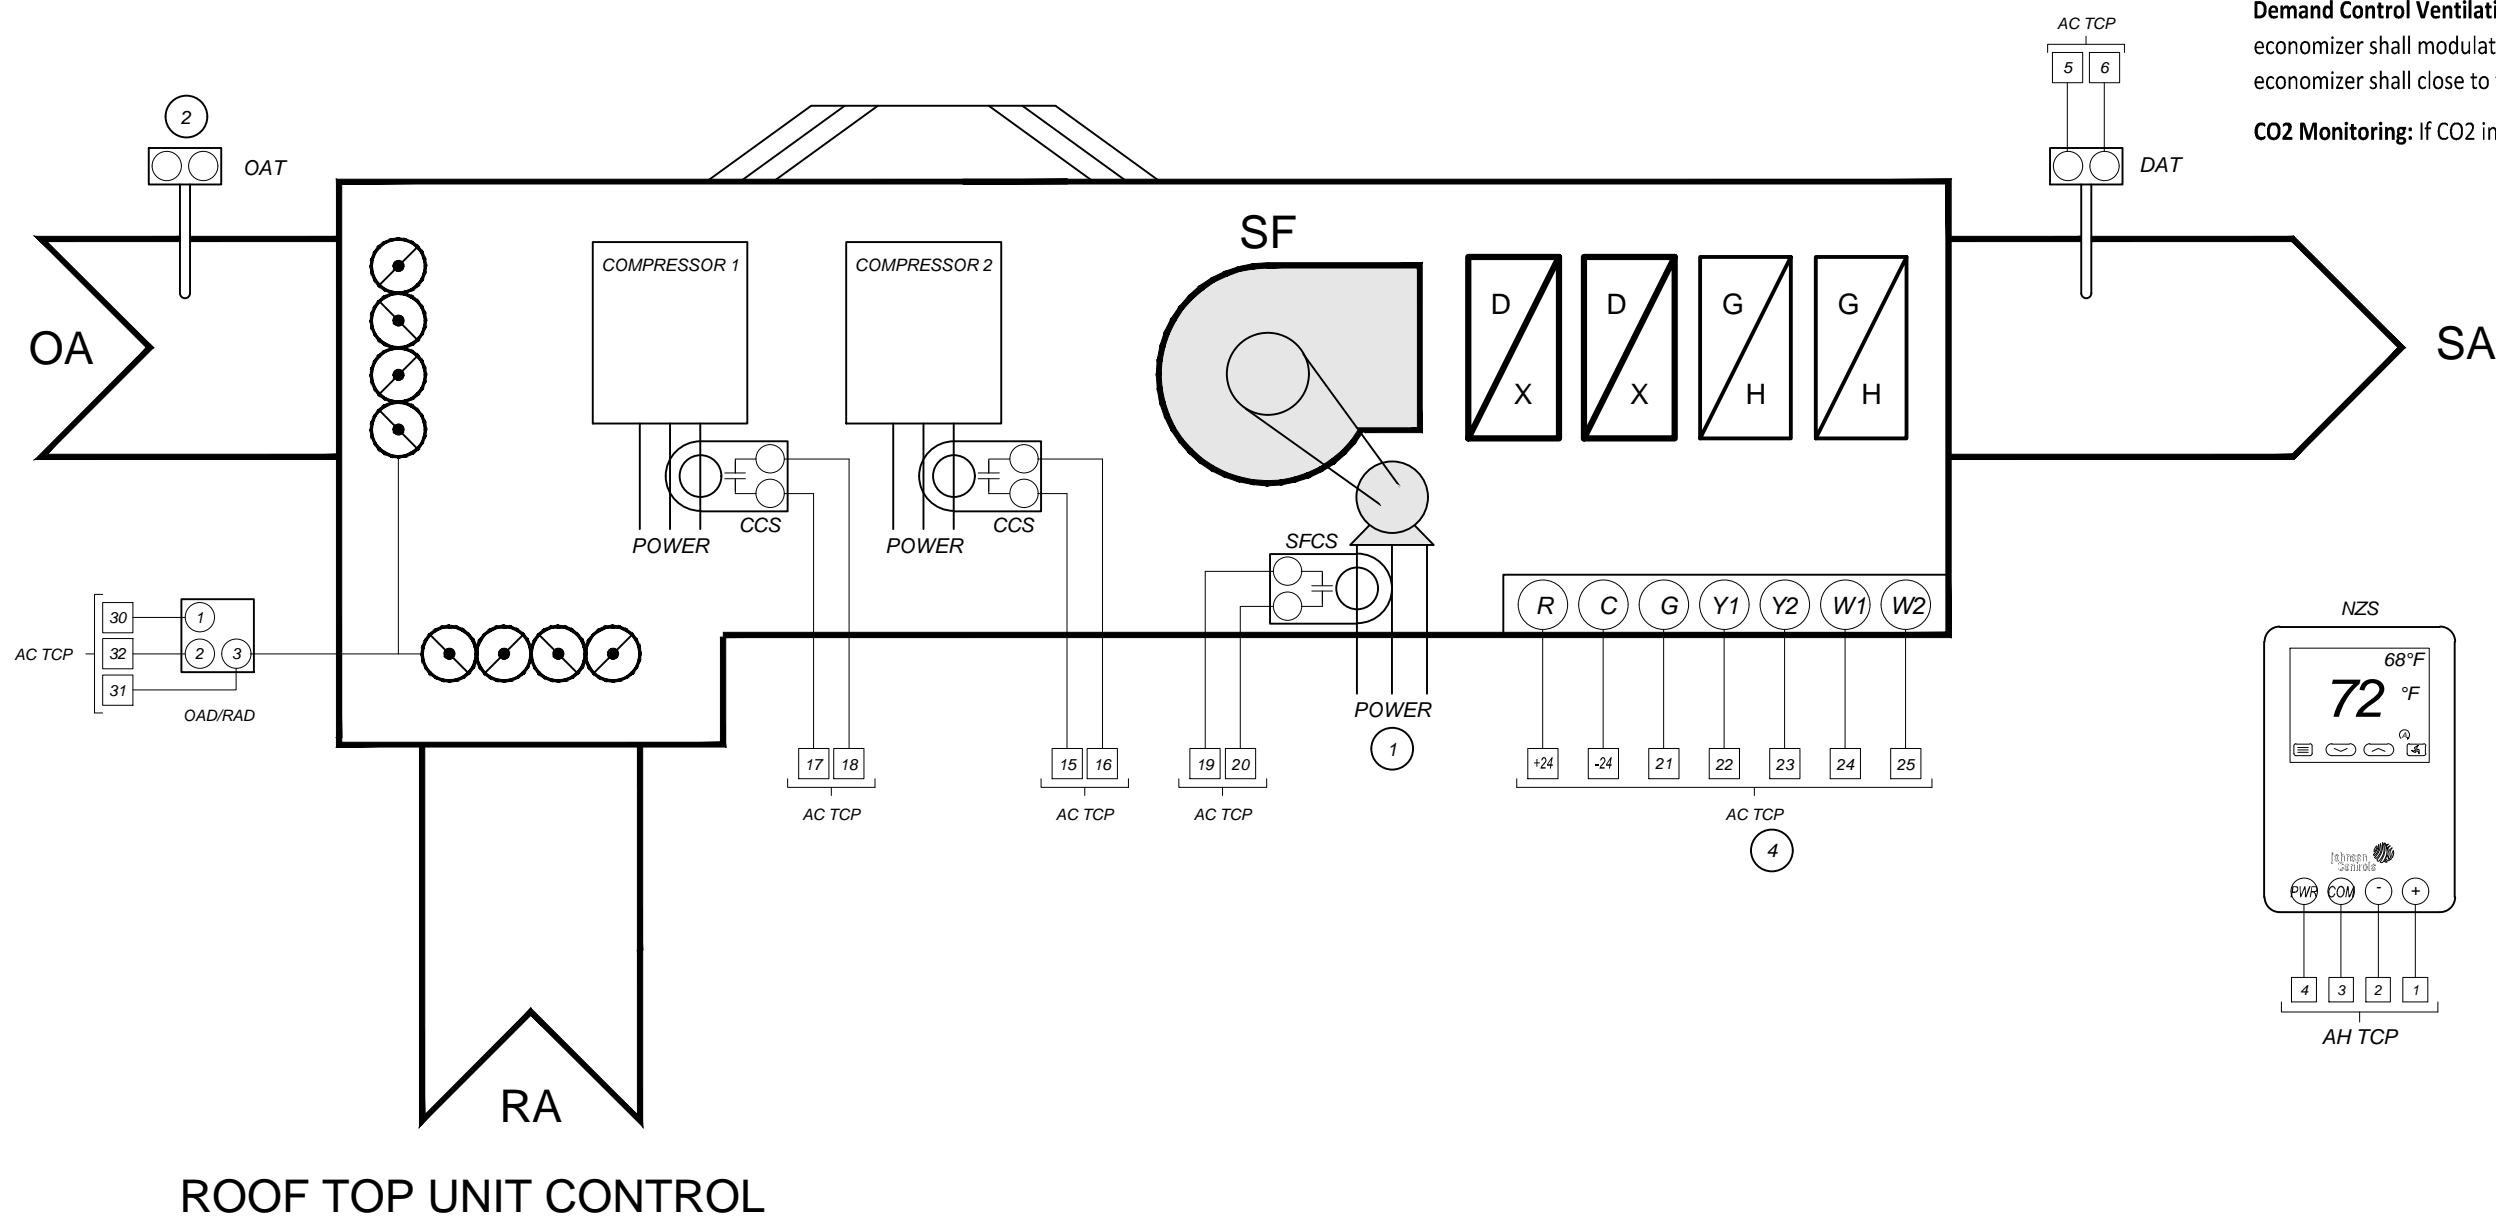


E
M9

NOTE: ALL WIRES INSIDE OF PANEL TO BE LABELED AS SHOWN WITH HEAT SHRINK MARKERS ON TERMINATING ENDS OF WIRE.

Panel Components	
TAG	DESCRIPTION
PCA	ADVANCED PROGRAMMABLE CONTROLLER
CB-1	MANUAL RESET 2.0 AMP CIRCUIT BREAKER
ENC	SEE SPEC'S FOR NEMA RATING
ENC	BACKPLATE ENCLOSURE
ENC	PANEL LOCK KIT
TCP	TCP LABEL


Sheet Notes

- CONTROL PANEL FABRICATED BY TOTAL CONTROL CONTACT DEVEN PUTNAM AT 559-291-1000.
- PANEL SHALL BE UL LISTED
- LINE VOLTAGE & CONDUIT BY DIVISION 16.

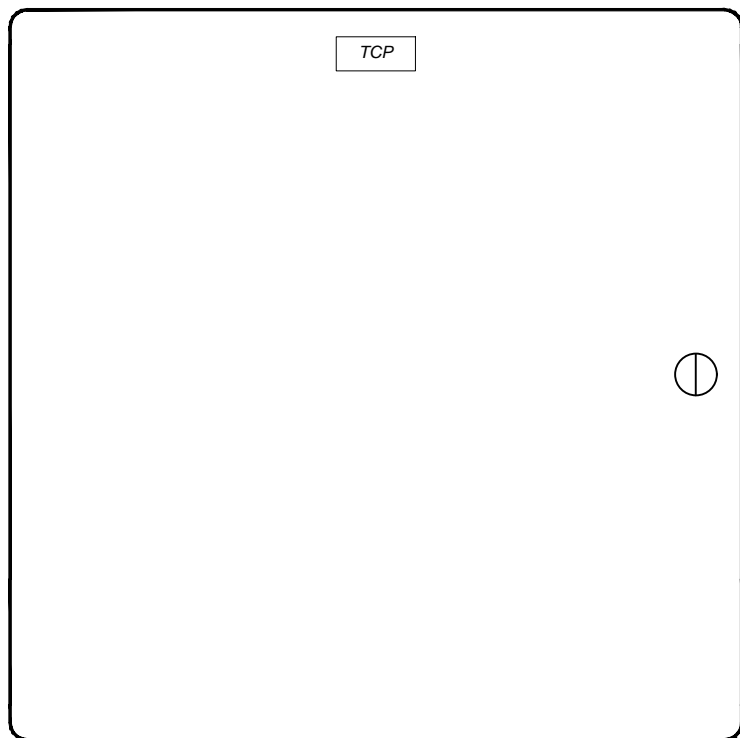


PANEL DOOR LAYOUT

F
M9

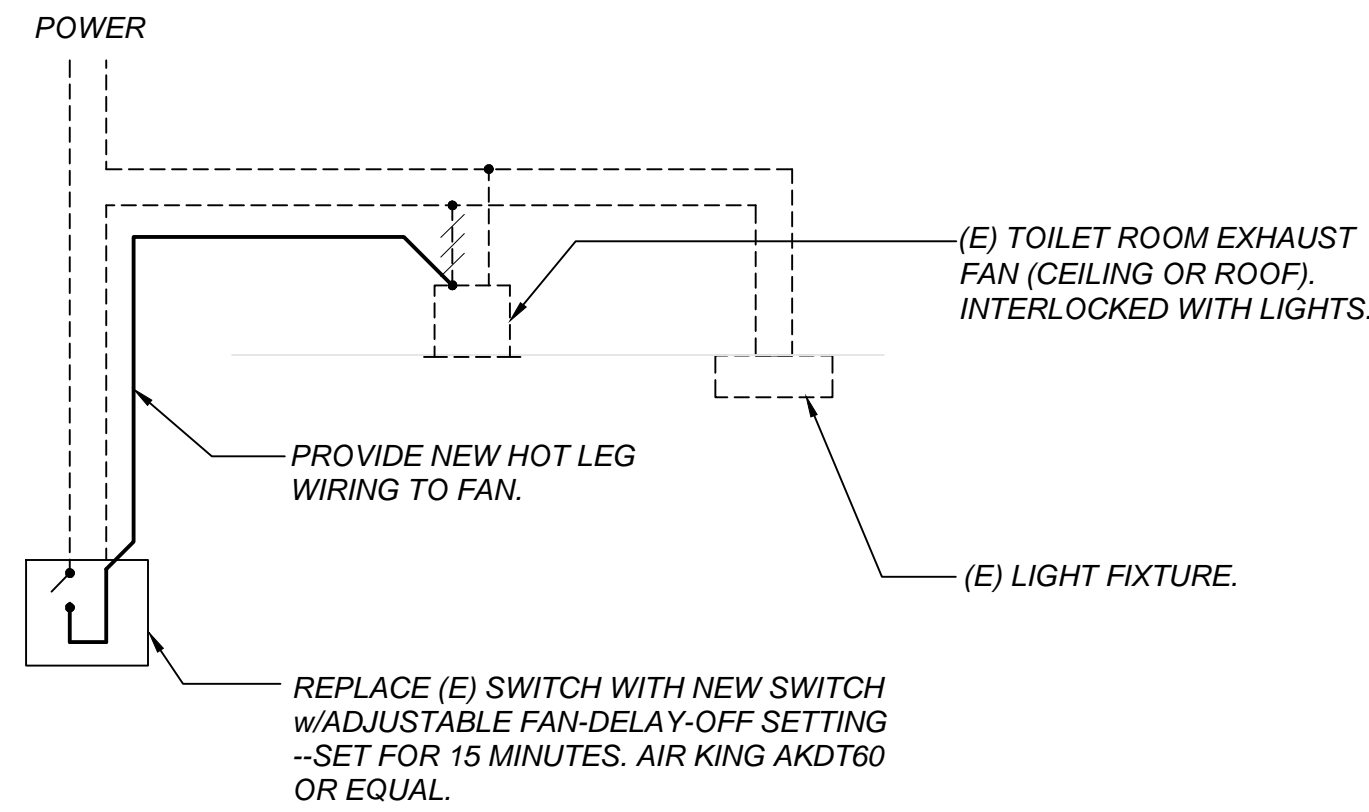

LIGHT / EXHAUST TIMER SWITCH


SCALE: NONE

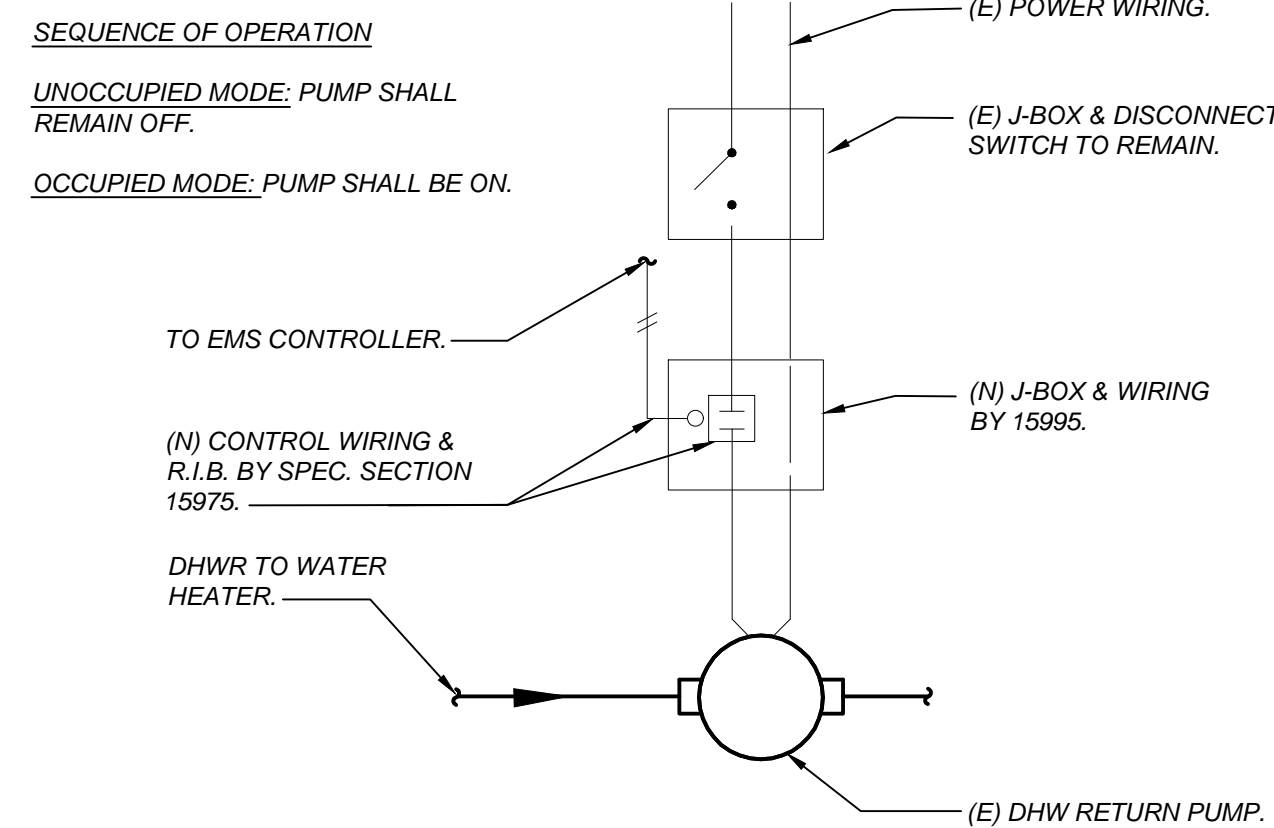

DOMESTIC H.W.R. PUMP CONTROL

SCALE: NONE

B
M9

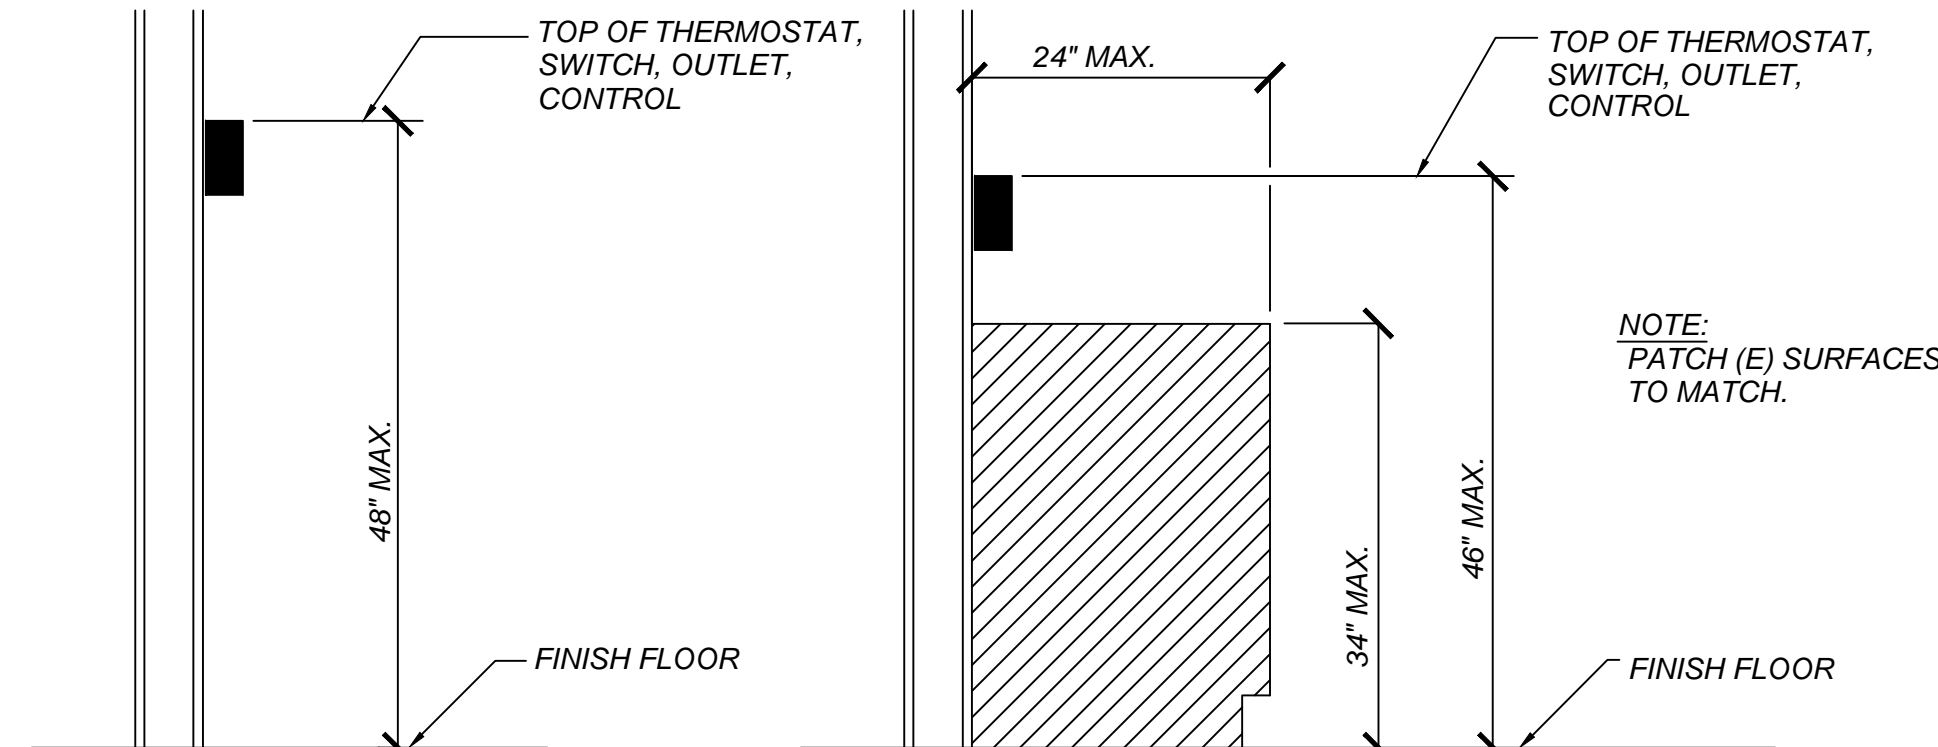


MOUNTING HEIGHT
THERMOSTAT MOUNTING

SCALE: NONE

OVER OBSTRUCTION

C
M9

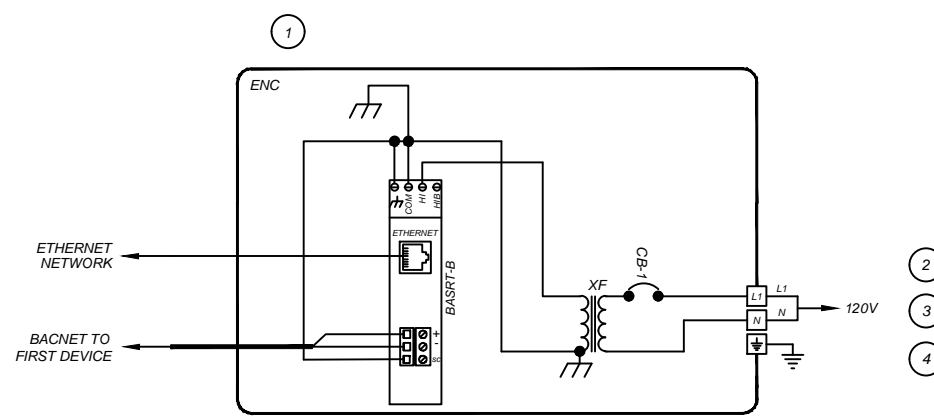

BACNET/IP MS/TP ROUTER PANEL DETAIL

SCALE: NONE


Router Panel Components	
TAG	DESCRIPTION
CB-1	2.0 AMP CIRCUIT BREAKER
BASRT-B	BACNET/IP MS/TP ROUTER
XF	50A 24VAC TRANSFORMER
ENC	12X12 NEMA 1 ENCLOSURE WITH BACKPLATE

Detail Notes

- CONTROL PANEL FABRICATED BY TOTAL CONTROL CONTACT DEVEN PUTNAM AT 559-291-1000.
- LINE VOLTAGE & CONDUIT BY DIVISION 16.
- FOR PORTABLE BLDG. PROVIDE AND INSTALL A DEDICATED 20A/1P CIRCUIT BREAKER TO THE PORTABLE BUILDING PANEL.
- FOR PERMANENT BLDG. CONNECT ROUTER TO (E) CIRCUIT.

D
M9

ROOF TOP UNIT TCP SCHEMATIC

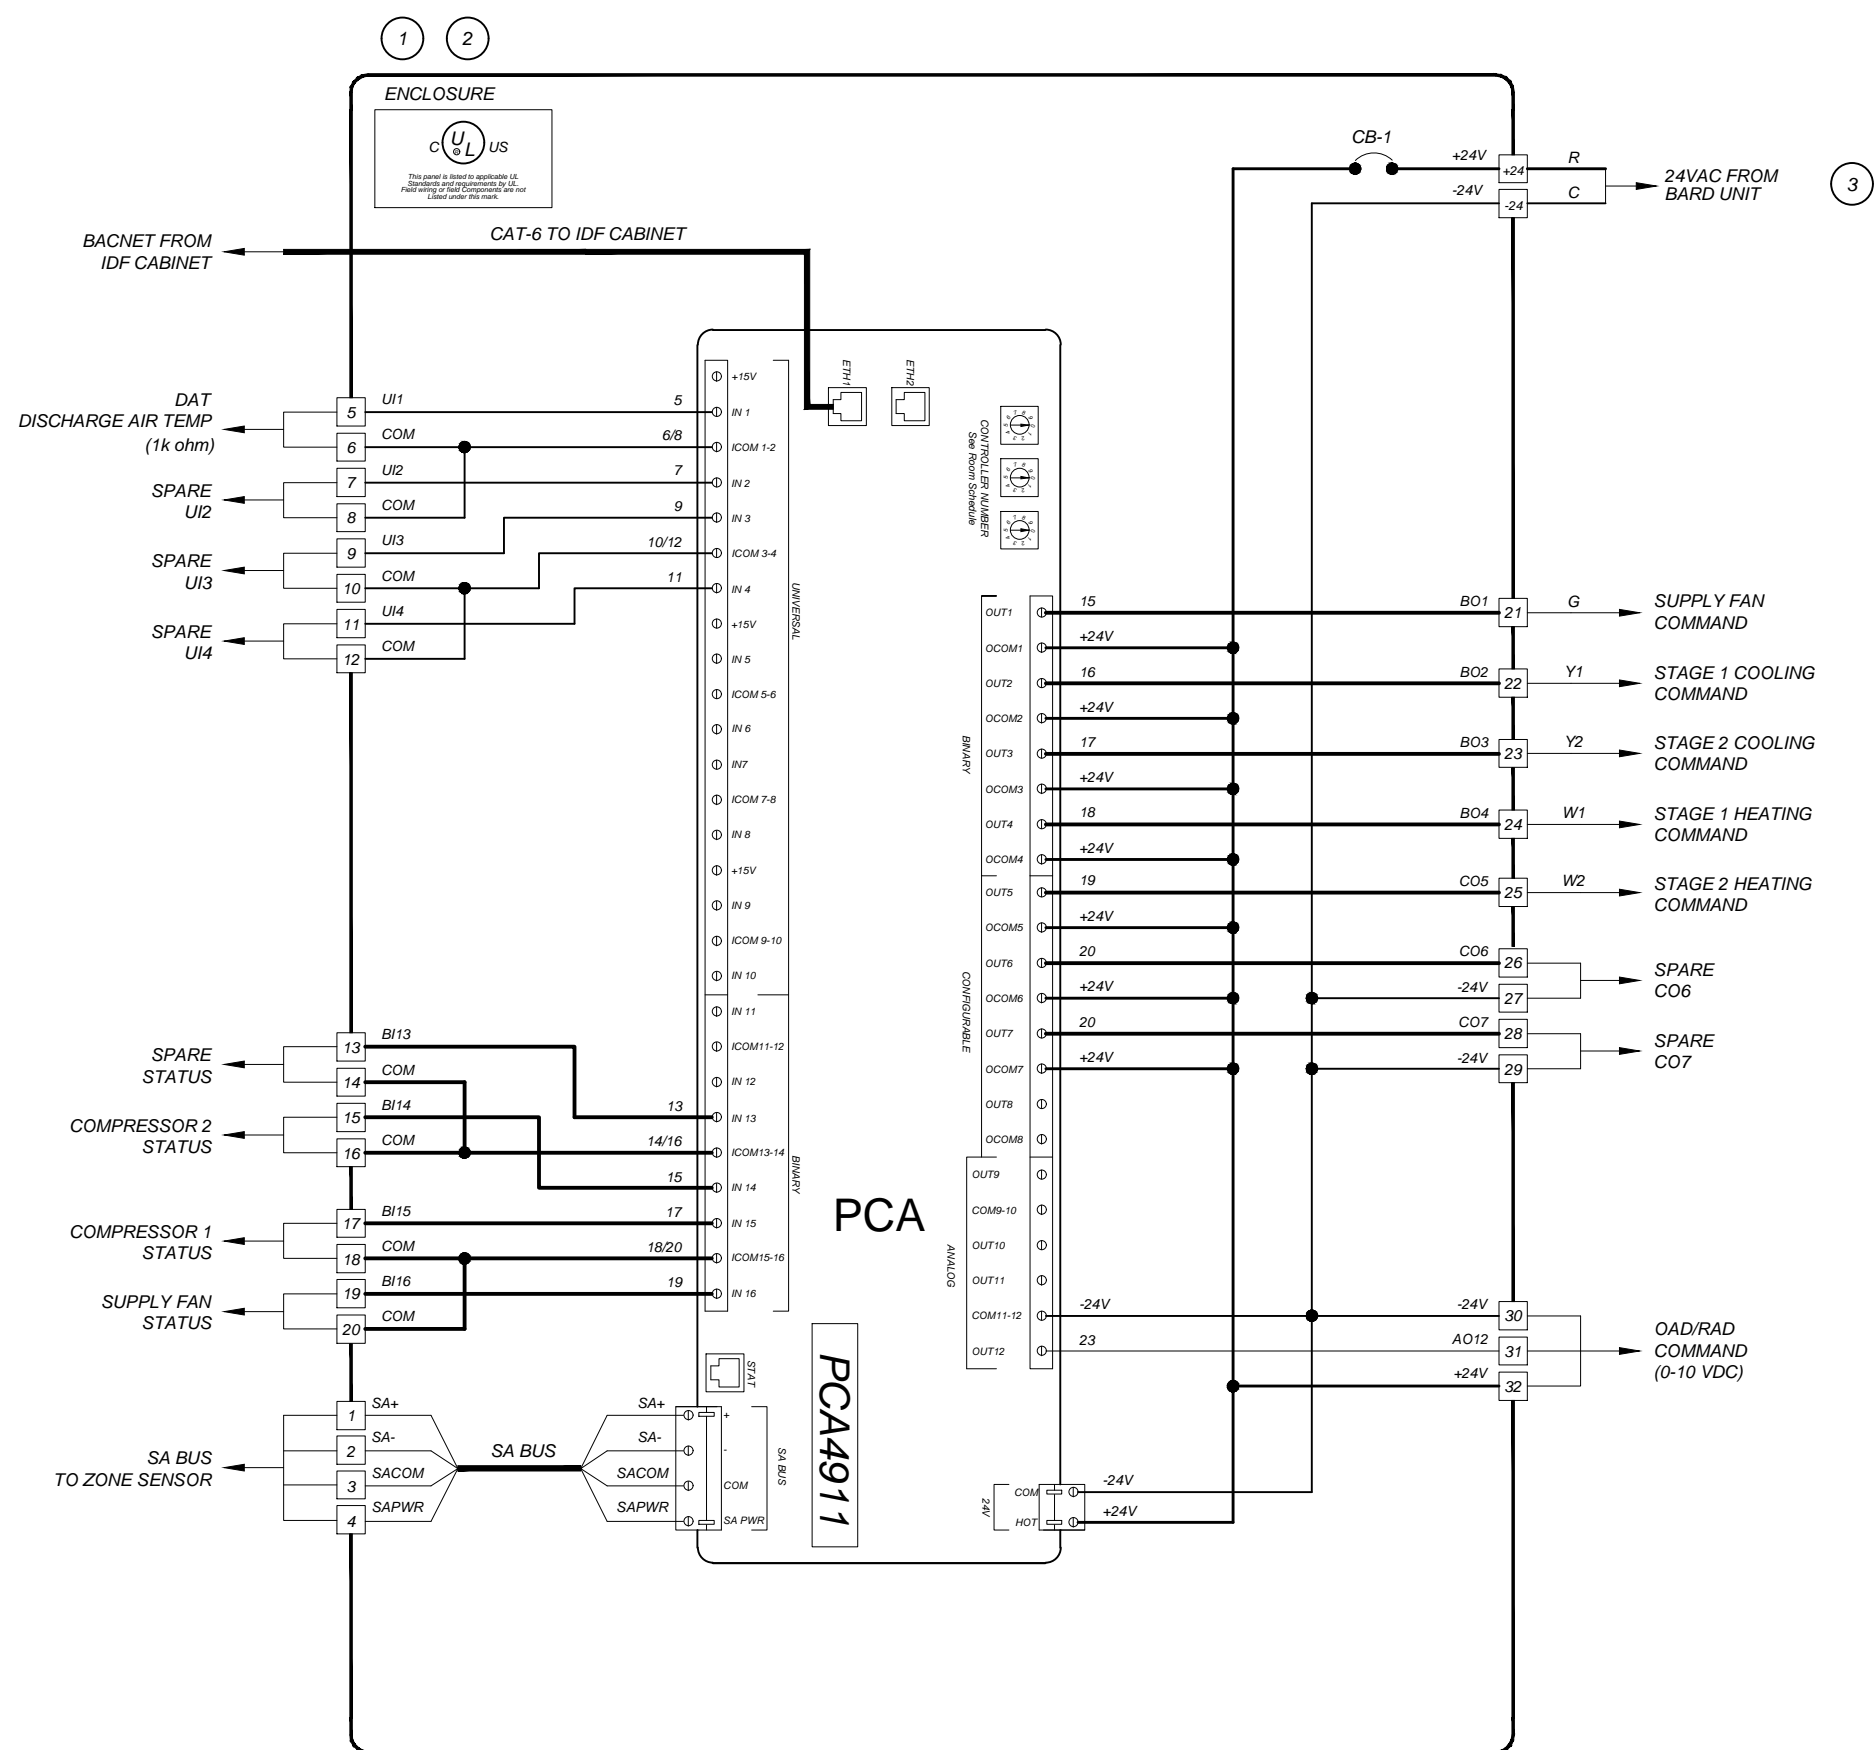



HARDIN-DAVIDSON ENGINEERING

356 Pollasky Ave • Suite 200 • Clovis, CA 93612
559.323.4995 tel • 559.323.4928 fax

Date: April 20, 2021

To: LEG
7084 N Maple Avenue
Fresno, California 93720
(559) 431-0101 Fax (559) 431-1362

Attn: Ezequiel Fregoso

Project: EMS Replacement Projects at Burroughs, Eaton & Rowell Elementary Schools, Fresno Unified School District

The following is an addendum to the scope of the above referenced projects.

These items apply to all sites:

1. On Sheet E-2 (typical), Drawing Key Note 1, should be modified as such:

“DISCONNECT EXISTING FAN MOTORS AND STARTERS IN AC UNIT. REMOVE EXISTING FVNR MOTOR STARTER. INSTALL AND CONNECT NEW VFDS AS REQUIRED WITH ALL NEW WIRING AND PROVIDE FUSING AS REQUIRED BY VFD MANUFACTURER. CONNECT NEW MOTOR. SEE MECHANICAL DRAWINGS AND COORDINATE WITH MECHANICAL CONTRACTOR. REPLACE ANY EXISTING LIQUID-TITE FLEXIBLE CONDUIT WITH NEW (MAXIMUM LENGTH OF 36" PER DISTRICT STANDARD). CONTRACTOR IS TO VISIT THE JOBSITE AND OBSERVE THE EXISTING CONDITIONS.”

2. Note to contractor: The motors will not be changing in size. The “Motor Replacement Schedule” and “Unit MCA Requirements” charts as shown on Sheet E-2 are not needed.

Sincerely,

Patrick May
Electrical Designer/Project Manager

SECTION 1 REQUEST & SUGGESTED SOLUTION
Project Name: FUSD Burroughs, Eaton, Rowell

Sent To: LEG

Requestor: Strategic Mechanical

Schedule Impact:
Cost Impact: X

Subject: Commissioning Agents

« In spec section 019113-5 it discusses the qualifications of the commissioning agents. Please clarify if 3rd party commissioning agents are to be secured by the contractor for this project or if they are to be provided by the district. »

SECTION 2
Received by:
Date:
SECTION 3 FINAL RESOLUTION

FRESNO UNIFIED SCHOOL DISTRICT WILL PROVIDE COMMISSIONING AGENT.

-LEG

Solution by:
Date:
SECTION 4 ACTION

 Information Only: ☐

 Change Order Required: ☐
Signature:
Date:
SECTION 5 DISTRIBUTION

 See Below: ☐

 Project Distribution Matrix: ☐

SECTION 1 REQUEST & SUGGESTED SOLUTION

Project Name:	FUSD Burroughs, Eaton, Rowell		
Sent To:	LEG		
Requestor:	Strategic Mechanical	Schedule Impact:	Cost Impact: X
Subject:	Touchscreens and Laptops		

« In spec section 230923-5 it states that PC Touchscreens and Laptops are to be furnished as part of this project. Please verify that these items are not required. »

SECTION 2

Received by:	Date:
---------------------	--------------

SECTION 3 FINAL RESOLUTION

PC TOUCHSCREENS AND LAPTOPS ARE NOT REQUIRED, REFER TO ADDENDUM 1.
 -LEG

Solution by:	Date:
---------------------	--------------

SECTION 4 ACTION	Information Only: <input type="checkbox"/>	Change Order Required: <input type="checkbox"/>
Signature:	Date:	

SECTION 5 DISTRIBUTION	See Below: <input type="checkbox"/>	Project Distribution Matrix: <input type="checkbox"/>
-------------------------------	--	--

SECTION 1 REQUEST & SUGGESTED SOLUTION
Project Name: FUSD Burroughs, Eaton, Rowell

Sent To: LEG

Requestor: Strategic Mechanical

Schedule Impact:
Cost Impact: X

Subject: Convenience Receptacle

« In spec section 230923-13 it states that a convenience 120V receptacle is to be provide in each control panel enclosure. This would require that a 120V circuit be run to every control panel which is most likely not existing for every piece of equipment. Typically, this receptacle (and 120V circuit) is only provided for instances where the panel serves a chiller or boiler. Please verify that the receptacle will only be required for Supervisory Control Panels (panels with the FX-80 controller) or central plant panels (panels that serve chillers, boilers, pumps ect..). »

SECTION 2
Received by:
Date:
SECTION 3 FINAL RESOLUTION

120V RECEPTACLES ARE ONLY REQUIRED AT SUPERVISORY CONTROL PANELS.
 -LEG

Solution by:
Date:
SECTION 4 ACTION

 Information Only: ☐

 Change Order Required: ☐
Signature:
Date:
SECTION 5 DISTRIBUTION

 See Below: ☐

 Project Distribution Matrix: ☐

SECTION 1 REQUEST & SUGGESTED SOLUTION

Project Name:	FUSD Burroughs, Eaton, Rowell		
Sent To:	LEG		
Requestor:	Strategic Mechanical	Schedule Impact:	Cost Impact: X
Subject:	Balancing, Duct Cleaning, and Water Treatment		

« There is not a specification section for balancing (air or water). In the drawings for all three schools, it discusses how some of the units are to have duct traverses before and after upgrades have been made to measure air flow. Please provide a specification for the air balancing work. Please verify that there is no water balancing, duct cleaning or water treatment included as part of this project. »

SECTION 2

Received by:	Date:
---------------------	--------------

SECTION 3 FINAL RESOLUTION

REFER TO ADDENDUM #1, FOR SPECIFICATION ADDITION.
 -LEG

Solution by:	Date:
---------------------	--------------

SECTION 4 ACTION	Information Only: <input type="checkbox"/>	Change Order Required: <input type="checkbox"/>
Signature:	Date:	

SECTION 5 DISTRIBUTION	See Below: <input type="checkbox"/>	Project Distribution Matrix: <input type="checkbox"/>
-------------------------------	--	--

SECTION 1 REQUEST & SUGGESTED SOLUTION

Project Name:	FUSD Burroughs, Eaton, Rowell		
Sent To:	LEG		
Requestor:	Strategic Mechanical	Schedule Impact:	Cost Impact: X
Subject:	VFD		

« On the M sheets for all three schools, there is a note for the MZ unit that calls for new AB VFD's for the Supply and Return fans. In past projects the district has used AB VFD's for Central Plant Equipment (Pumps) and other brands of drives (Honeywell, JCI, Eaton, ect...) for the fans on AHU's. Would it be acceptable to use other brands of drives instead of AB drives? If only AB drives are to be allowed, will line reactors be required? »

SECTION 2

Received by:	Date:
---------------------	--------------

SECTION 3 FINAL RESOLUTION

ALLEN-BRADLEY DRIVES MUST BE INSTALLED, WITHOUT SUBSTITUTION. PROVIDE LINE REACTORS FOR ALLEN-BRADLEY DRIVES.
 -LEG

Solution by:	Date:
---------------------	--------------

SECTION 4 ACTION	Information Only: <input type="checkbox"/>	Change Order Required: <input type="checkbox"/>
Signature:	Date:	

SECTION 5 DISTRIBUTION	See Below: <input type="checkbox"/>	Project Distribution Matrix: <input type="checkbox"/>
-------------------------------	--	--

SECTION 1 REQUEST & SUGGESTED SOLUTION
Project Name: FUSD Burroughs, Eaton, Rowell

Sent To: LEG

Requestor: Strategic Mechanical

Schedule Impact:
Cost Impact: X

Subject: Enclosures

« On M sheets for all three schools it states that the SCP is to be installed in a N12 enclosure. It shows the TCP's being in N4 enclosures. In the specifications 230924-2 it states that the enclosures for the Control Panels are to be N1 if indoor and N3R if outdoor. Please clarify the Nema rating required for the control panels. »

SECTION 2
Received by:
Date:
SECTION 3 FINAL RESOLUTION

NEMA RATINGS SHALL FOLLOW SPECIFICATION SECTION 230924-2.
 -LEG

Solution by:
Date:
SECTION 4 ACTION

 Information Only: ☐

 Change Order Required: ☐
Signature:
Date:
SECTION 5 DISTRIBUTION

 See Below: ☐

 Project Distribution Matrix: ☐

SECTION 1 REQUEST & SUGGESTED SOLUTION

Project Name:	FUSD Burroughs, Eaton, Rowell		
Sent To:	LEG		
Requestor:	Strategic Mechanical	Schedule Impact:	Cost Impact: X
Subject:	EF Interlocking		

« In the M sheets for all three schools there is a detail for the interlock of the exhaust fan with the lighting by replacing the existing light switch with a new switch that has fan control and pull a new hot leg off the lighting circuit to power the fan. We have found in the past that this has not worked because the exhaust fan sometimes is not on the same circuit as the lighting as shown in the detail and is even a different voltage than the lighting. Please verify that the interlocked exhaust fans are currently on the same circuit as the lighting as shown in the detail. »

SECTION 2

Received by:	Date:
---------------------	--------------

SECTION 3 FINAL RESOLUTION

Use this method where possible, and provide a solution in situations where this method does not work.
 -LEG

Solution by:	Date:
---------------------	--------------

SECTION 4 ACTION	Information Only: <input type="checkbox"/>	Change Order Required: <input type="checkbox"/>
Signature:	Date:	

SECTION 5 DISTRIBUTION	See Below: <input type="checkbox"/>	Project Distribution Matrix: <input type="checkbox"/>
-------------------------------	--	--

SECTION 1 REQUEST & SUGGESTED SOLUTION

Project Name:	FUSD Burroughs, Eaton, Rowell		
Sent To:	LEG		
Requestor:	Strategic Mechanical	Schedule Impact:	Cost Impact: X
Subject:	Electrical Feeders		

« On sheet E-2 for all three schools it states that feeders for some of the HVAC equipment are to be replaced. Please indicate from what electrical panels these units are currently fed from. Please indicate if any of the circuit breakers for these units will need to be replaced. Please indicate if any of the raceways will need to be replaced due to upsize of feeders for derations as indicated on the drawings. »

SECTION 2

Received by:	Date:
---------------------	--------------

SECTION 3 FINAL RESOLUTION

SEE ADDENDUM #1 FOR SCOPE CLARIFICATION.
 -LEG

Solution by:	Date:
---------------------	--------------

SECTION 4 ACTION	Information Only: <input type="checkbox"/>	Change Order Required: <input type="checkbox"/>
Signature:	Date:	

SECTION 5 DISTRIBUTION	See Below: <input type="checkbox"/>	Project Distribution Matrix: <input type="checkbox"/>
-------------------------------	--	--

SECTION 1 REQUEST & SUGGESTED SOLUTION

Project Name:	FUSD Burroughs, Eaton, Rowell		
Sent To:	LEG		
Requestor:	Strategic Mechanical	Schedule Impact:	Cost Impact: X
Subject:	Ethernet for Controllers		

« On the LAN architecture drawings for all three schools the PCA are shown to wire back to the local network switches. The cabling used varies from school to school. Also, the use of the Panduit CJ688TGYL connectors varies from school to school on these details. Please indicate which cable is to be used and if the connectors are required. Please indicate which IDF's these PCA controllers are to be wired to and verify if there are available ports on the switch to be wired into. »

SECTION 2

Received by:	Date:
---------------------	--------------

SECTION 3 FINAL RESOLUTION

REFER TO ADDENDUM #1 FOR REVISED DRAWING SETS.

CAT 6 CABLEING IS TO BE USED ON ALL SITES, PER FUSD STANDARDS THE CONNECTORS ARE REQUIRED.

PCA ARE TO BE CONNECTED TO THE NEAREST IDF CABINET. FUSD WILL ADD ADDITIONAL PORTS, AS REQUIRED.

-LEG

Solution by:	Date:
---------------------	--------------

SECTION 4 ACTION

 Information Only: ☐

 Change Order Required: ☐

Signature:	Date:
-------------------	--------------

SECTION 5 DISTRIBUTION

 See Below: ☐

 Project Distribution Matrix: ☐

SECTION 1 REQUEST & SUGGESTED SOLUTION

Project Name:	FUSD Burroughs, Eaton, Rowell		
Sent To:	LEG		
Requestor:	Strategic Mechanical	Schedule Impact:	Cost Impact: X
Subject:	Burroughs Drawings		

« The drawings for Burroughs have several letters replaced by squares. Can new drawings be provided? »

SECTION 2

Received by:	Date:
---------------------	--------------

SECTION 3 FINAL RESOLUTION

SEE REVISED DRAWINGS.

Solution by:	Date:
---------------------	--------------

SECTION 4 ACTION	Information Only: <input type="checkbox"/>	Change Order Required: <input type="checkbox"/>
Signature:	Date:	

SECTION 5 DISTRIBUTION	See Below: <input type="checkbox"/>	Project Distribution Matrix: <input type="checkbox"/>
-------------------------------	--	--

SECTION 1 REQUEST & SUGGESTED SOLUTION
Project Name: FUSD Burroughs, Eaton, Rowell

Sent To: LEG

Requestor: Strategic Mechanical

Schedule Impact:
Cost Impact: X

Subject: Bacnet Router 120V power

« Would it be acceptable to tap off the 120V power for the IDF's that the bacnet router panels are mounted next to in order to provide power for the bacnet router panel? »

SECTION 2
Received by:
Date:
SECTION 3 FINAL RESOLUTION

NO, PROVIDE A DEDICATED 120V RUN.
-LEG

Solution by:
Date:
SECTION 4 ACTION

 Information Only: ☐

 Change Order Required: ☐
Signature:
Date:
SECTION 5 DISTRIBUTION

 See Below: ☐

 Project Distribution Matrix: ☐

SECTION 1 REQUEST & SUGGESTED SOLUTION

Project Name:	FUSD Burroughs, Eaton, Rowell		
Sent To:	LEG		
Requestor:	Strategic Mechanical	Schedule Impact:	Cost Impact: X
Subject:	Drawing scales		

« In scaling off the drawings on Burroughs I found that at least one of the buildings was not the same size on the drawing as it should be based on the drawing scale. Please verify scaling on drawings. »

SECTION 2

Received by:	Date:
---------------------	--------------

SECTION 3 FINAL RESOLUTION

SEE REVISED DRAWINGS.
-LEG

Solution by:	Date:
---------------------	--------------

SECTION 4 ACTION	Information Only: <input type="checkbox"/>	Change Order Required: <input type="checkbox"/>
Signature:	Date:	

SECTION 5 DISTRIBUTION	See Below: <input type="checkbox"/>	Project Distribution Matrix: <input type="checkbox"/>
-------------------------------	--	--

SECTION 1 REQUEST & SUGGESTED SOLUTION

Project Name:	FUSD Burroughs, Eaton, Rowell		
Sent To:	LEG		
Requestor:	Strategic Mechanical	Schedule Impact:	Cost Impact: X
Subject:	EC		

« On sheet M-3 for Burroughs on the MPR kitchen there is an evap cooler unit that is to remain. Does this unit need to be controlled by the new EMS? »

SECTION 2

Received by:	Date:
---------------------	--------------

SECTION 3 FINAL RESOLUTION

UNIT IS TO REMAIN OFF NEW EMS.
 -LEG

Solution by:	Date:
---------------------	--------------

SECTION 4 ACTION

 Information Only: ☐

 Change Order Required: ☐

Signature:	Date:
-------------------	--------------

SECTION 5 DISTRIBUTION

 See Below: ☐

 Project Distribution Matrix: ☐

SECTION 1 REQUEST & SUGGESTED SOLUTION

Project Name:	FUSD Burroughs, Eaton, Rowell		
Sent To:	LEG		
Requestor:	Strategic Mechanical	Schedule Impact:	Cost Impact: X
Subject:	HP's and PCA Controllers		

« On sheet M1 it shows two HP's for portable classrooms but M5 only shows one PCA controller for each portable. Please verify that that if there are two HP's serving the same space that these are to be controlled by only one PCA controller.

On M4 there are also dual HP's per portable but for those portables they have individual PCA controllers shown on M5.

Also on M4 it shows HP37 and HP38 but these units do not have a PCA controller shown on M5. »

SECTION 2

Received by:	Date:
--------------	-------

SECTION 3 FINAL RESOLUTION

SEE REVISED DRAWINGS.
-LEG

Solution by:	Date:
--------------	-------

SECTION 4 ACTION	Information Only: <input type="checkbox"/>	Change Order Required: <input type="checkbox"/>
Signature:	Date:	

SECTION 5 DISTRIBUTION	See Below: <input type="checkbox"/>	Project Distribution Matrix: <input type="checkbox"/>
-------------------------------	-------------------------------------	---

SECTION 1 REQUEST & SUGGESTED SOLUTION

 Project Name: **FUSD Burroughs, Eaton, Rowell**

 Sent To: **LEG**

 Requestor: **Strategic Mechanical**

Schedule Impact:

 Cost Impact: **X**

 Subject: **Eaton MZU Zones Bldg A**

« On M1 it appears that the zones for the units may be mislabeled. Please verify. Also MZU-1 states that it has 8 zones but only 3 zones are shown on the drawing. »

SECTION 2

Received by:

Date:

SECTION 3 FINAL RESOLUTION

ADDITIONAL ZONES HAVE BEEN ADDED.
 -LEG

Solution by:

Date:

SECTION 4 ACTION

 Information Only: ☐

 Change Order Required: ☐

Signature:

Date:

SECTION 5 DISTRIBUTION

 See Below: ☐

 Project Distribution Matrix: ☐

SECTION 1 REQUEST & SUGGESTED SOLUTION

Project Name:	FUSD Burroughs, Eaton, Rowell		
Sent To:	LEG		
Requestor:	Strategic Mechanical	Schedule Impact:	Cost Impact: X
Subject:	Eaton EF 5 and 5A		

« On M1 it shows EF5 and 5A. On sheet M4 it shows only EF5. Is EF5A to be controlled the same as EF5? »

SECTION 2

Received by:	Date:
--------------	-------

SECTION 3 FINAL RESOLUTION

YES-LEG

Solution by:	Date:
--------------	-------

SECTION 4 ACTION	Information Only: <input type="checkbox"/>	Change Order Required: <input type="checkbox"/>
Signature:	Date:	

SECTION 5 DISTRIBUTION	See Below: <input type="checkbox"/>	Project Distribution Matrix: <input type="checkbox"/>
-------------------------------	-------------------------------------	---

SECTION 1 REQUEST & SUGGESTED SOLUTION

Project Name:	FUSD Burroughs, Eaton, Rowell		
Sent To:	LEG		
Requestor:	Strategic Mechanical	Schedule Impact:	Cost Impact: X
Subject:	Eaton EDH		

« On M2 it shows several electric duct heaters. Are these to be included on the new controls? If so, how are they to be incorporated in the new EMS? »

SECTION 2

Received by:	Date:
---------------------	--------------

SECTION 3 FINAL RESOLUTION

SEE REVISED DRAWINGS.
-LEG

Solution by:	Date:
---------------------	--------------

SECTION 4 ACTION

 Information Only: ☐

 Change Order Required: ☐

Signature:	Date:
-------------------	--------------

SECTION 5 DISTRIBUTION

 See Below: ☐

 Project Distribution Matrix: ☐

SECTION 1 REQUEST & SUGGESTED SOLUTION

Project Name:	FUSD Burroughs, Eaton, Rowell		
Sent To:	LEG		
Requestor:	Strategic Mechanical	Schedule Impact:	Cost Impact: X
Subject:	Eaton – EF1A		

« On M2 it shows EF1A. Is this exhaust fan to be incorporated into the new EMS? »

SECTION 2

Received by:	Date:
--------------	-------

SECTION 3 FINAL RESOLUTION

SEE REVISED DRAWINGS.
-LEG

Solution by:	Date:
--------------	-------

SECTION 4 ACTION	Information Only: <input type="checkbox"/>	Change Order Required: <input type="checkbox"/>
Signature:	Date:	

SECTION 5 DISTRIBUTION	See Below: <input type="checkbox"/>	Project Distribution Matrix: <input type="checkbox"/>
-------------------------------	-------------------------------------	---

SECTION 1 REQUEST & SUGGESTED SOLUTION

 Project Name: **FUSD Burroughs, Eaton, Rowell**

 Sent To: **LEG**

 Requestor: **Strategic Mechanical**

Schedule Impact:

 Cost Impact: **X**

 Subject: **Eaton - Portable Equipment Numbers**

« On M4 It shows AH-27 and HP's 22-26. On sheet M3 It shows HP's 22, 23, 25, 26, 27 and no AH-27. Please verify the corrected HP numbering on the Lan Drawing or the HP's and the elimination of AH-27 from the LAN drawing on M3. »

SECTION 2

Received by:

Date:

SECTION 3 FINAL RESOLUTION

SEE REVISED DRAWINGS, LAN HAS BEEN CORRECTED.
 -LEG

Solution by:

Date:

SECTION 4 ACTION

 Information Only: ☐

 Change Order Required: ☐

Signature:

Date:

SECTION 5 DISTRIBUTION

 See Below: ☐

 Project Distribution Matrix: ☐

SECTION 1 REQUEST & SUGGESTED SOLUTION

Project Name:	FUSD Burroughs, Eaton, Rowell		
Sent To:	LEG		
Requestor:	Strategic Mechanical	Schedule Impact:	Cost Impact: X
Subject:	Eaton – Mini Split Bacnet Card		

« On M4 it shows a bacnet card for the mini split unit shown on M1. Please verify that a bacnet card for this unit is available from the manufacturer. »

SECTION 2

Received by:	Date:
---------------------	--------------

SECTION 3 FINAL RESOLUTION

SEE REVISED DRAWINGS, NO BACnet CARD REQUIRED.
 -LEG

Solution by:	Date:
---------------------	--------------

SECTION 4 ACTION	Information Only: <input type="checkbox"/>	Change Order Required: <input type="checkbox"/>
Signature:	Date:	

SECTION 5 DISTRIBUTION	See Below: <input type="checkbox"/>	Project Distribution Matrix: <input type="checkbox"/>
-------------------------------	--	--

SECTION 1 REQUEST & SUGGESTED SOLUTION

Project Name:	FUSD Burroughs, Eaton, Rowell		
Sent To:	LEG		
Requestor:	Strategic Mechanical	Schedule Impact:	Cost Impact: X
Subject:	Rowell - MZU Zones		

« On M1 MZU-1 states that it has 8 zones but only 3 zones are shown on the drawing. Please clarify. »

SECTION 2

Received by:	Date:
--------------	-------

SECTION 3 FINAL RESOLUTION

SEE REVISED DRAWINGS.
-LEG

Solution by:	Date:
--------------	-------

SECTION 4 ACTION	Information Only: <input type="checkbox"/>	Change Order Required: <input type="checkbox"/>
Signature:	Date:	

SECTION 5 DISTRIBUTION	See Below: <input type="checkbox"/>	Project Distribution Matrix: <input type="checkbox"/>
-------------------------------	-------------------------------------	---

SECTION 1 REQUEST & SUGGESTED SOLUTION

Project Name:	FUSD Burroughs, Eaton, Rowell		
Sent To:	LEG		
Requestor:	Strategic Mechanical	Schedule Impact:	Cost Impact: X
Subject:	Rowell - EDH		

« On M2 it shows several electric duct heaters. Are these to be included on the new controls? If so, how are they to be incorporated in the new EMS? »

SECTION 2

Received by:	Date:
---------------------	--------------

SECTION 3 FINAL RESOLUTION

SEE REVISED DRAWINGS.
-LEG

Solution by:	Date:
---------------------	--------------

SECTION 4 ACTION	Information Only: <input type="checkbox"/>	Change Order Required: <input type="checkbox"/>
Signature:	Date:	

SECTION 5 DISTRIBUTION	See Below: <input type="checkbox"/>	Project Distribution Matrix: <input type="checkbox"/>
-------------------------------	--	--

SECTION 1 REQUEST & SUGGESTED SOLUTION

Project Name:	FUSD Burroughs, Eaton, Rowell		
Sent To:	LEG		
Requestor:	Strategic Mechanical	Schedule Impact:	Cost Impact: X
Subject:	Rowell – New FX-80s		

« On M1 it shows the installation of a new FX-80 control panel in the storage room in Building A. On M3 it shows the installation of a new FX-80 in the electrical room of Building E. On Sheet M4 it only shows the installation of a new FX-80 in Building E with a bacnet Router used for Building A. Please clarify how many FX-80's are to be used. »

SECTION 2

Received by:	Date:
---------------------	--------------

SECTION 3 FINAL RESOLUTION

SEE REVISED DRAWINGS, ONE FX-80 IS REQUIRED AND TO BE INSTALLED IN BUILDING E.
 -LEG

Solution by:	Date:
---------------------	--------------

SECTION 4 ACTION	Information Only: <input type="checkbox"/>	Change Order Required: <input type="checkbox"/>
Signature:	Date:	

SECTION 5 DISTRIBUTION	See Below: <input type="checkbox"/>	Project Distribution Matrix: <input type="checkbox"/>
-------------------------------	--	--

FRESNO UNIFIED SCHOOL DISTRICT
PAINTING

PART 1 - GENERAL

1.01 REFERENCE:

Requirements in Addenda, Alternates, Conditions, and Division 1 collectively apply to this work.

1.02 DESCRIPTION:

A. Principal Work Items Are:

1. Complete application of paint to interior and exterior surfaces.
 - a. Unfinished materials.
 - b. Back-priming.
 - c. Metals, including certain hidden surfaces.
 - d. Woods and fabrications of wood.
 - e. Sheet metal.
 - f. Plaster, except where integrally colored.
 9. Gypsum wallboard.
 - h. Doors.
 - l. Exposed piping, conduits, ducts, panels, mechanical and electrical equipment and items.
 - j. Visible roof-top equipment.
 - k. Miscellaneous items.
 - l. Concrete block.
 - m. Painted stripes at stairs, to conform to Handicap Requirements.
2. Application of finish coats to shop-primed metal surfaces:
 - a. Door louvers.
 - b. Pressed metal frames.
 - c. Hollow metal doors.
 - d. Coiling grilles.
3. Structural steel.

B. Some Surfaces Not to Be Painted:

1. In general, items with District approved integral finishes, approved plated finishes, approved complete factory finishes, except where otherwise indicated.
2. Finish hardware, except where primed for paint.
3. Integrally colored plaster.
4. Acoustical materials: Acoustic tile, acoustic panels, and exposed suspension grids.

5. Metal items:
 - a. Approved plated or factory finished items.
 - b. Anodized and color anodized aluminum.
 - c. Stainless steel.
 - d. Toilet partitions.
 - e. Factory finished steel or aluminum frame sliding glass doors.
 - f. Passenger lift doors, frames and cars.

C. Related Work Specified Elsewhere:

1. Materials and items which receive paint: Respective Sections.
2. Factory finished items: Respective Sections.
3. Paint Materials List: Section 09901.
4. Paint & Coatings Surface Prep Guidelines: 09904
5. General Painting Requirements: 09905
6. Electrical fixture trim and plates removal and replacement in coordination with painting work: Division 16.

D. Definitions:

1. DFT: Abbreviation for dry film thickness.
2. Concealed Ungalvanized Steel: Defined in Paragraph 3.06B.
3. Paint: A collective general reference to include all materials of every component for finishing systems of every type, and preparation of surfaces for and application of said materials.
4. Rough-surface wood: Rough-sawn, re-sawn, or sandblasted woods.
5. Visible roof-top equipment: Mechanical and electrical equipment, piping, ducts, conduits, panels and other materials exposed on building roof tops which can be seen by a person standing on the earth's surface at any point within 1,000' of any building.

1.03 SUBSTITUTIONS:

Only written approval of the will permit substitutions for materials specified. Refer to Section 00700, Article 30, Substitutions, for procedure.

1.04 QUALITY ASSURANCE:

- A. Reference Standards: Steel Structures Painting Council-Surface Preparation Specifications (SSPC-SP).
- B. Job Mock-Up, Supergraphic Designs: Layout designs full-size on indicated walls, revise as required by District. Obtain District's approval prior to doing any finished work.

- C. Paint Contractor must have completed 2 projects in last 3 years of similar size and scope in order to qualify for award. Contractor shall submit reference information for verification at time of bid or within 24 hours of request.

1.05 SUBMITTALS:

A Samples

- 1. Number required: Three each, submitted by Manufacturers of the material being used.
- 2. Paints and enamels:

Typical: Each type, in each selected color; 8.5" x 11" size on stiff smooth material typical; on sandpaper for rough surfaces.

- a. Stipple enamel: Each selected color District approved, roller texture on 12" x 24" piece of drywall.
- 3. Stains, varnishes, lacquers: Each finish type on each specie and texture of wood; 8.5" x 11" size for plywood, 16" length for casing or boards, show clearly each step of finishing process.
- 4. Make samples by same methods to be used to produce actual work. Samples will be examined for color, texture, and workmanship.
- 5. Re-make and re-submit samples when required for approval.

B. Product Data: Complete list of all paint materials.

C. Submittal requirements related to hazardous materials as specified in 09904.

1.06 PRODUCT DELIVERY, STORAGE AND HANDLING:

A. Deliver in sealed containers. Manufacturer, brand name, product, and use instructions clearly identified thereon.

B. Store in assigned spaces.

C. Handle to prevent damage during storage and use.

1.07 JOB CONDITIONS:

A. Environmental Requirements:

- 1. Follow manufacturer's printed recommendations for product when they are more stringent than limits stated herein.
- 2. Do not apply materials when RH is above 90%.
- 3. As necessary to provide air movement, aid drying, disperse noxious fumes.
- 4. Do not apply paint to wet-applied construction until such work is dry, and acceptable to District and paint manufacturer.
- 5. Do not apply exterior paint in rainy, damp, misty, smoggy, or excessively windy weather.
- 6. Do not apply paint in areas where dust is being generated.

- B. Protection:
 - 1. Cover or otherwise protect finished work of other trades, work not to be painted concurrently, landscaping, and adjacent property from damage.
 - 2. When not in use, store paints in designated areas. Keep containers closed. At end of day's work, remove empty containers, paint-soaked rags, and debris. Vent fumes. Take precautions to prevent fire.
- C. Sequencing, Scheduling:
 - 1. Coordinate removal and replacement of hardware, electrical fixtures and trim, and related work of other Sections.
 - 2. Stain, prime, back paint, and pre-finish items before installation as required.
- D. Cleaning and Disposal:
 - 1. Do not use Project plumbing fixtures or piping systems for:
 - a. Cleaning painting equipment and utensils.
 - b. Disposal of waste from cleaning or disposal of paints.

PART 2 - PRODUCTS

2.01 MATERIALS:

- A. Acceptable Manufacturers and Products:
 - 1. Materials shall be those listed in Paint Materials List Specifications, Section 09901.
 - 2. Each material type to be same manufacturer throughout. All materials in a coating system to be by a single manufacturer.
 - 3. Brand Names: Shall constitute a standard of quality.
 - 4. Other Manufacturers: Refer to General Conditions for Substitution Requirements.
- B. Colors:
 - 1. As selected by, using ICI/Sinclair color and finish systems as a standard.
 - 2. Concrete block: As selected by District using Triarch Industries, Incorporated and Pittsburgh Paints color and finish systems as a standard.
 - 3. Colors to be factory mixed, and to match approved samples.
 - 4. Tint undercoats sufficiently different so that they are readily distinguishable in any light from each other and the finish coat.

2.02 - MIXING:

- A Follow manufacturer's printed recommendations.
- B. Mix all paints thoroughly prior to application.
- C. Inspection during mixing process shall take place at District request.
- D. Except where thinning is specifically recommended by manufacturer, do not thin products.

PART 3 - EXECUTION

3.01 EXAMINATION:

- A. Examine surfaces for suitability to receive paint. Prior to application of any paint, surfaces to be cleaned free of dust, corrosion, and other foreign matter.
- B. Sand, scrape, fill and repair surfaces flush with suitable materials. Fill voids between adjoining surfaces flush with suitable fillers.
- C. Wood:
 - 1. Clean solid surfaces.
 - 2. Except for rough-surface finishes, sand to a smooth even finish and dust clean.
 - 3. Seal knots, pitch spots, and resinous sapwood with shellac or knot sealer before priming.
 - 4. Puttying:
 - a. Do after first priming coat is dry.
 - b. For transparent or stained work, color putty to match finish.
 - c. Fill flush all nail holes, open joints, cracks and other defects.
- D. Drywall:
 - 1. Fill any cracks or defects with drywall joint compound or speckle. Sand any roughspots smooth. Do not raise nap on paper covering.
 - 2. Portland Cement Plaster:
 - a. Where surfaces alkali is present, wash surface clean with zinc-sulphate in water solution. Fill cracks and defects with cement grout, match surface texture. Small defects may be filled with exterior spackle.
 - 3. Concrete:
 - a. Brush and wash with clean water to remove laitance, efflorescence, from oil bond breaker, and other foreign matter. Fill cracks and defects with cement grout; match surface texture.
 - 4. Galvanized Metal:
 - a. Cleaning: Solvent clean per SSPC-SP, No. 1, Solvent Cleaning.
 - b. Vinyl wash: Apply Dunn-Edwards Galva-Etch, No. GE-123. Follow manufacturer's directions.
 - c. Application: Mop or brush-apply in a thin even coat.
 - d. Remove excess solution from surface with rags, squeegee, or sponge. When using full strength, rinse surface with water.
 - 5. Thinning: Use water, do not reduce solution beyond three parts water to one part Galva-Etch.
 - 6. Drying: One-half hour minimum and four hours maximum before priming.
 - 7. Ungalvanized Shop Primed Structural Steel:

8. Cleaning method: Clean member free of corrosion, loose paint, and foreign matter by either SSPC-SP, No. 2, Hand Cleaning or SSPC-SP, No. 3, PowerBrush Cleaning at the Project site after steel is erected. Touch-up paint, with compatible primer, all abraded, damaged, or uncoated areas.
9. Ungalvanized Shop Primed Metals Other Than Paragraph G Above:
 - a. Clean free of all loose paint and foreign matter. Touch-up paint, with compatible primer, all abraded, damaged, or uncoated areas.
10. Factory Finished Equipment and Items:
 - a. Where indicated to receive job-applied finish coats, sand or etch factory finish as required for proper paint adherence.
11. Concrete Block:
 - a. Substrate shall be cleaned of dust, oils, and other substances that might reduce adhesion of the finish material.

3.02 APPLICATION:

- A. Workmanship:
 1. Execute all work with skilled craftsmen.
 2. Evenly apply all coats with suitable equipment, well flowed on, free of laps, runs, skips, dead spots, and other imperfections. Last coat to present a uniform surface, color and texture.
 3. Stipple texture to be as approved by District.
- B. Manufacturer's Printed Recommendations:
 1. Follow where more stringent than limits specified herein.
- C. Equipment:
 1. Brushes, rollers, and spraying equipment as required and suitable for material being applied; keep clean and in proper operating condition.
- D. General:
 1. Paint and color areas per District's color schedules.
 2. Mask and cut-in as required to accomplish the various color combinations. Make edges of paint clean and sharp (no overlaps) where they adjoin other colors or materials.
 3. Paint entire surface parts and items including reveals, returns, rebates, soffits, projections, openings, and ornamental features.
 4. Do not apply initial coating until moisture content of surface is within paint manufacturer's recommended limits.
 5. Do not apply next coat until previous coats are properly cured and prepared to receive them.
- E. Examination of Work:
 1. Refer to Paragraph 3.03, Field Quality Control, for required examination of work.
 2. Written notification must be provided to District when work is ready for examination.
 3. Do not proceed with next operation until required examination has been made.
- F. Number of Coats:
 1. Specified number is the minimum number to be applied.
 2. Contractor shall, at his expense, apply additional coats as directed by District if:
 - a. Contractor does not produce full even coverage and/or required dry film thickness with specified number of coats.
 - b. Contractor applies a coat before Inspector has examined previous coat.
- G. Dry Film Thickness:
 1. DFT thickness stated in Paragraph 3.06, Schedule of Paint Finishes, is the minimum thickness to be applied and must be increased to manufacturer recommended thickness when such exceeds the thickness stated herein.

- H. Drying Time:
 - 1. Minimum interval between coats shall be the most stringent of the following conditions:
 - a. Until coat is dry.
 - b. Manufacturer's printed recommendations.
 - c. Three days for exterior work, two days for interior work, except where other time requirements are specifically stated in manufacturer's printed recommendations.
- I. Preparation of Work Between Coats:
 - 1. General: Repair defects, sand, dust, wipe clean.
 - 2. Wood, enameled: When dry, lightly sand smooth.
 - 3. Wood, varnished or lacquered: When dry, steel wool smooth.
 - 4. Plaster and concrete: Neutralize suction spots or hot spots then touch up so coat surface is uniform.
- J. Back-Priming:
 - 1. Immediately upon delivery to Project site, backprime all surfaces which will be concealed after installation for following items: exterior and interior finish lumber and millwork, door frames, trim, plywood wall lining and paneling.
 - 2. Painted or Enameled Work: One coat clear sealer.
 - 3. Work with Stained Finish: One coat linseed oil.
 - 4. Keep back-priming off exposed faces.
- K. Priming:
 - 1. General: Prime work as soon as possible after surfaces are prepared.
 - 2. Ungalvanized Steel: Prime immediately after cleaning on the same day.
 - 3. Galvanized Sheet Metal: Prime immediately after erection.
 - 4. Exterior and Interior Woodwork: Prime immediately after erection.
 - 5. At Glazing: Paint all glass beads, stops and rebates, except for aluminum.
- L. Application Methods:
 - 1. Apply by brush or roller, except as listed below:
 - a. Enamel: to doors: Roller only.
 - b. Enamel: Roller typically.
 - c. Stipple enamel: Roller only, with District approved texture.
 - d. Varnish or lacquer: Spray.
 - e. Exterior wood stains: Apply by brush or roller only. Work well into surface, especially on rough surface woods.
 - f. Doors:
 - 1. Finish faces, edges, top, and bottom. On wood doors, apply first coat to all parts at the same time. At exterior doors, paint interior face with same material used on the exterior face.
 - g. Colors:
 - 1. Make color changes at inside corners typically. Paint to a clean straight line.

3.03 FIELD QUALITY CONTROL:

- A. Examination of Work (By District Appointed Inspector):
 - 1. Notification: Contractor to provide 24-hr written notice to District Project Manager upon readiness for inspection of work steps.
 - 2. Work shall not proceed to subsequent step without written authorization from District personnel.
 - 3. Refer to Part V of Specification 09905 for specific inspection requirements.

3.04 ADJUSTMENT AND CLEANING:

A. Cleaning:

1. Clean surfaces as work progresses.
2. Remove all paint spillage and droppings and stains as soon as possible.
3. Do not use tools or cleaners, which will mar finish of item being cleaned.
4. Leave work and paint storage area clean and free of droppings, stains, dirt or defacements resulting from this work.

B. Correction of Defective Work:

1. Repair abraded, damaged or incomplete paint surfaces by methods acceptable to District. Spot repairs to be well-blended into adjacent work. For large repairs, re-coat entire plane or building element in which damaged area occurs.
2. Defaced surfaces of work not to be painted shall be cleaned and their original finish restored.

3.05 SCHEDULE OF PAINT FINISHES:

A. Metal Work, Exterior and Interior:

1. Galvanized Metal Exterior and Interior:
 - a. Coat 1: Zinc Dust Primer or Oil-Cementitious Primer. If Oil Cementitious Primer is used, it shall be re-coated within 48 hours in accordance with the manufacturer's recommendations.
 - b. Coat 2: Sash and trim.
 - c. Coat 3: Sash and trim.
 - d. DFT: Five mils.
2. Ungalvanized Shop-Primed Structural Steel, Exposed On Building Exterior: Apply prime coat immediately after steel is cleaned.
 - a. Touch-Up: Spot prime any abraded, damaged, rusted, or uncoated areas with rust inhibitive primer for ferrous metals.
 - b. Coat 1: Rust Inhibitive Primer For Ferrous Metals.
 - c. DFT For Coat 1: 1.3 mils.
 - d. Coat 2: Sash and trim.
 - e. Coat 3: Sash and trim.
 - f. DFT For Coats 2 + 3: 3 mils.
3. Ungalvanized Shop Primed Structural Steel, Exposed On Building Interior:
 - a. Touch-up: Spot prime any abraded, damaged, rusted, or uncoated areas with rust inhibitive primer for ferrous metals.
 - b. Coat 1: Sash and trim.
 - c. Coat 2: Sash and trim.
 - d. DFT: 4.5 mils.

4. Ungalvanized Shop Primed Structural Steel, Concealed: Touch-up by spot priming any abraded, damaged, rusted, or uncoated areas with rust inhibitive primer for ferrous metals.
 5. Shop Primed Metals and Door Louvers, Exterior and Interior, Except For Subparagraphs 2, 3, and 4 above:
 - a. Coat 1: Sash and trim.
 - b. Coat 2: Sash and trim.
 - c. DFT: Three mils.
 6. Factory Finished Equipment and Items, Exterior and Interior:
 - a. Coat 1: Sash and trim.
 - b. DFT: 1.5 mils.
 7. Visible Roof-Top Equipment: Refer to definition in Paragraph 1.02, D.
 - a. Paint the various materials, items, and equipment per requirements of Paragraph 3.06, B, Metal Work, Exterior and Interior.
- B. Exterior Work, Other Than Metals:
1. Wood Typical:
 - a. Coat 1: Exterior wood primer.
 - b. Coat 2: Sash and trim.
 - c. Coat 3: Sash and trim.
 - d. DFT: Five mils.
 2. Surface Trim, Wood, And Plywood:
 - a. Coat 1: Exterior wood stain, opaque.
 - b. Coat 2: Exterior wood stain, opaque.
 - c. Application Rate: 150 SF per gallon per coat.
 3. Surface Plywood Siding:
 - a. Coat 1: Exterior wood stain, opaque. Prime all surfaces of all pieces completely before installation (faces, edges, ends).
 - b. After installation, inspect members; touch-up any damage, cuts, and nail holes.
 - c. Application Rate: 150 SF per gallon per coat.
 4. Surface Boards Over Plywood at Building Facias and Certain Building.
 5. Walls, Both Stained Same Color:
 - a. Finish: Exterior wood stain, opaque.
 - b. Coat 1, Plywood: Apply stain after plywood is installed, but before any boards or trim are installed over plywood.
 - c. 2 x 3 Boards:
 1. Boards to be cut to size by Carpentry Section prior to any staining.
 2. Coat 1: Prime stain all surfaces of all pieces completely before installation (faces, backs, edges, ends).
 3. Touch-Up: After installation over plywood by Carpentry Section, inspect members, touch-up stain any damage, cuts and nail holes.
 - d. Coat 2, All Parts: Apply stain to all exposed wood and plywood surfaces.
 - e. Application Rate: 150 SF per gallon per coat.

6. Exposed Structural Plywood Sheathing At Roof Screens Smooth Surface:
 - a. Coat 1: Exterior wood stain, opaque.
 - b. Coat 2: Exterior wood stain, opaque.
 - c. Application Rate: 250 SF per gallon per coat.
 7. Soffit Construction Behind Screen Vents:
 - a. Coat 1: Exterior wood stain, opaque; black color.
 - b. Application Rate: 250 SF per gallon per coat.
 - c. Apply to all construction, which will be visible through installed vents.
Apply prior to installation of screen.
 8. Plaster Smooth Troweled Finish:
 - a. Coat 1: Exterior masonry finish.
 - b. Coat 2: Exterior masonry finish.
 - c. DFT: 2.3 mils.
 9. Concrete Exposed Foundation Walls and Curbs, Recessed Letters at Sandblasted Concrete Name and Office Signs:
 - a. Coat 1: Concrete sealer.
 - b. Coat 2: Exterior masonry finish.
 - c. Coat 3: Exterior masonry finish.
 - d. DFT: 3.6 mils.
 10. Plastic Condensate Piping and Other Plastic Piping Exposed On Rooftops:
 - a. Coat 1: Chlorinated rubber base paint.
 - b. Application Rate: One coat to cover.
 11. Building Dado (8' Height):
 - a. Coat 1: Light tack coat.
 - b. Coat 2: Semi-gloss enamel.
- D. Interior Work, other Than Metals:
1. Softwood Typical:
 - a. Coat 1: Enamel undercoat.
 - b. Coat 2: Sash and trim.
 - c. Coat 3: Sash and trim.
 - d. DFT: 4 mils.
 2. Hardwood Doors and Handrails, Softwood Casework Where Not Factory Finished:
 - a. Sealer: At Contractor's option and expense, Clear Sealer may be used as an aid in obtaining a uniform stain color.
 - b. Coat 1: Oil Stain, or wiped white glaze, as selected by District.
 - c. Coat 2: Gloss varnish. Sand smooth.
 - d. Coat 3: Gloss varnish. Steel wool smooth.
 - e. Coat 4: Satin varnish.
 - f. DFT: 3.5 mils.
 - g. Lacquer Option: With specific approval of District, lacquer may be used in lieu of varnish.

3. Rough Surface Wood and Trim:
 - a. Coat 1: Exterior wood stain, semi-transparent.
 - b. Coat 2: Exterior wood stain, semi-transparent.
 - c. Application Rate: 150 SF per gallon per coat.
4. Rough Surface Board On Plywood Wall Treatment:
 - a. Coat 1: Exterior wood stain, semi-transparent. Prime all pieces completely before installation (faces, edges, and ends). After installation, inspect members, touch up any damage, cuts, and nail holes.
 - b. Coat 2: Exterior wood stain, semi-transparent. Apply to all exposed surfaces.
 - c. Application Rate: 150 SF per gallon per coat.
5. Plywood Wall Lining At Storage Areas:
 - a. Coat 1: Exterior wood stain, semi-transparent.
 - b. Coat 2: Exterior wood stain, semi-transparent.
 - c. Application Rate: 250 SF per gallon per coat.
6. Hardboard Panels At Integrated Ceiling:
 - a. Coat 1: Clear methacrylic lacquer.
 - b. Apply before items are installed.
7. Concrete; Exposed Foundation Wall and Curbs:
 - a. Coat 1: Concrete sealer.
 - b. Coat 2: Exterior masonry finish.
 - c. Coat 3: Exterior masonry finish.
 - d. DFT: 3.6 mils.
8. Drywall Walls; Typical:
 - a. Coat 1: Latex sealer.
 - b. Coat 2: Enamel undercoater.
 - c. Coat 3: Stipple enamel, semi-gloss. Apply with a District approved heavy-texture stipple roller.
 - d. DFT: 5 mils.
9. Drywall Ceilings, Soffits, and Beams:
 - a. Coat 1: Latex sealer.
 - b. Coat 2: Flat wall latex.
 - c. Coat 3: Flat wall latex.
 - d. DFT: 4 mils.
10. Drywall Walls and Ceilings at Janitor's Rooms, Toilets, Storage Rooms, And Kitchen:
 - a. Coat 1: Latex sealer.
 - b. Coat 2: Enamel undercoat.
 - c. Coat 3: Stipple enamel, semi-gloss. Apply with a District approved heavy-texture stipple roller.
 - d. OFT: Five mils.
11. Painted Strips at Interior Concrete Stairs, Conform to State Handicap Requirements:
 - a. Coat 1: Traffic paint.
 - b. Coat 2: Traffic paint.
 - c. Application Rate: Two coats, at 400 SF per gallon per coat.
 - d. Stripes: 2" wide, located 1" maximum from and parallel to nosing.
 - e. Required Locations: Bottom tread and upper approach of each flight of stairs and landings.

12. Concrete Block:

- a. SPRAYTEK II over undercoat.
 - 1. Coat 1: Primer, undercoat with hopper or other equipment qualified for heavy bodied material to a minimum thickness of 20 mils.
 - 2. Finish Coat: SPRAYTEK, minimum thickness of 10 mils.
 - 3. Texture: Smooth sand; OS-IV Texture.
- b. Water-base Acrylic-epoxy
 - 1. Pittsburgh Paints; Pitt-glaze, (tinted).
 - 2. Wet film; 20 to 40 mils thickness as required to fill the surface. Films in excess of 25 mils wet should be applied in two coats to facilitate their cure.

E. Mechanical and Electrical Work:

- 1. General: Unless otherwise specified herein, paint all exposed mechanical, plumbing, fire sprinklers, and electrical equipment, apparatus, piping, conduit, fittings incidental thereto, and coverings applied thereto as specified above in Paragraph 3.06, B, Metal Work, Exterior and Interior.
 - a. Finished rooms and spaces: Paint equipment, panel boards, and all other items to match room finish.
 - b. Unfinished rooms and spaces: Same requirements as "Finished Rooms and Spaces," except that equipment, panel boards, and other items with complete factory-applied paint finishes need not be painted.
 - c. Do not paint out nameplates, labels, or stamped designations of sizes, qualities, standards and manufacture on pieces of equipment.
 - d. Do not paint canvas connections between fans and ducts.
 - e. Do not paint brass fittings, rough or polished, plated or non-plated.
 - f. Items mounted in floors: Paint cover plates to sumps and pipe trenches, and manhole covers and rings mounted in floors, and similar items two coats of cement color floor paint.
 - g. Exposed exterior items: Paint per Paragraph 3.06, B.
 - h. Painting flat black: Paint two coats flat black color as far back as visible the inside surfaces of ducts, dampers, louvers, vents, and similar items.
 - i. Plumbing fixtures: Paint unfinished exposed surfaces to match adjoining walls.
 - j. Main sprinkler riser: Paint bright red color.
 - k. Sprinkler head canopies: Paint to match color of adjacent surfaces, unless canopies are chrome-finished or stainless steel.
 - l. Paint work not specifically mentioned shall be as specified for work of similar character.

END OF SECTION

FRESNO UNIFIED SCHOOL DISTRICT
PAINT MATERIALS LIST

PART 1 - GENERAL

1.01 REFERENCE:

- A. General Conditions & Requirements
- B. Specification Sections 09900, 09904 & 09905

PART 2 - PRODUCTS

2.01 MATERIALS GENERAL:

- A. Standard Materials and Finishes: Use pure unadulterated factory-mixed material delivered to site in unopened containers bearing manufacturer's name and brand; colors, as selected by District, shall be factory-mixed.
 - 1. Manufacturers shall verify that their products conform to latest California Air Resources Board regulations.

2.02 ACCEPTABLE MANUFACTURERS AND PRODUCTS:

A. General:

All materials used in the work shall be a proprietary brand of one of the manufacturers listed below for each type. Should a listed manufacturer's product no longer be available, an equivalent product may be submitted for District review in order to ensure conformance with current Industry standards for both quality and applicable regulations.

B. Metal Primers:

MANUFACTURER

PRODUCT

1. Zinc Dust:

Sherwin-Williams
ICI/Sinclair Paint Co.

B69A8 Zinc-Clad IV
Zinc Dust - Zinc Oxide Primer #25

2. Oil-Cementitious:

Sherwin-Williams
Dunn Edwards
TNEMEC

B66-310 ProCryl Universal Primer
Galv-Alum White Anti-Corrosion Primer #43-7
Series 22 Galv-Gard Oil
Cementitious Exterior Coating
Galvanized Metal Primer#13201

Ameritone Mirrolac

3. Rust-Inhibitive Primer for Ferrous Metals:

Dunn Edwards
Sherwin-Williams
ICI/Sinclair

Block-Rust Red Oxide Primer #43-4
DTM Primer/Finish B66W1
15 Red Oxide Primer

C. Exterior Wood Primers:

Dunn Edwards
Sherwin-Williams
ICI/Sinclair

Apex Extr. Primer # 42-9
ProBlock Latex Primer B51W20
Exterior Wood Primer #289

D. Exterior Surfaces - Acrylic Enamel:

Dunn Edwards	Permasheen Semi Gloss W901
Sherwin-Williams	A-100 Gloss A8 Series
ICI/Sinclair	2406 Dulux

E. Semi-Transparent Exterior Wood Stain; For Interior Wood; Must Be An Oil-Base Stain:

Dunn Edwards	Rancho-Hues, #17 Series Semi-Transparent
Sherwin-Williams	WoodScapes Ext. Semi-Transparent Stain A15T5
ICI/Sinclair	Stainteke, Semi-Transparent #3900 Series

F. Opaque Exterior Wood Stains; For Exterior Wood; Must Be An Oil-Base Stain:

Olympic	Exterior, Solid Color Stain
ICI/Sinclair	Stainteke, Heavy-Bodied Opaque #4700 Series
Sherwin-Williams	WoodScapes Ext. Solid Color Stain A15W50 Series

G. Exterior Masonry Finish:

Dunn Edwards	Evershield #W 701-1; 100% acrylic
Sherwin-Williams	A-100 Flat A6 Series
ICI/Sinclair	Stuc-O-Life #1300, 100% Acrylic Dulux 2200

H. Sealer; Latex:

Dunn Edwards	Vinylastic Pigmented Wall Sealer W-101
Sherwin-Williams	ProGreen 200 Latex Primer B28W600
ICI/Sinclair	P.V.A. Sealer #1770 (1030 U/H PVA Primer)

I. Sealer; Concrete:

Dunn Edwards	Eff-Stop Concrete Sealer W-709.
Sherwin-Williams	Loxon Masonry Primer A24W300
ICI/Sinclair	18 EPO Primer 3210 Gripper

J. Interior Finishes:

1. Enamel Undercoater. Interior:

Dunn Edwards	Enamel Undercoater #42-31 or E22-1 Super-U 365
Sherwin-Williams	Water Reducible Alkyd Primer B49WJ1100
ICI/Sinclair	Sinco Prime Undercoater #975

2. Enamel. Semi-Gloss Stipple:

Sherwin-Williams	ProGreen 200 Semi-Gloss B31W600 Series
Dunn Edwards	Semi-Gloss Stipple Enamel #8-14
ICI/Sinclair	Semi-Gloss Stipple #782

a. Color Selection: Dunn Edwards, Navajo White 60.

3. Lacquer Sanding Sealer: High Solids:

Dunn Edwards	Lacquer Sanding Sealer #LQ-101
Sherwin-Williams	Lacquer Sanding Sealer B44MJ91
ICI/Sinclair	Lacquer Sanding Sealer, Clear #2610

4. Interior Lacquer System:

Dunn Edwards	Lacquer Clear (gloss #LQ-103) (Semi-gloss #LQ-104) (Flat #LQ-105)
--------------	--

- | | |
|------------------|--|
| Sherwin-Williams | ProMar High Build Lacquer (Gloss B44CJ89)(Semi-Gloss B44FJ86)(Satin B44KJ84) |
| ICI/Sinclair | Lacquer #2600 Series "Lac-O-Rite" |
5. Interior Varnish System:
- | | |
|------------------|---|
| Dunn Edwards | Pale Synthetic Varnish: Gloss #V-197; Satin #V-199 |
| Sherwin-Williams | WoodClassics Waterborne Polyurethane Varnish A68-90 Series |
| ICI/Sinclair | Woodpride Varnish: #400 Gloss; #410 Semi-gloss; #407 Velvet |
6. Clear Sealer:
- | | |
|------------------|--|
| Dunn Edwards | Reinseal Clear Sealer #V-195 |
| Sherwin-Williams | WoodClassics Waterborne Polyurethane Varnish A68-90 Series |
| ICI/Sinclair | Primer Sealer #3352 |
- K. Traffic Paint:
- | | |
|------------------|---|
| Dunn Edwards | "Vin-L-Stripe" #W-801, vinyl-epoxy. |
| J.E. Bauer | Latex base; formulas #1030A9 white, #1056A9 Yellow, #1865A9 blue, #1118A9 Green, and #1854A9 Red. |
| ICI/Sinclair | #160 Vinyl Traffic Line Paint, Water-base. |
| Sherwin-Williams | Set Fast Traffic Marking Paint |
1. Color Selection:
- Text: White.
 - Parking Dividers: White.
 - No Parking Zones: Yellow.
 - No Parking Curb: Red.
 - Handicap Zones: Blue.
 - Directional Arrows: White.
 - Driving Lane Dividers: White.
 - Playground Striping: Beige or Green.
2. Blue paint for Handicap shall match No. 15090 in Federal Standard 595A.

END OF SECTION